


GENERAL NOTES

- 1 ALL CONSTRUCTION TO BE DONE IN ACCORDANCE WITH THE CITY OF GRAND JUNCTION SPECIFICATIONS
- 2 TOP OF ECCENTRIC CONE TO BE SET @ TOP OF SUBGRADE (STREET CONTRACTOR TO SET RIMS TO FINISH GRADE OF STREET)

QUANTITIES




- 2595 LF 8" SANITARY SEWER
- 10 MANHOLES
- 40 SERVICE CONNECTIONS

AS BUILT DRAWINGS

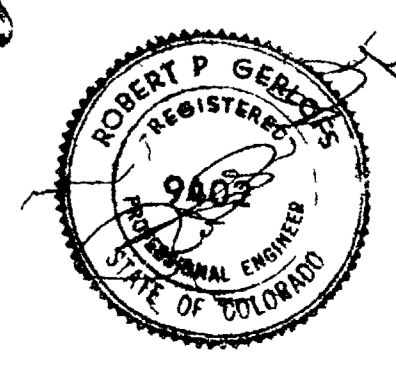

PARAGON ENGINEERING, INC.
 DATE: NOVEMBER, 21
 SCALE: AS SHOWN
 SAUNTERY SEWER PLAN, DETAILS AND NOTES
 FAIRMOUNT NORTH CITY OF GRAND JUNCTION, COLORADO

PO BOX 2672 GRAND JUNCTION CO, LOVADO 811
 PHONE 828-8968

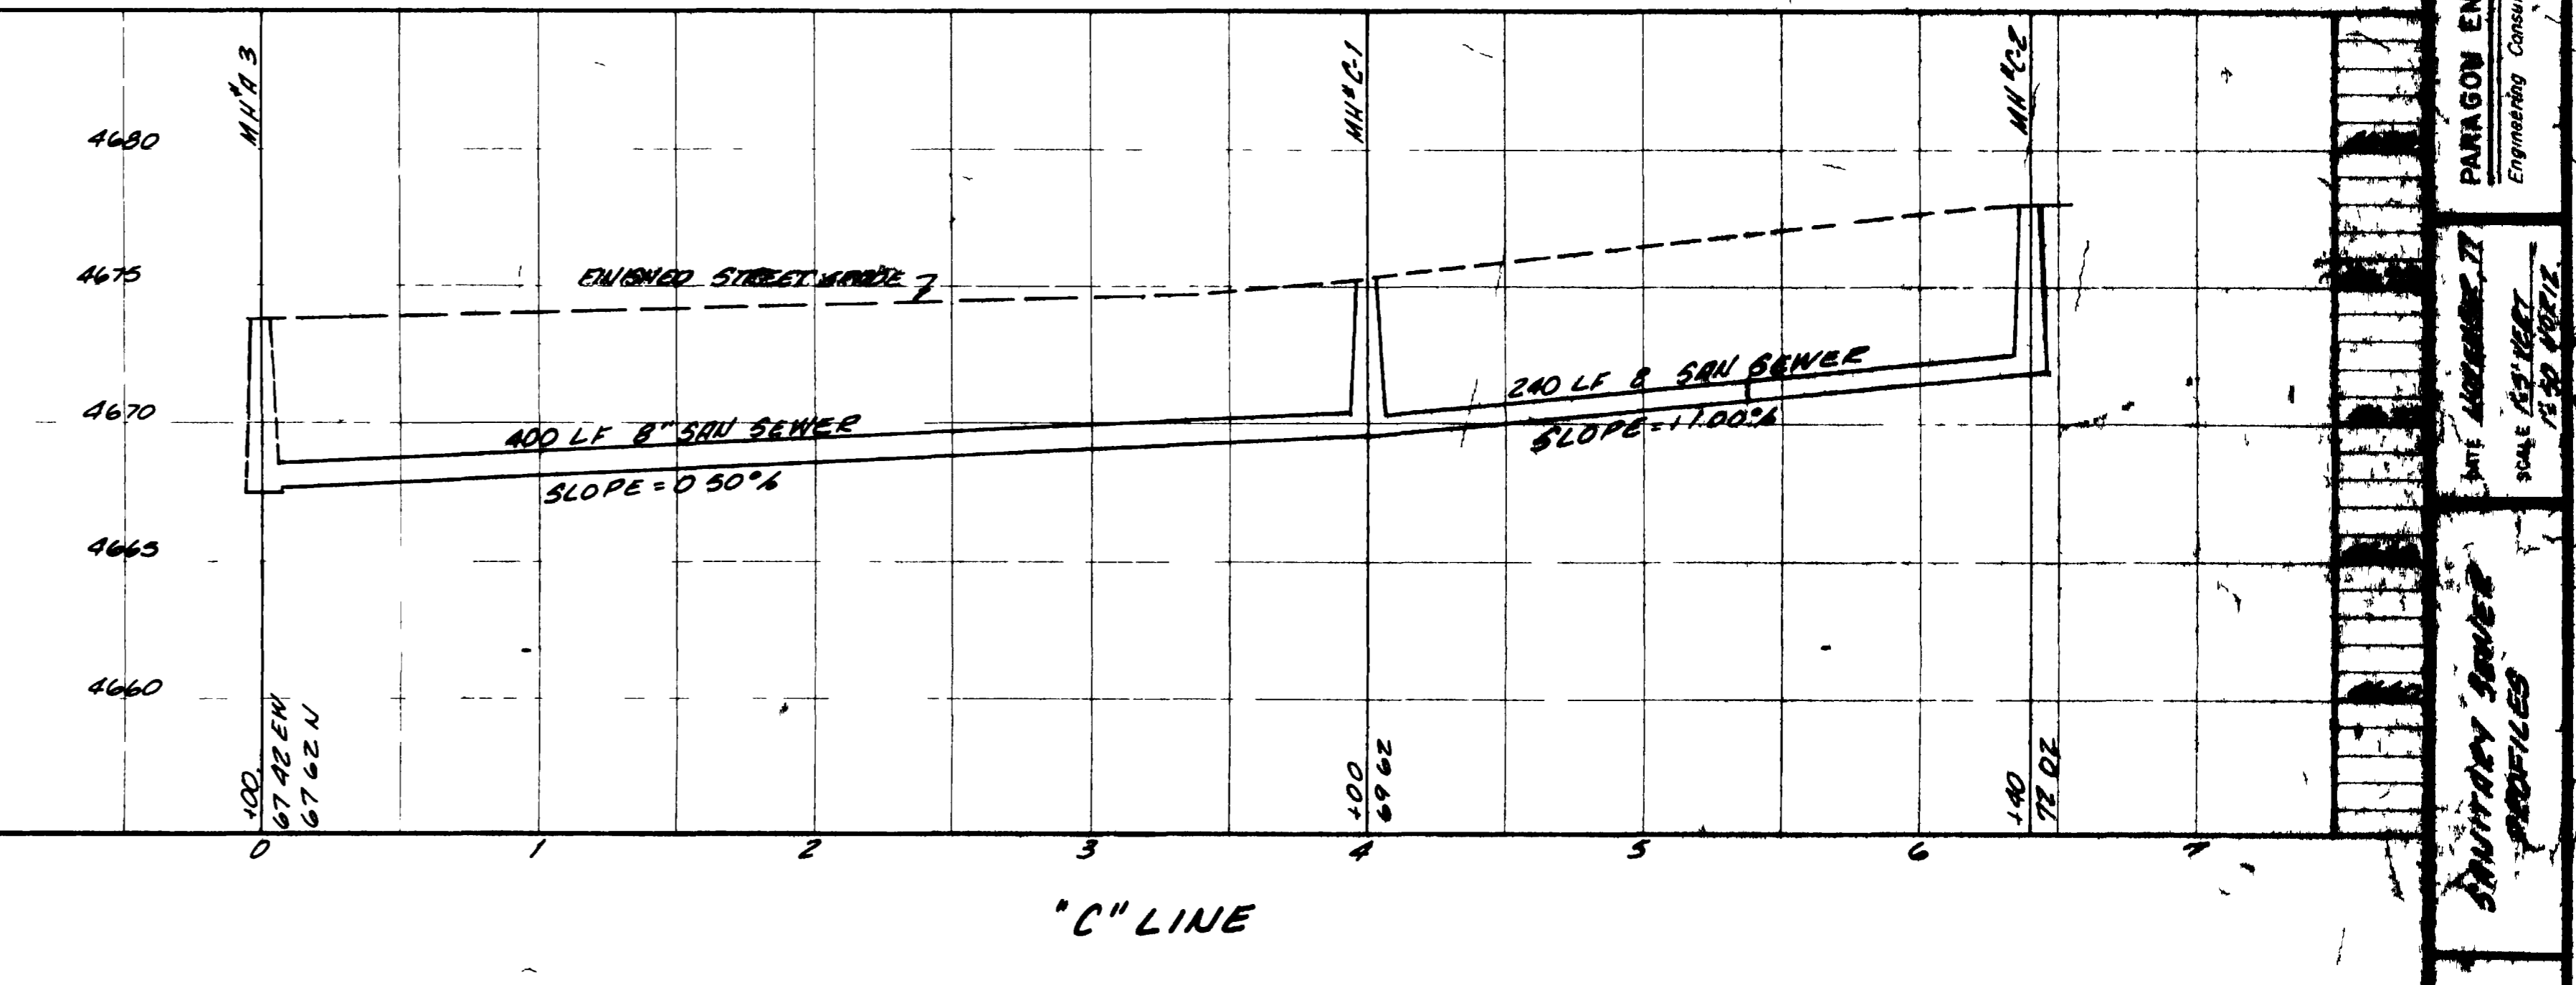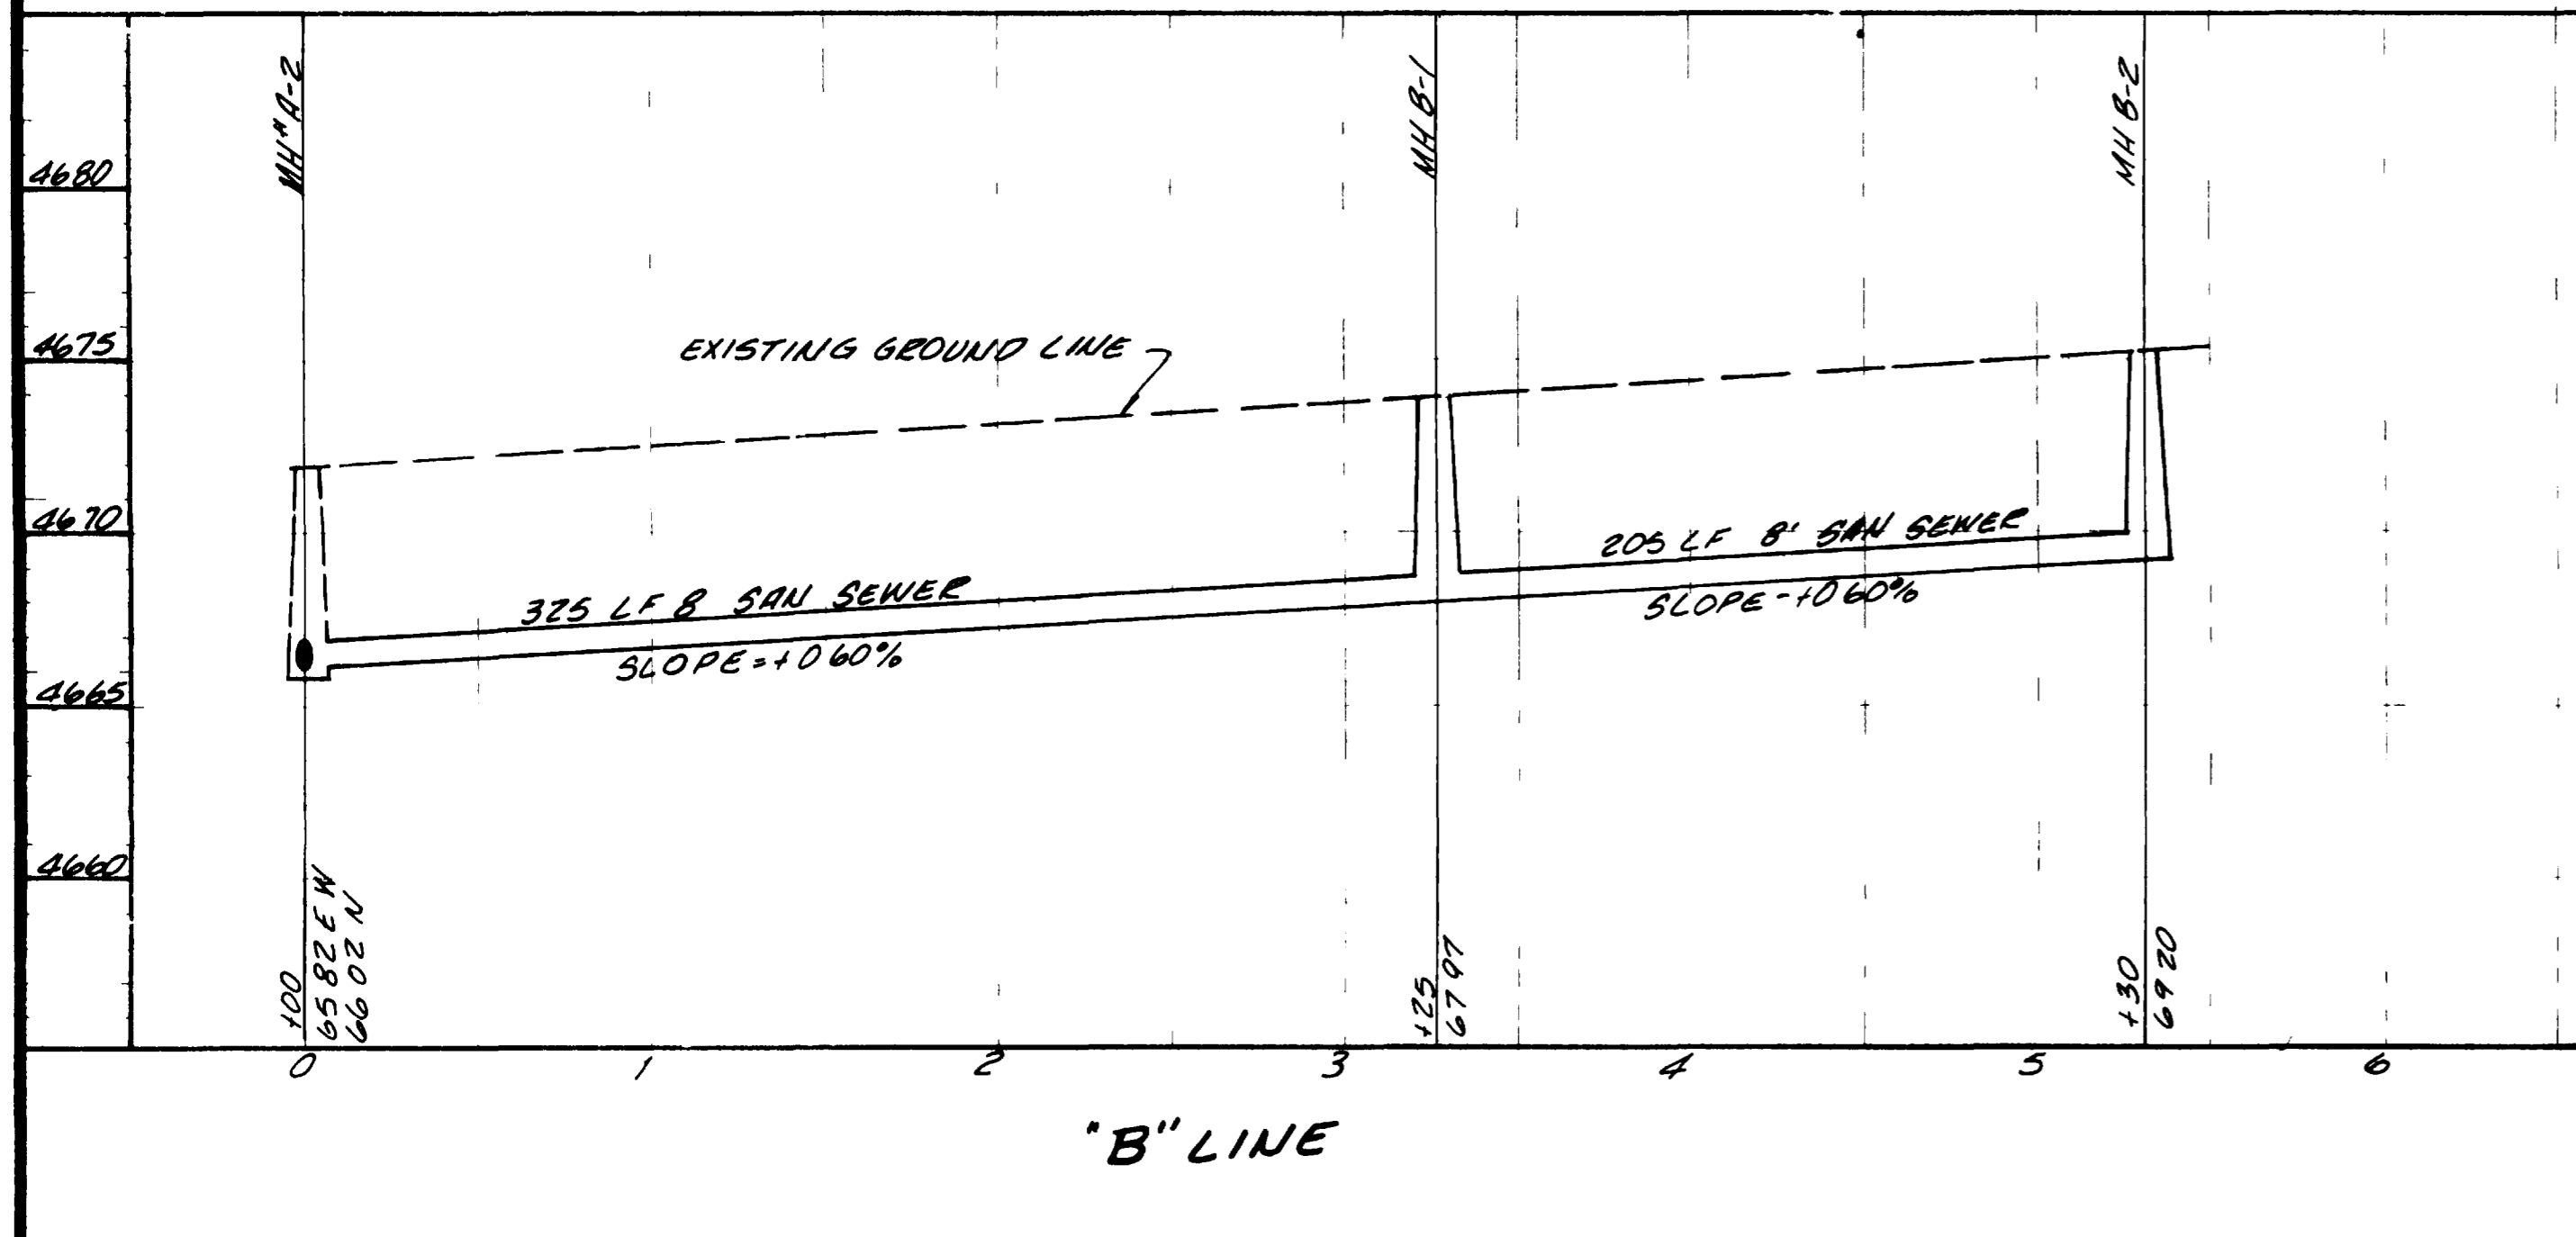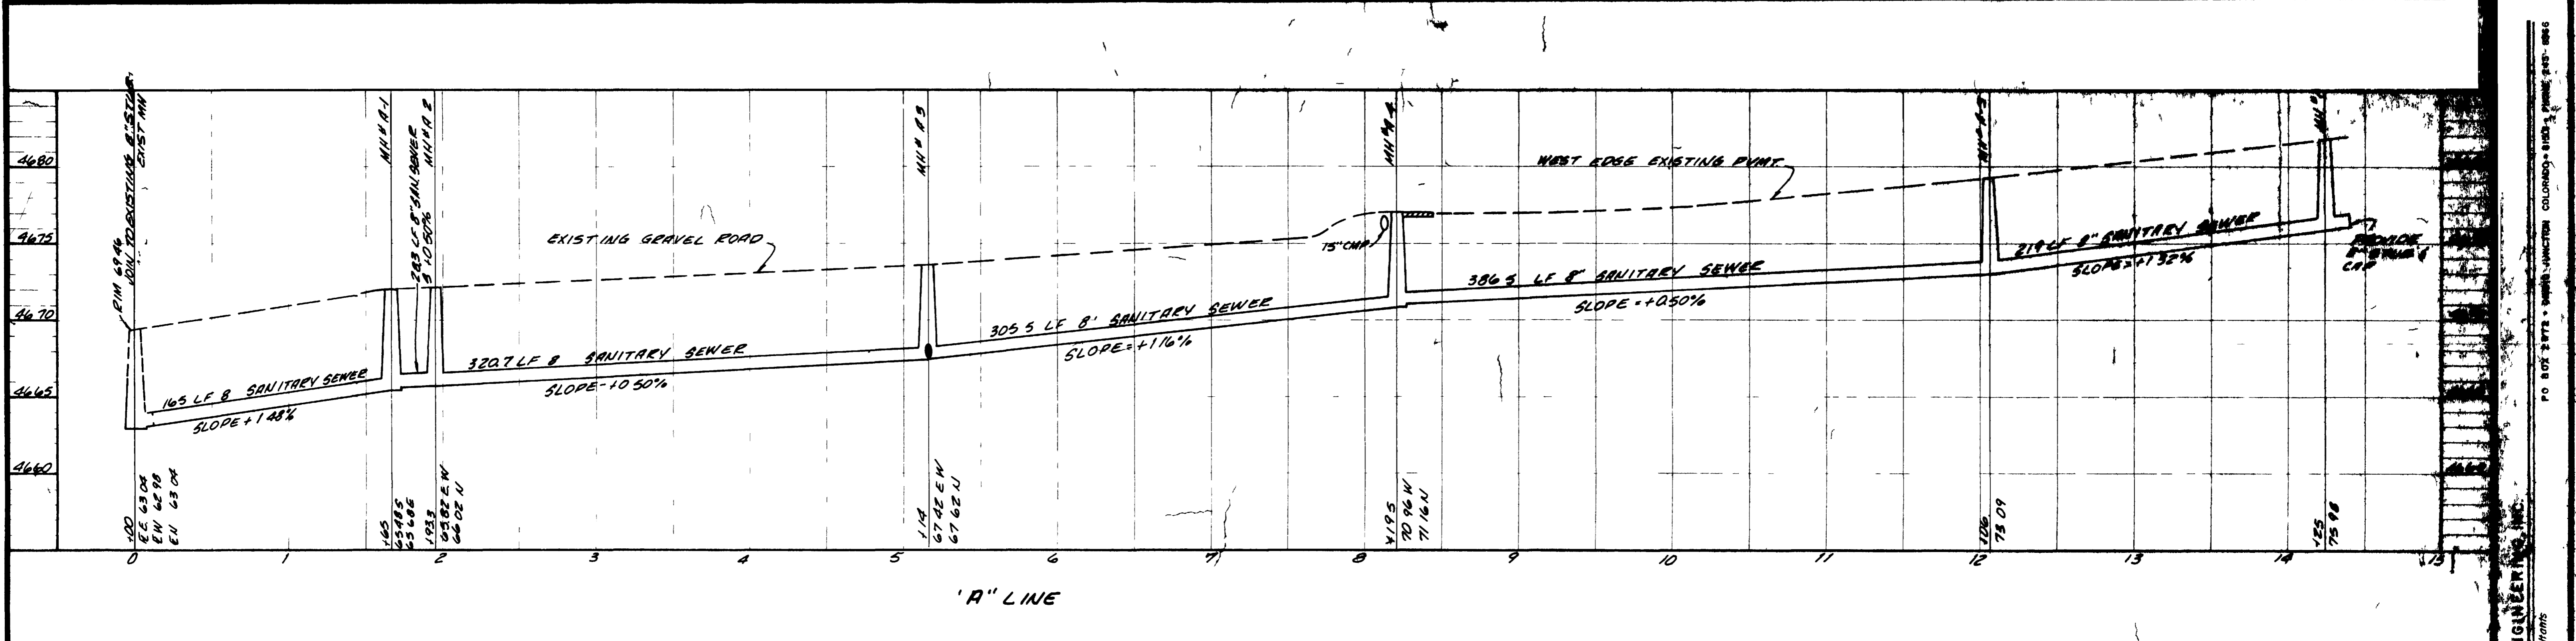

AS SHOWN

PARAGON ENGINEERING, INC.
 Engineering Consultants
 1530 10TH ST. N.
 DENVER, CO 80202
 SCALE: 1/4" = 1'-0"
 DATE: 12/15/07
 PROJECT: SANITARY SEWER PROFILES
 SHEET: 1530-007E
 CITY OF GRAND JUNCTION, COLORADO