



- SANITARY SEWER NOTES**
- 1 TOP OF ECCENTRIC CONE TO BE SET AT TOP OF SUBGRADE (STREET CONTRACTOR TO SET RIMS TO FINISH GRADE OF STREET)
 - 2 ALL CONSTRUCTION TO BE DONE IN ACCORDANCE WITH THE ORCHARD MESA SANITATION DISTRICT SPECIFICATIONS
 - 3 ALL SERVICE LINES SHALL EXTEND A MINIMUM OF 10 FEET BEYOND THE PROPERTY LINE

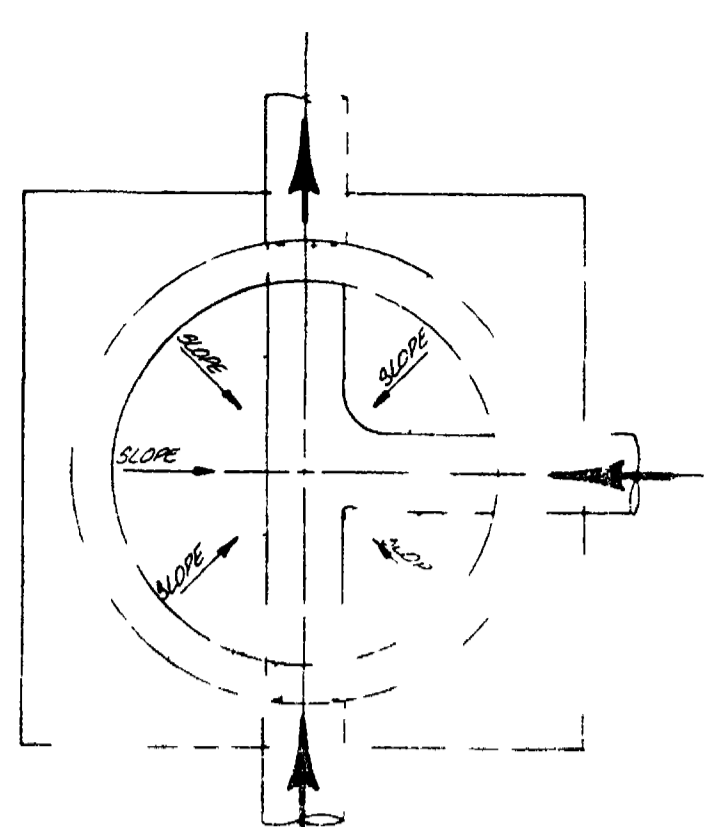

Scale 1"=50' 0"

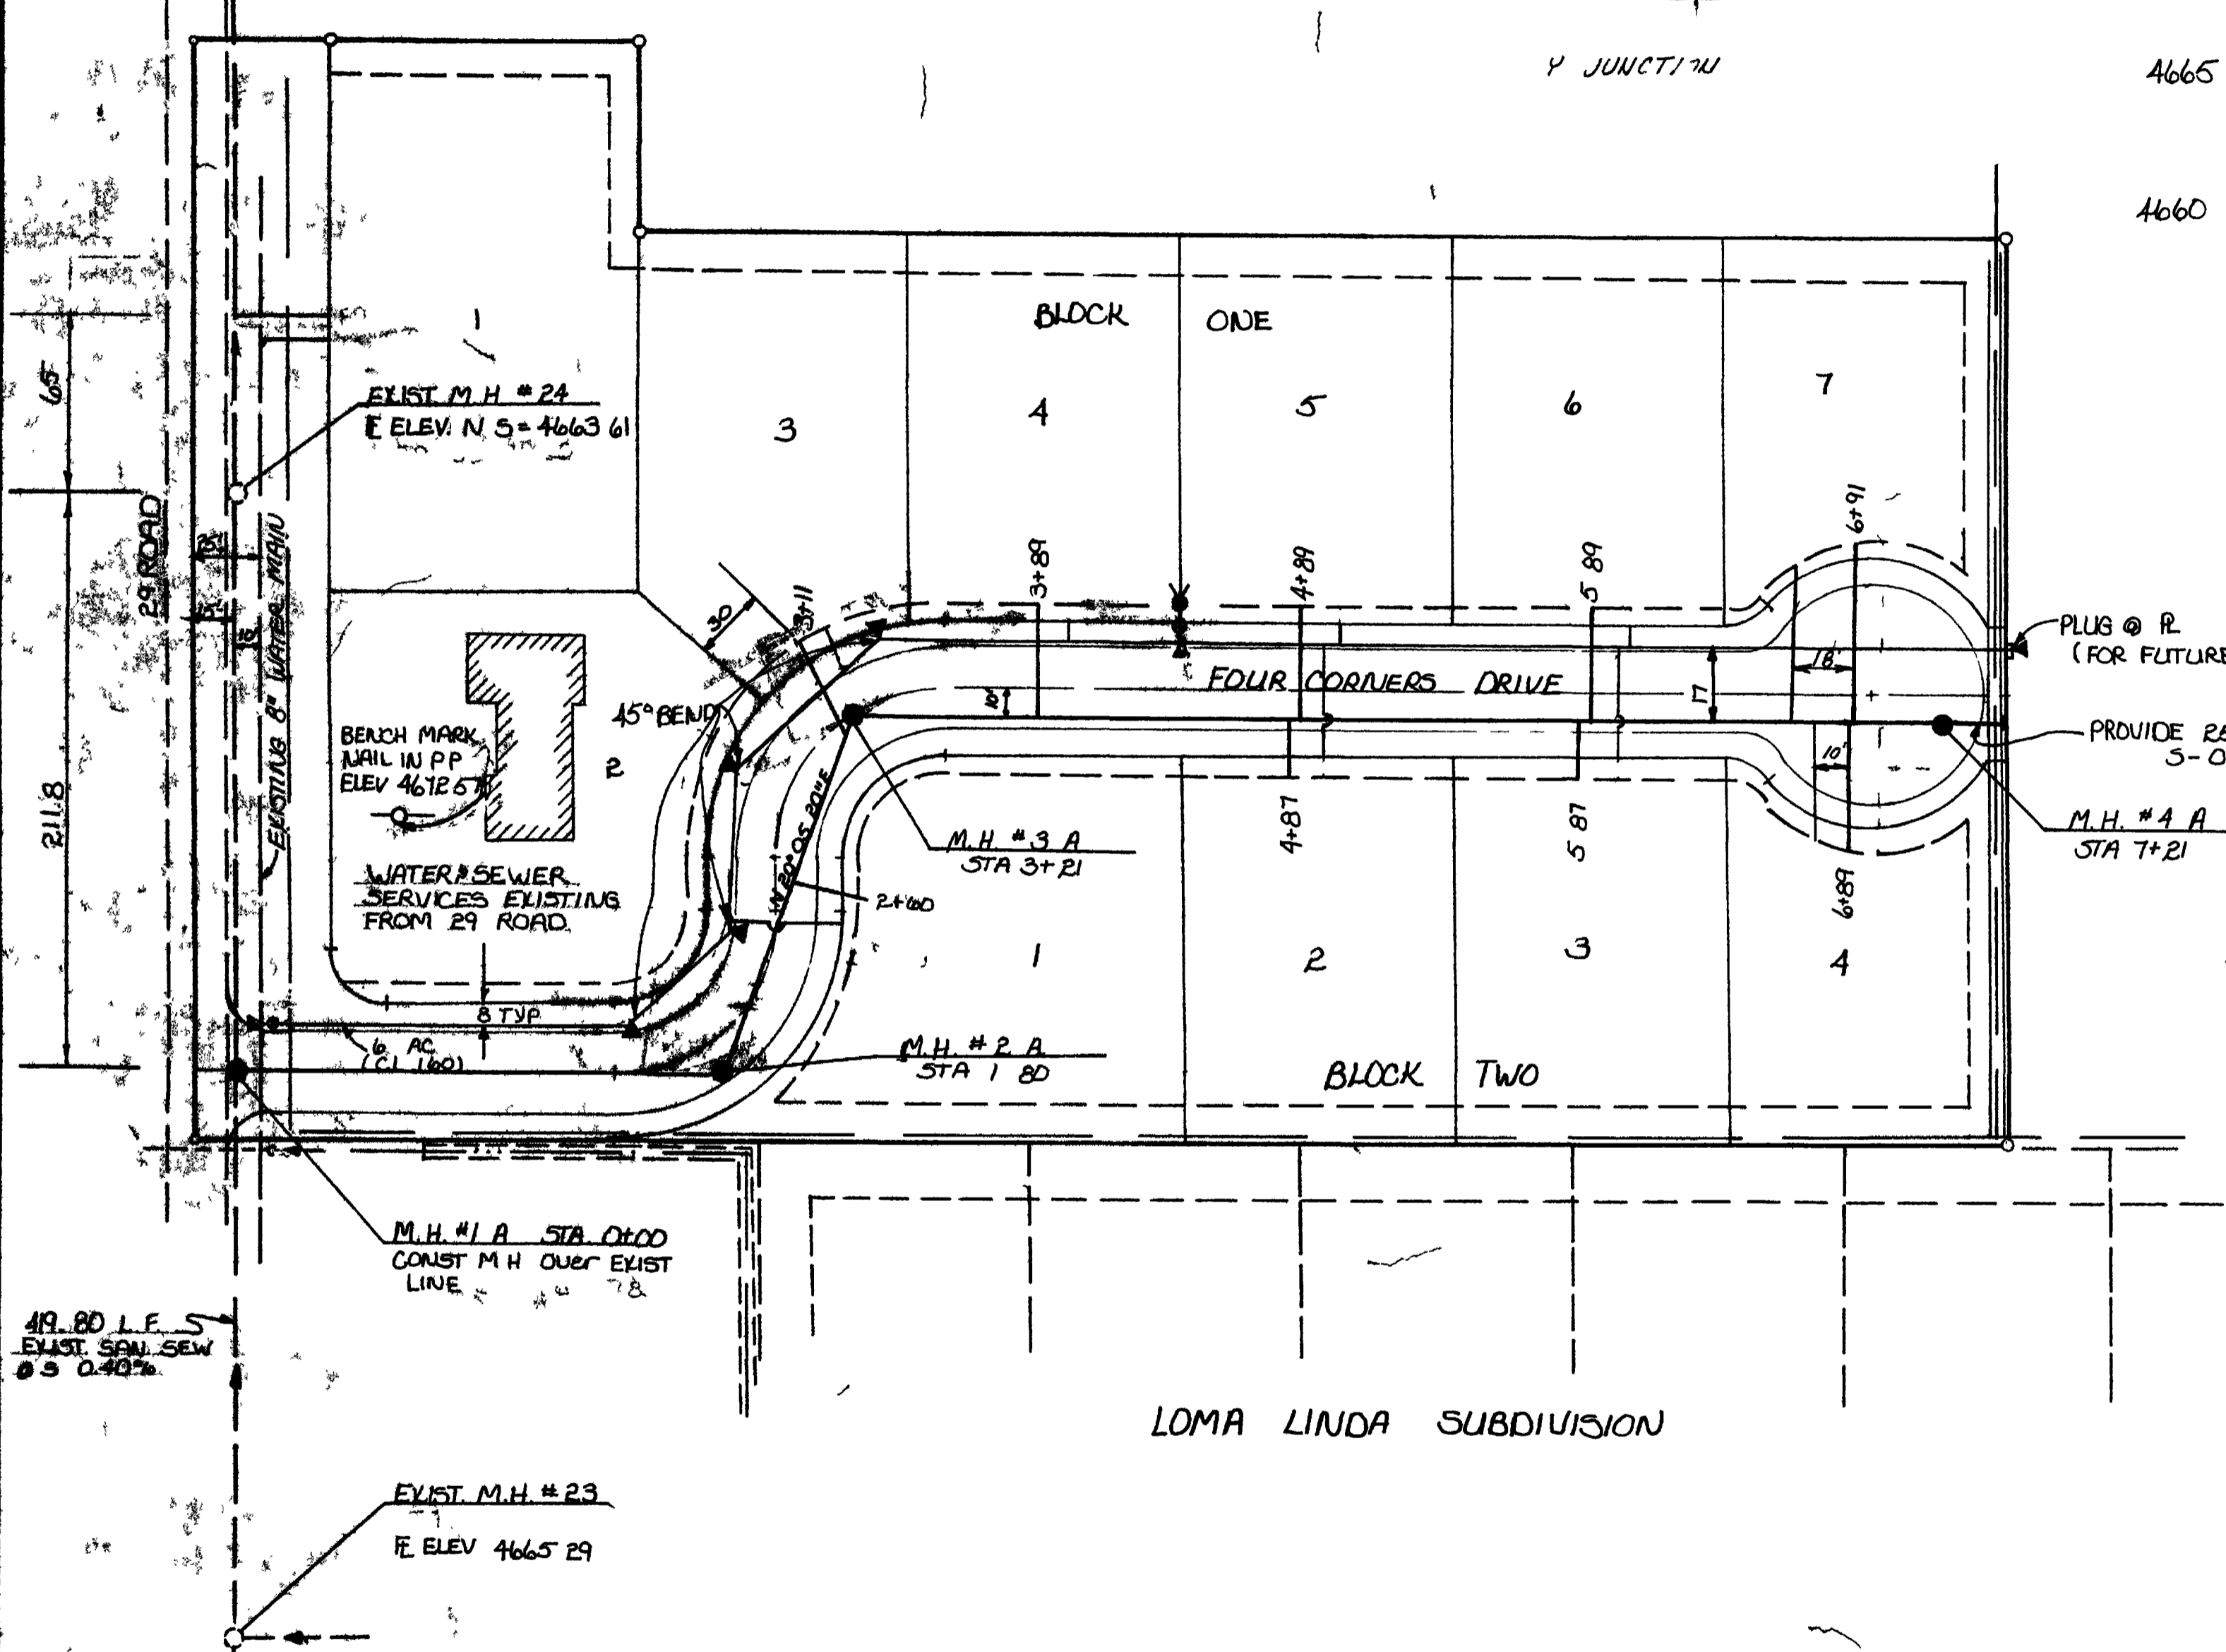

SANITARY SEWER QUANTITIES

- 746 LF 8" SANITARY SEWER
- 4 STANDARD MANHOLES
- 10 SERVICES CONNECTIONS





DOMESTIC WATER QUANTITIES

- 735 LF 6" CLASS 160 A/C
- 1 6" GATE VALVE
- 1 FIRE HYDRANT
- 10 SERVICE CONNECTIONS
- 1 JOIN EXISTING 8" WATER MAIN

DOMESTIC WATER NOTES

- 1 THE CONTRACTOR SHALL BE RESPONSIBLE FOR COORDINATING ALL CONSTRUCTION WITH THE WATER
- 2 ALL CURB STOPS WILL BE FURNISHED BY THE WATER FOR INSTALLATION BY THE CONTRACTOR
- 3 WATER SERVICES SHALL BE LOCATED 10' UPSTREAM OF SEWER SERVICES UNLESS OTHERWISE SHOWN

4680
4675
4670
4665
4660

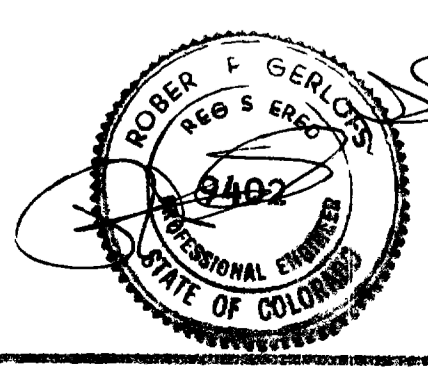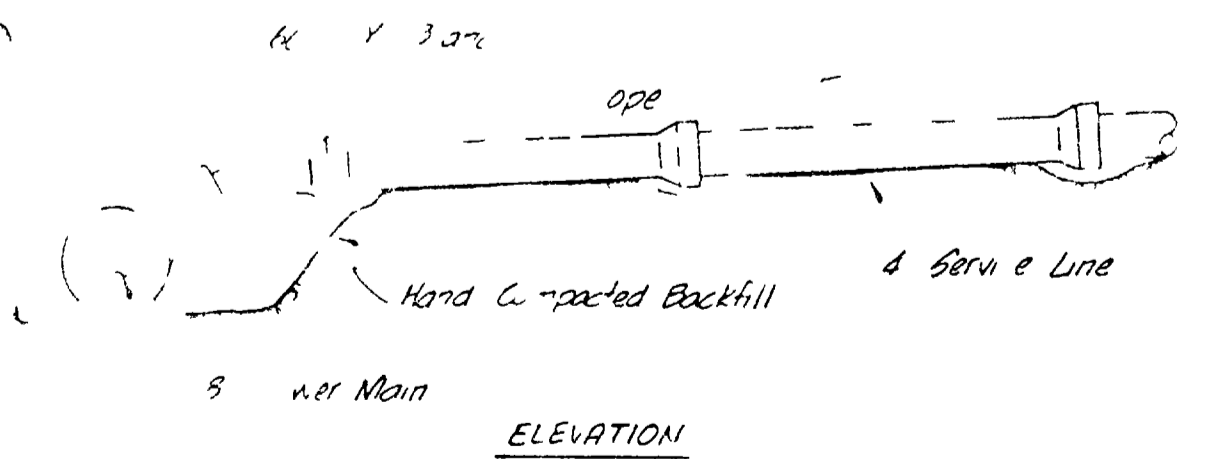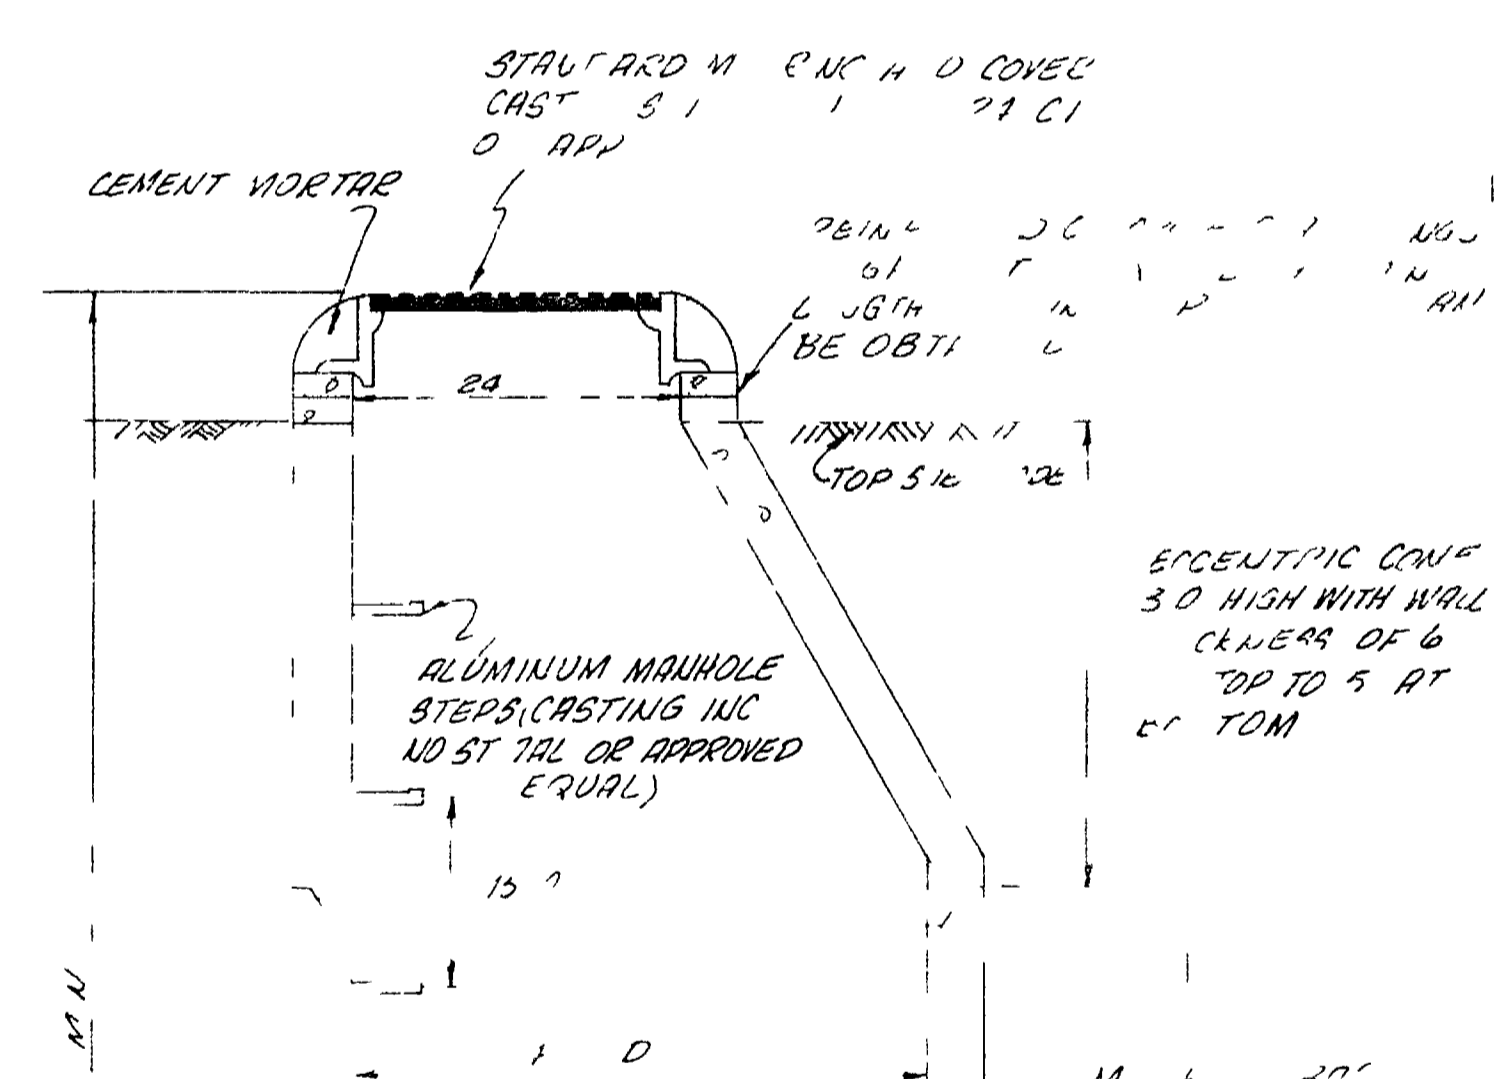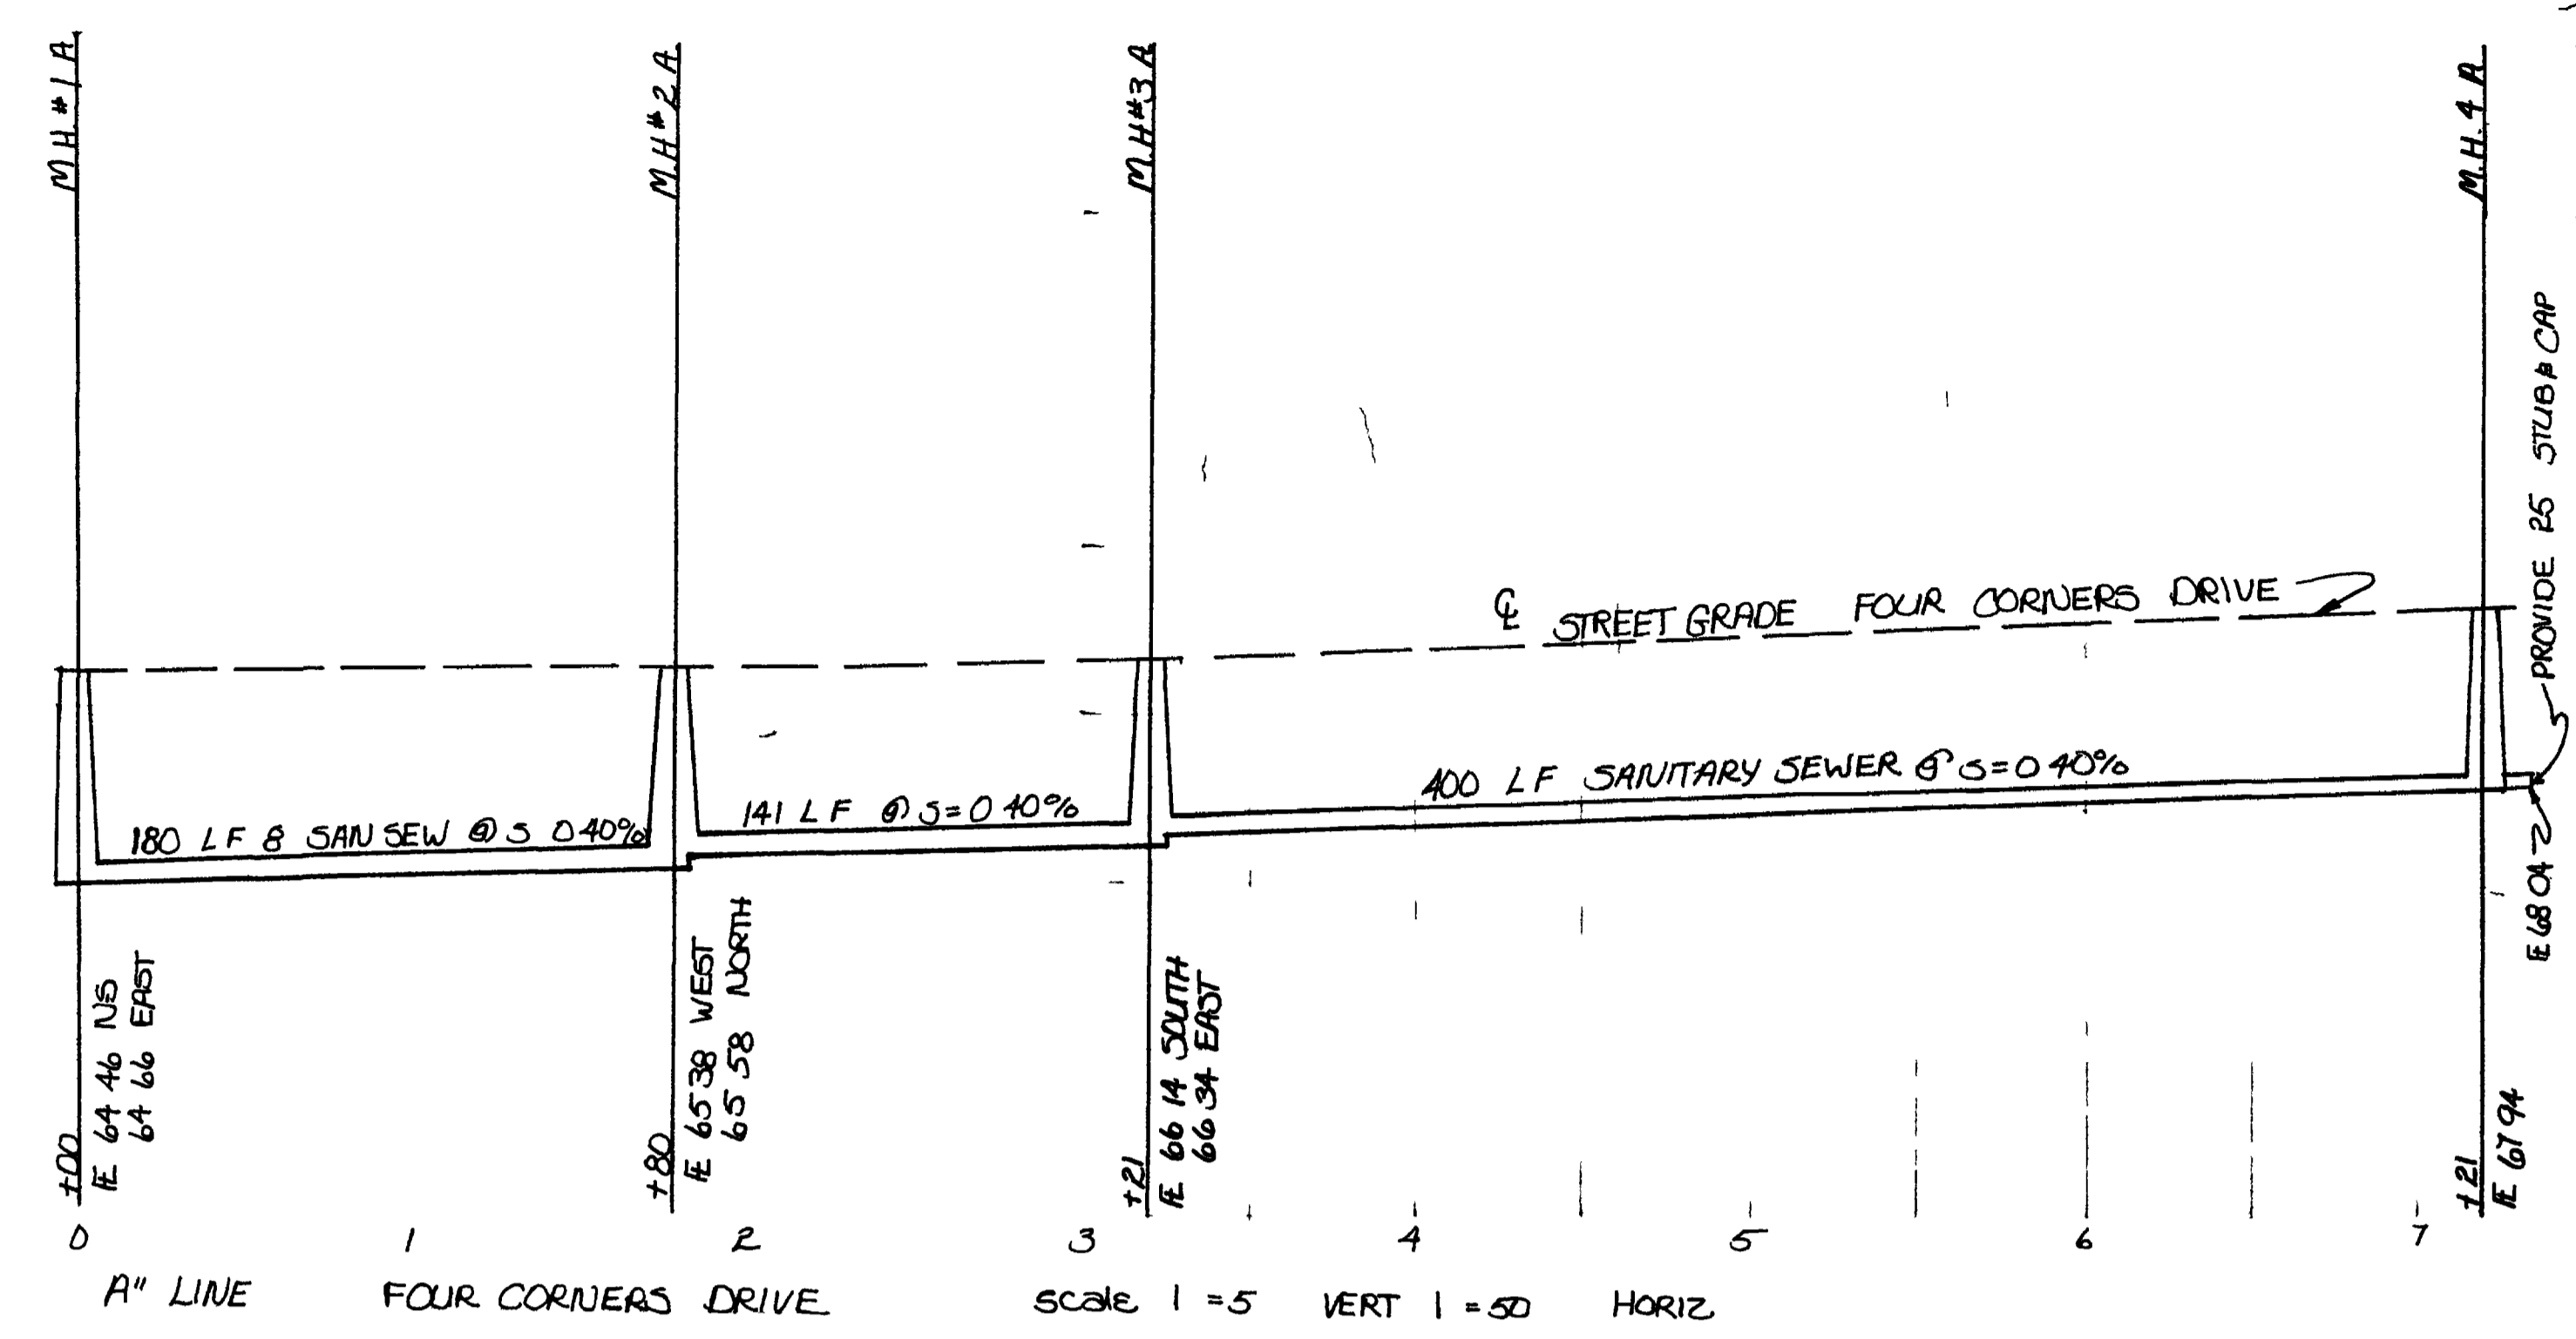

APPROVED _____ DATE _____
ORCHARD MESA SANITATION DISTRICT

AS BUILT DRAWING

PARAGON ENGINEERING INC
PO BOX 28 G C OH
E 91 00 9 CO OHIO
DATE: MAY, 1978
SCALE: AS SHOWN
SANITARY SEWER AND DOMESTIC WATER PLANS
PROFILES AND DETAILS
FOUR CORNERS SUBDIVISION
ORCHARD MESA, COLORADO