



SECTION "A" - "A"


- NOTES
1. ALL CONSTRUCTION TO BE DONE IN ACCORDANCE WITH THE CITY OF GRAND JUNCTION SPECIFICATIONS
 2. TOP ECCENTRIC CONE TO BE SET @ TOP OF SUBGRADE | STREET CONTRACTOR TO SET RIMS TO FINISH GRADE OF STREETS
 3. ALL SEWER SERVICES TO EXTEND A MINIMUM 10' BEYOND PROPERTY LINE
 4. SEWER AND WATER SERVICES SHALL HAVE A MINIMUM SEPARATION OF 10' AT ALL TIMES

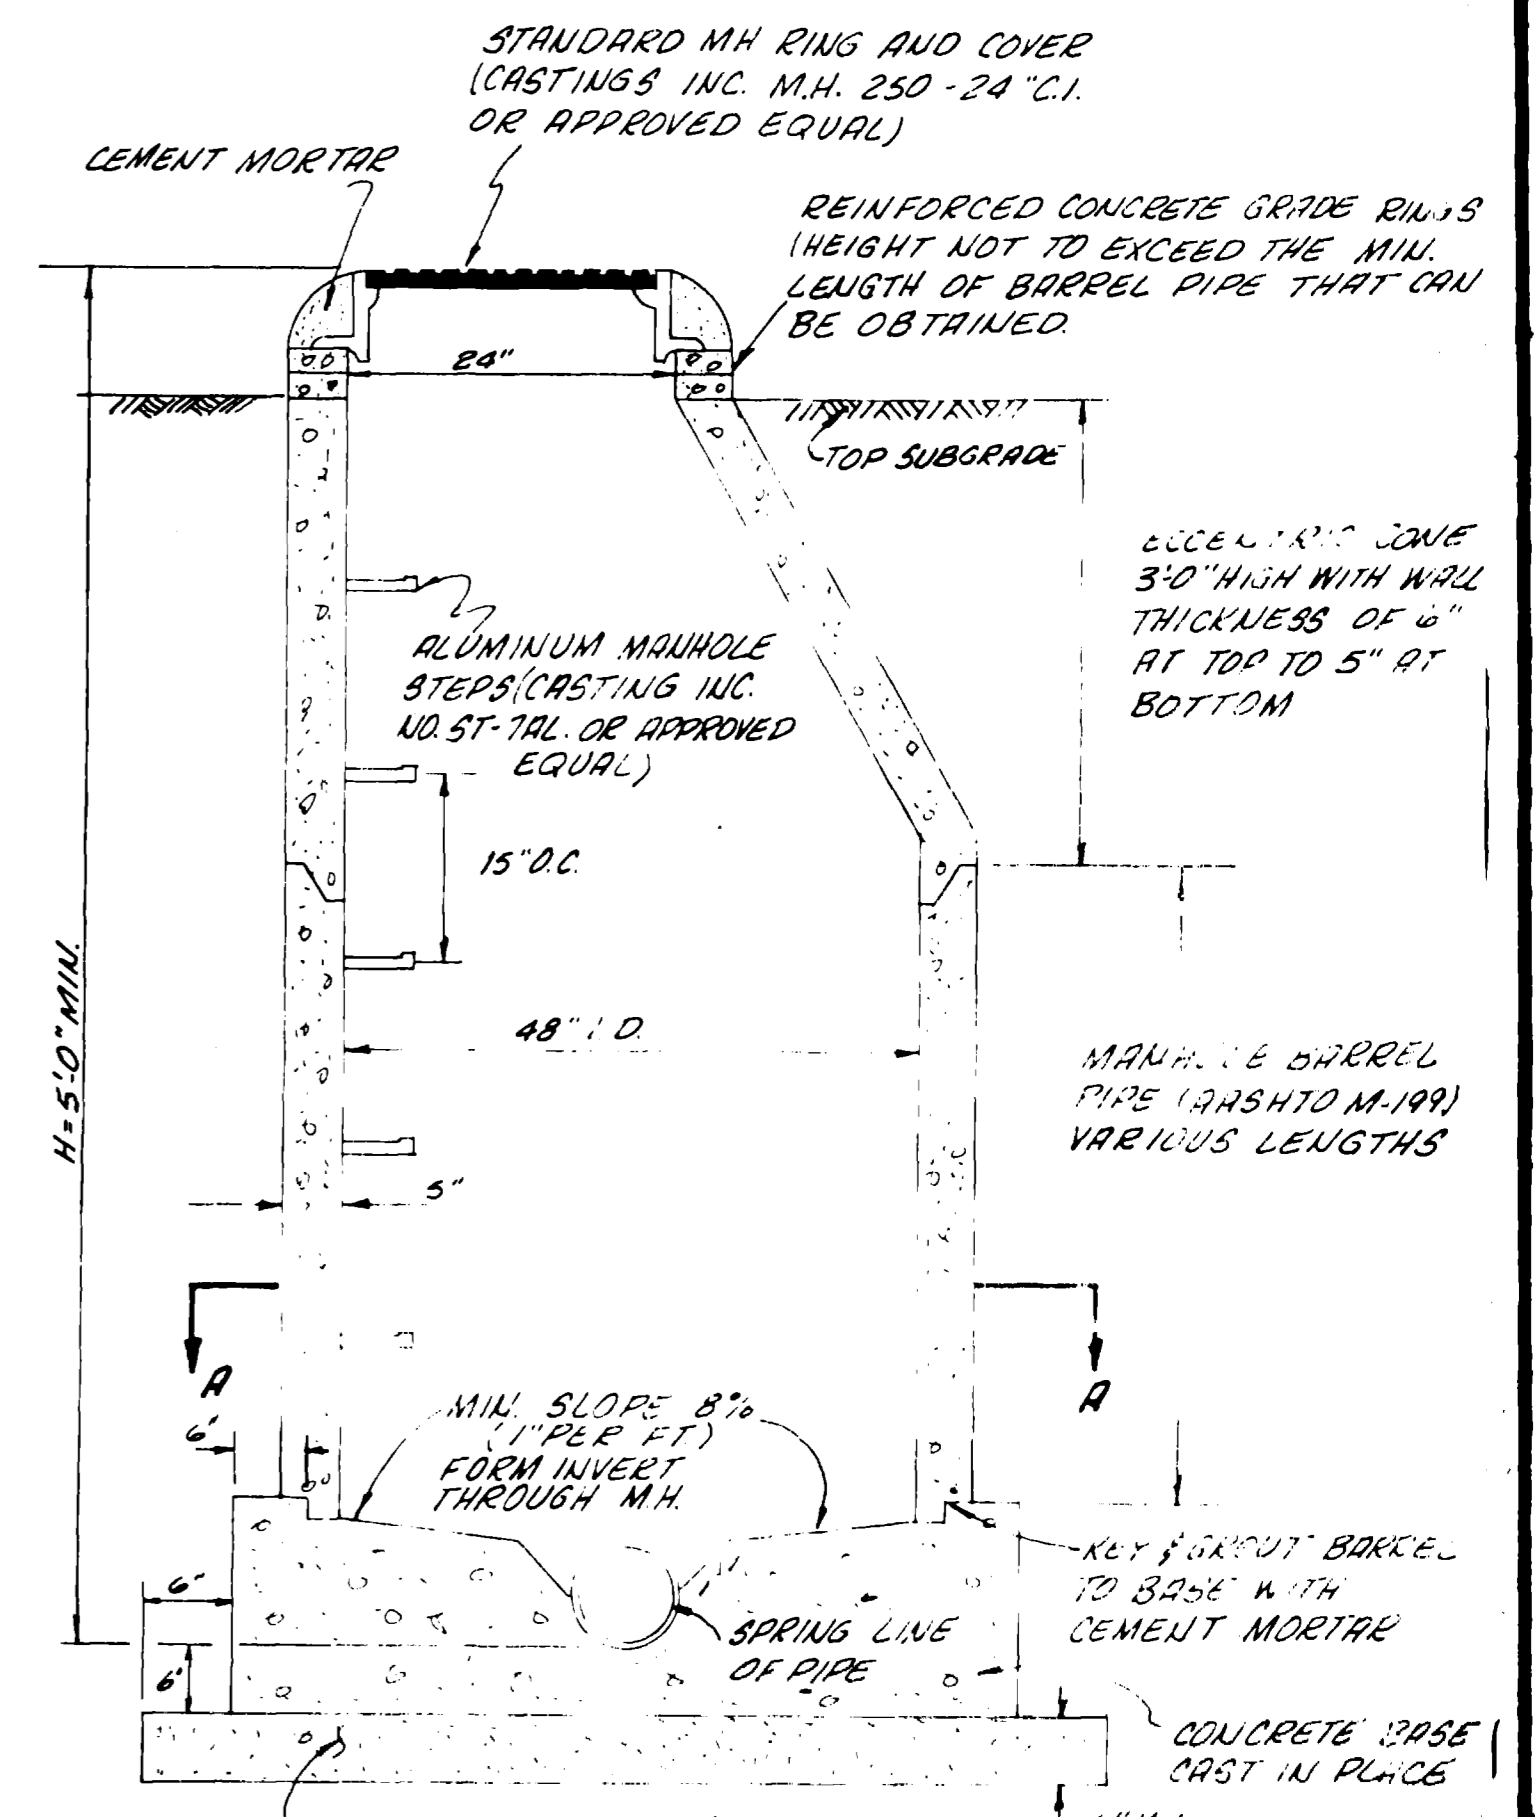

STANDARD MANHOLE

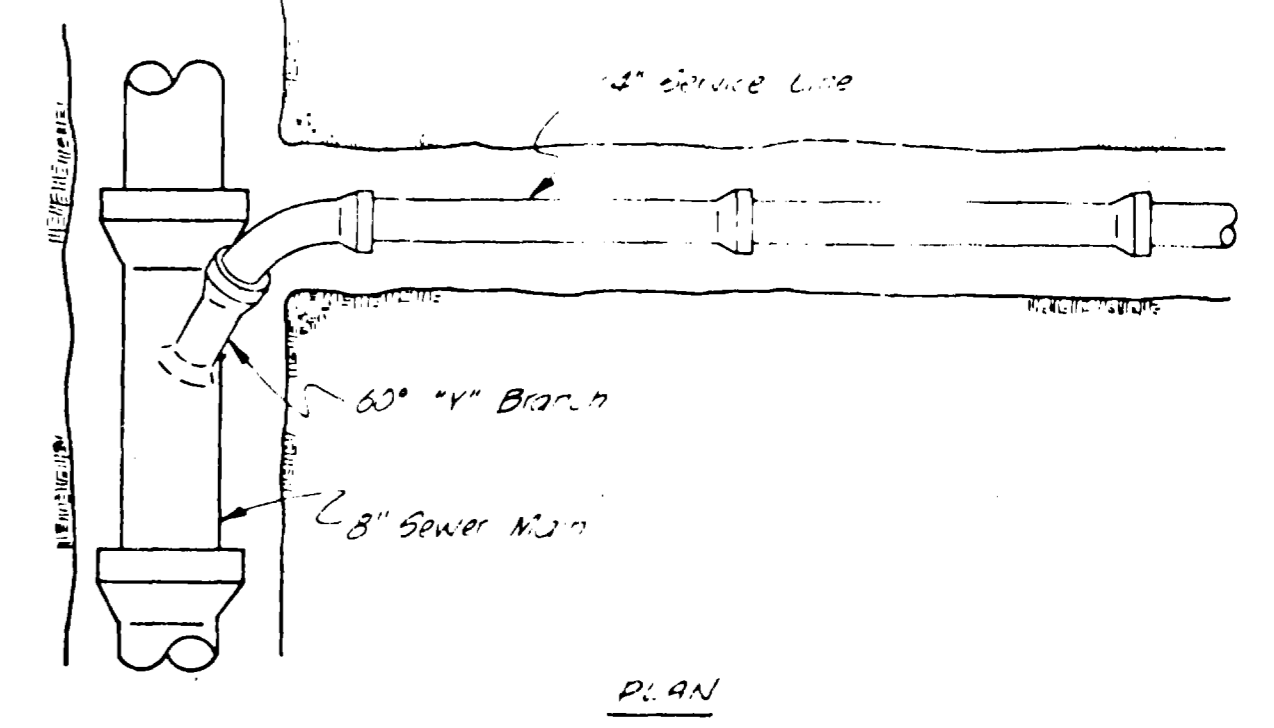


PLAN

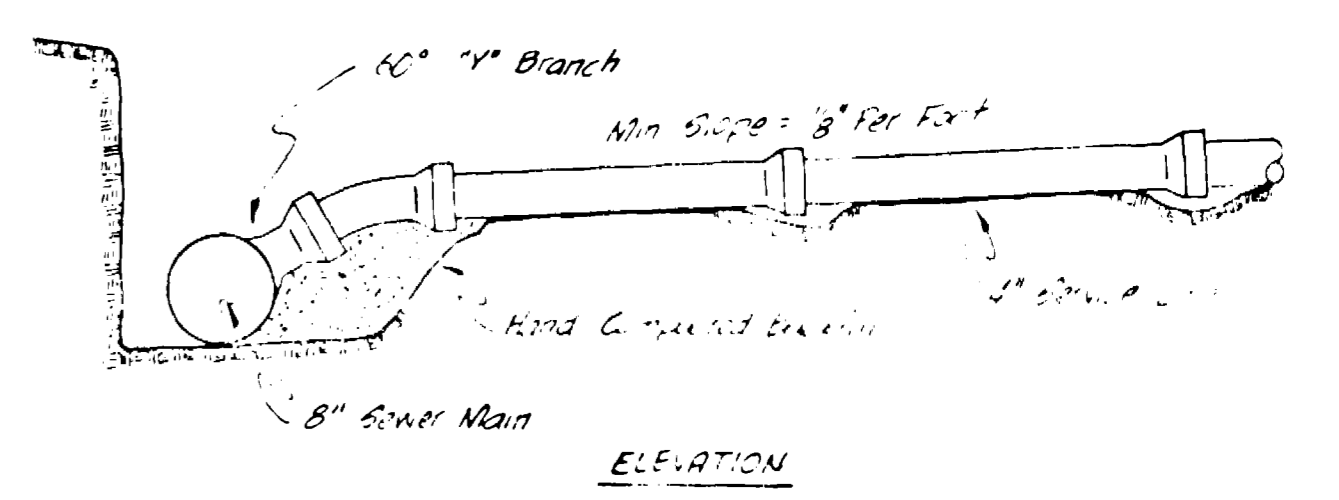

ELEVATION

STANDARD SERVICE CONNECTION

QUANTITIES
 2160.7 L.F. SANITARY SEWER
 9 STANDARD MANHOLES
 43 SERVICE CONNECTION

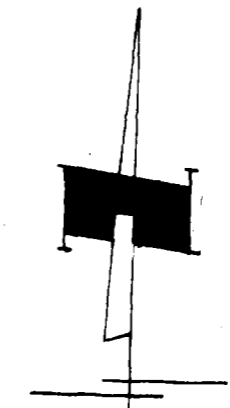



SCALE: 1" = 50'

AS BUILT DRAWINGS



APPROVED _____ DATE: _____

CENTRAL GRAND VALLEY SANITATION DISTRICT

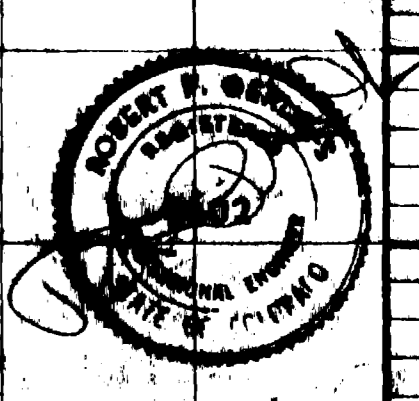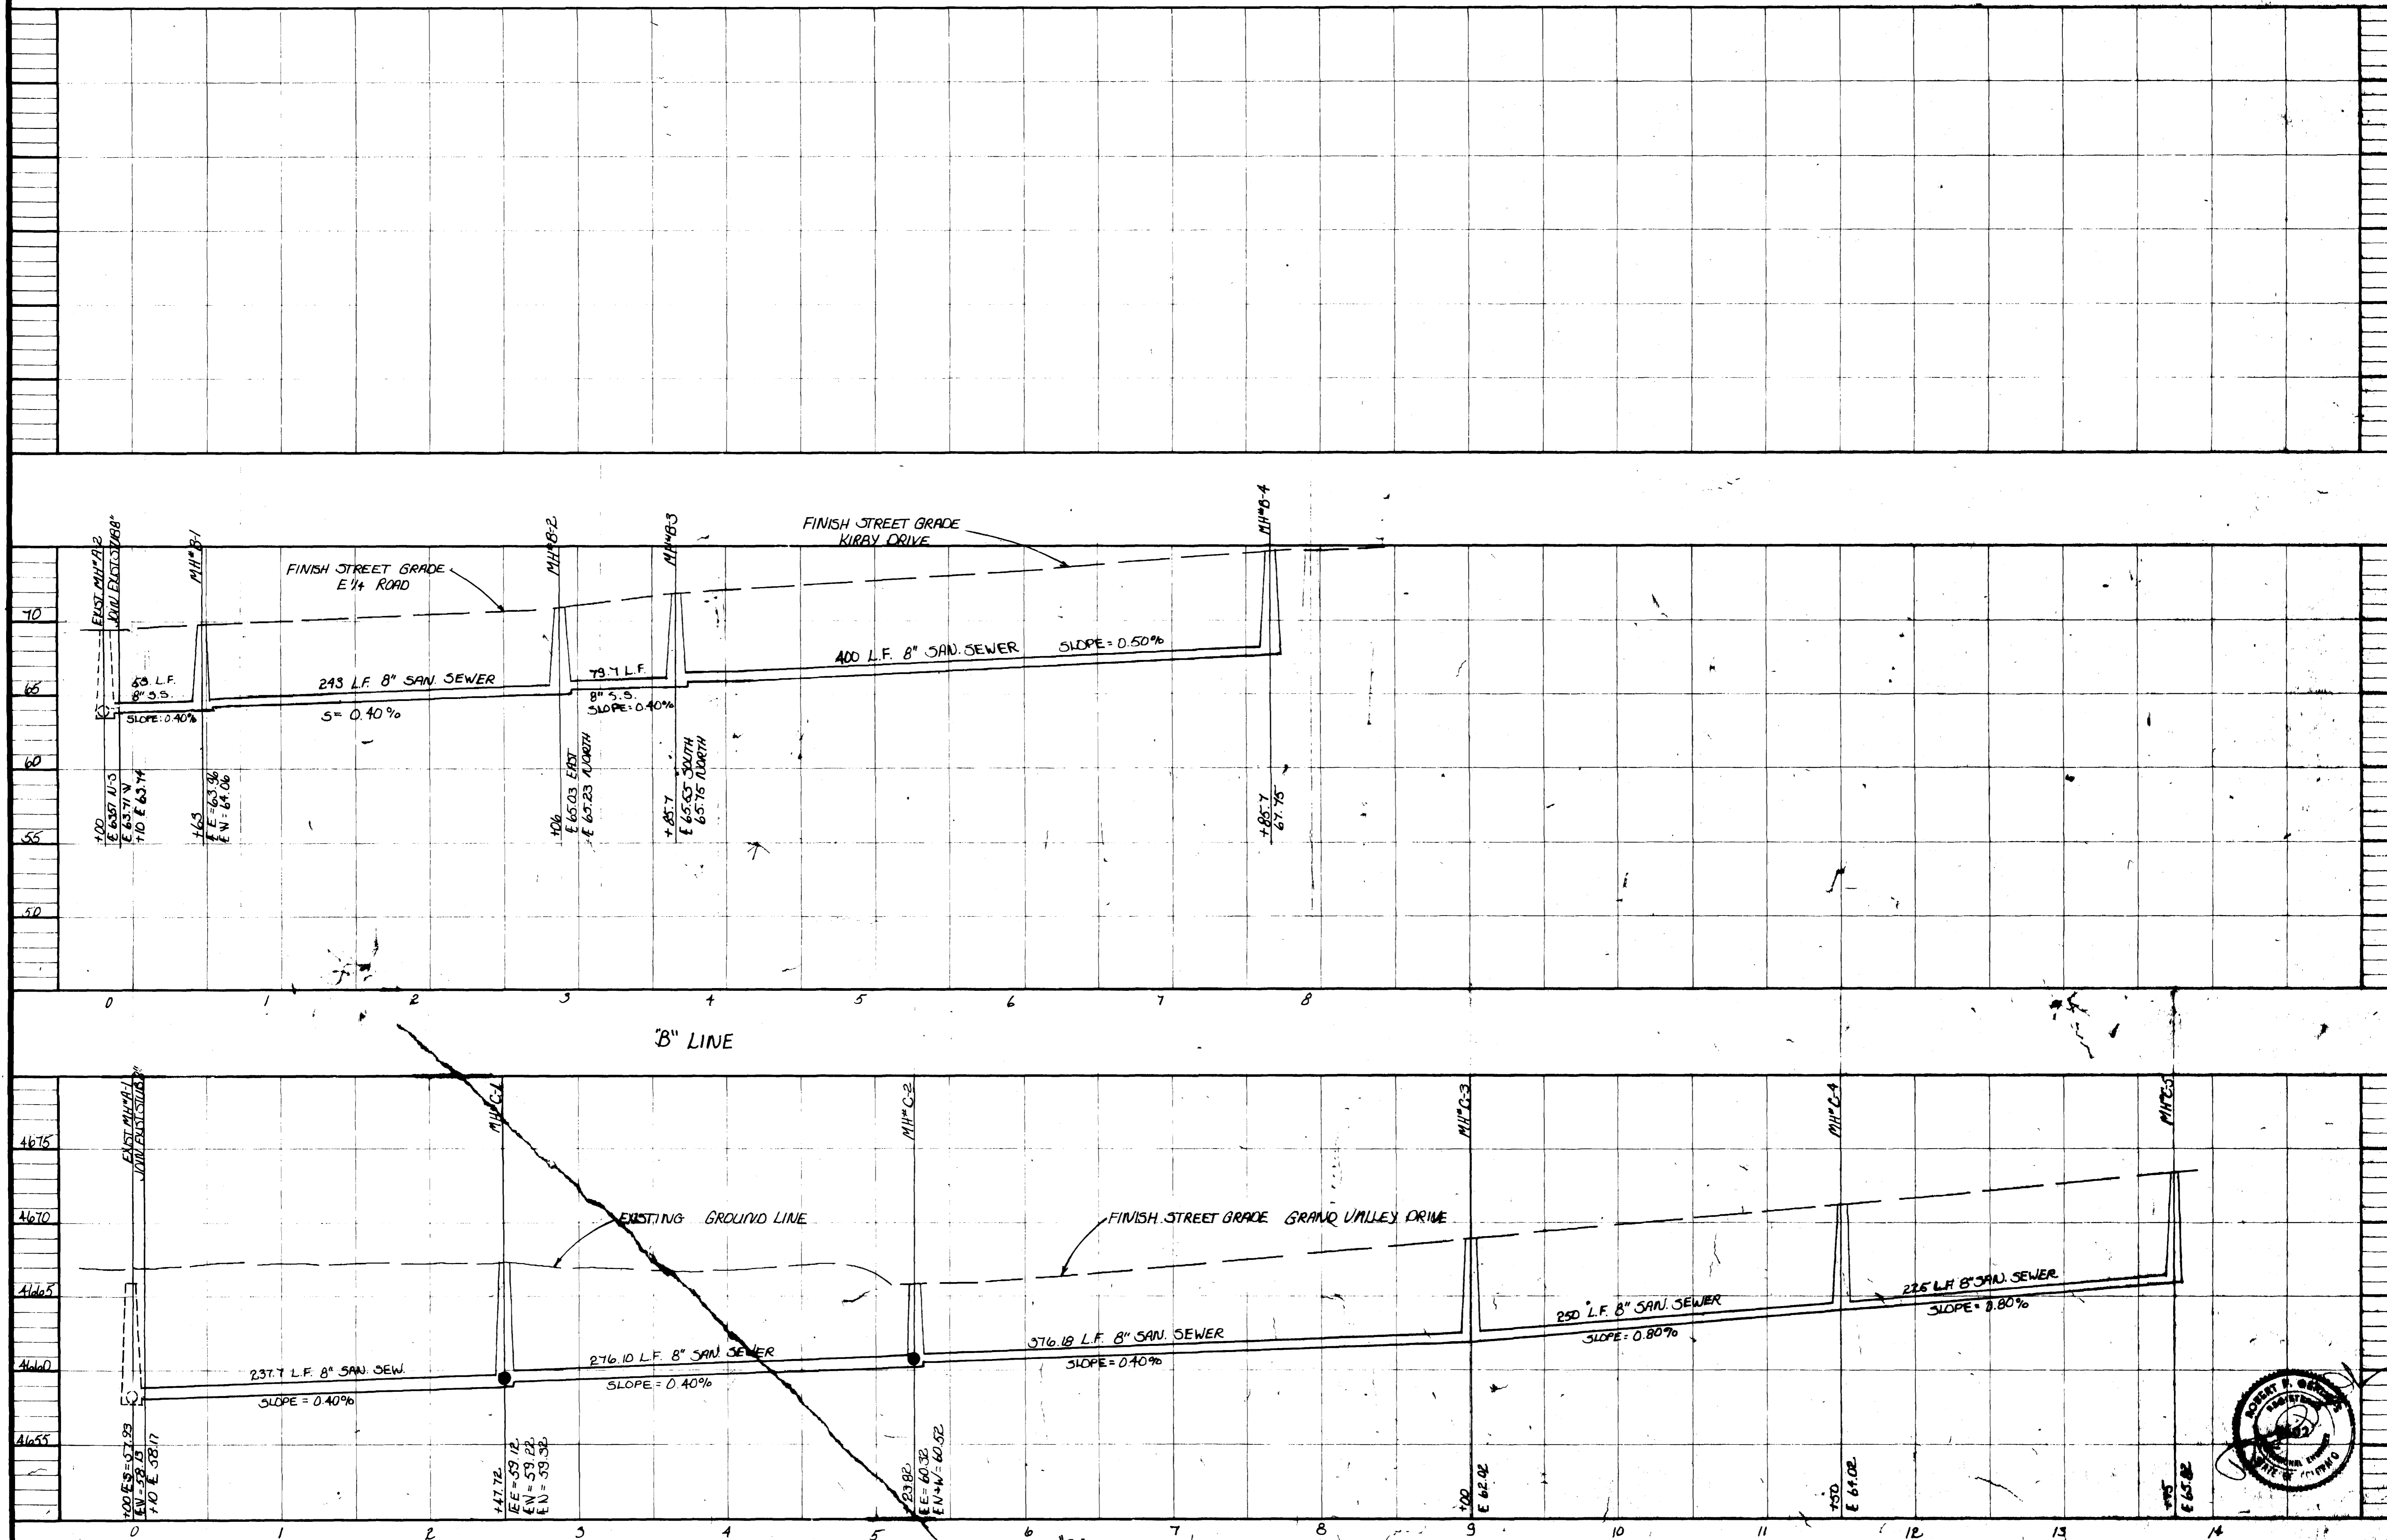

AS BUILT DRAWINGS