



PLAT OF
SEWER DISTRICT N° 4

SHOWING
LINE OF SEWER, BOUNDARY OF DISTRICT AND PROPERTY TO BE ASSESSED
AND THE ESTIMATED ASSESSMENT ON EACH LOT IN DISTRICT
GRAND JUNCTION COLORADO
SCALE 1 inch = 100 feet
JUNE 1912
G. H. Gardner
City Engineer

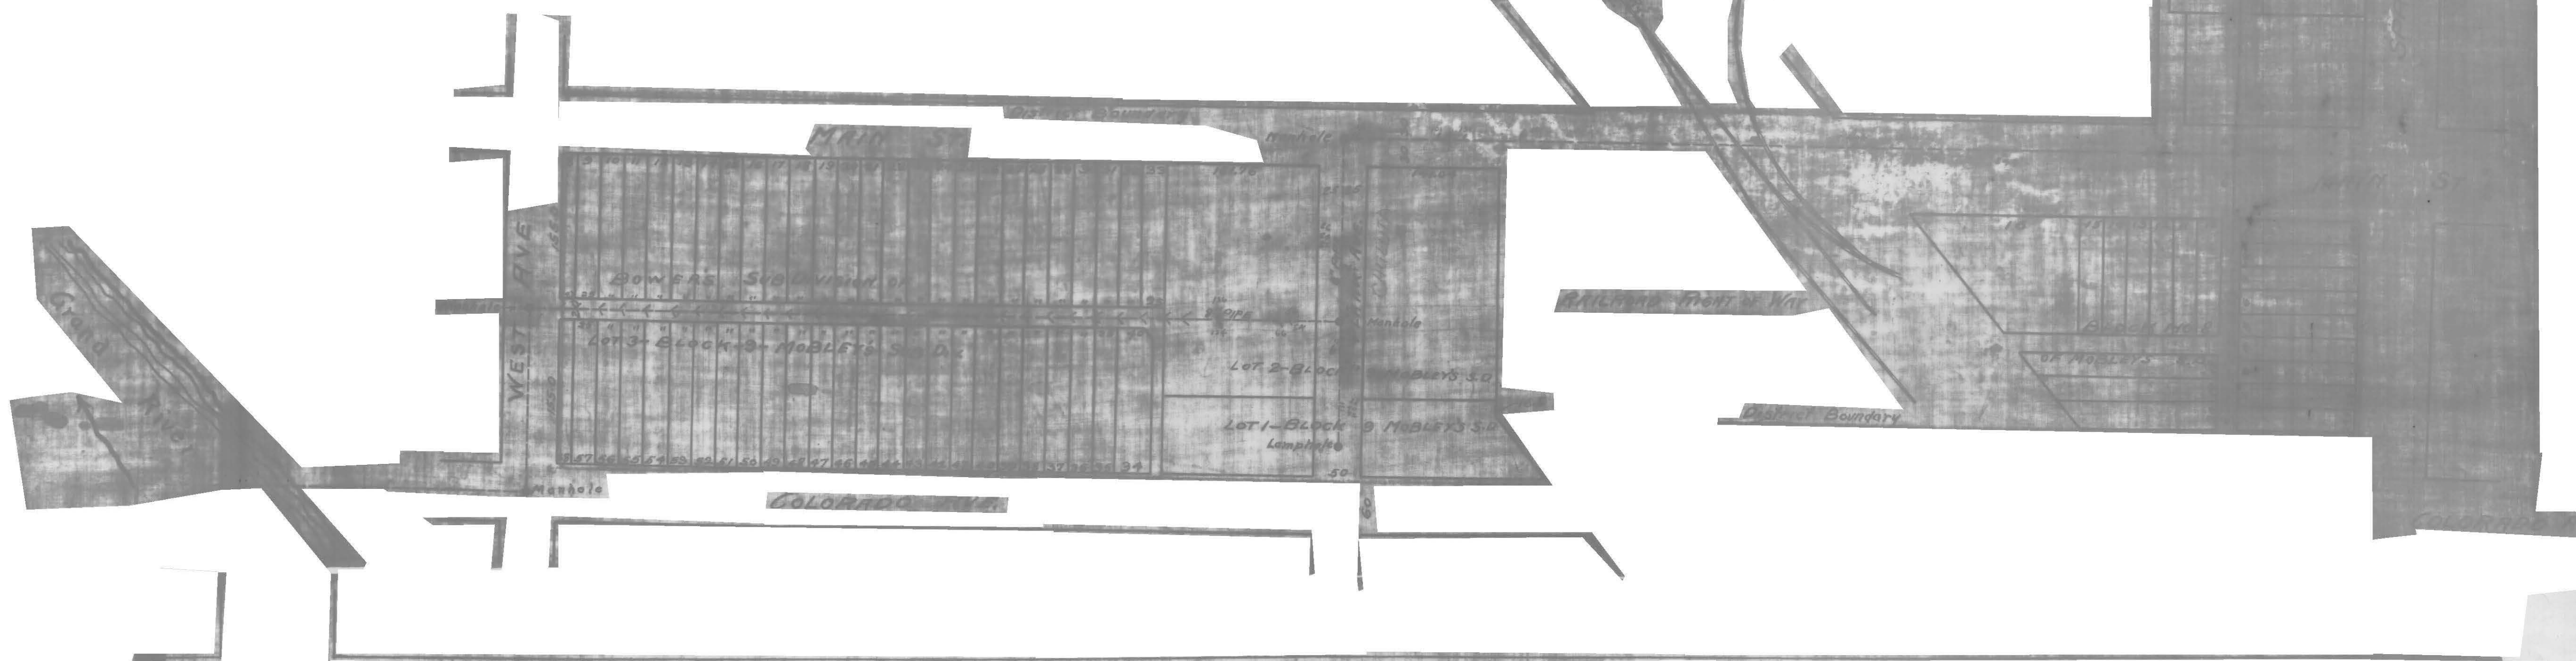

MAIN STREET

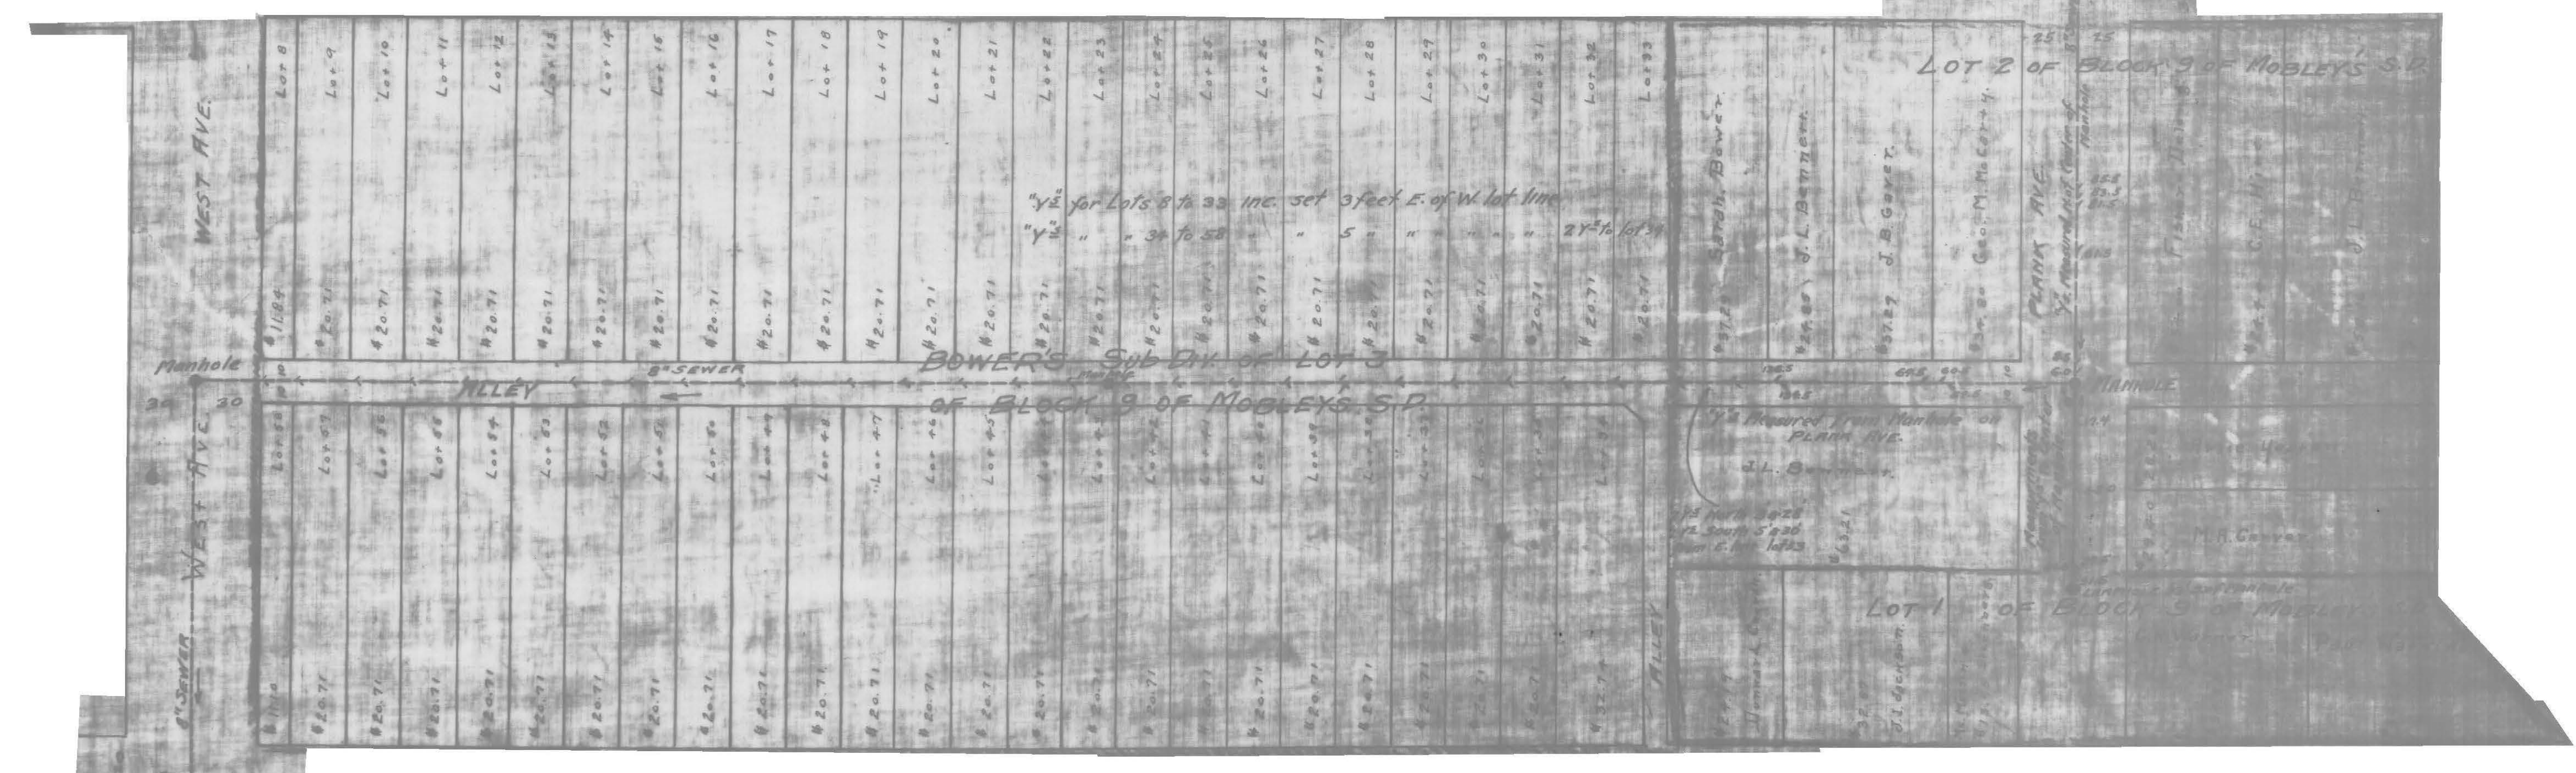

COLORADO AVE

BLOCK 9 OF MOBLEYS S.D.

SEWER DIST. No. 4