


As-Built Drawing

As-Built Drawing

SHOSHONI SUBDIVISION		SANITARY SEWER SYSTEM	
EOR WARREN HOMES PALISADE, COLO.		SURVEYED BY: LTM	DRAWN BY:
SCALE HORIZONTAL 1"=100' VERTICAL 1"=5'		APPROVED BY: RSC	SHEET NO: 1 of 1
DATE 6-30-78	GRAND JUNCTION, COLO.	FILE NO: 78-04-07	

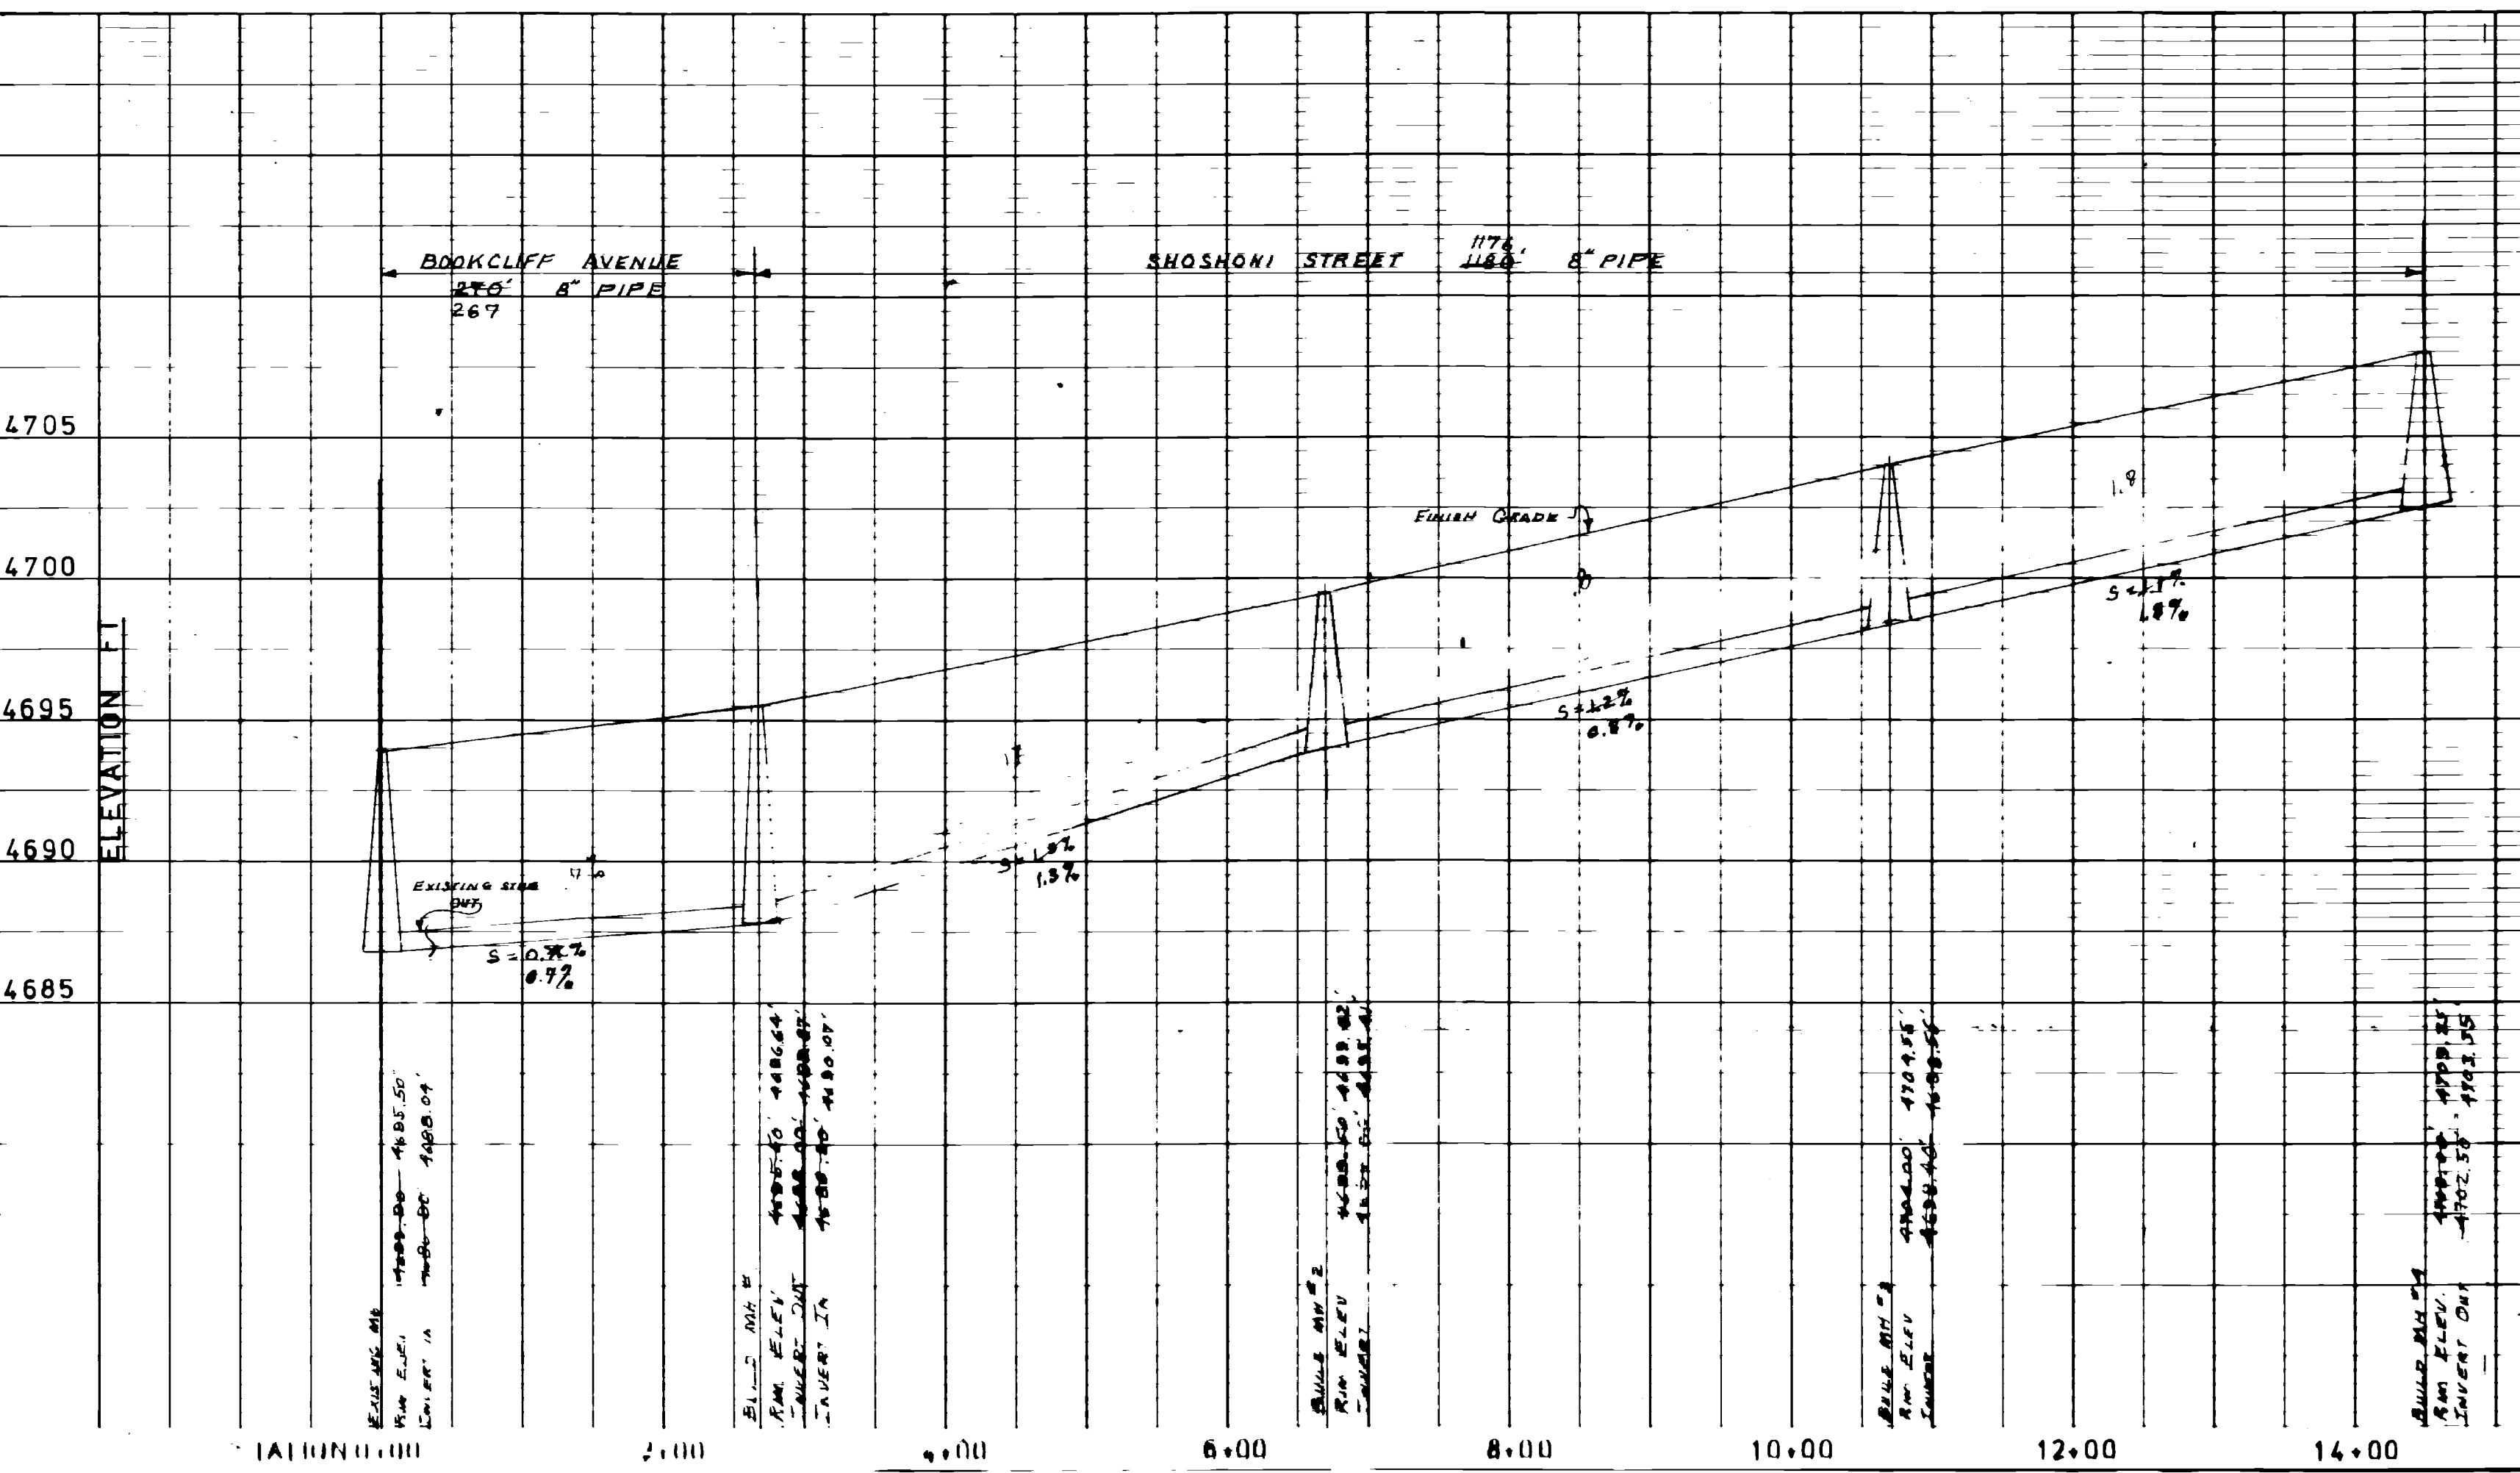

PIPE SPECIFICATIONS

PVC	ASTM D3034	SDR35
TRUSS	ASTM D2680	
ABS	ASTM D2751	SDR35 (LATERALS ONLY)

NOTES

INVERTS IN MANHOLES 24" TO BE FORMED BY RUNNING THE PIPE STRAIGHT THROUGH MANHOLE BASE AT THE PREVIOUS SLOPE - CUT TOP OF PIPE TO MATCH BASE CONTIGUE

CARRY LATERALS A MINIMUM OF 5' INSIDE OF ALL LOT LINES

As-Built Drawing