
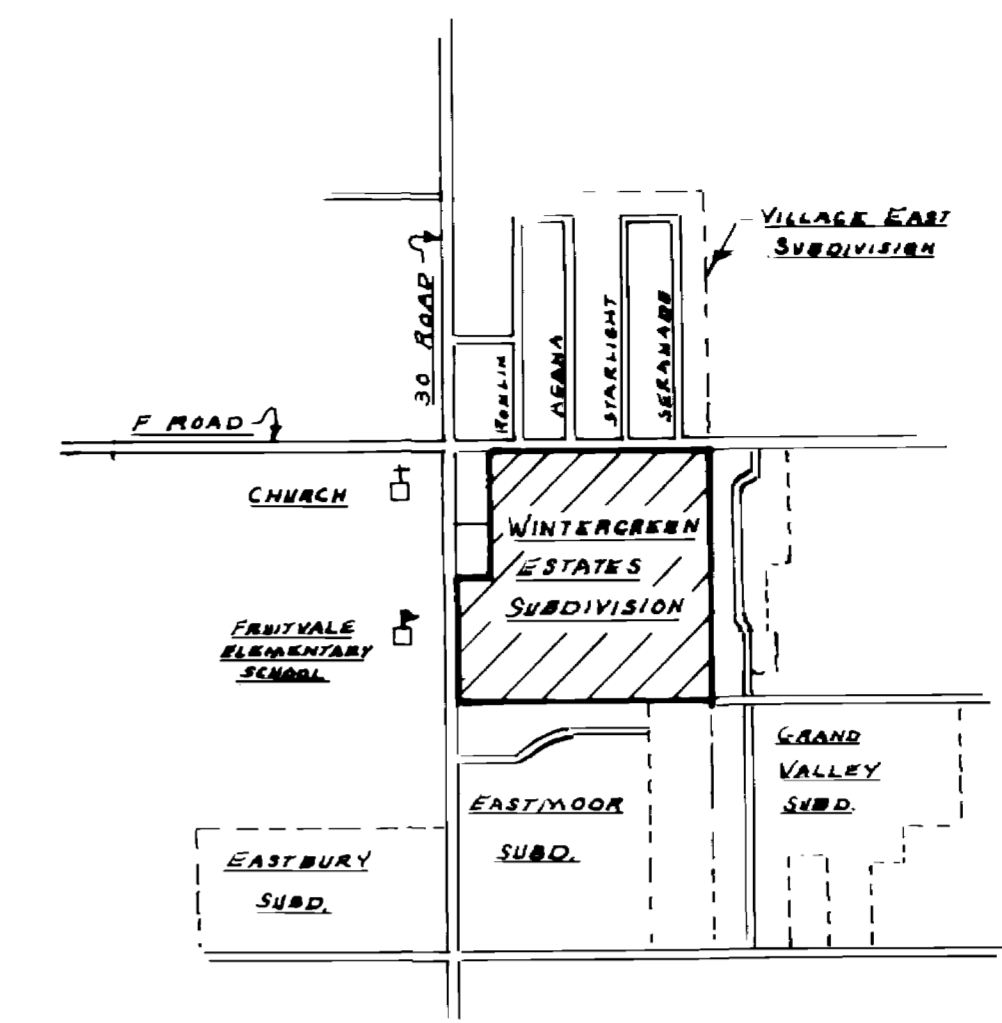


'As - Built Drawing'

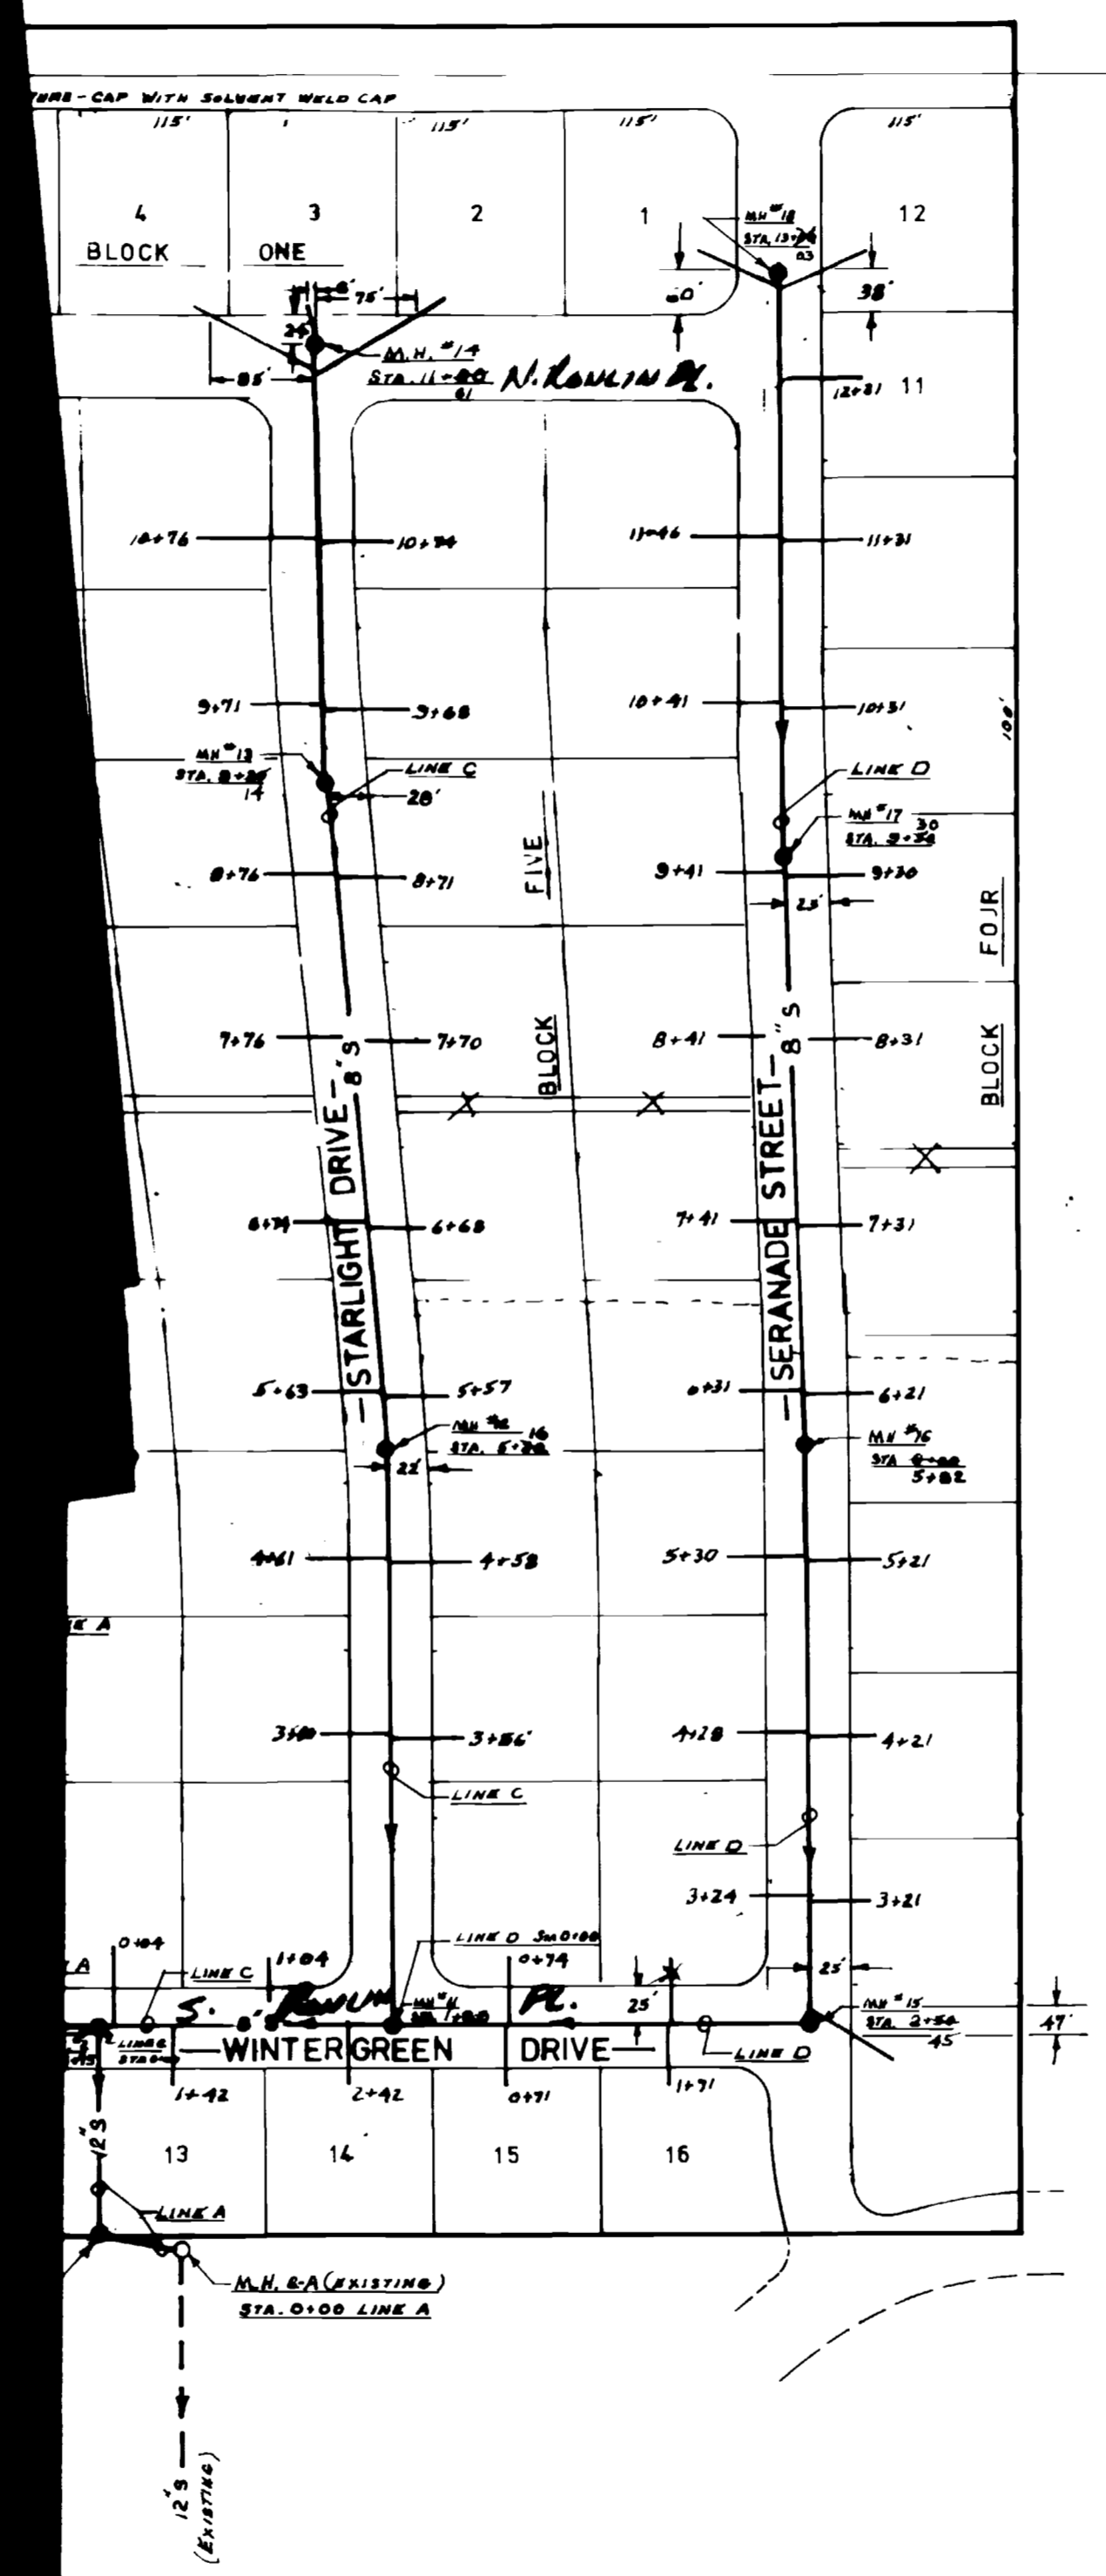

SCALE 1"=100'

- LEGEND:
- — EXISTING MANHOLE
 - — NEW MANHOLE
 - S — SEWER LINE

APPROVALS

APPROVALS	DATE
CENTRAL GRAND VALLEY SANITATION DIST.	
MESA COUNTY HEALTH DEPT. <i>Bonn J. Rooster</i>	4/27/78
MESA COUNTY PLANNING DEPT.	
MESA COUNTY COMMISSIONERS	
COUNCIL OF GOVERNMENTS	
GREENTREE, INC. (OWNER) <i>Oliver L. ...</i>	4/27/78




'As - Built Drawing'

NOTE:
LOTS 1-6, BLOCK SIX, ARE TAPPED TO EXISTING 8" LINE
NO NEW LINE REQUIRED.


PIPE SPECIFICATIONS:
PVC ASTM D3034 SDR 35
TRUSS ASTM D2680
ABS ASTM D2751 SDR 35 (LATERALS ONLY)

'As - Built Drawing'


WINTERGREEN ESTATES		
SANITARY SEWER SYSTEM		
GREENTREE, INC.		PLAN VIEW
SURVEYING BY:		SCALE: 1"=100'
ENGINEERING BY: R. S. COBURN P.E. #7444		DATE: 4-21-1978
APPROVED BY:		SHEET 1 OF 2
		FILE NO. 78-03-07

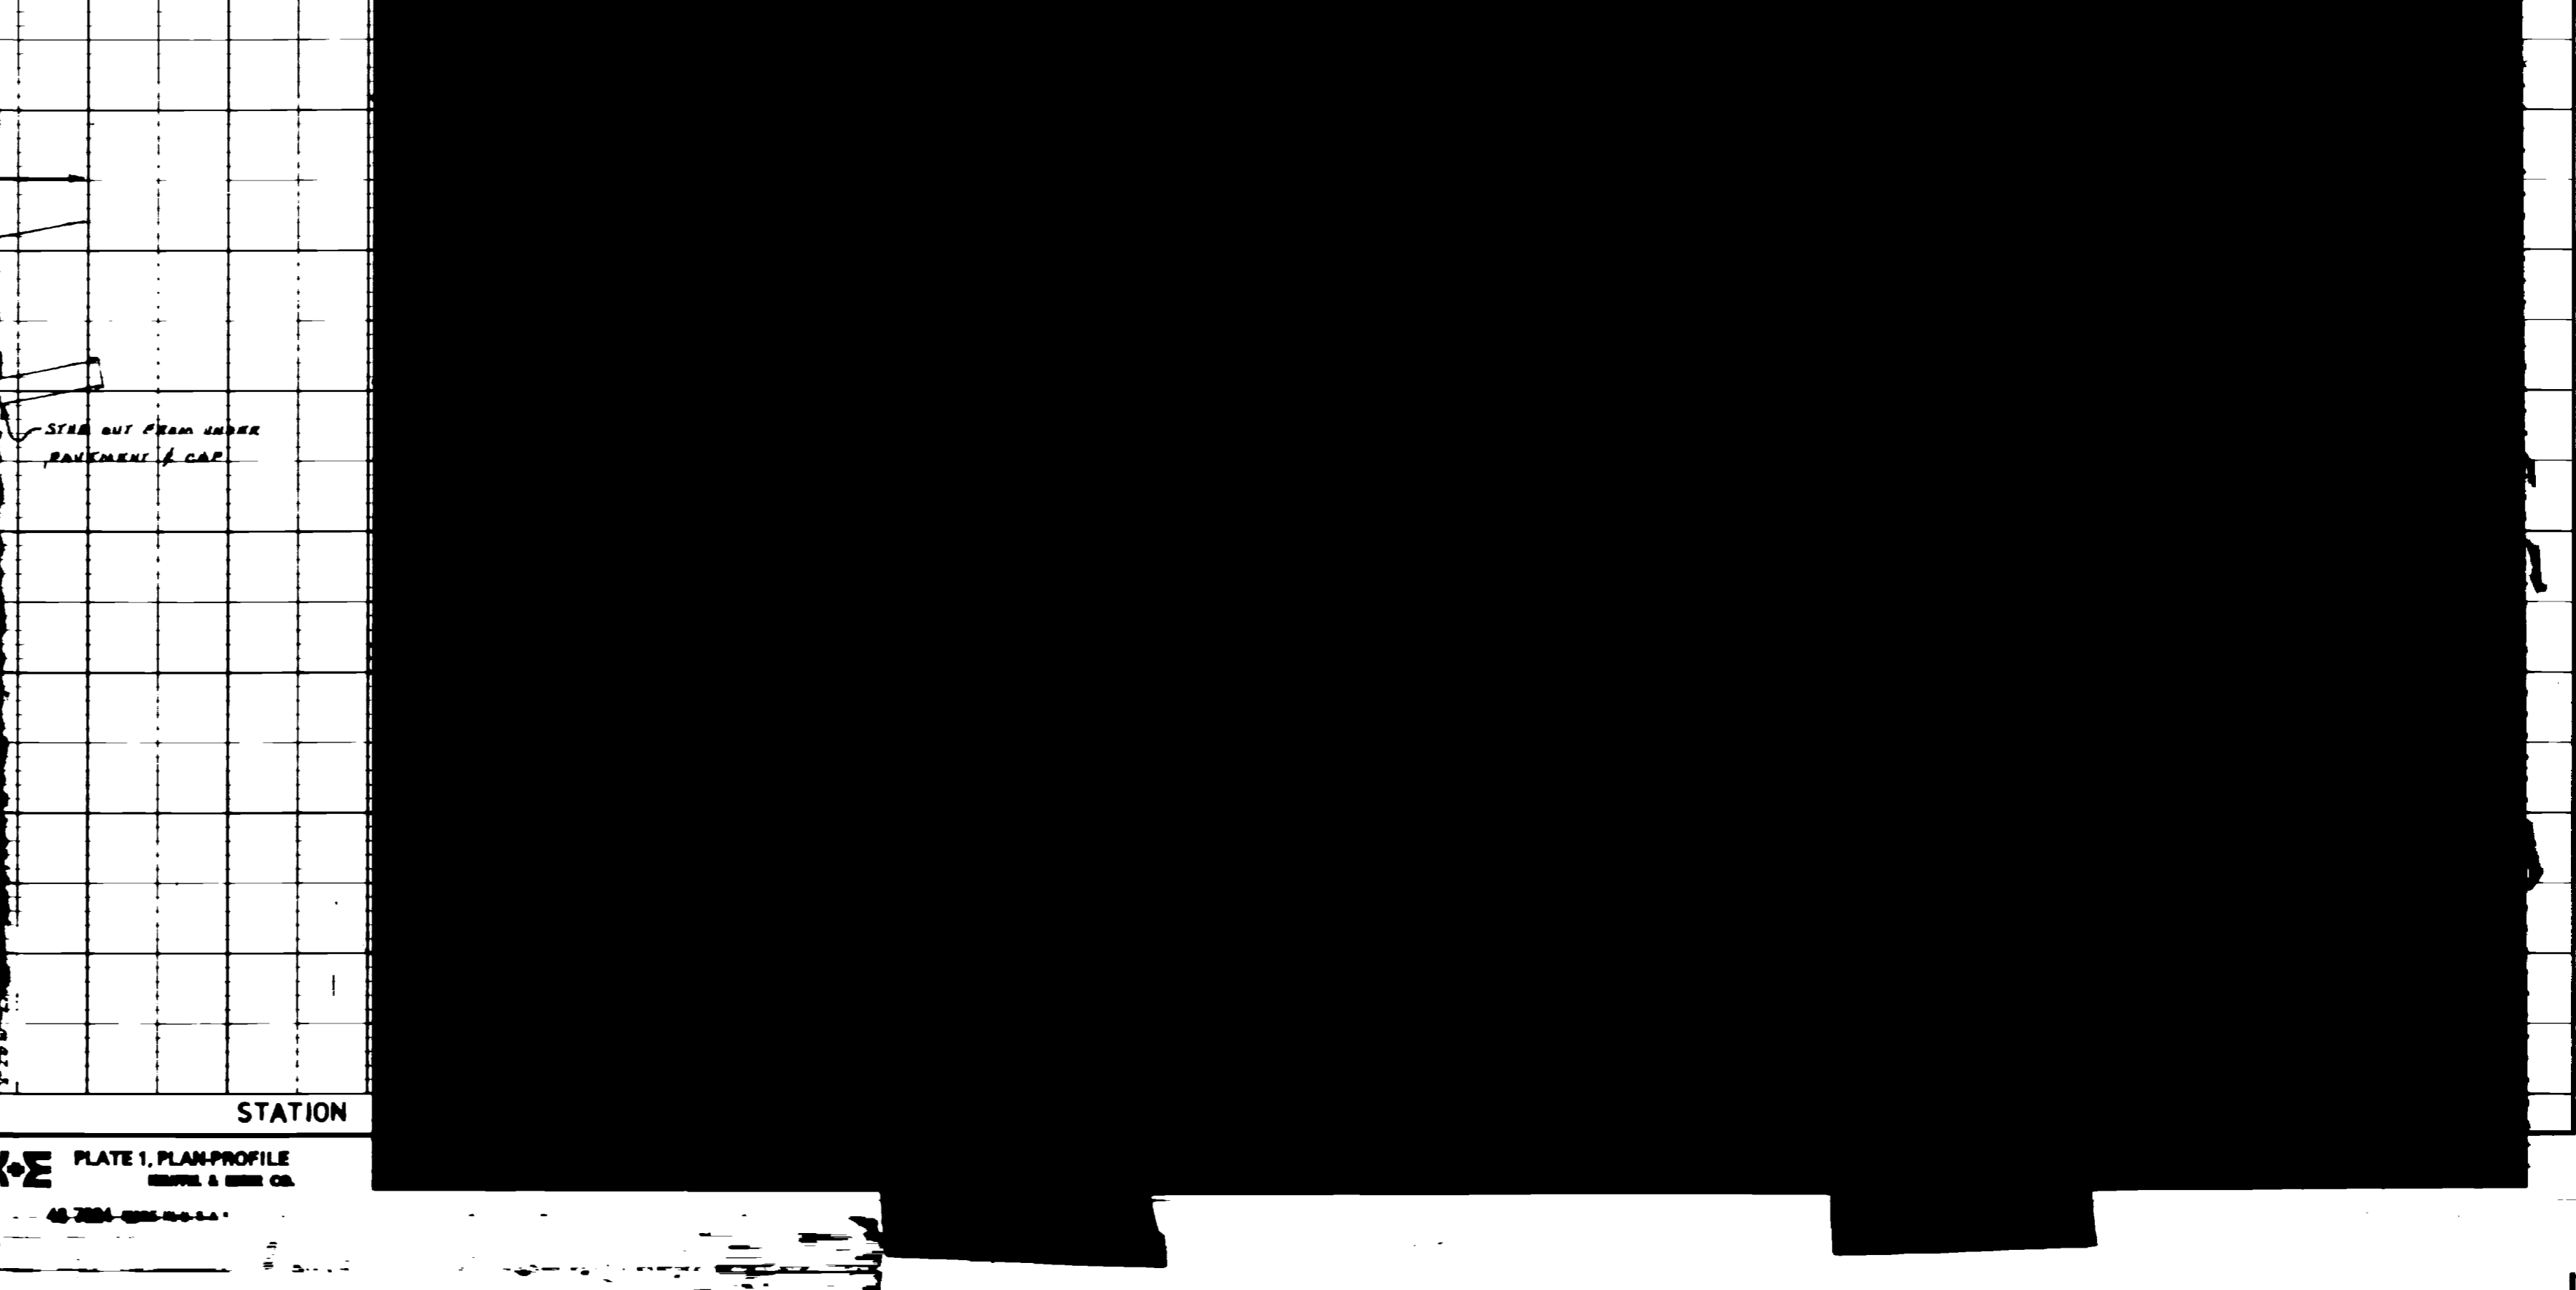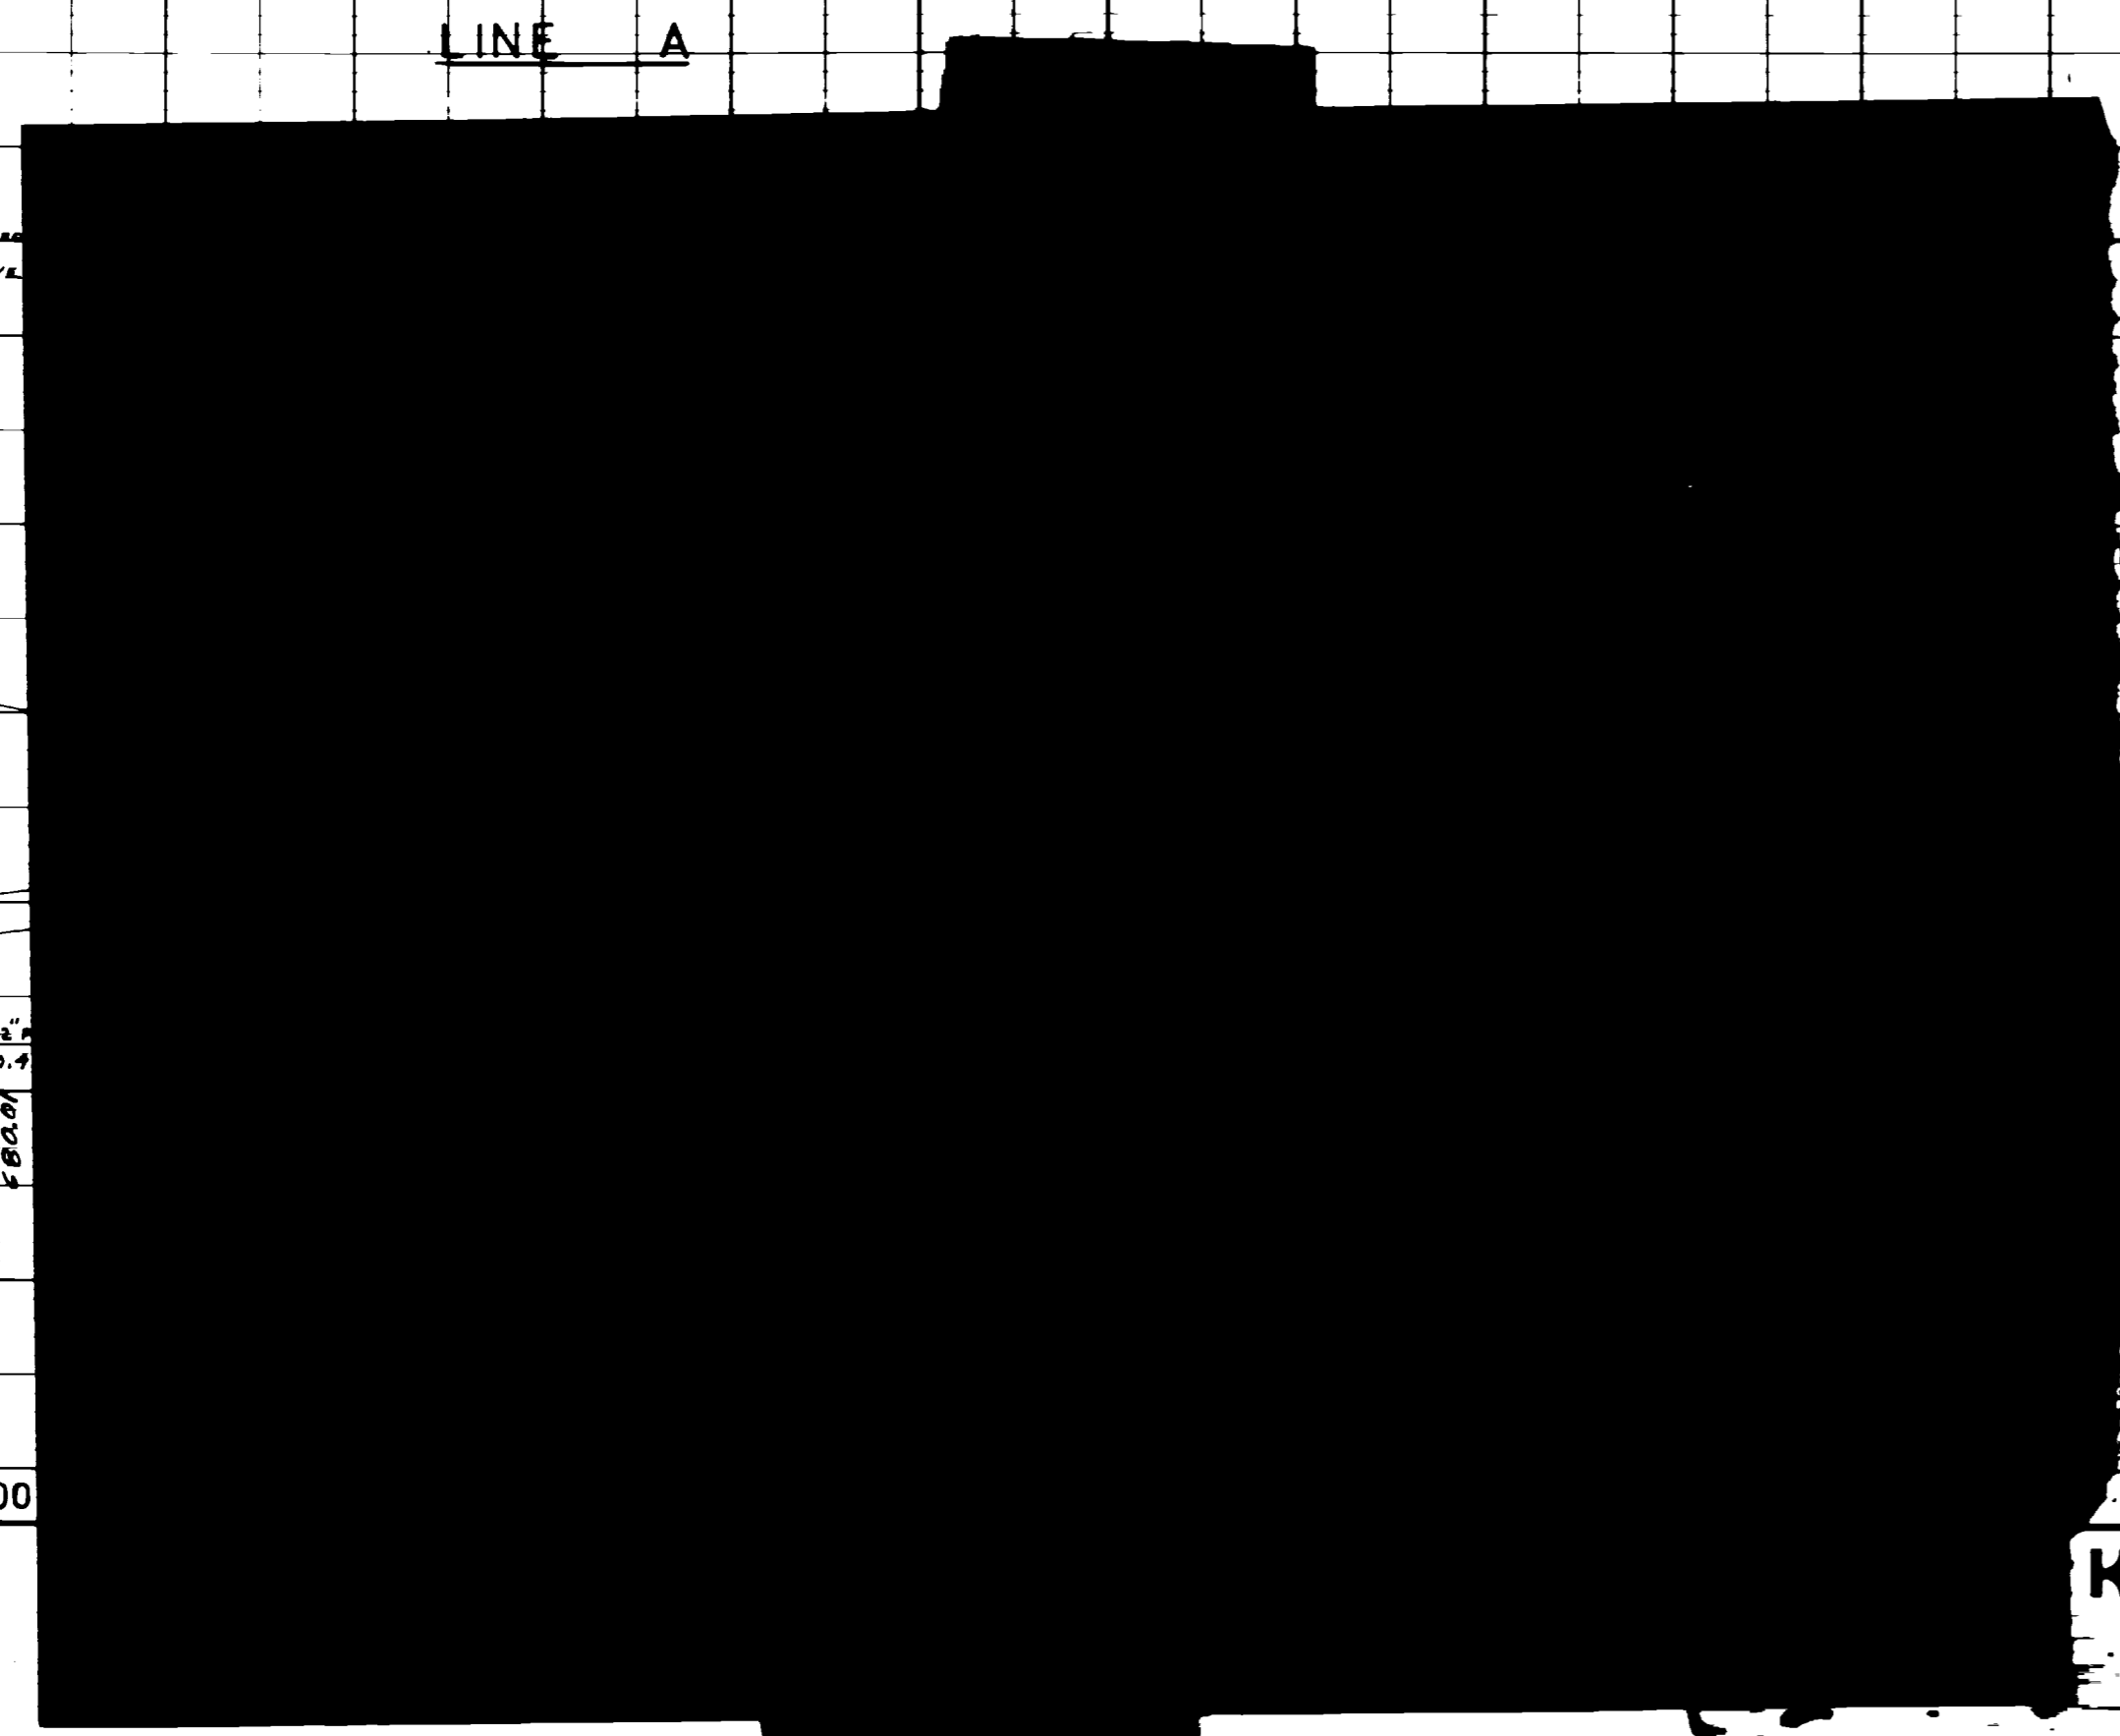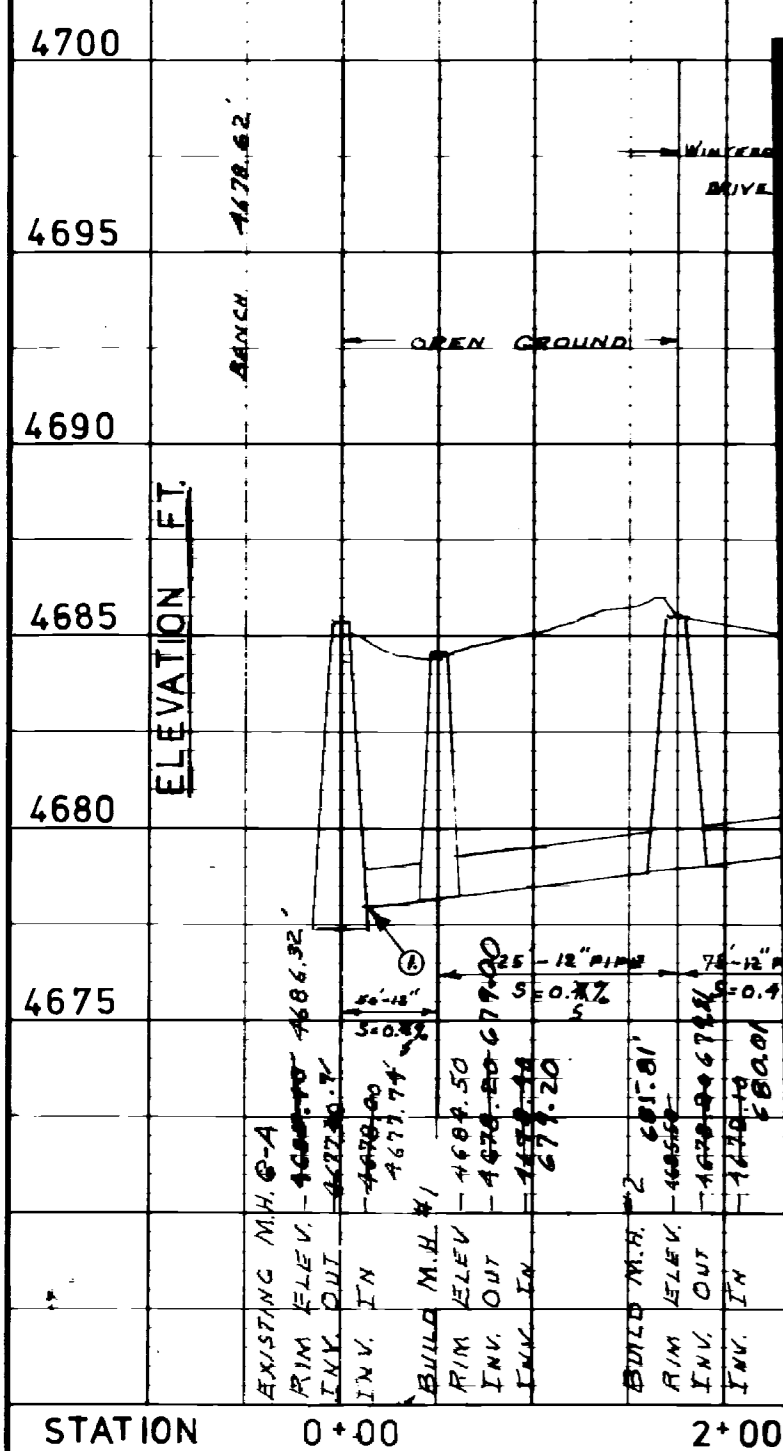

K&E PLATE 1, PLAN-PROFILE
KUPPE & BERR CO.
48 7024 MADE IN U.S.A.

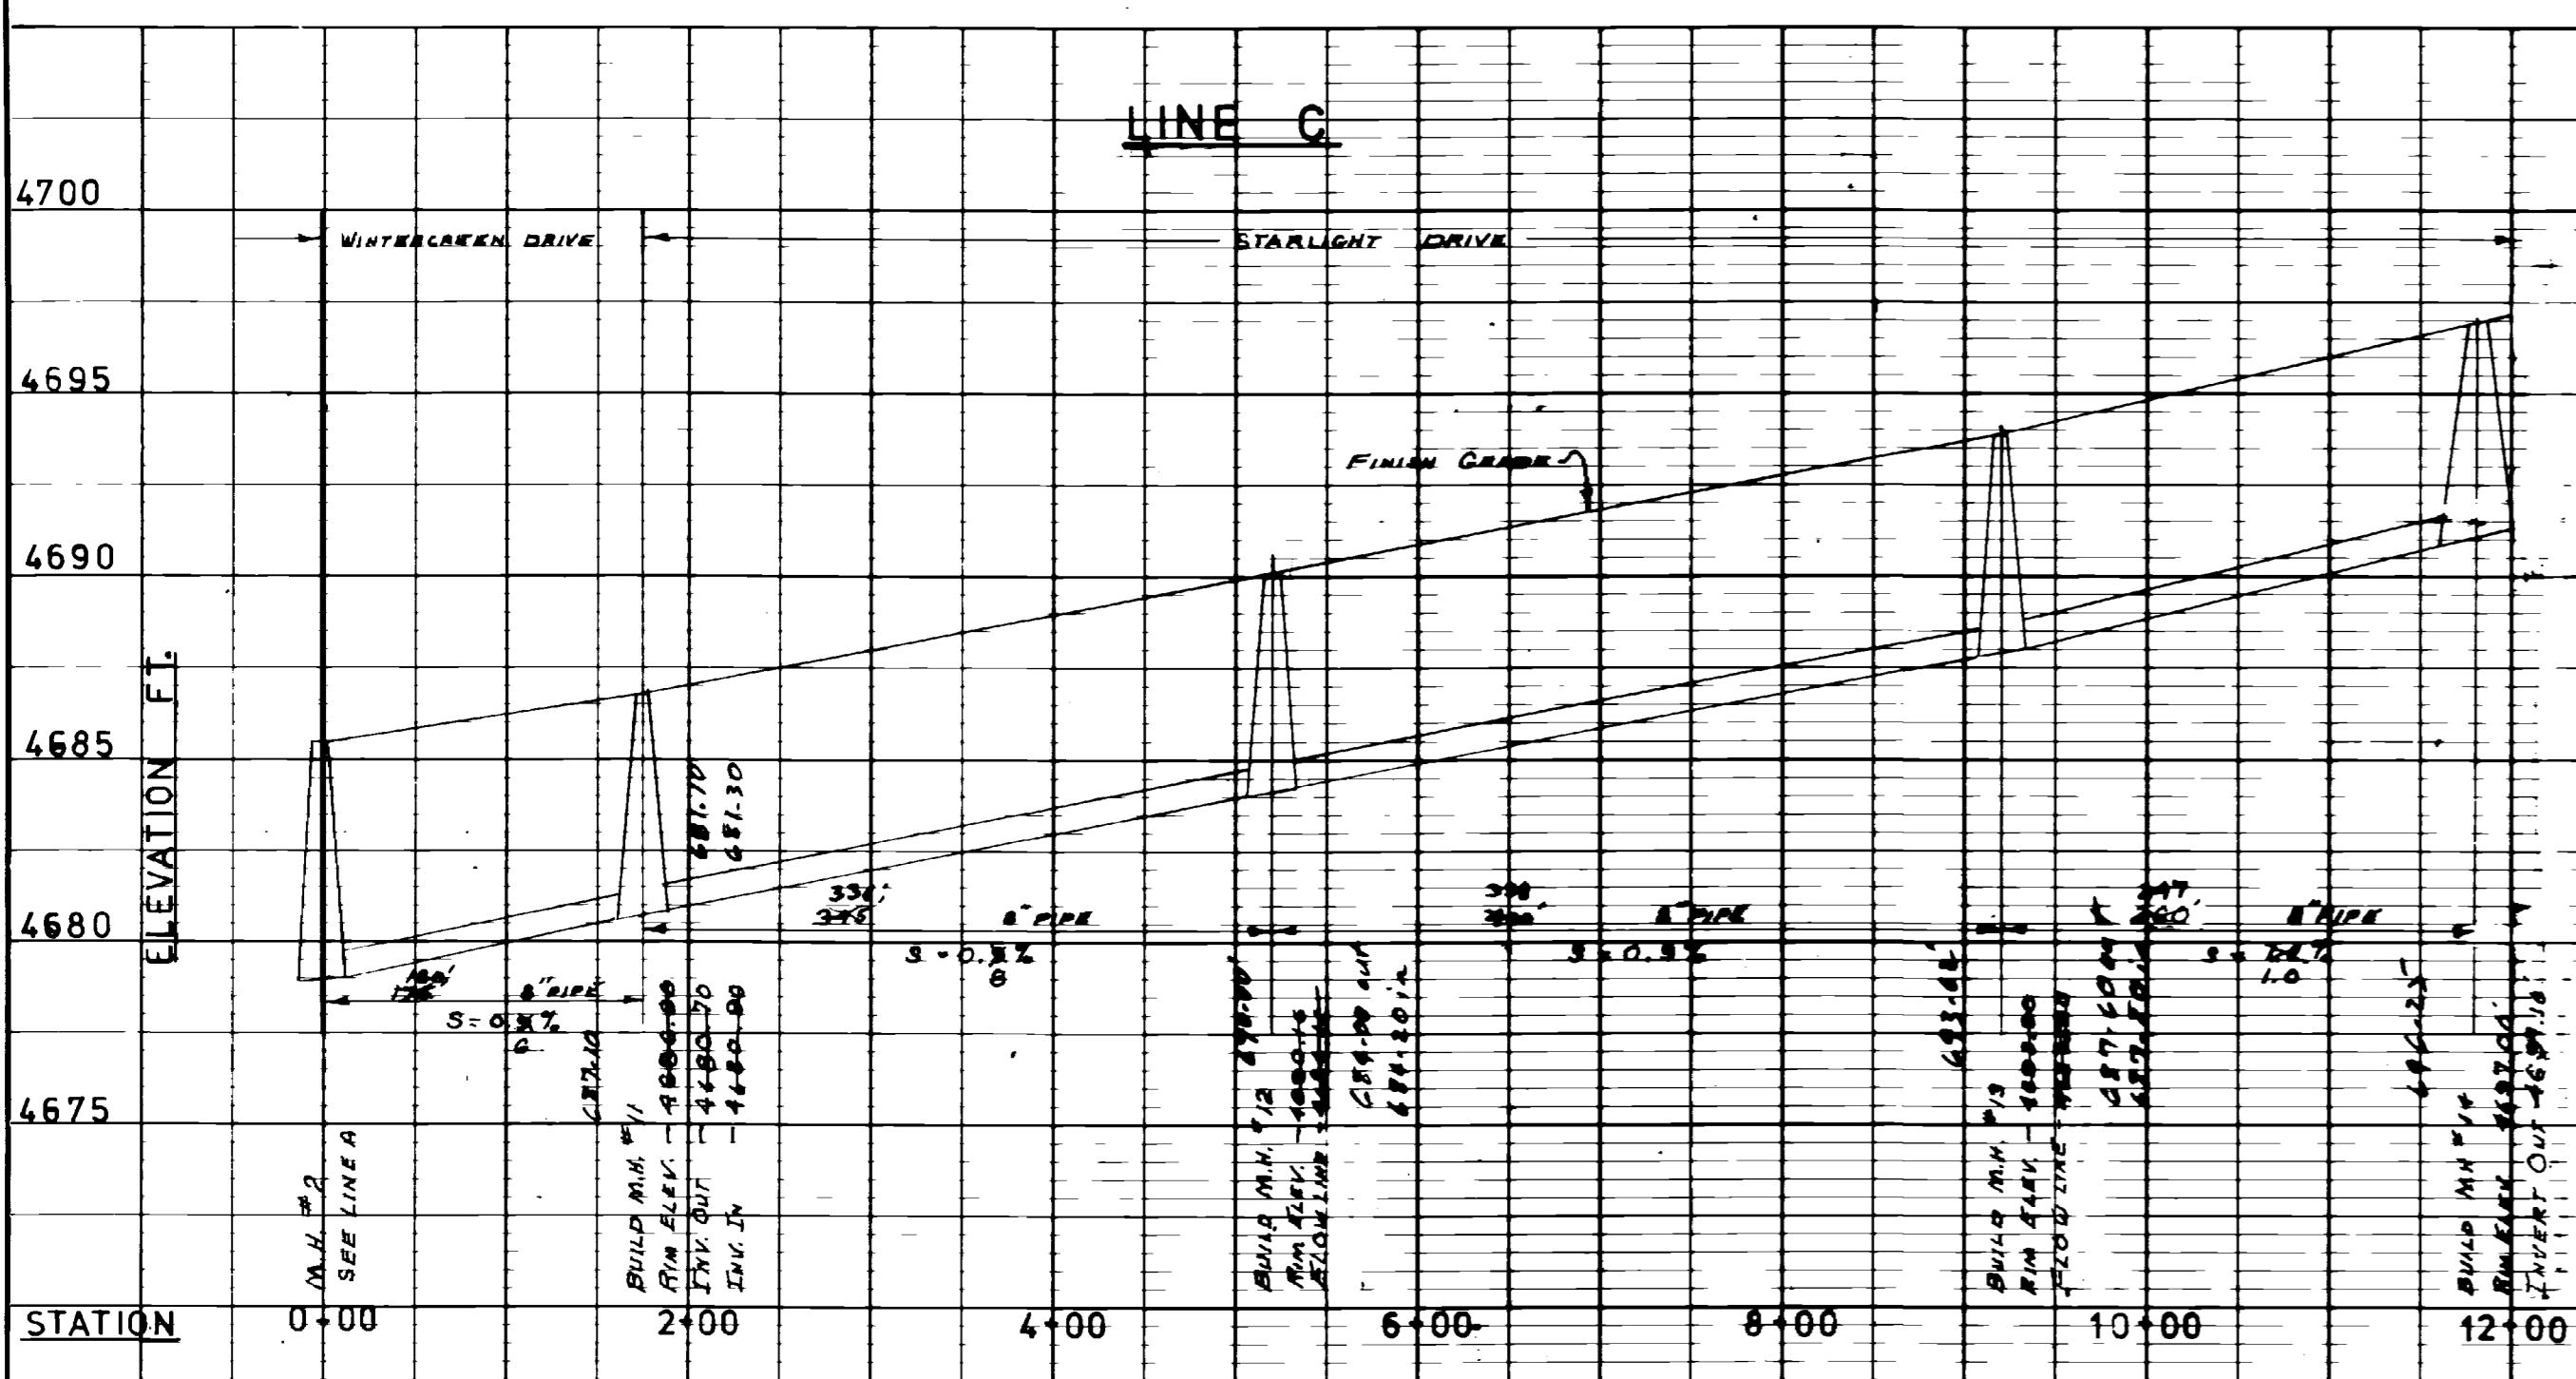

'As - Built Drawing'

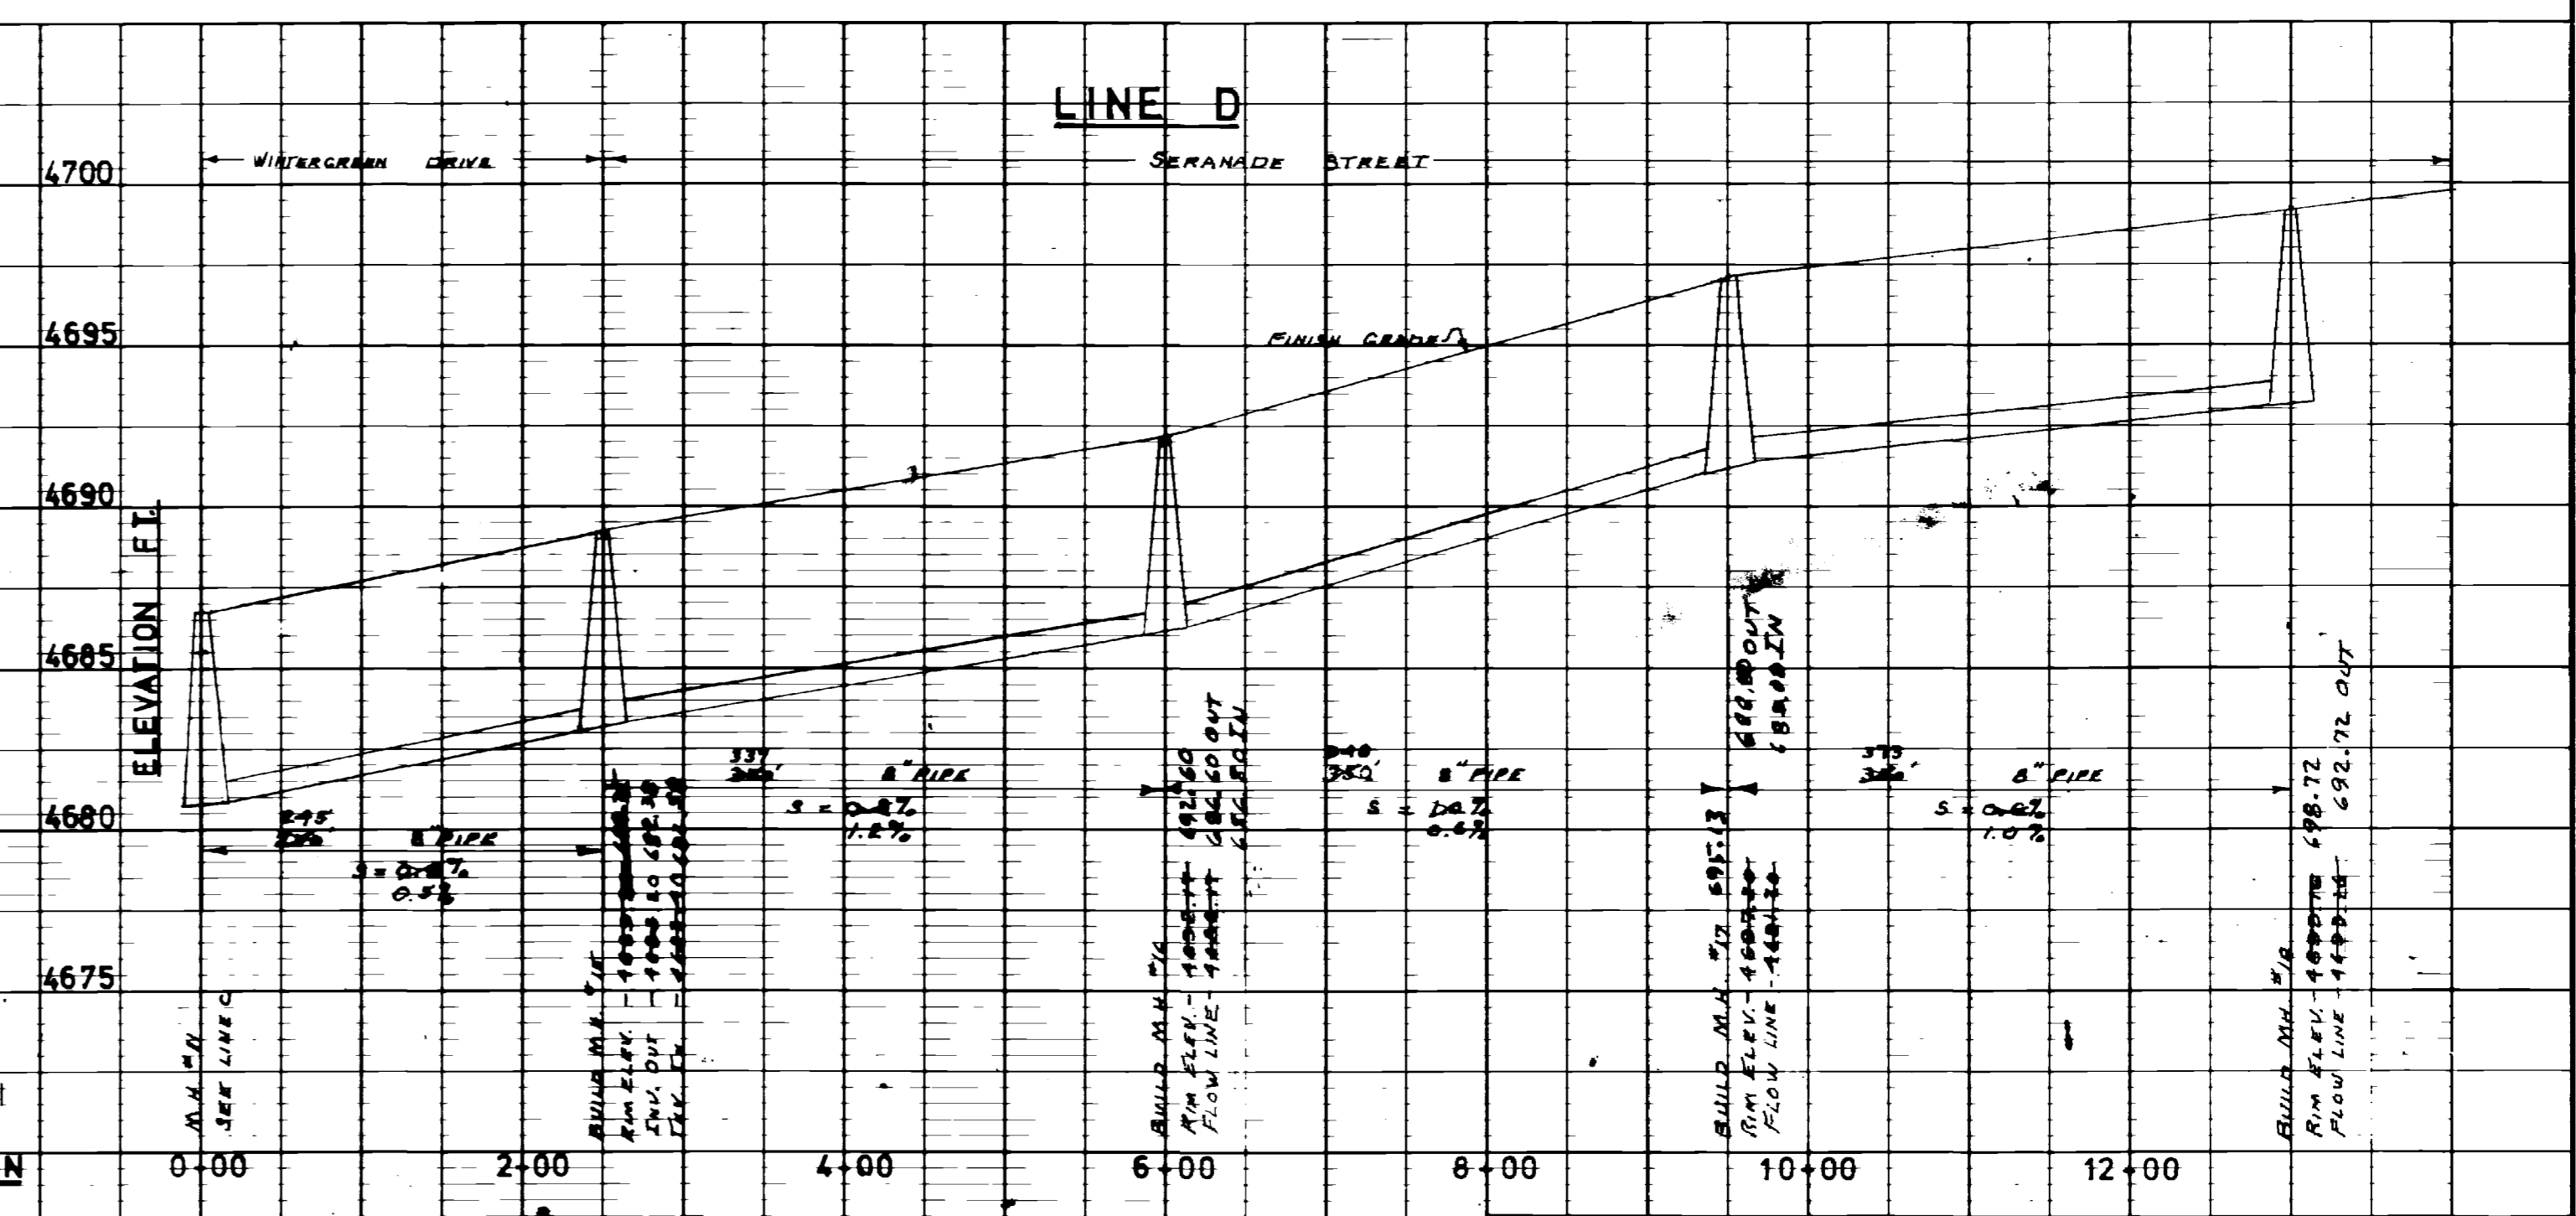

NOTES:
1. EXISTING MANHOLES ABOVE THE BASE.
2. STRAIGHT THROUGH MANHOLES - INVERT MARKED BY RAINING PIPE TOP.
3. STRAIGHT BASE AT PREPARING SLOPE & CAPING FOR ABOVE.
4. BASE CONFORM.

PIPE SPECIFICATIONS:
PVC ASTM D 3034 3DR 15
TRUSS ASTM D 2680
ABS ASTM D 2751 3DR 35 (LATERALS ONLY)

**WINTERGREEN ESTATES
SANITARY SEWER SYSTEM**

GREENTREE INC	 ENGINEERS INC.	PROFILE VIEW
SURVEYING BY:		HORIZONTAL SCALE 1" = 100'
ENGINEERING BY:		VERTICAL SCALE 1" = 5'
R.S. COBURN P.E. 7444		DATE: 4-21-1978
FILE NO: 78-03-02		SHEET 2 OF 2

K&E PLATE 1, PLAN-PROFILE
KUPPE & BERR CO.
48 7024 MADE IN U.S.A.