


PARAGON ENGINEERING, INC.



OCT. 1978

SANITARY SEWER PROFILES



NEED VISTA SUBDIVISION
MESA COUNTY, COLORADO

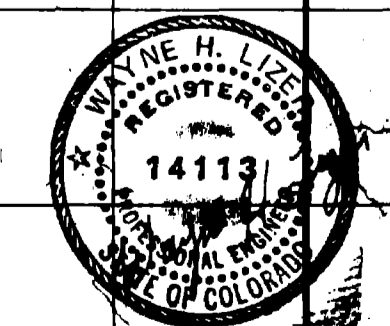

02-999
AS BUILT DRAWINGS

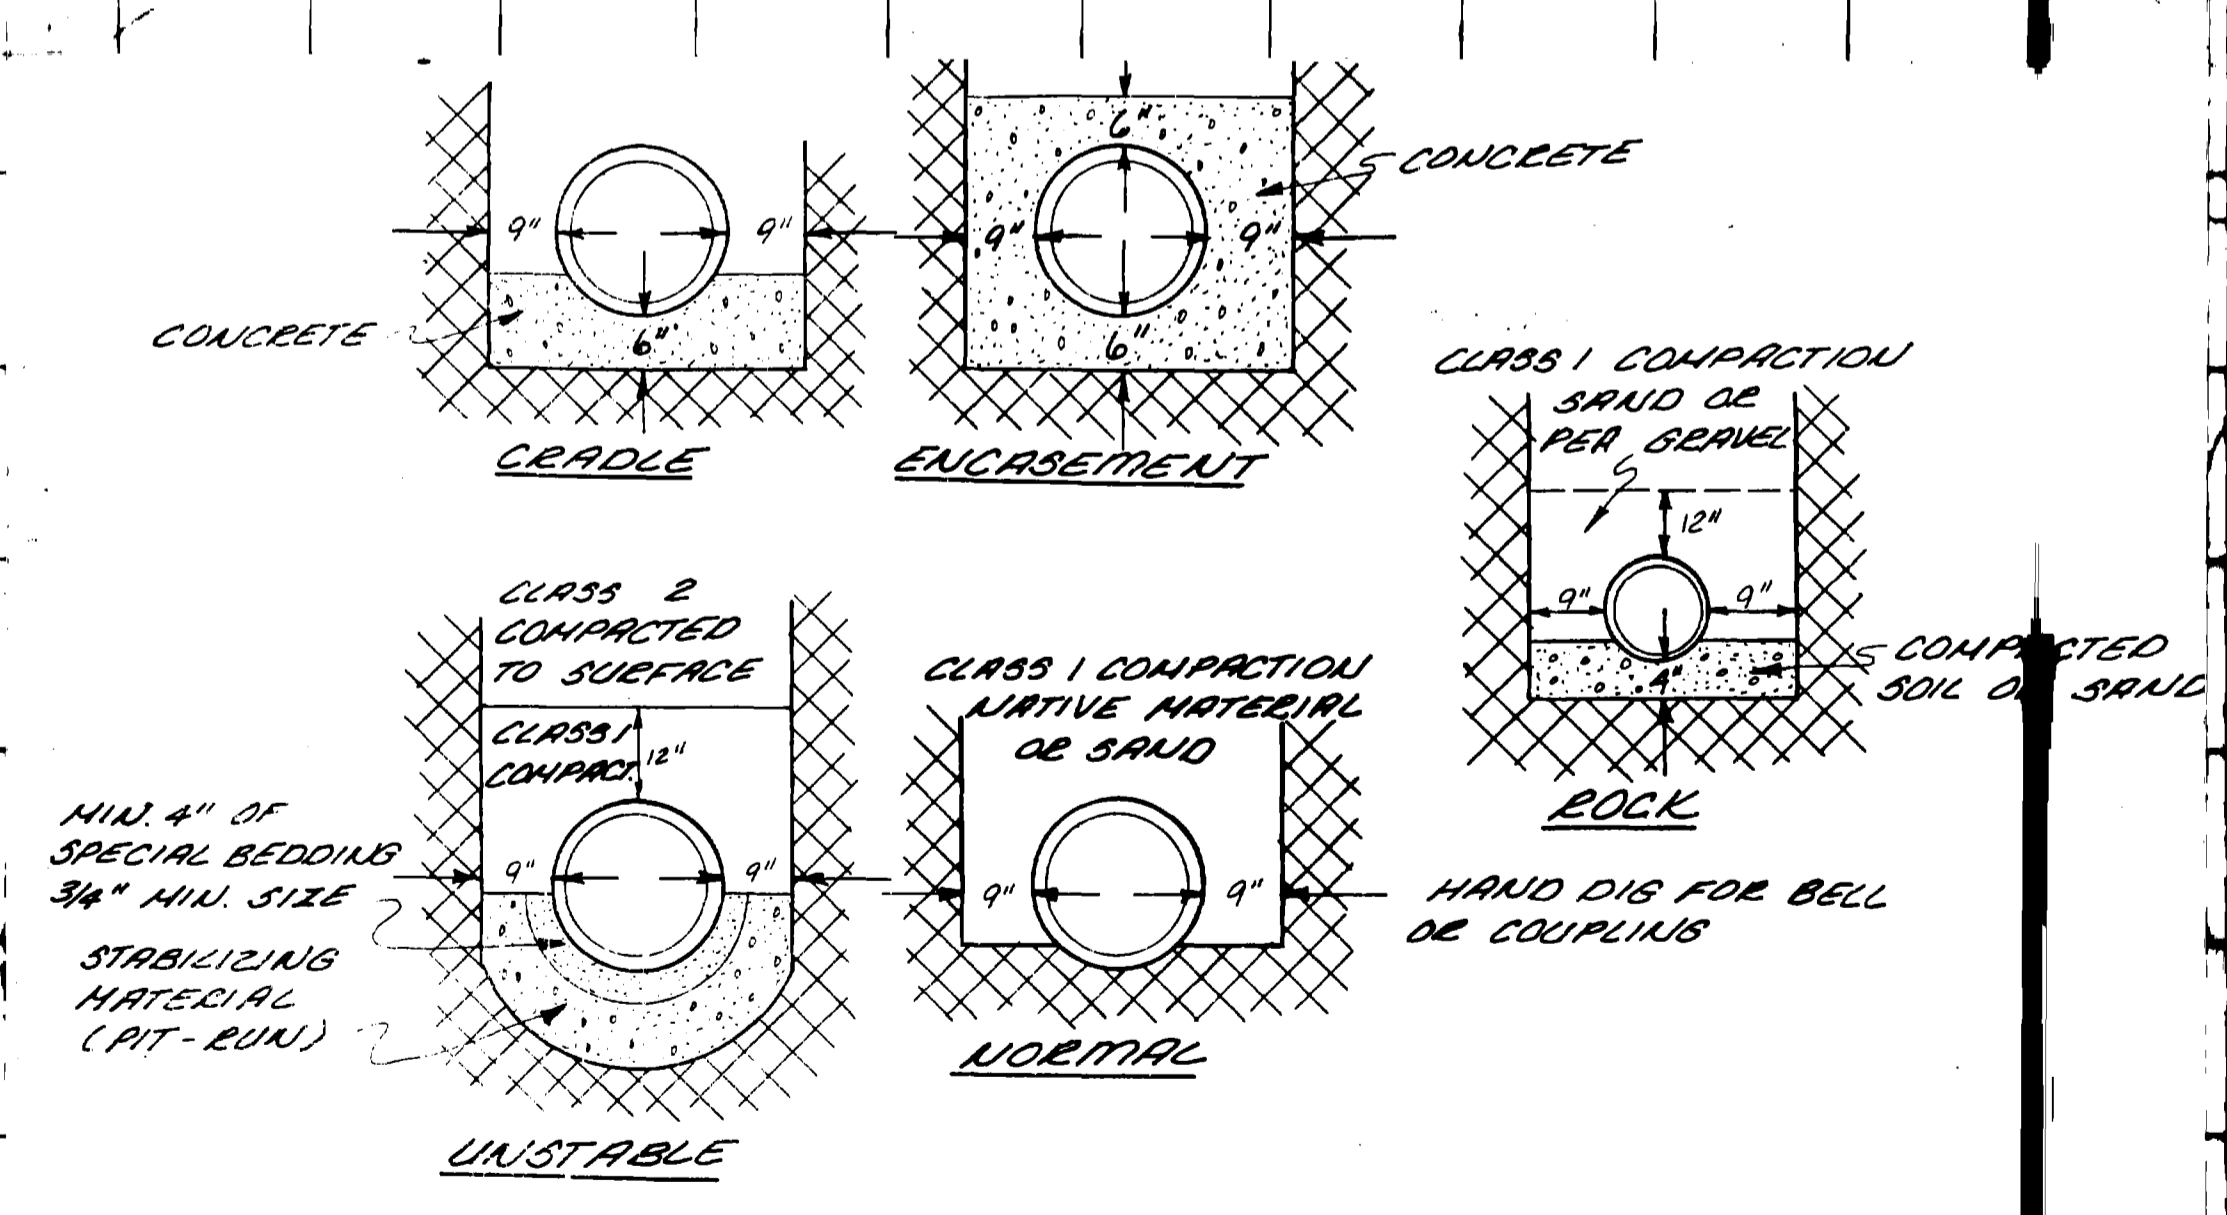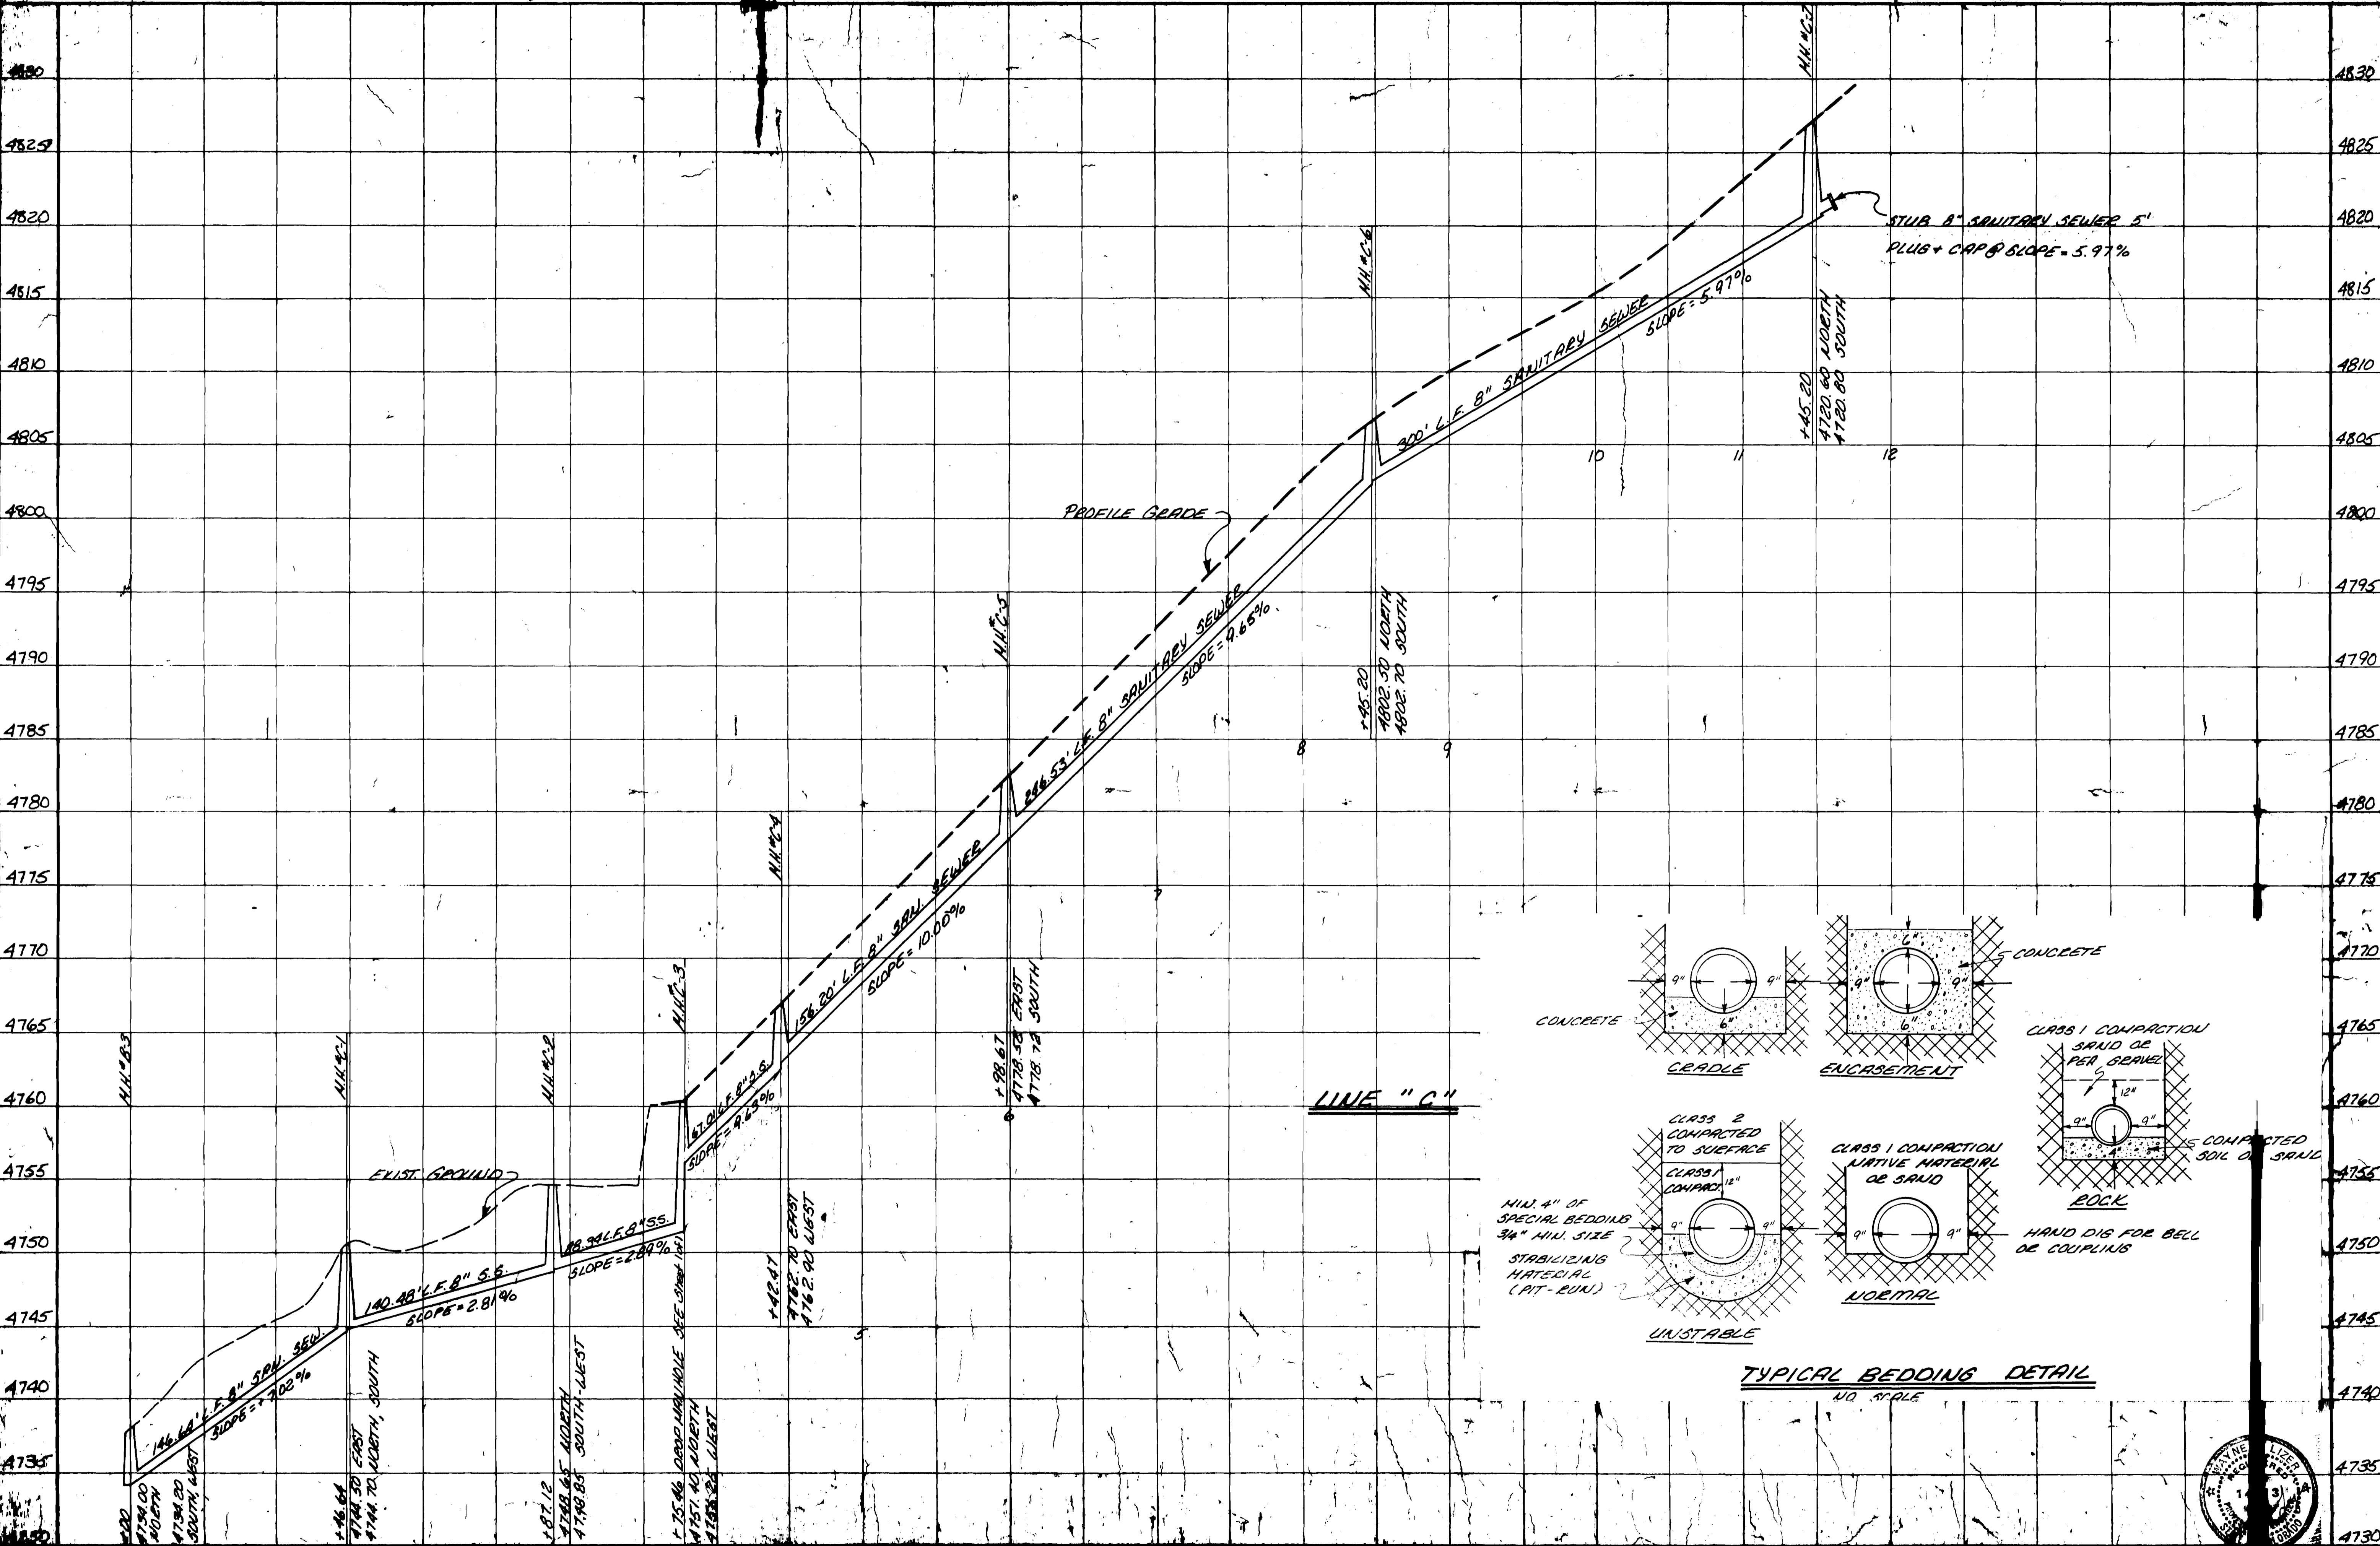

PARAGON ENGINEERING, INC.
 Engineering Consultants
 DATE: OCT. 1978
 SIERRA VISTA SUBDIVISION
 SANITARY SEWER
 SHEET NO. 103

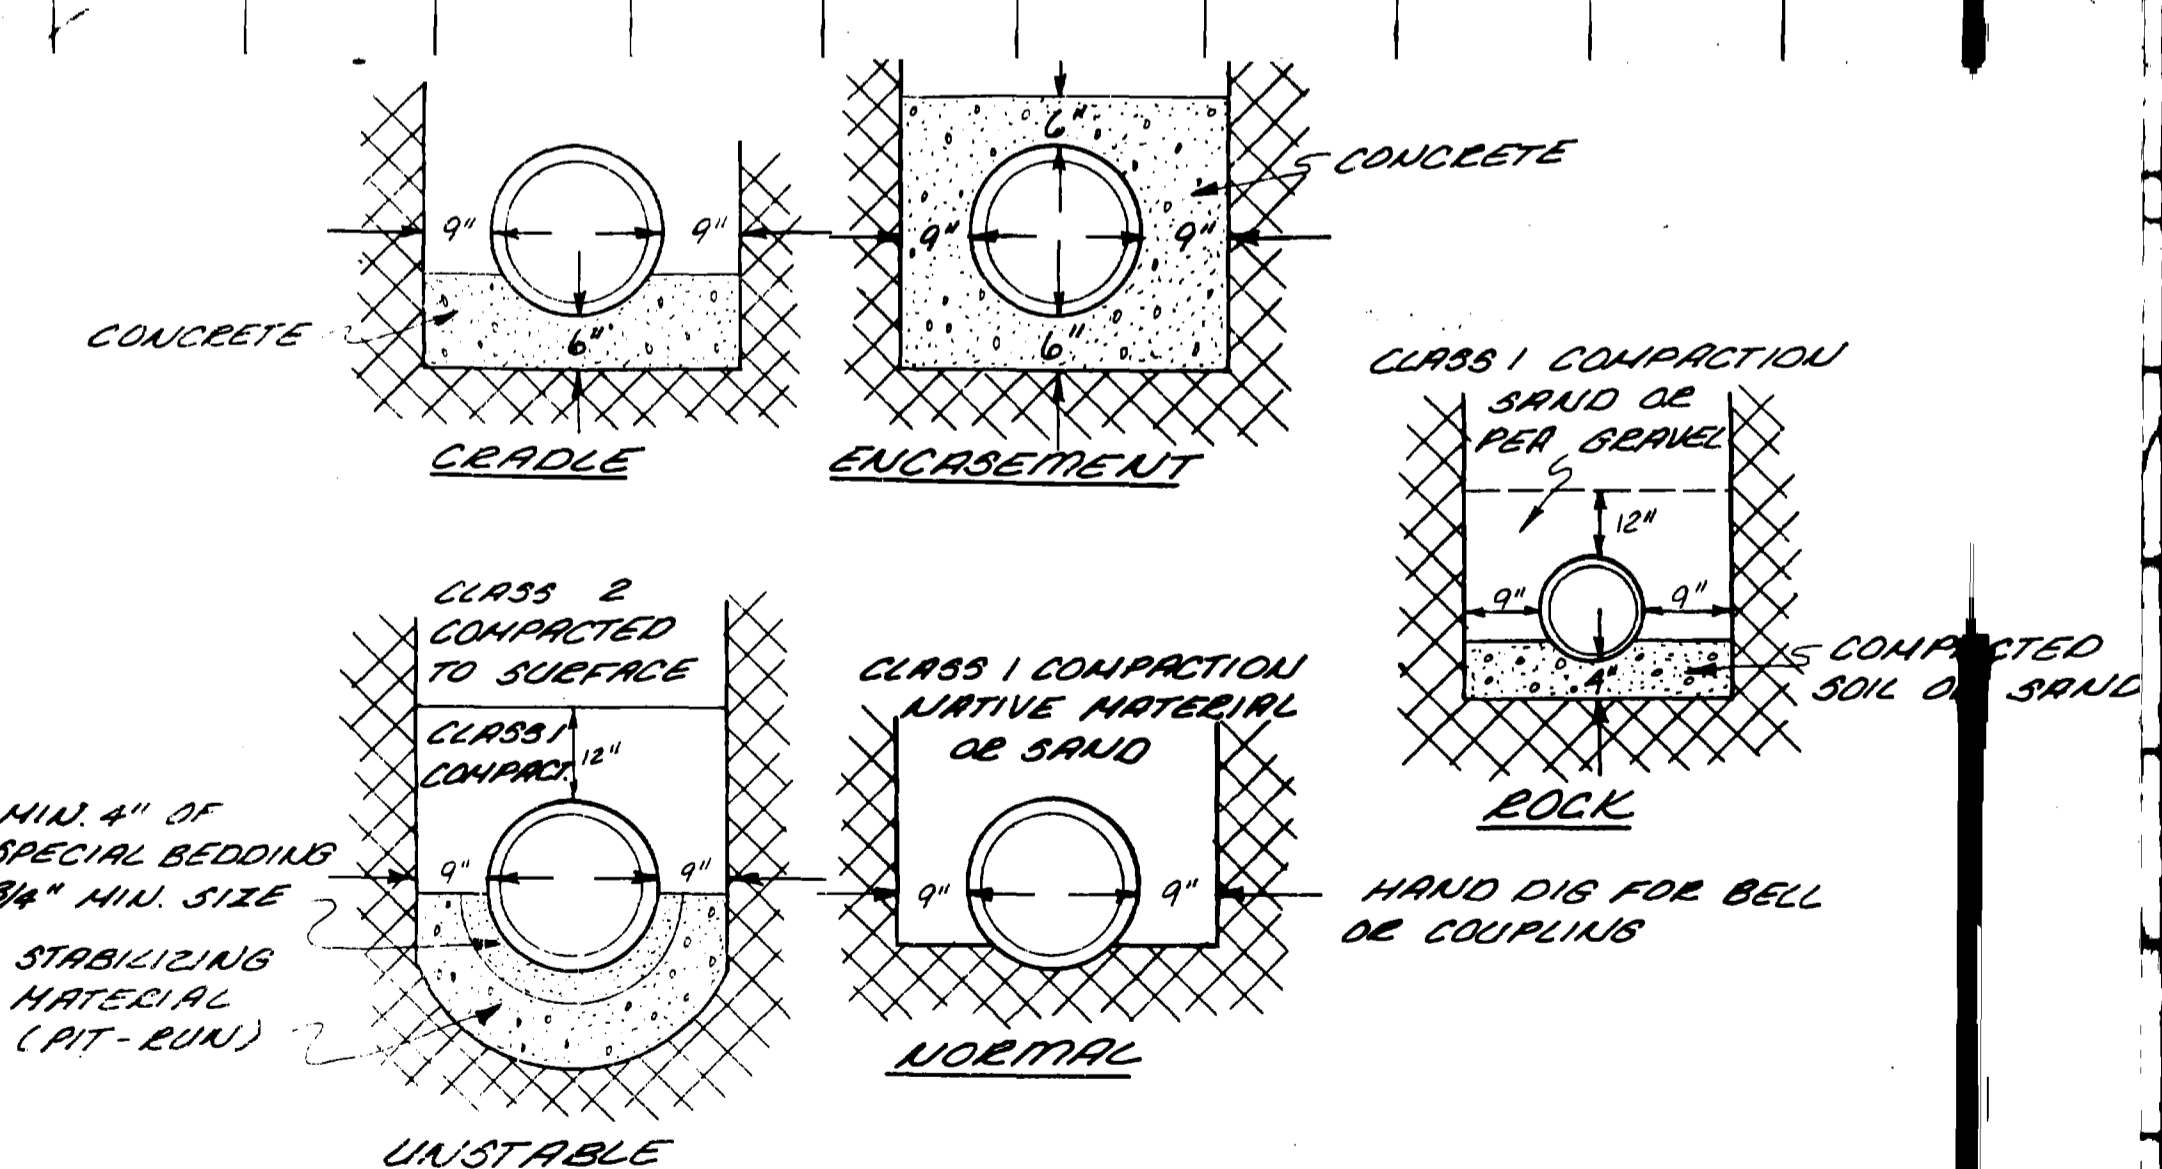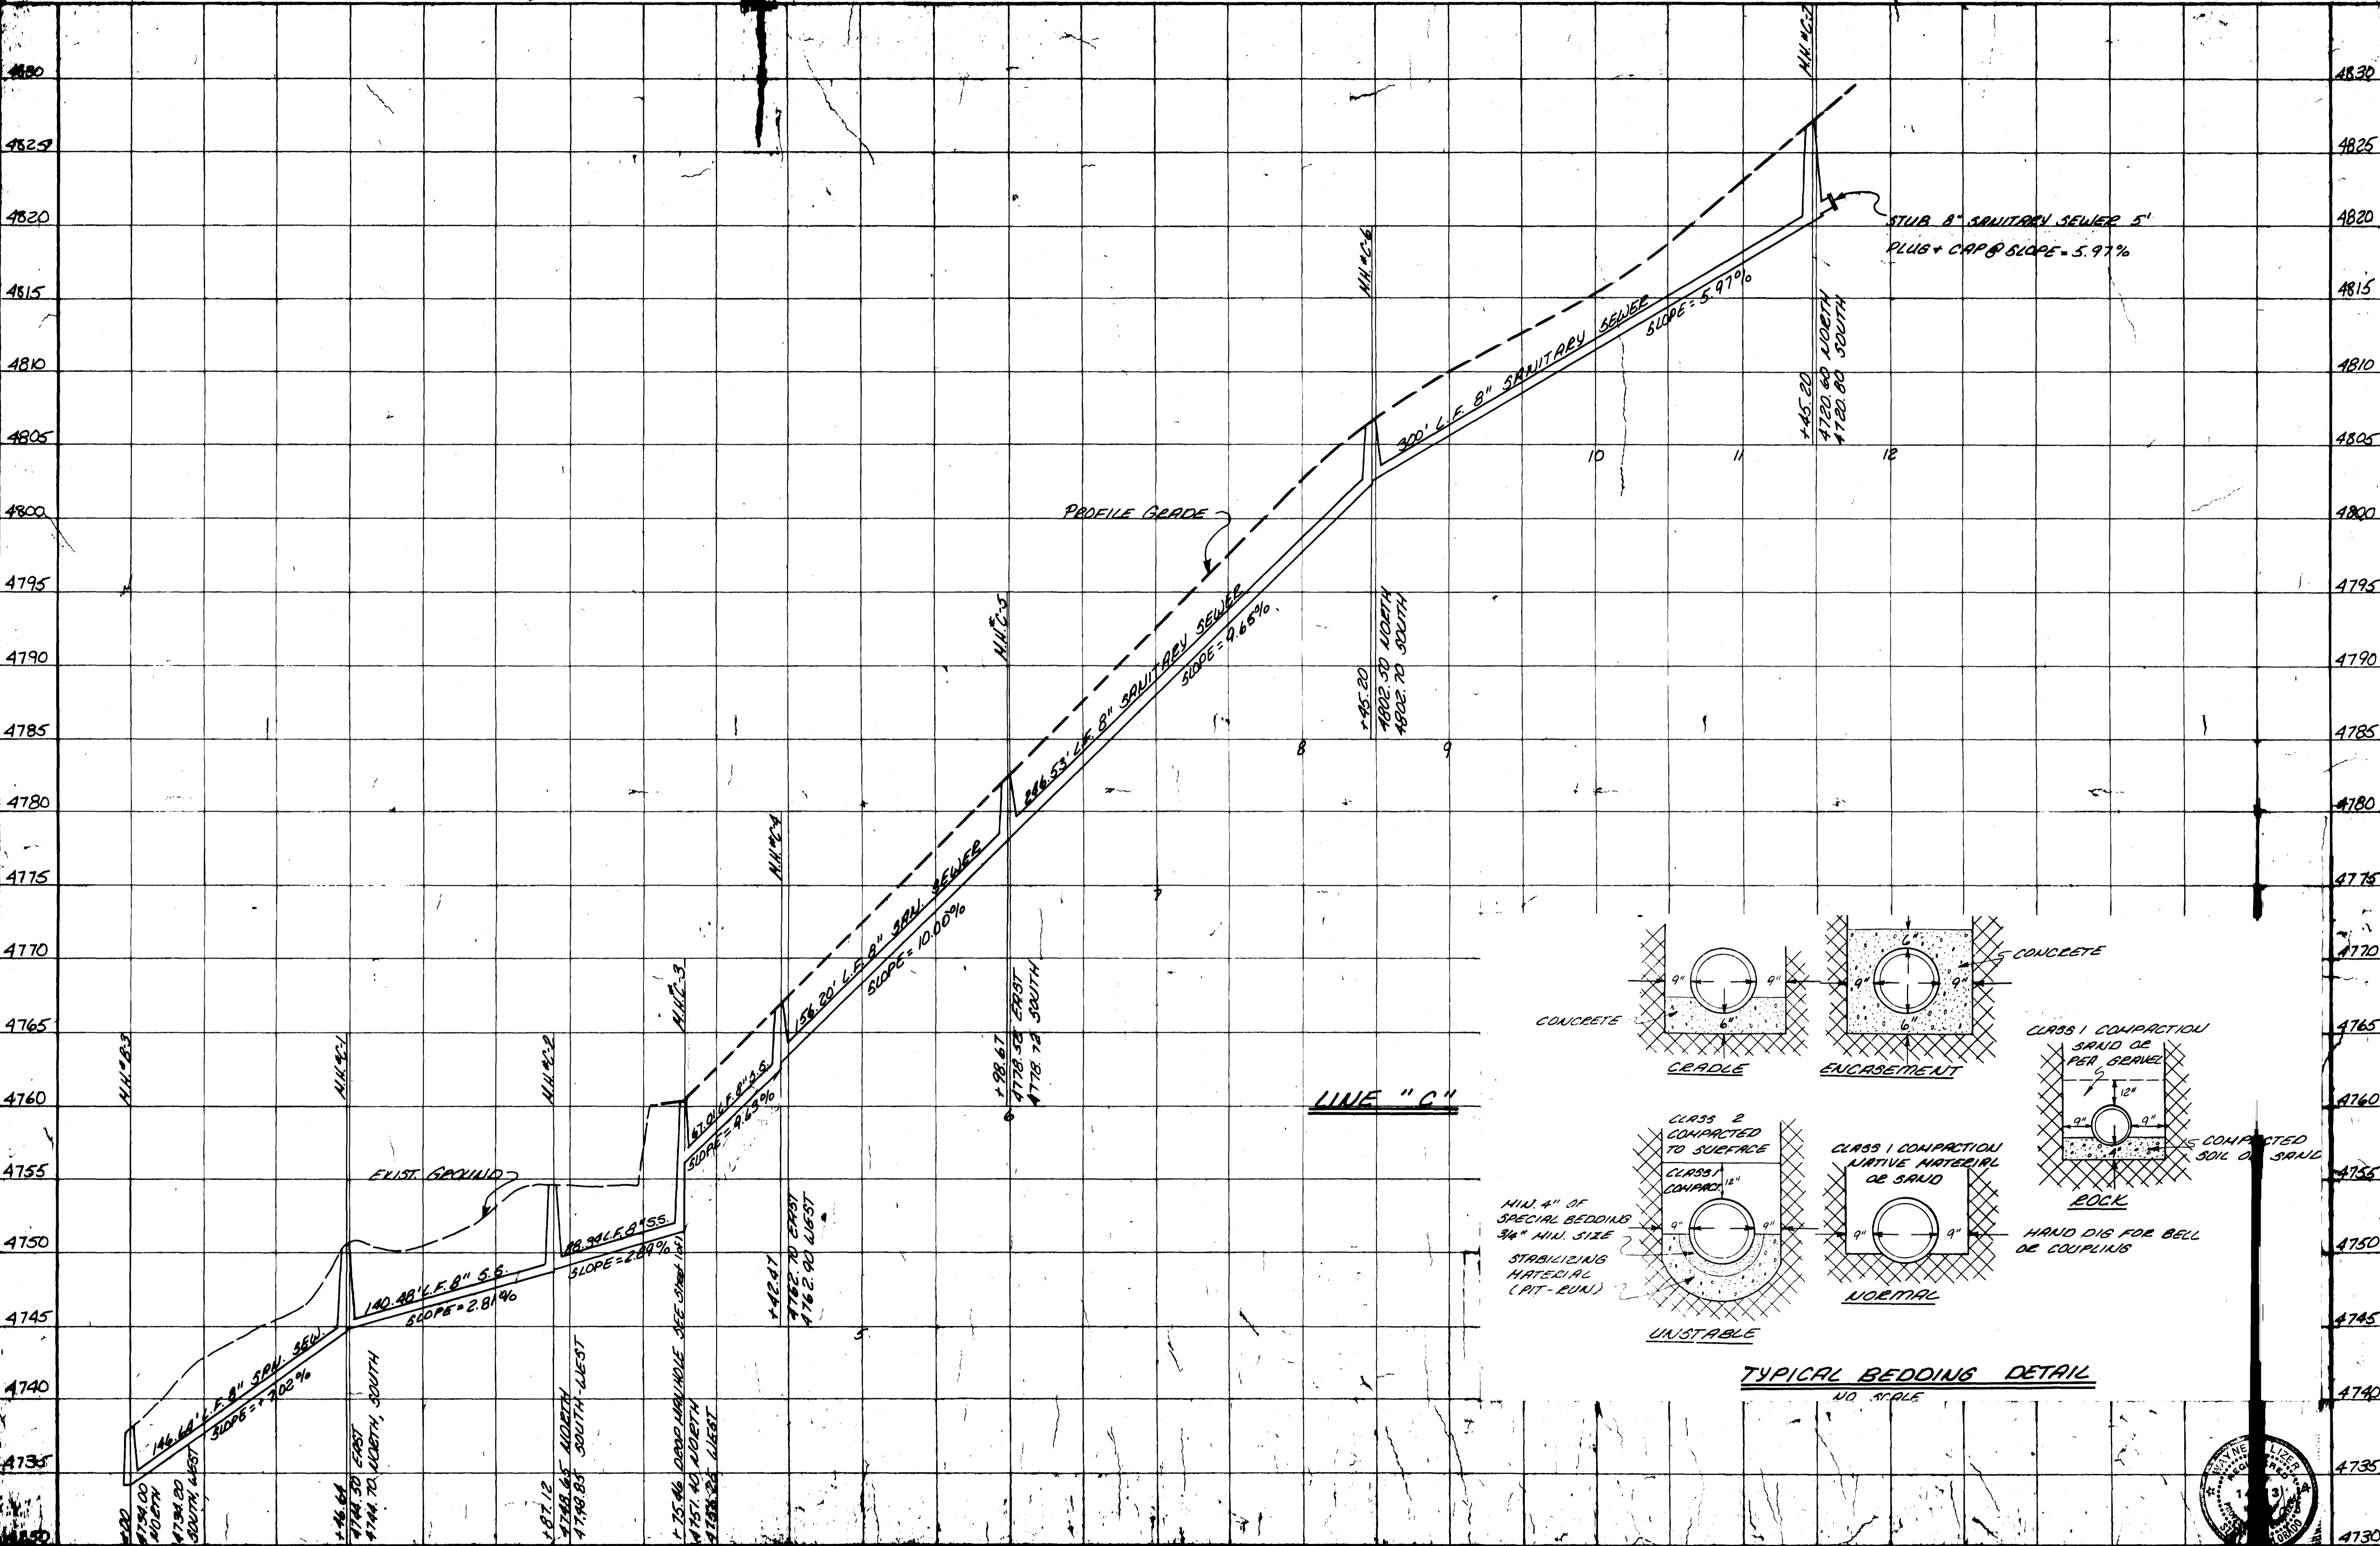

PARAGON ENGINEERING, INC.
 Engineering Consultants
 DATE: OCT. 1978
 SIERRA VISTA SUBDIVISION
 SANITARY SEWER
 SHEET NO. 103

