


- NOTES**
1. ALL CONSTRUCTION TO BE DONE IN ACCORDANCE WITH THE CENTRAL GRAND VALLEY SANITATION DISTRICT SPECIFICATIONS
 2. TOP OF ECCENTRIC CONE TO BE SET @ TOP OF SUBGRADE (STREET CONTRACTOR TO SET RIMS TO FINISHED GRADE OF STREETS)
 3. SERVICE LINE ARE INTENDED TO BE LOCATED 5' DOWNSTREAM FROM CENTER OF LOTS OR AS SHOWN ON PLANS AND EXTEND 10 BEYOND PROPERTY LINE



QUANTITIES

6" SANITARY SEWER	1194 LF
MANHOLES	3
6" SERVICE CONNECTIONS	27

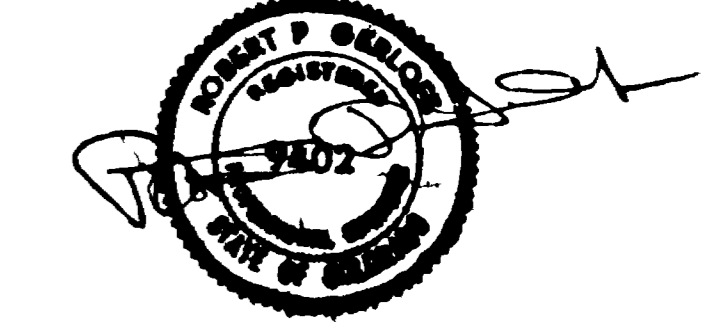

APPROVED: *Robert P. Gerlofs* DATE: June 13, 1971
CENTRAL GRAND VALLEY SANITATION DISTRICT

ROBERT P. GERLOFS
 Engineering Co. Sanibel
 1000 S. W. 10th St.
 Ft. Myers, FL 33902
 PHONE 843-6968
 FAX 843-6968
 MESA COUNTY, COLORADO
 COUNTRYSIDE SUBDIVISION PLANS NO TWO
 SANITARY SEWER PLAN AND DETAILS
 SCALE 1"=50'
 SHEET 1 OF 2

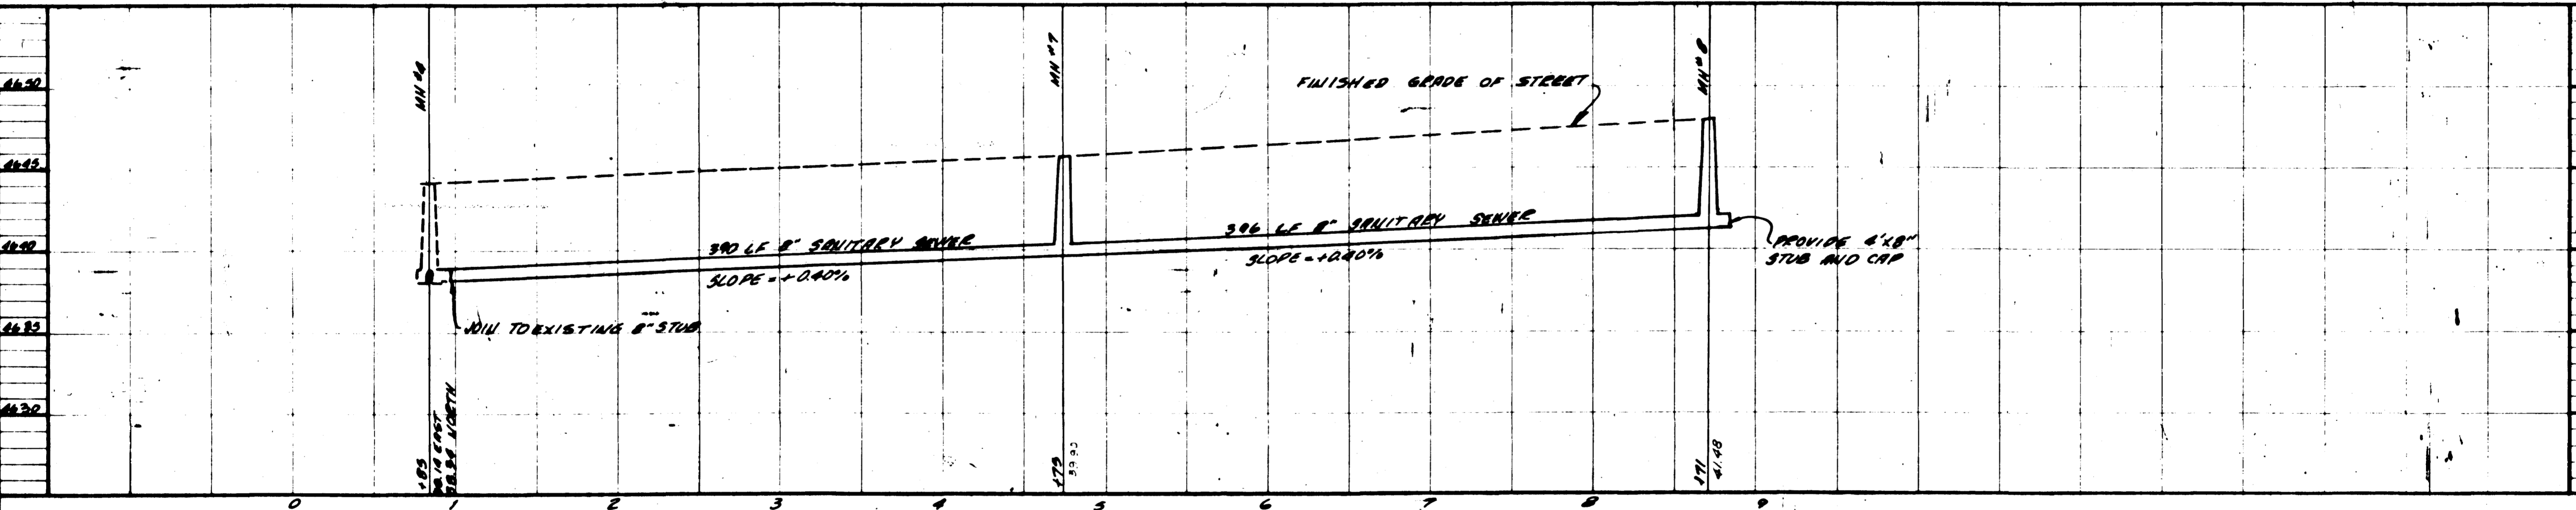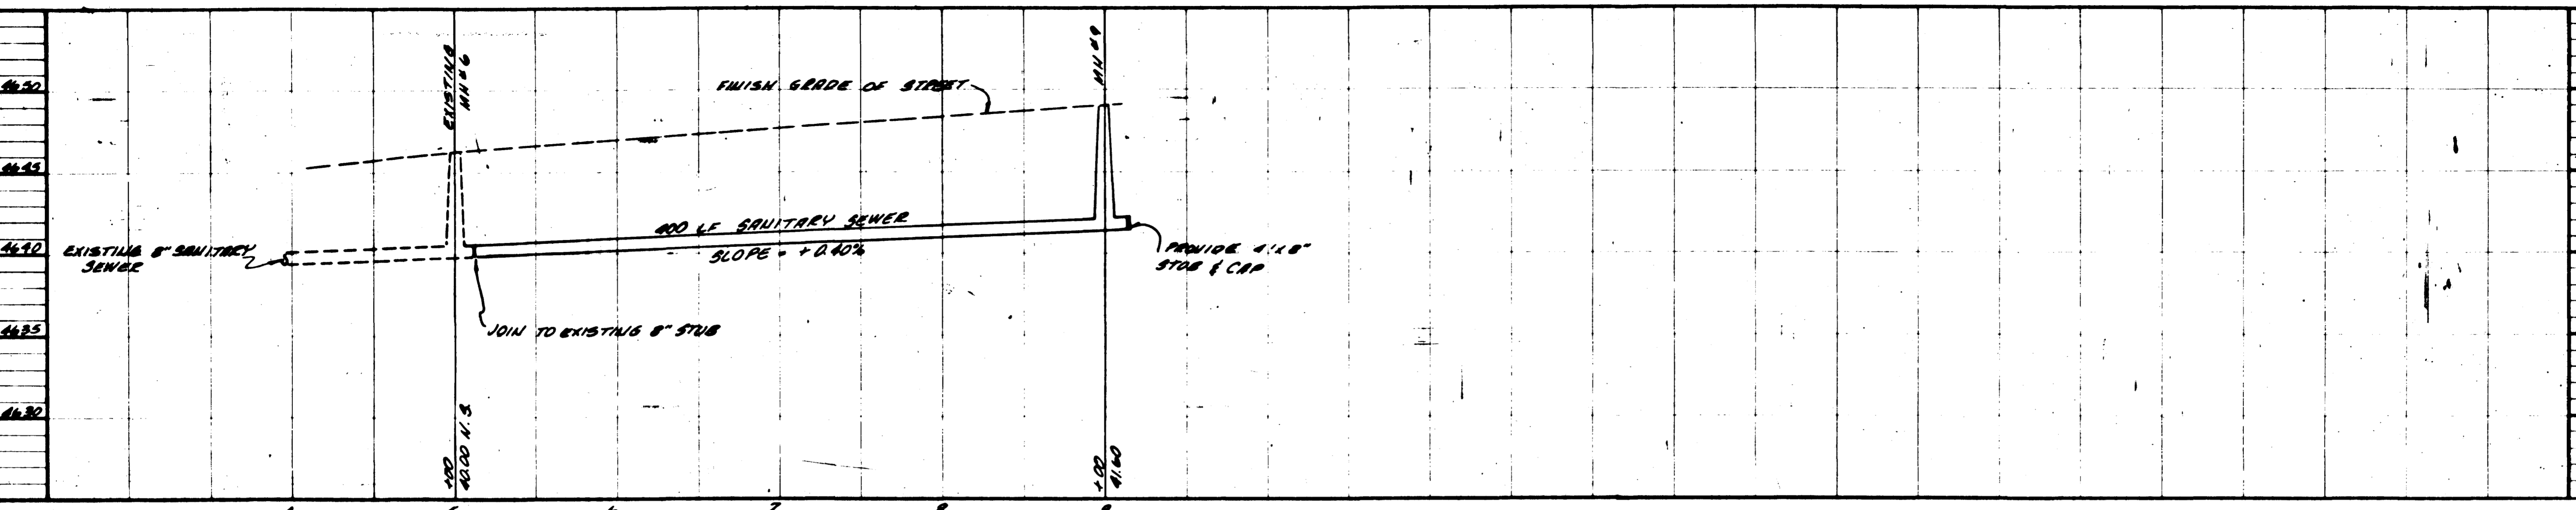

AS BUILT DRAWING

