

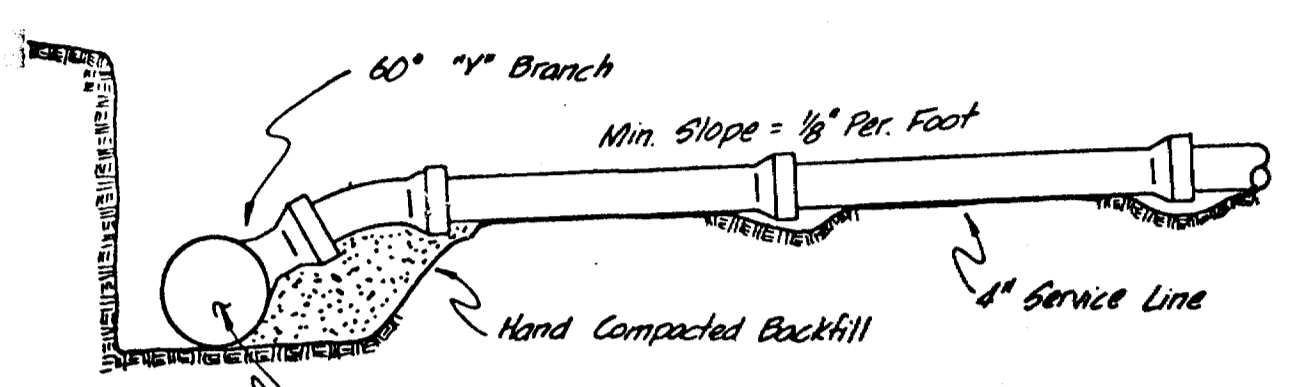


STANDARD MANHOLE
Scale: 1/2" = 1'-0"

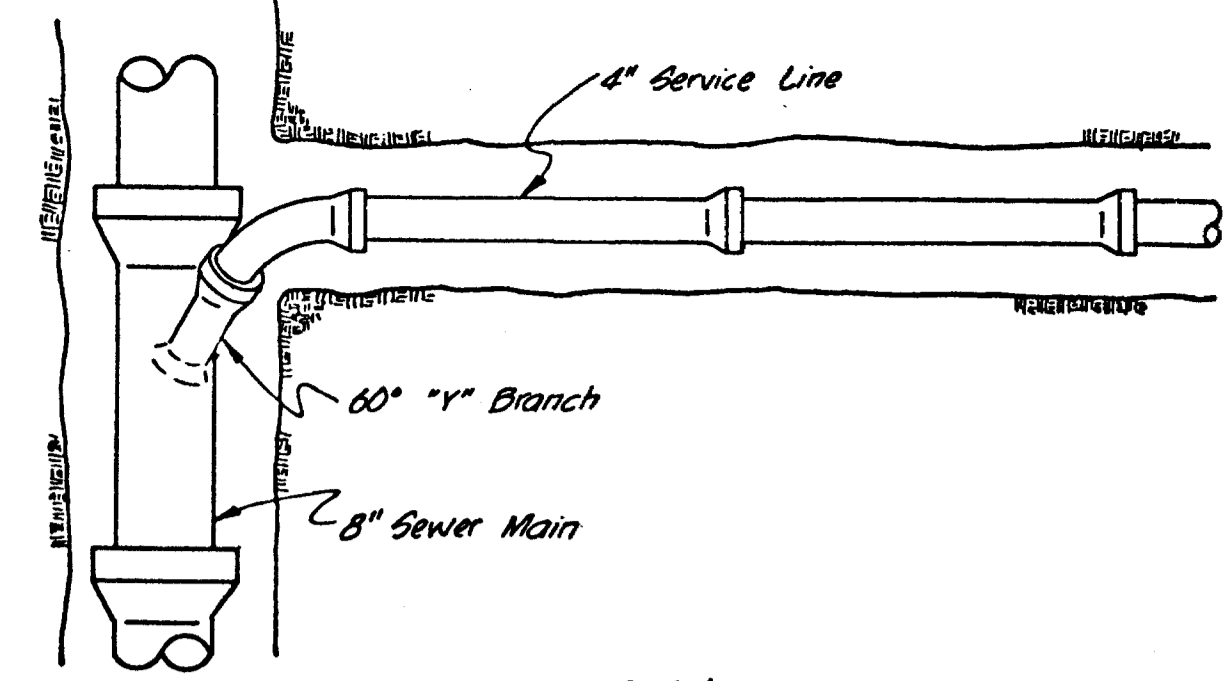


STANDARD SERVICE CONNECTION
No Scale


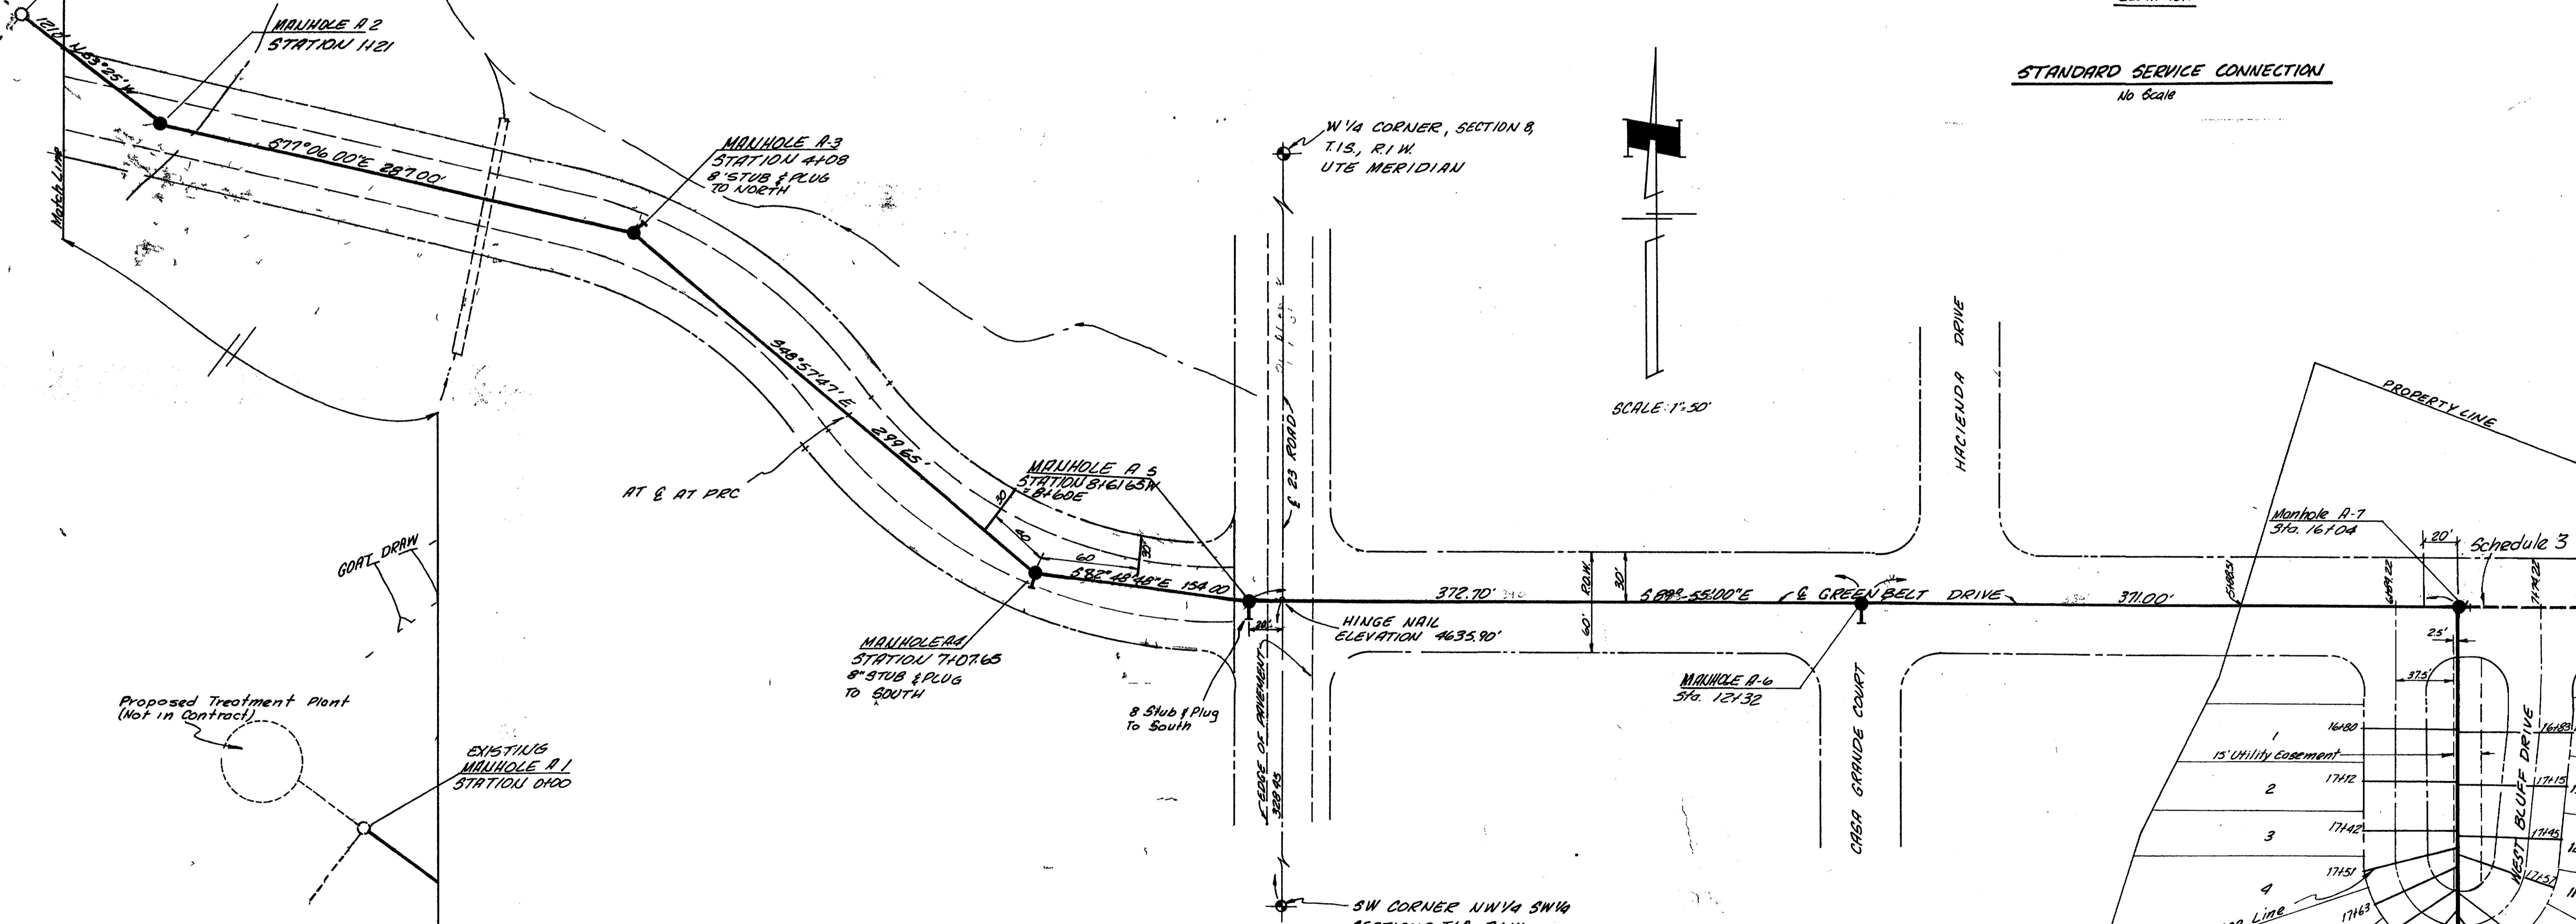


- NOTES**
1. ALL CONSTRUCTION TO BE DONE ACCORDANCE WITH THE CITY OF GRAND JUNCTION SPECIFICATIONS
 2. TOP OF ECCENTRIC CONE TO BE SET @ TOP OF SUBGRADE (STREET CONTRACTOR TO SET RIMS TO FINISHED GRADE OF STREETS)
 3. SERVICE LINE ARE INTENDED TO BE LOCATED 5' DOWNSTREAM FROM CENTER OF LOTS OR AS SHOWN ON PLANS AND EXTEND 10' BEYOND PROPERTY LINE.

QUANTITIES
1063 L.F. 8" SANITARY SEWER
154 L.F. 12" SANITARY SEWER
7 MANHOLES
14 SERVICE CONNECTION




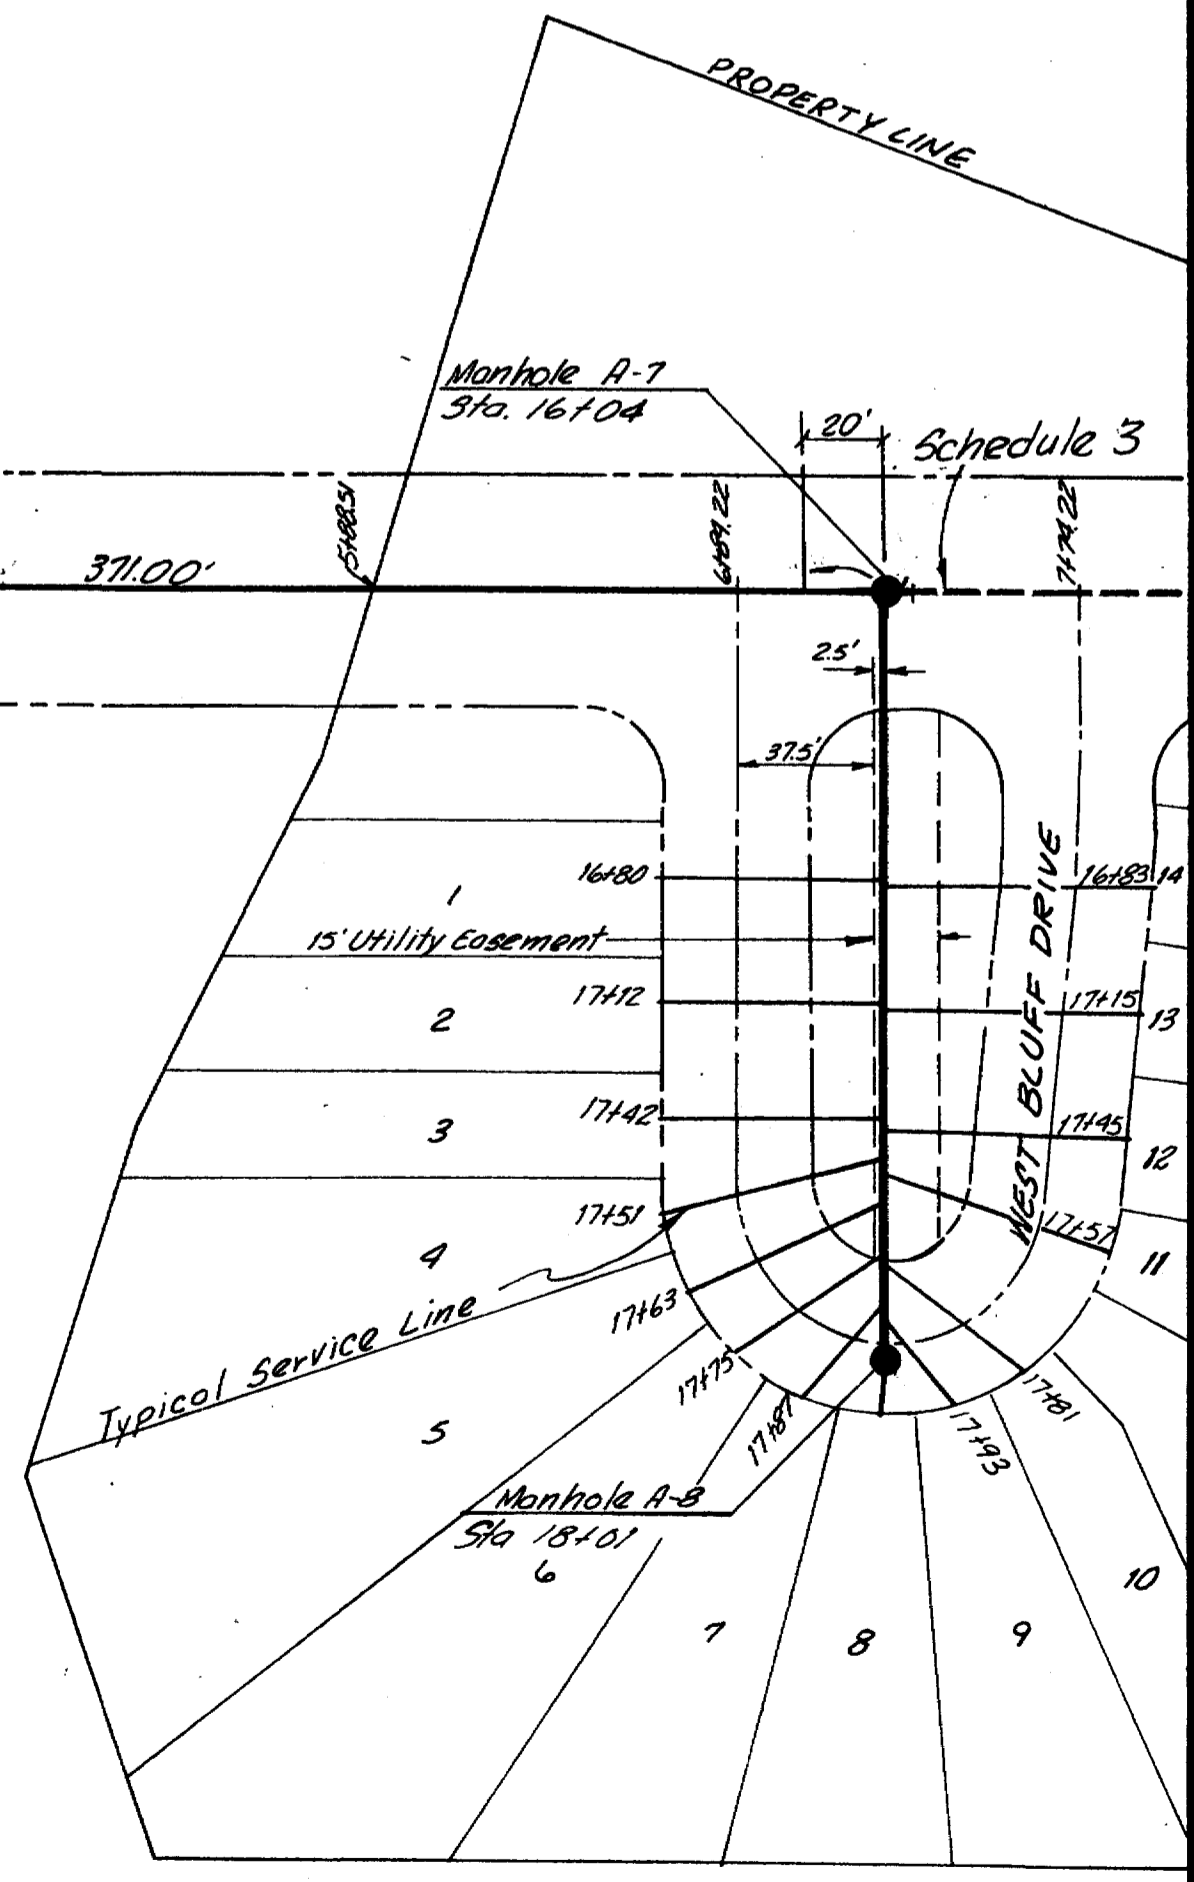


12-27-77
SCHEDULE 2

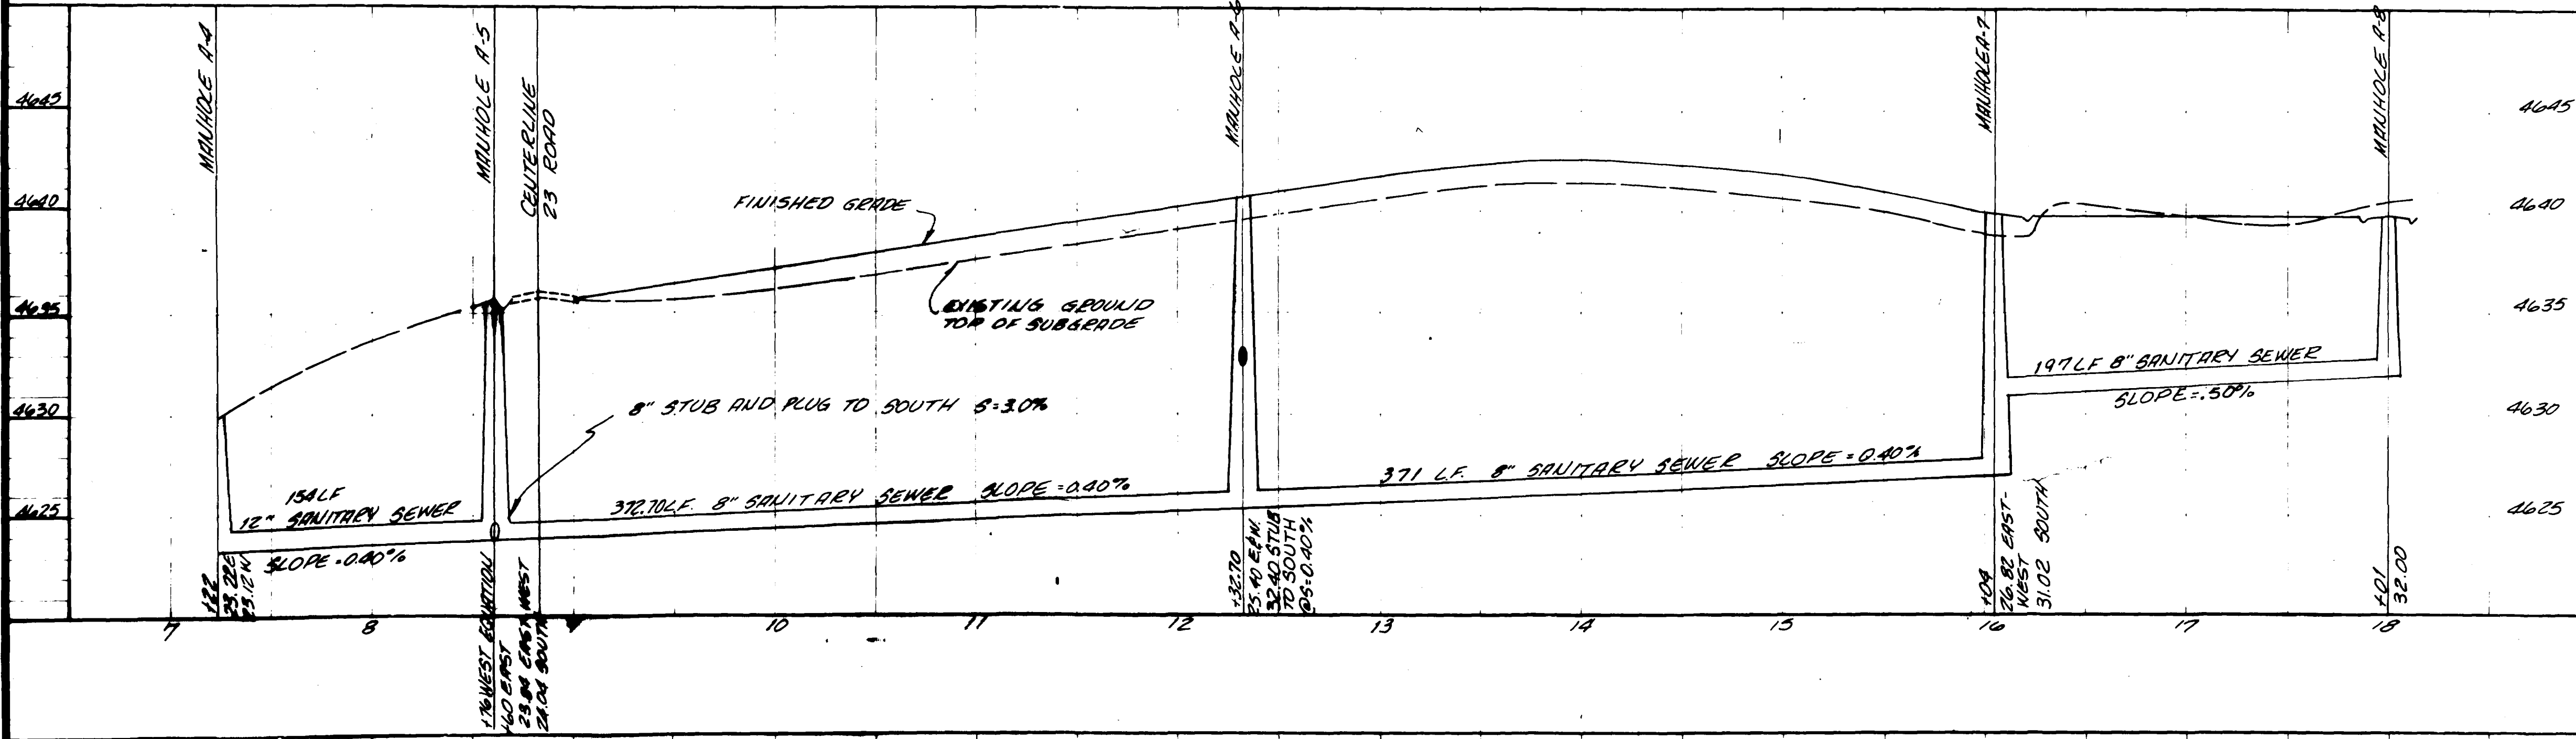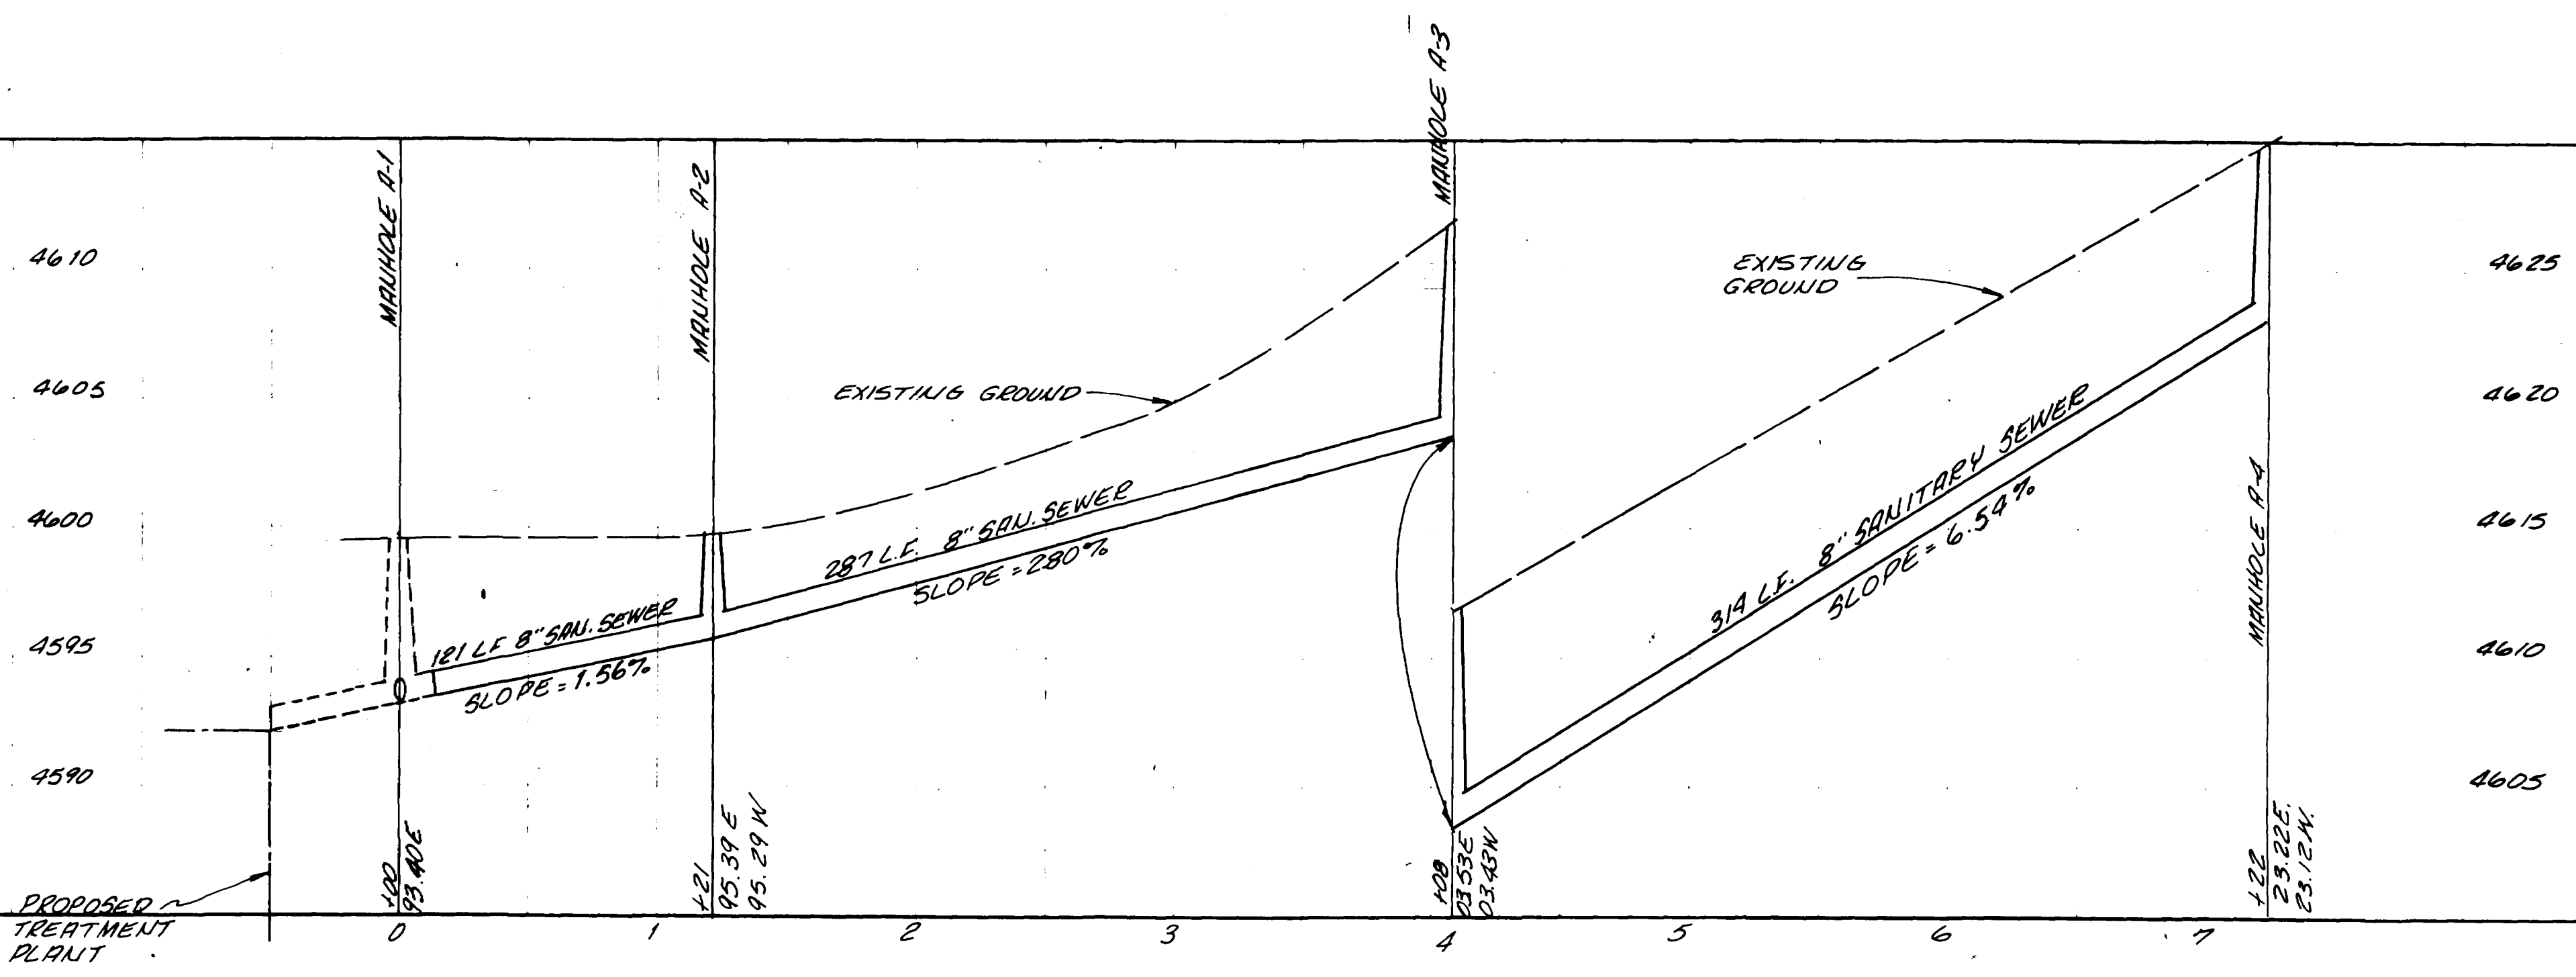


AS BUILT DRAWINGS
 12-27-77
 SCHEDULE 2

THE BLUFFS WEST
 MESA COUNTY, COLORADO
 SANITARY SEWER PROFILES
 DATE REVISED: JULY 1977
 SCALE: 1" = 5' HORIZ.
 1" = 50' VERT.
 ROBERT P. GERLOFS
 Engineering Consultants
 P.O. BOX 2872 • GRAND JUNCTION, COLORADO • 81501 • PHONE 243-8966

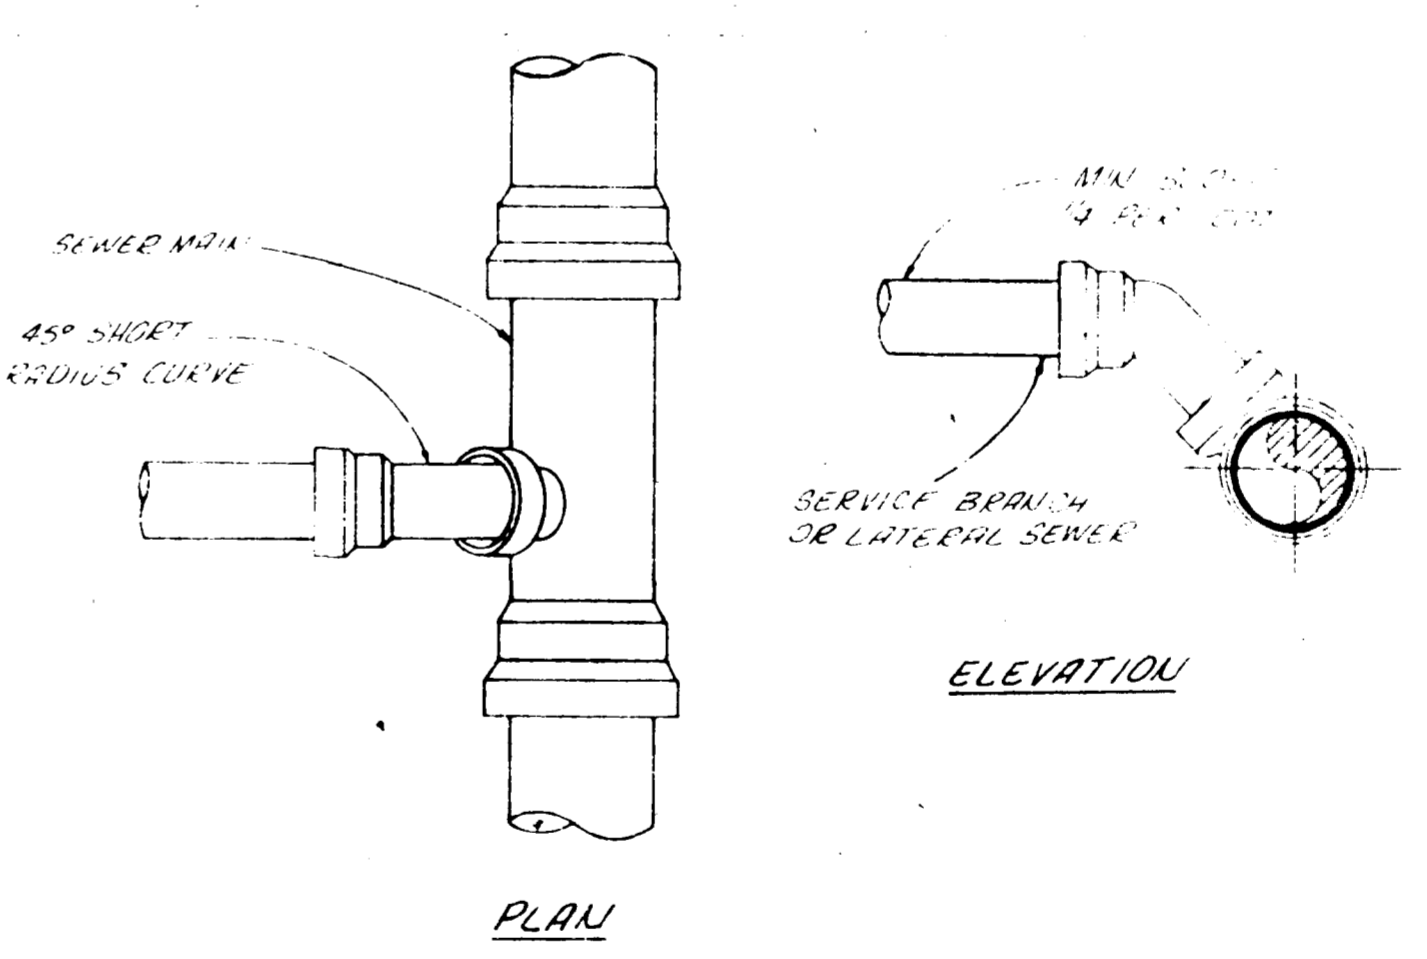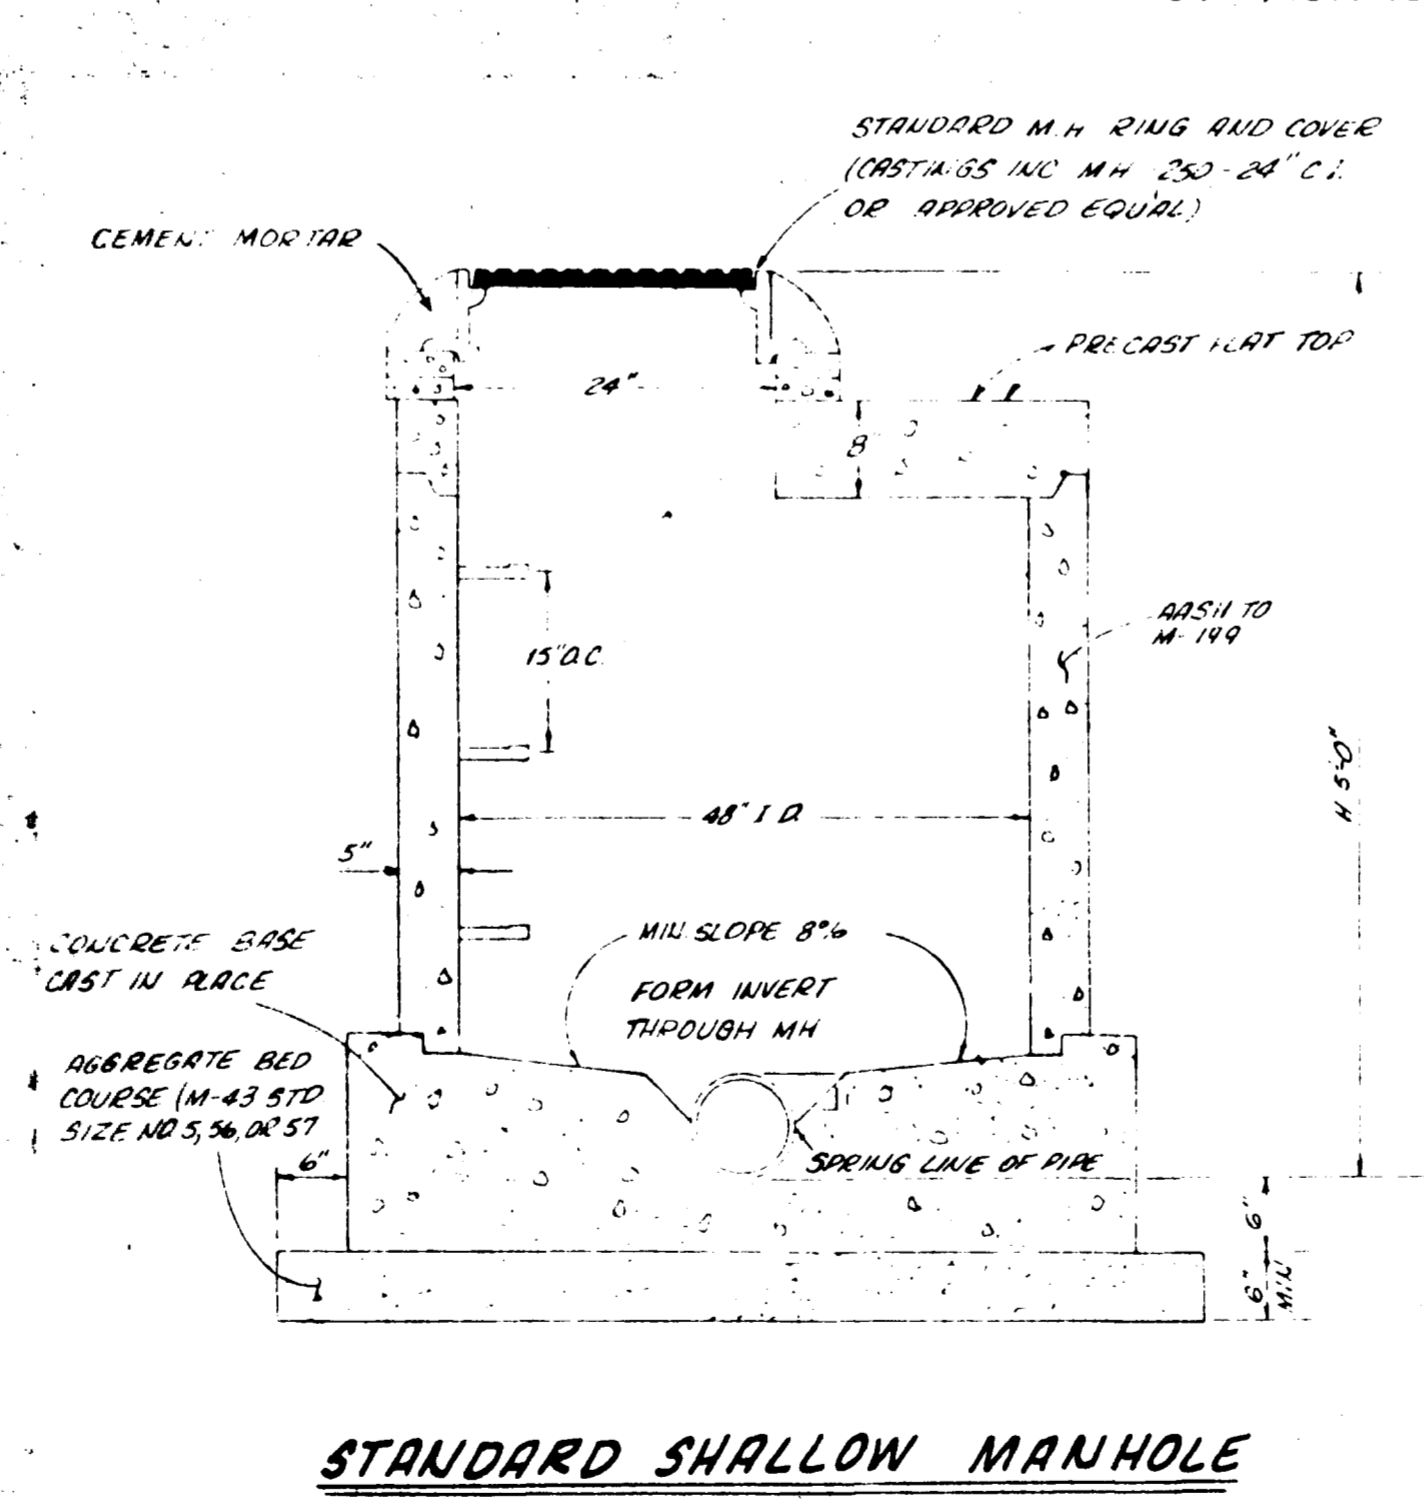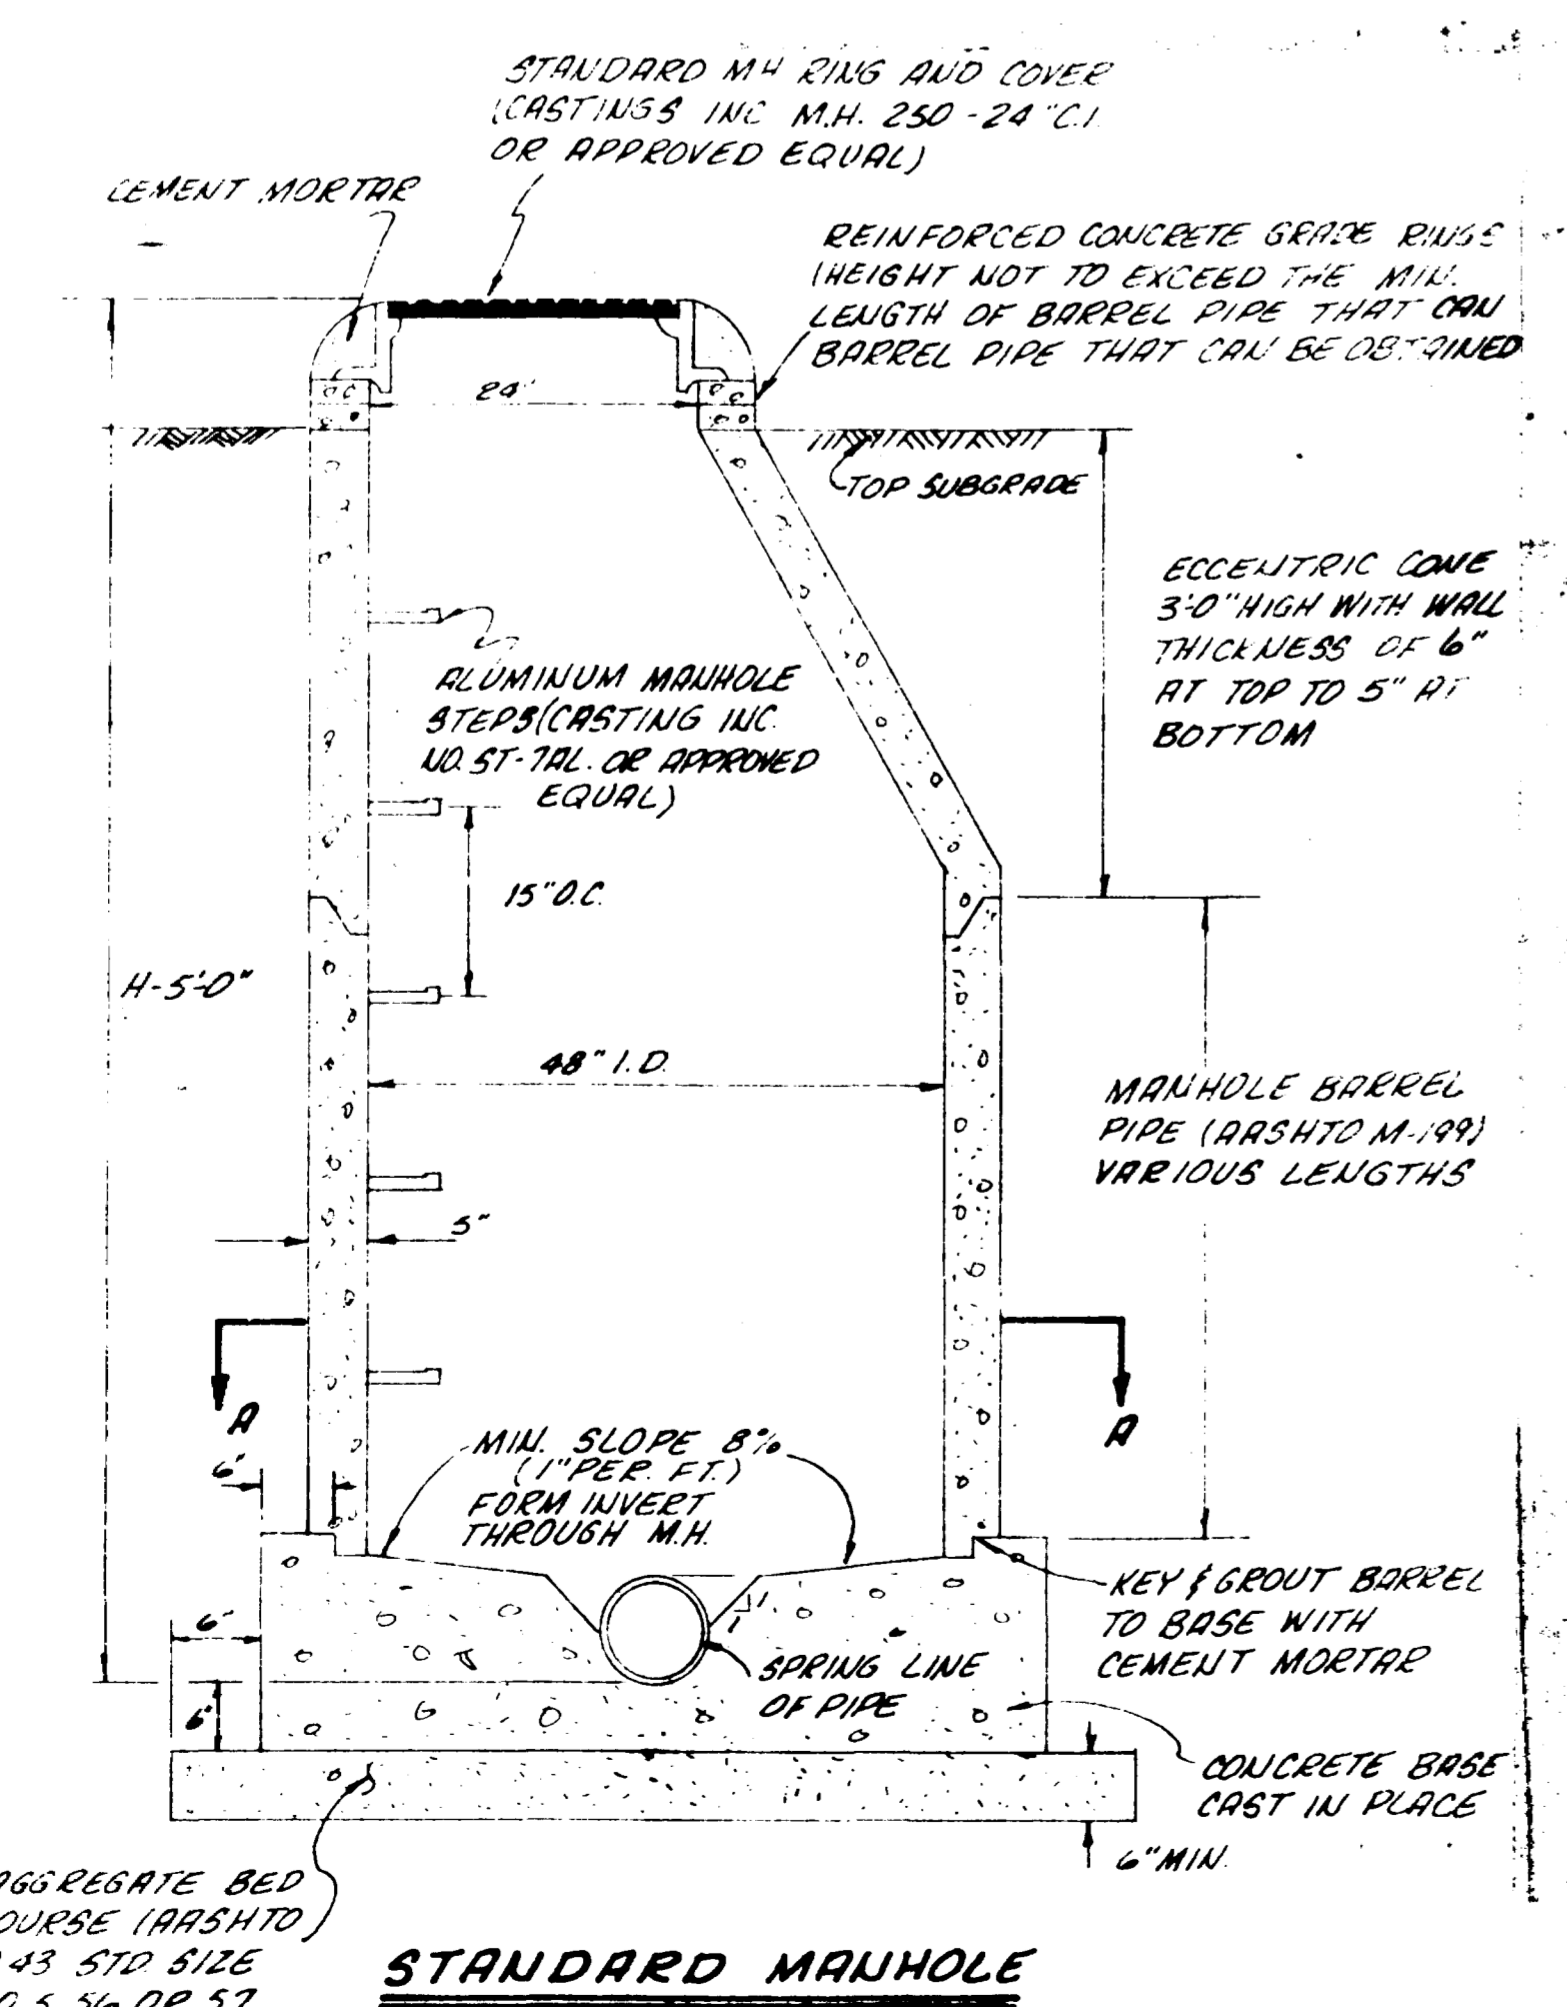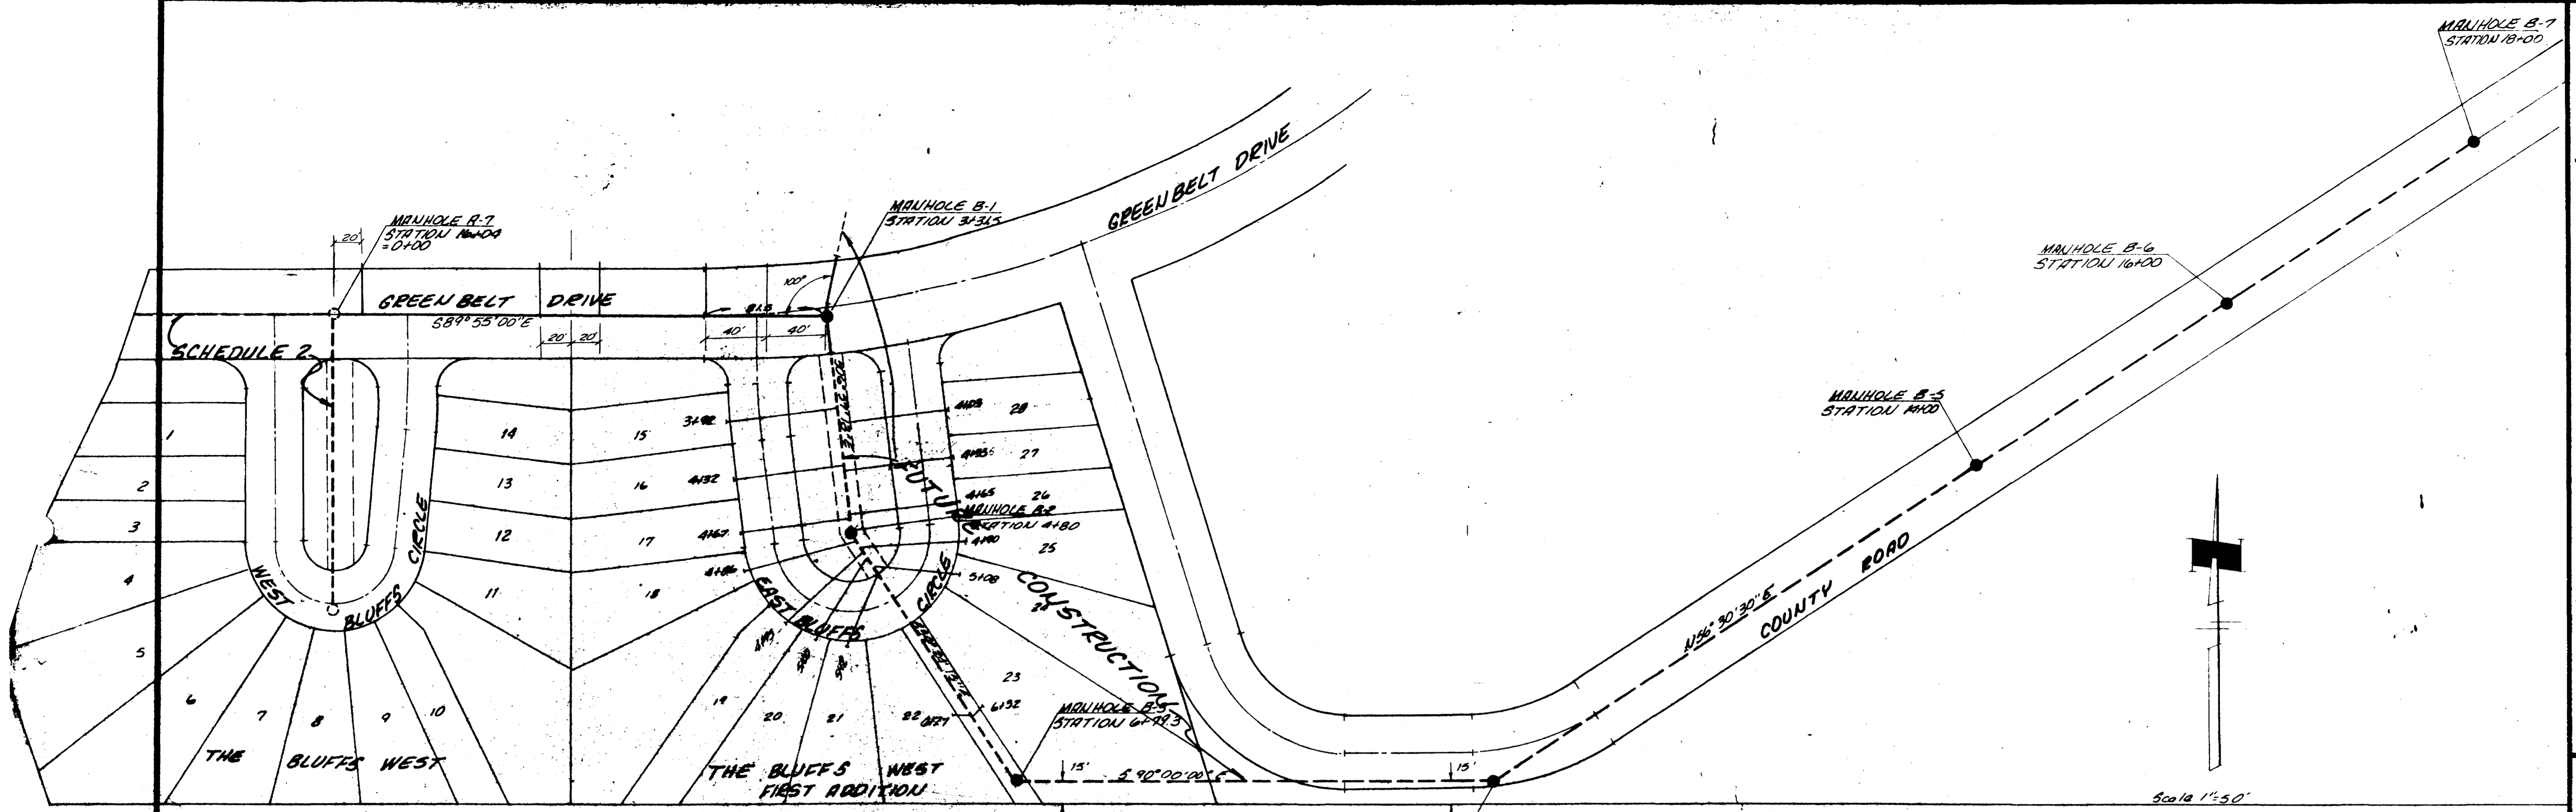




QUANTITIES
 1800 LF. 8" SANITARY SEWER
 7 MANHOLES
 14 SERVICE CONNECTION

- NOTES:**
1. ALL CONSTRUCTION TO BE DONE IN ACCORDANCE WITH THE CITY OF GRAND JUNCTION SPECIFICATIONS
 2. TOP OF ECCENTRIC CONE TO BE SET @ TOP OF SUBGRADE (STREET CONTRACTOR TO SET RIMS TO FINISHED GRADE OF STREETS.)
 3. SERVICE LINES ARE INTENDED TO BE LOCATED 5' DOWNSTREAM FROM CENTER OF LOTS OR AS SHOWN ON PLANS AND EXTEND 10' BEYOND PROPERTY.

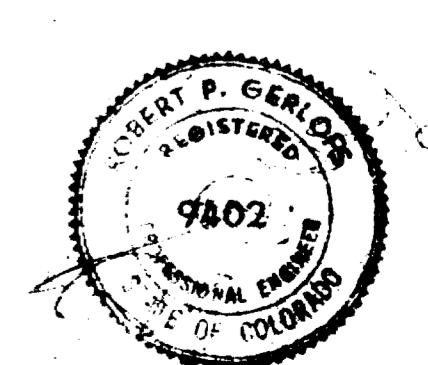

AS BUILT DRAWINGS
 2/28/78
SCHEDULE 3

ROBERT P. GERLOFS
 Engineering Consultants
 DATE: 02/28/78
 SCALE: 1"=50'
 SHEET NO. 150
 THE BLUFFS WEST SANITARY SEWER EXTENSION
 MESA COUNTY, COLORADO
 02020004.tif

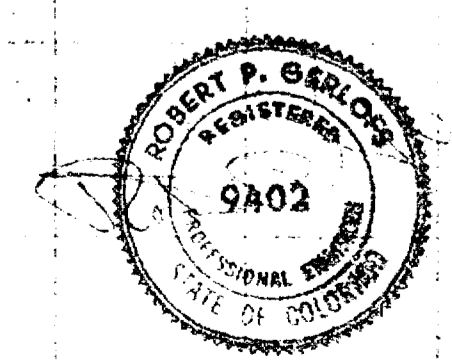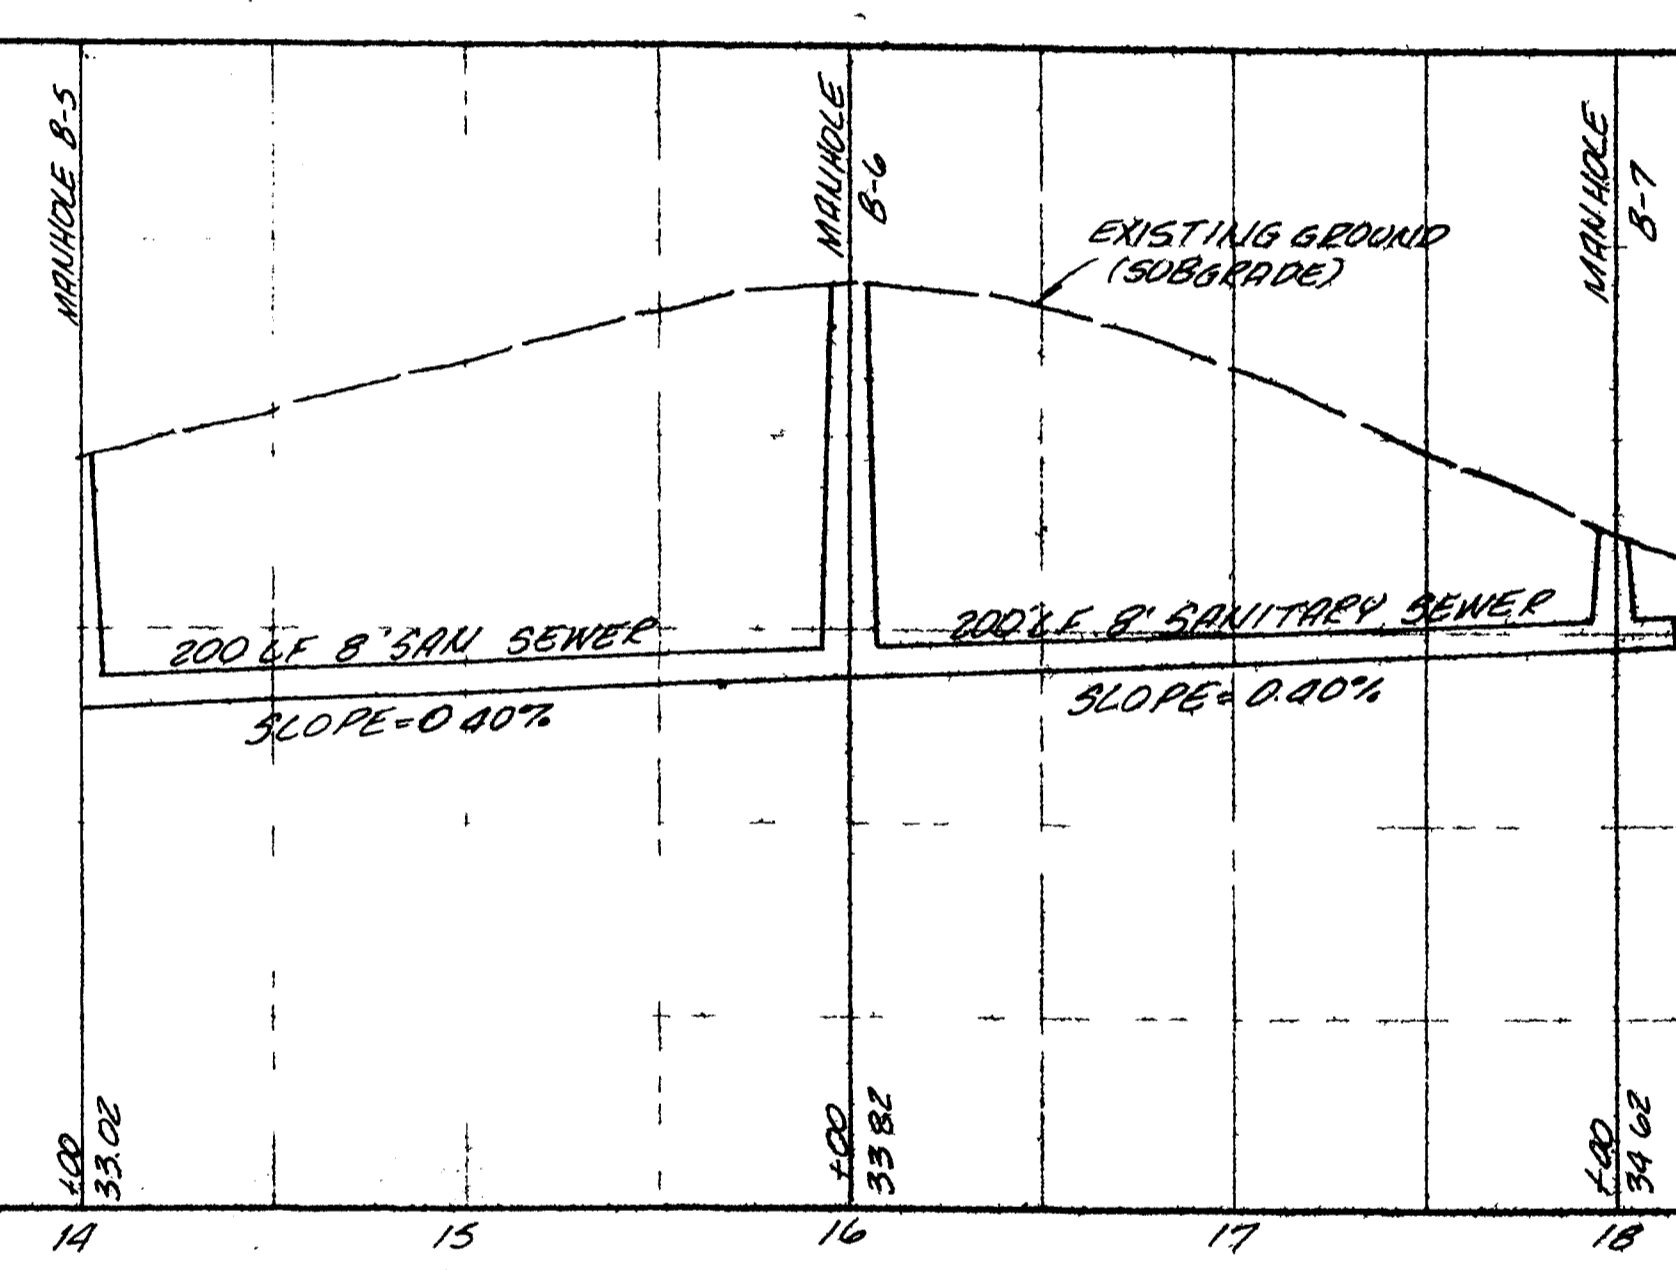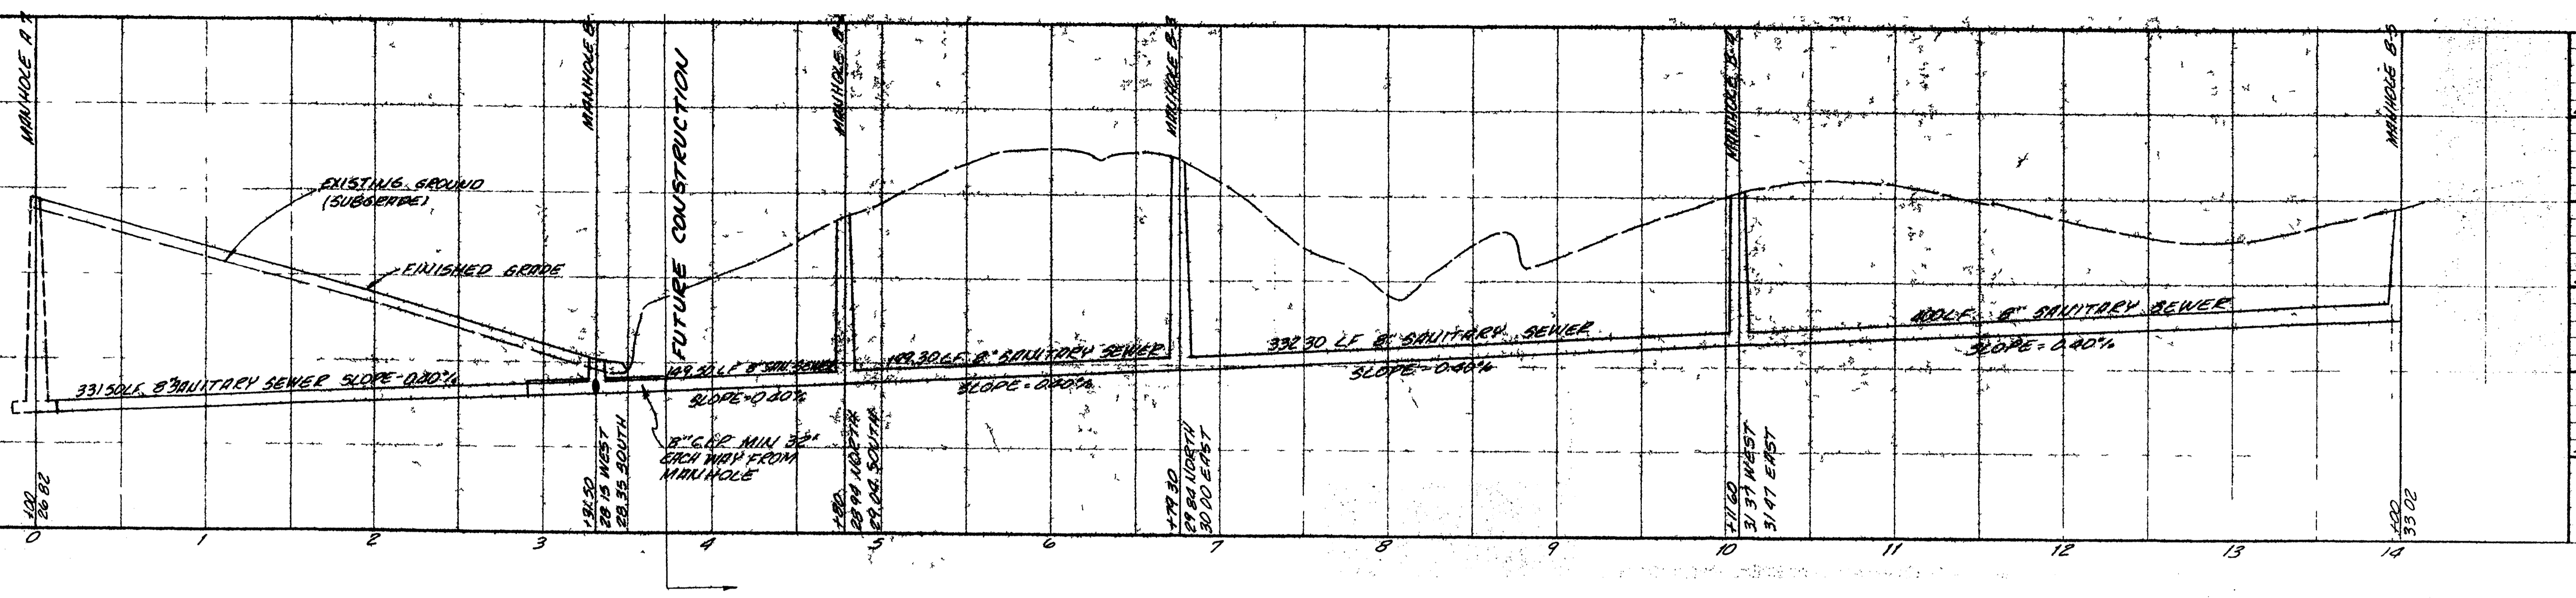

AS BUILT DRAWING
 2/28/78
 SCHEDULE 3

THE BLUFFS WEST SANITARY SEWER EXTENSION
 MESA COUNTY, COLORADO
 PROFILE
 DATE: JUNE 1977
 SCALE: 1" = 5' VERT.
 1" = 50' HORIZ.
 ROBERT P. GERLOFS
 ENGINEER - CONSULTANT
 P.O. BOX 2878 • GRAND JUNCTION, COLORADO • 81501 • PHONE 243-8866