



OMSD MH 45
INV. 4635.17

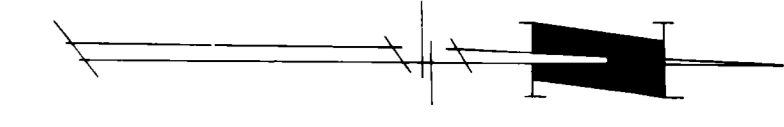

MH A-1
0-04.25 =
151+32.80 Main N.
Sbc Western Eng.
Drawing 202-754-1
Sh. 9a-N


OMSD MH 44
INV. 4636.71

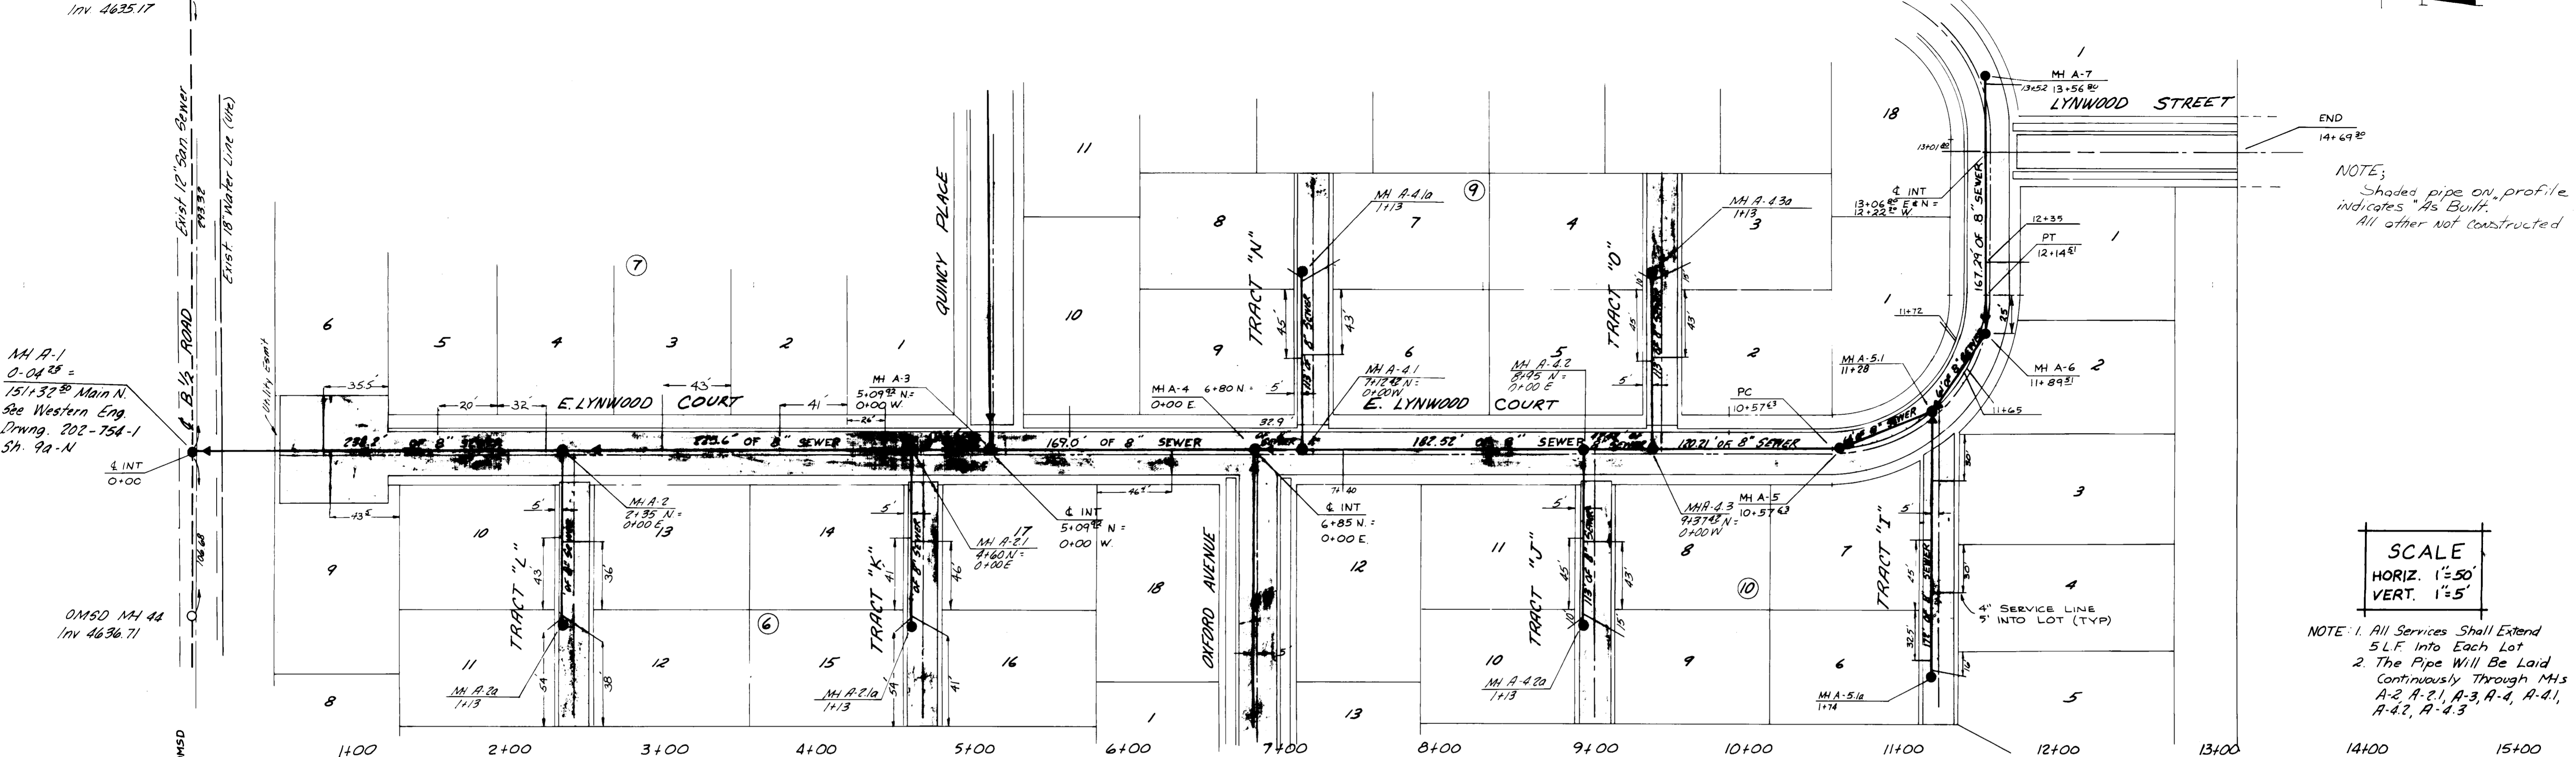

NOTE:
Shaded pipe on profile
indicates "As Built".
All other not constructed

SCALE
HORIZ. 1"=50'
VERT. 1"=5'



NOTE: 1. All Services Shall Extend
5LF into Each Lot
2. The Pipe Will Be Laid
Continuously Through MHS
A-2, A-2.1, A-3, A-4, A-4.1,
A-4.2, A-4.3

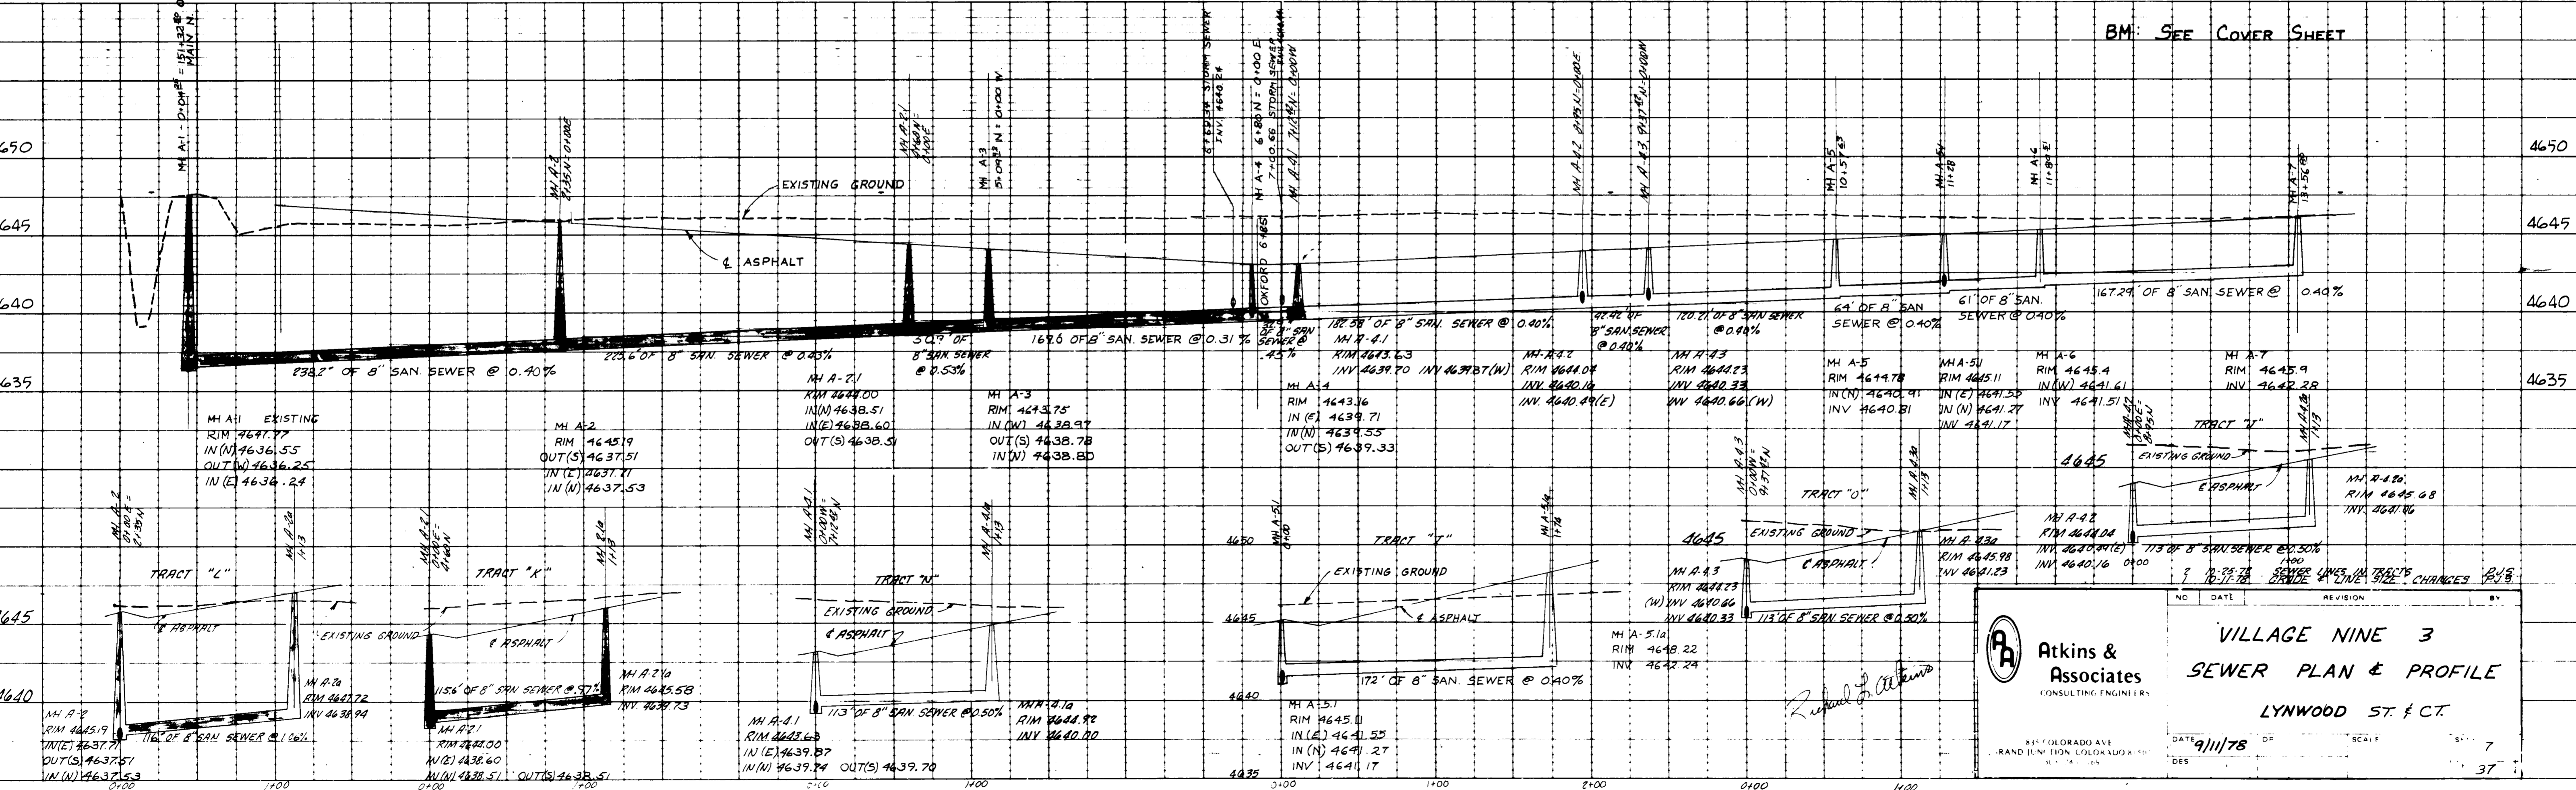

BM: SEE COVER SHEET




VILLAGE NINE 3
SEWER PLAN & PROFILE
LYNWOOD ST. & CT.
DATE 9/11/78 OF SCALE 7
DES 37

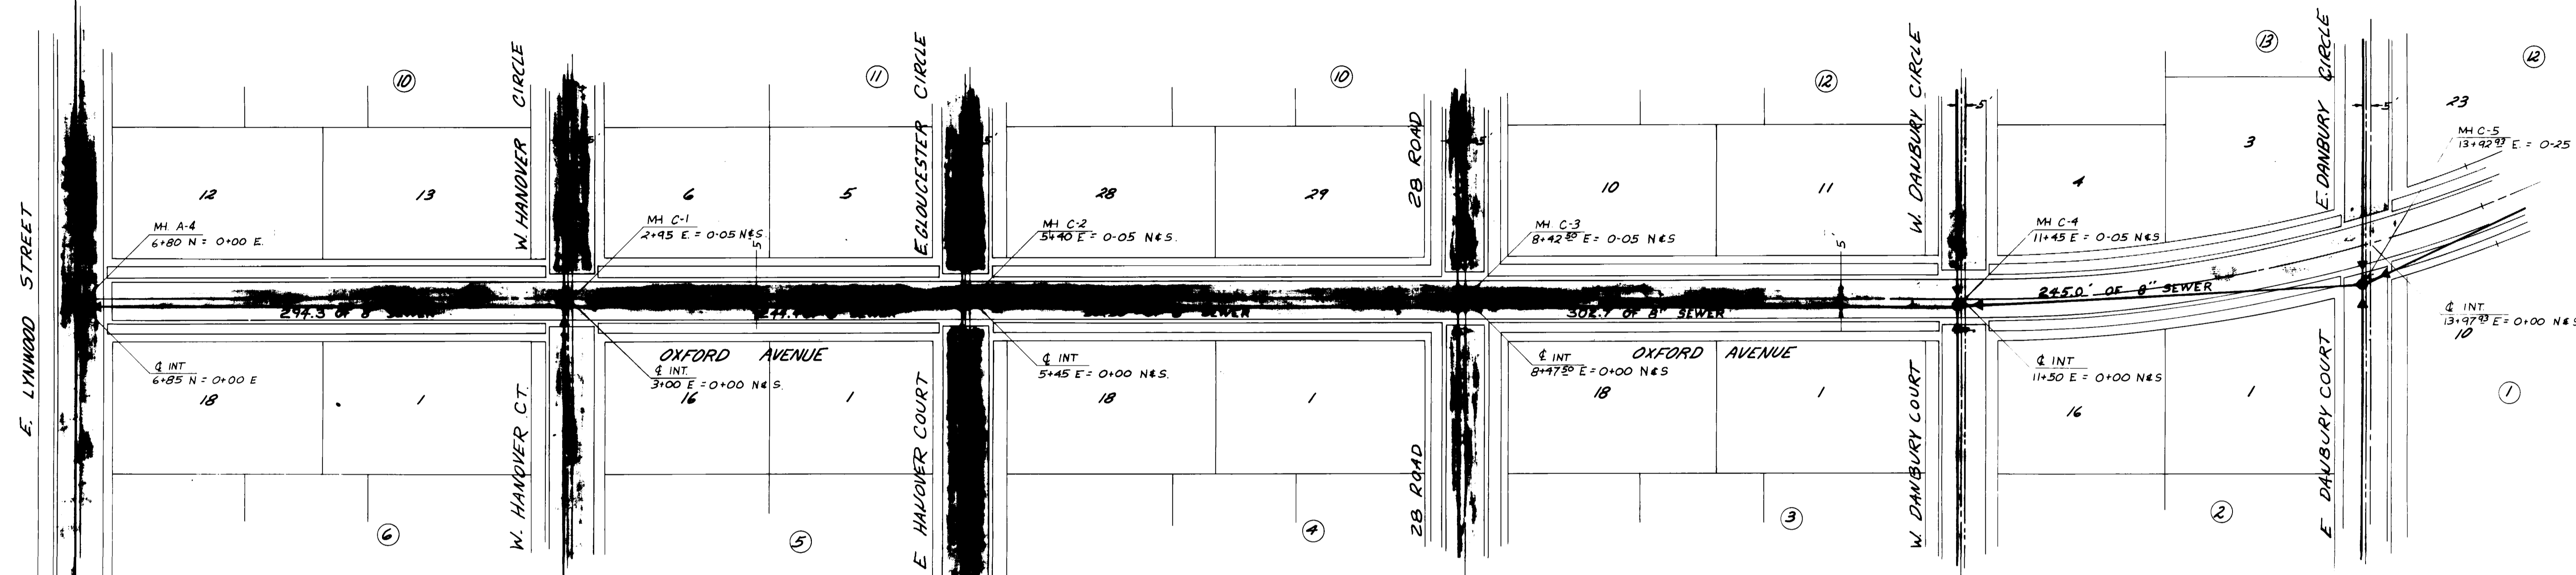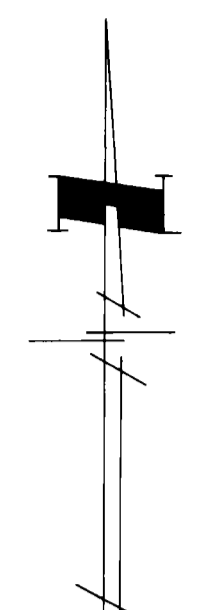

NOTE;
 Shaded pipe on profile indicates "As Built."
 All other not constructed.

SCALE
 HORIZ. 1"=50'
 VERT. 1"=5'

NOTE: 1. All Services Shall Extend 5 L.F. Into Each Lot
 2. The Pipe To Be Laid Continuously Through M.H.'s C-1, C-2, C-3

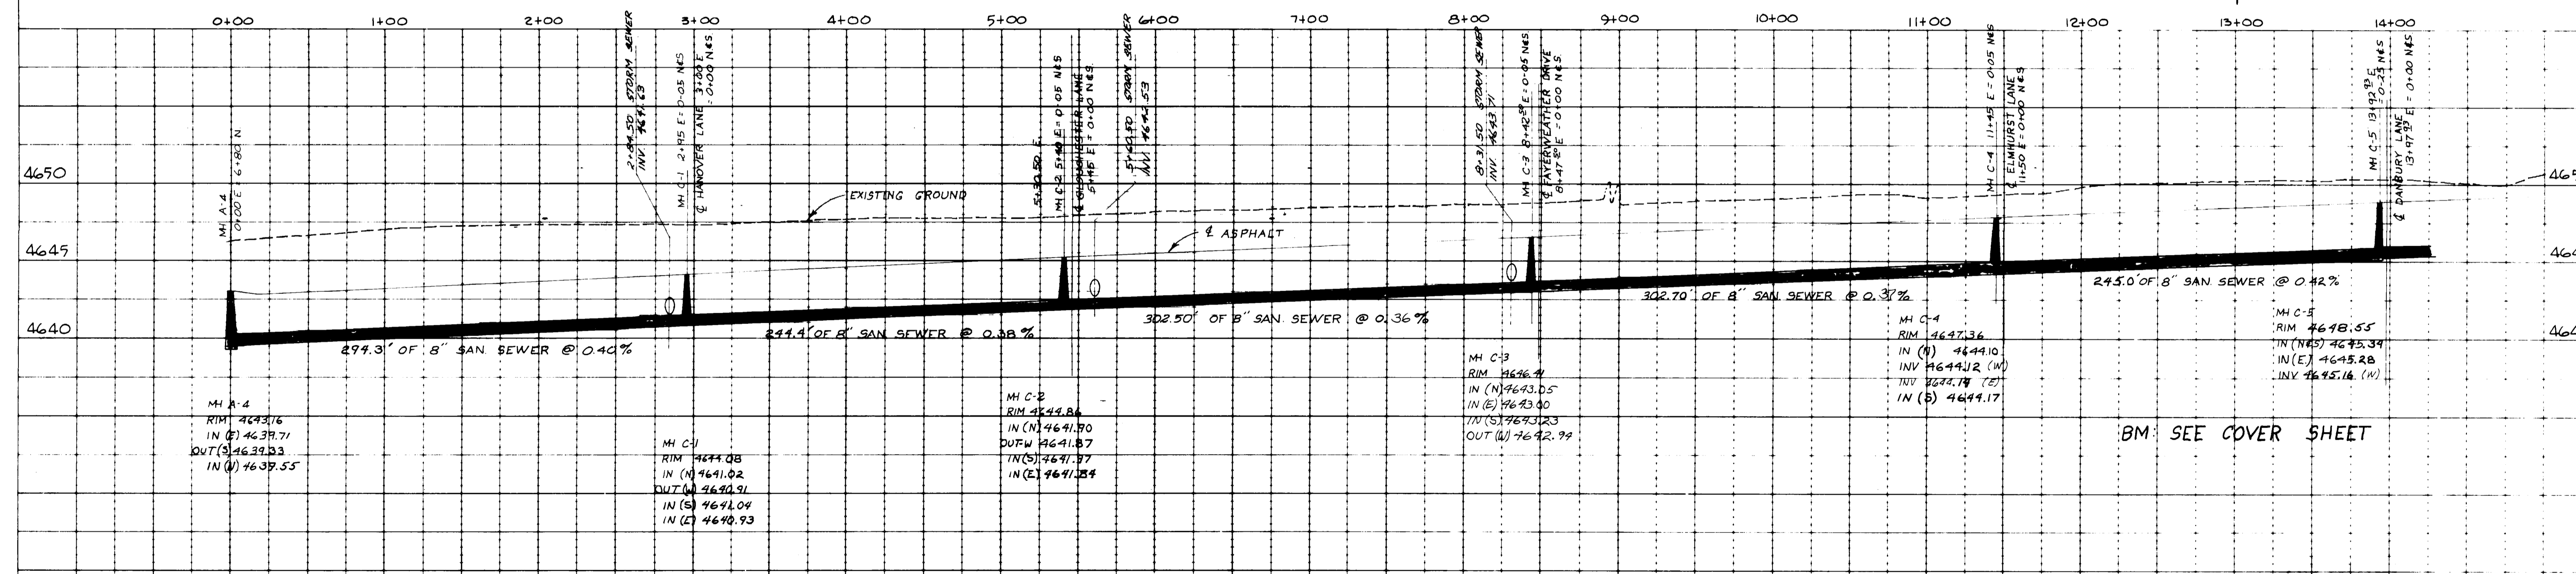

BM: SEE COVER SHEET

14-11-78 GRADE CHANGES P.J.S.



NO.	DATE	REVISION	BY

Atkins & Associates
 CONSULTING ENGINEERS

VILLAGE NINE 3
SEWER PLAN & PROFILE
 OXFORD AVENUE


DATE: 9/9/78 OR SCALE: SHEET: 9 OF: 37

W.S.

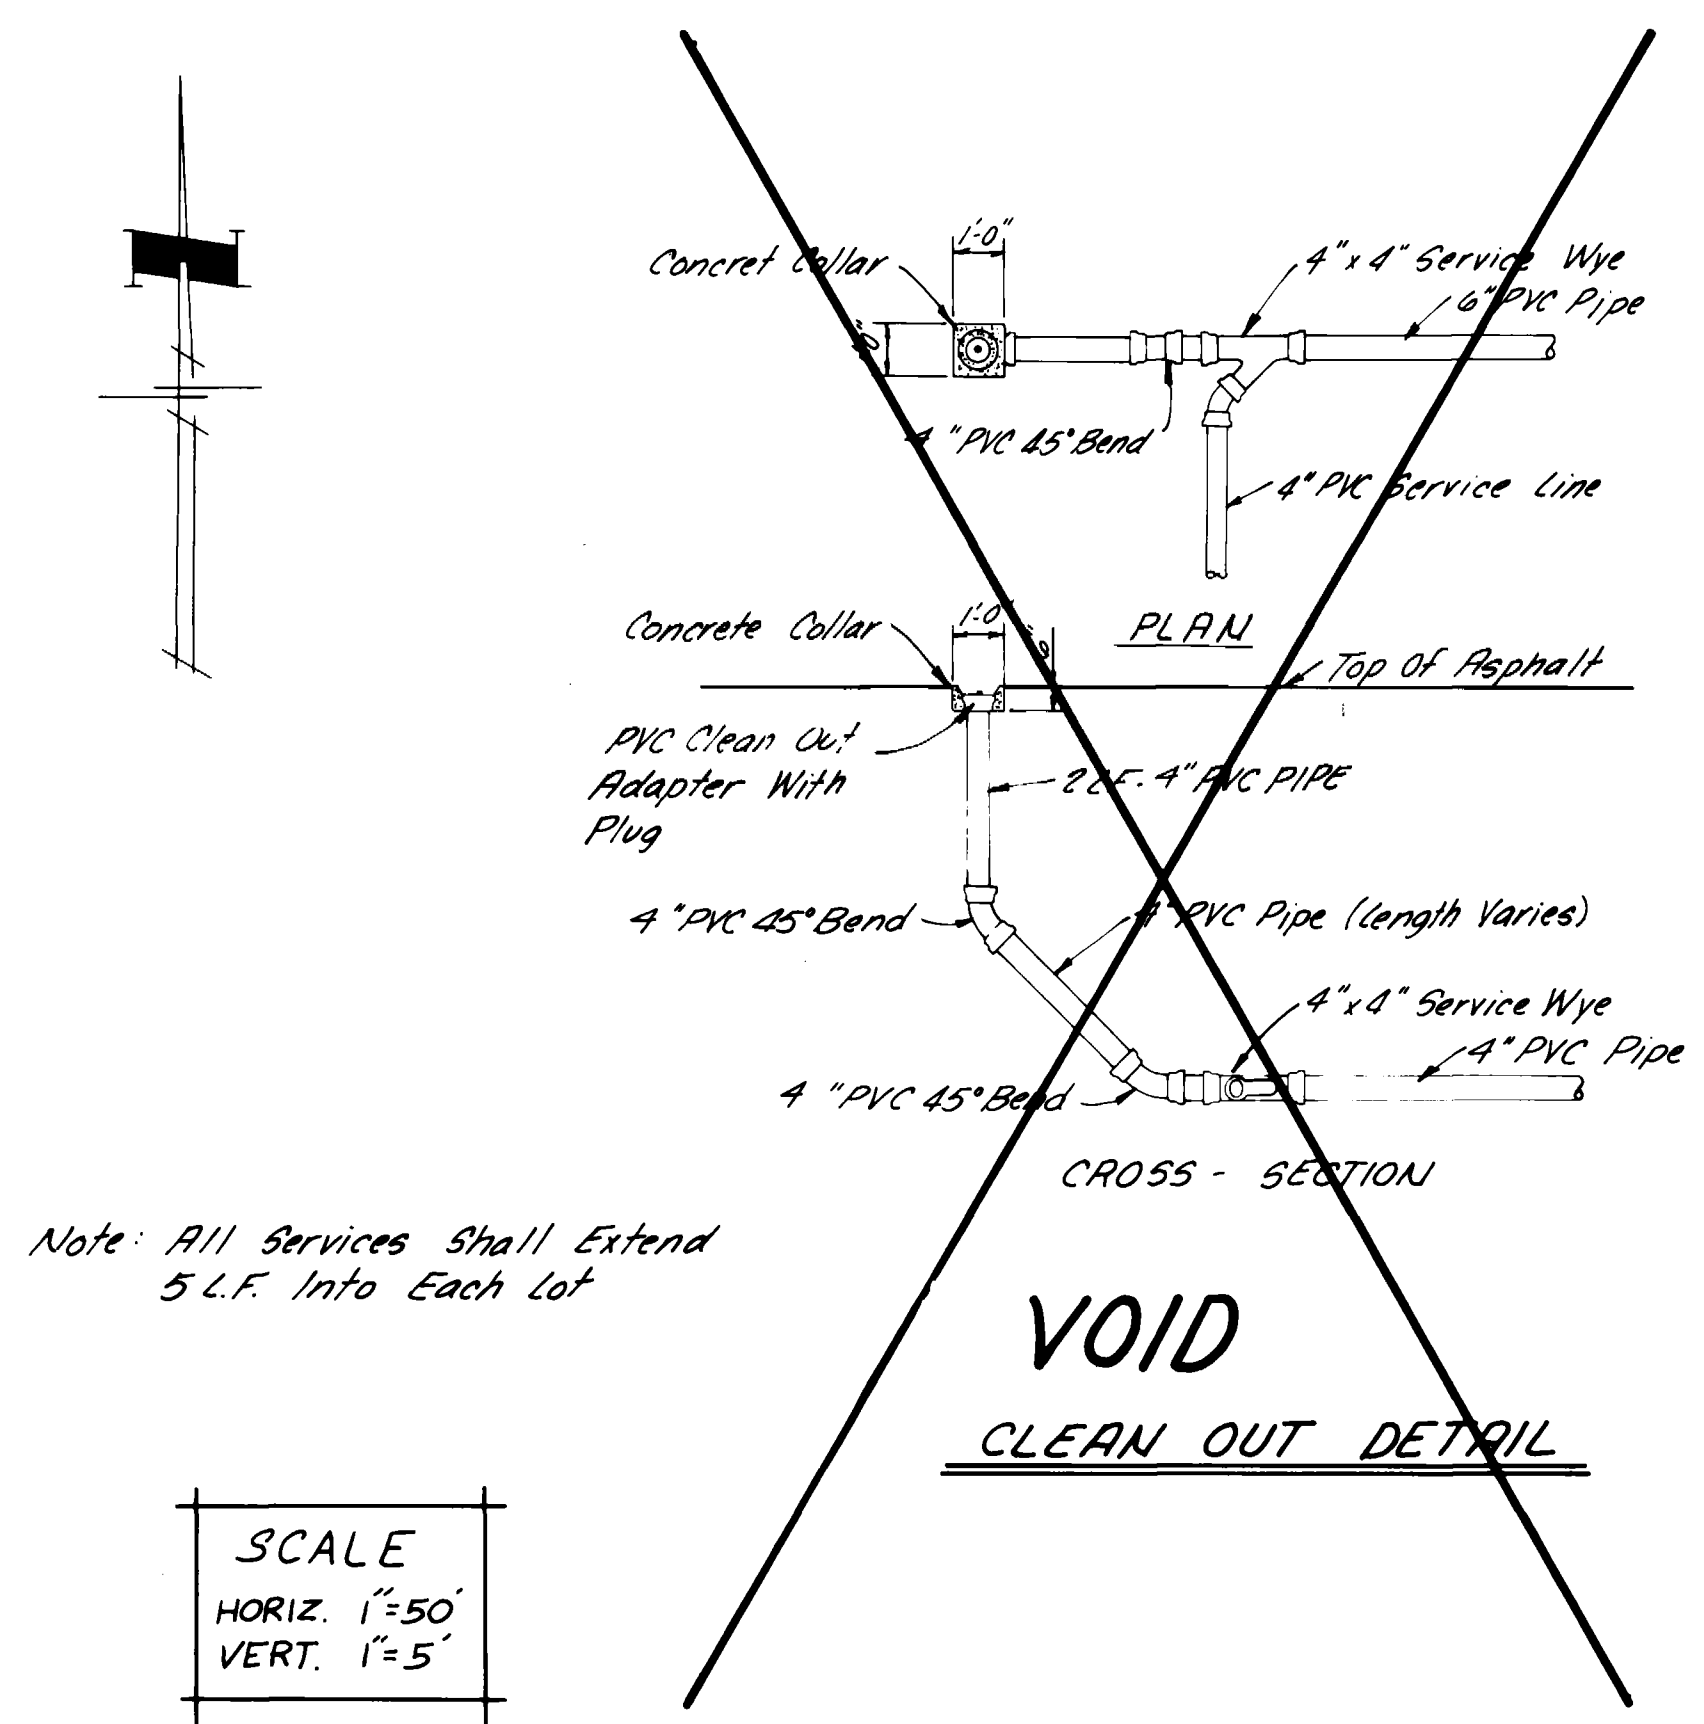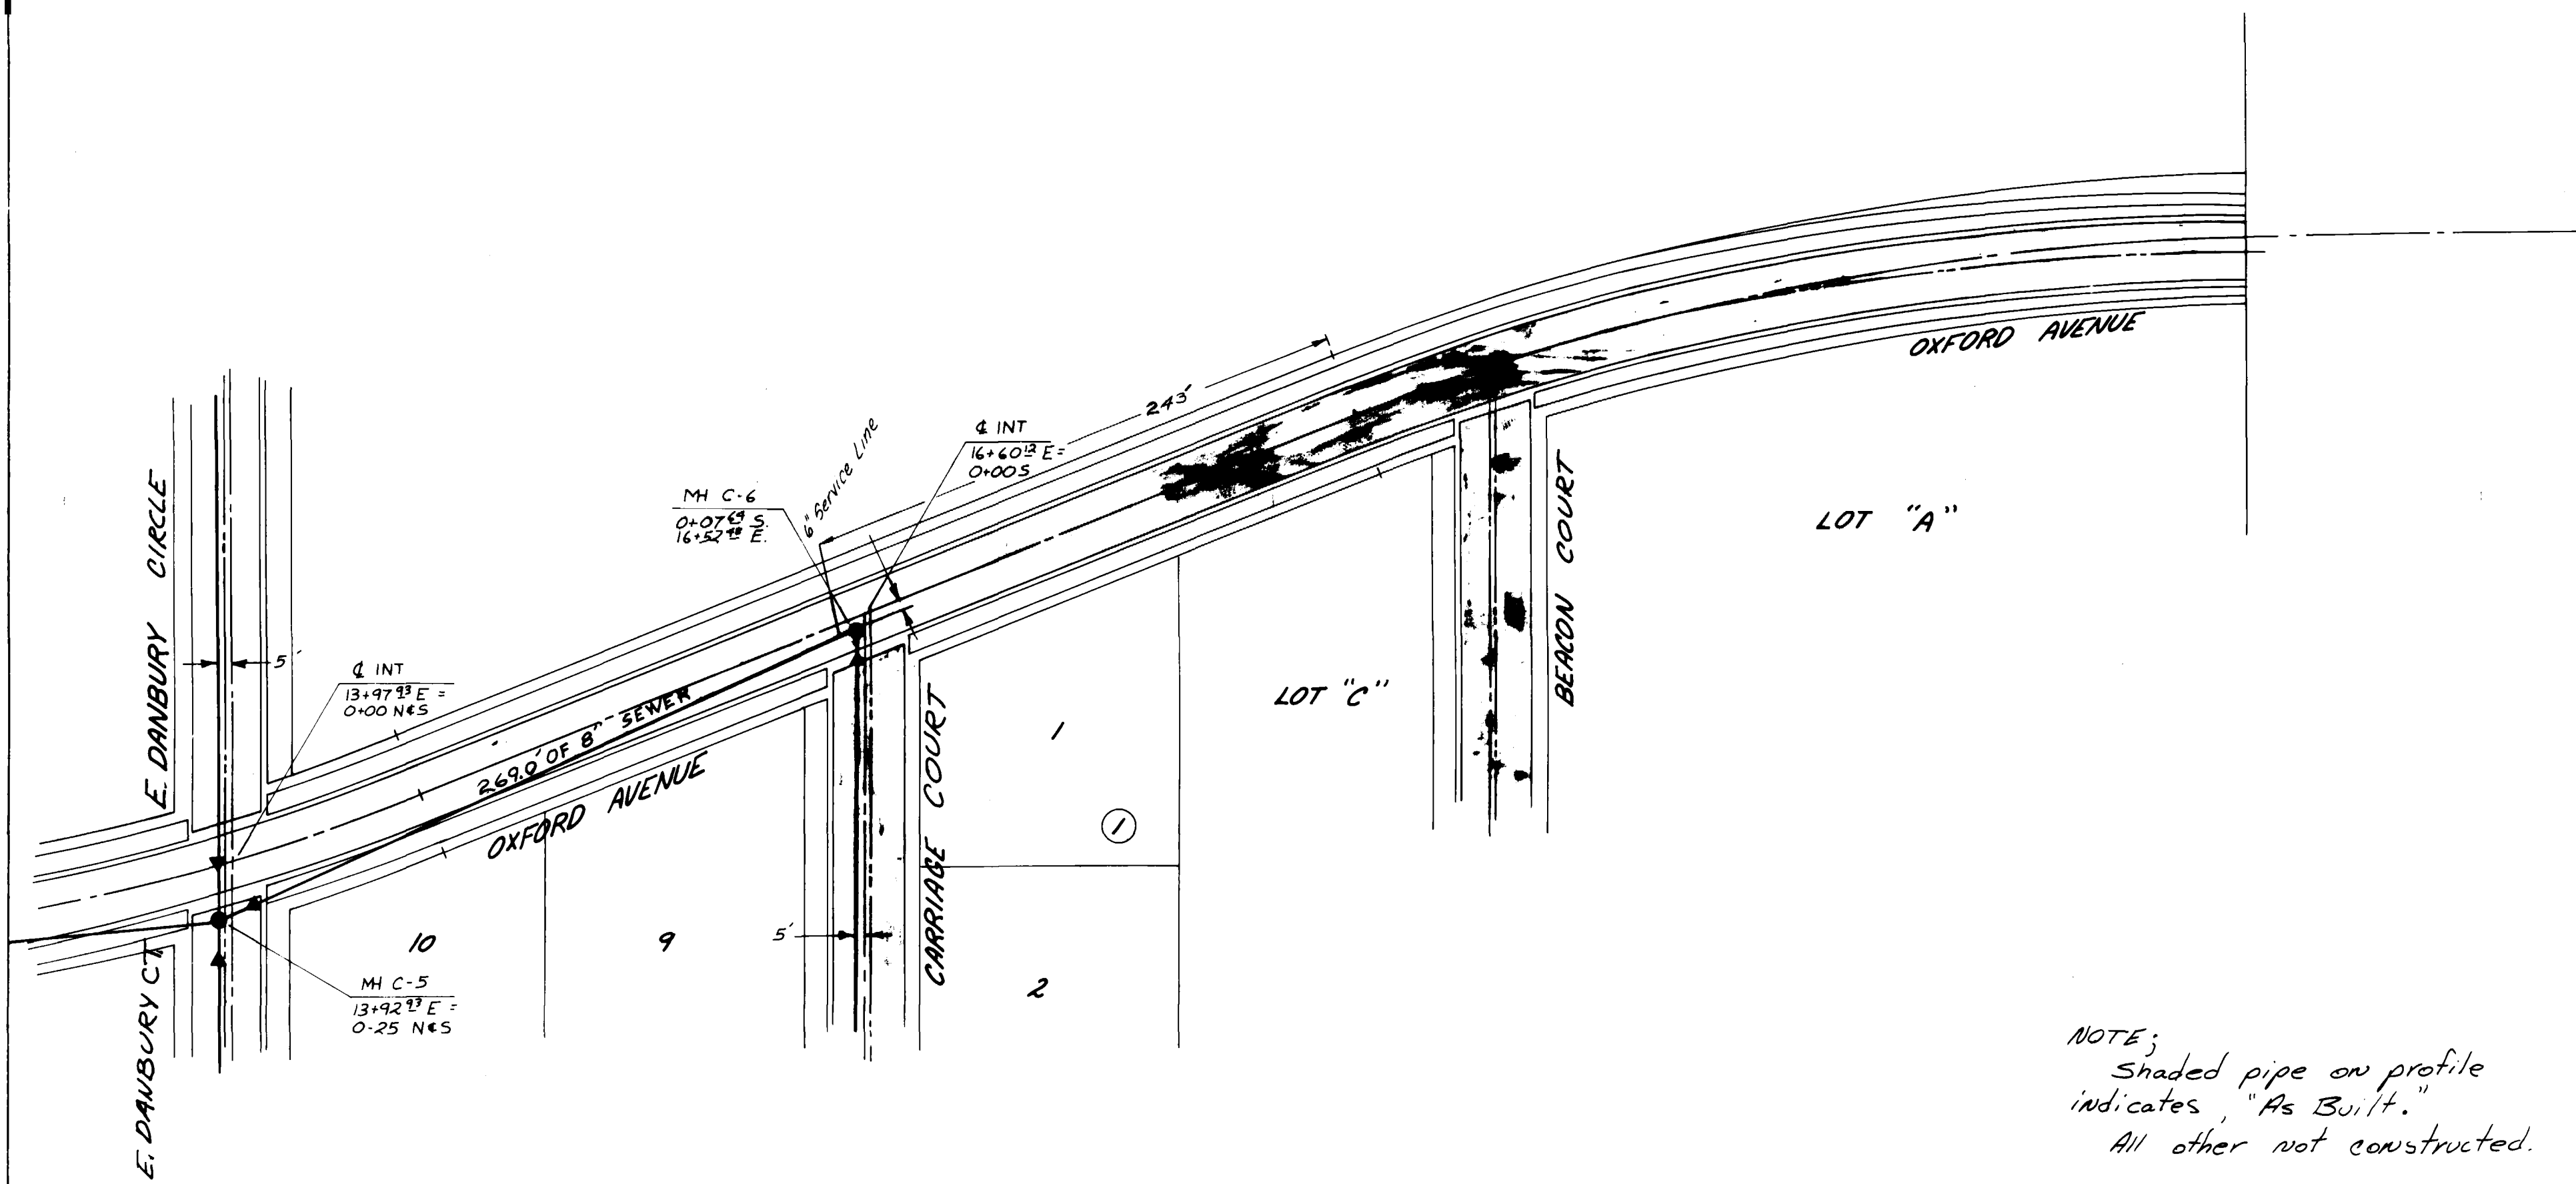

NOTE:
 Shaded pipe on profile
 indicates, "As Built."
 All other not constructed.

SCALE
 HORIZ. 1"=50'
 VERT. 1"=5'

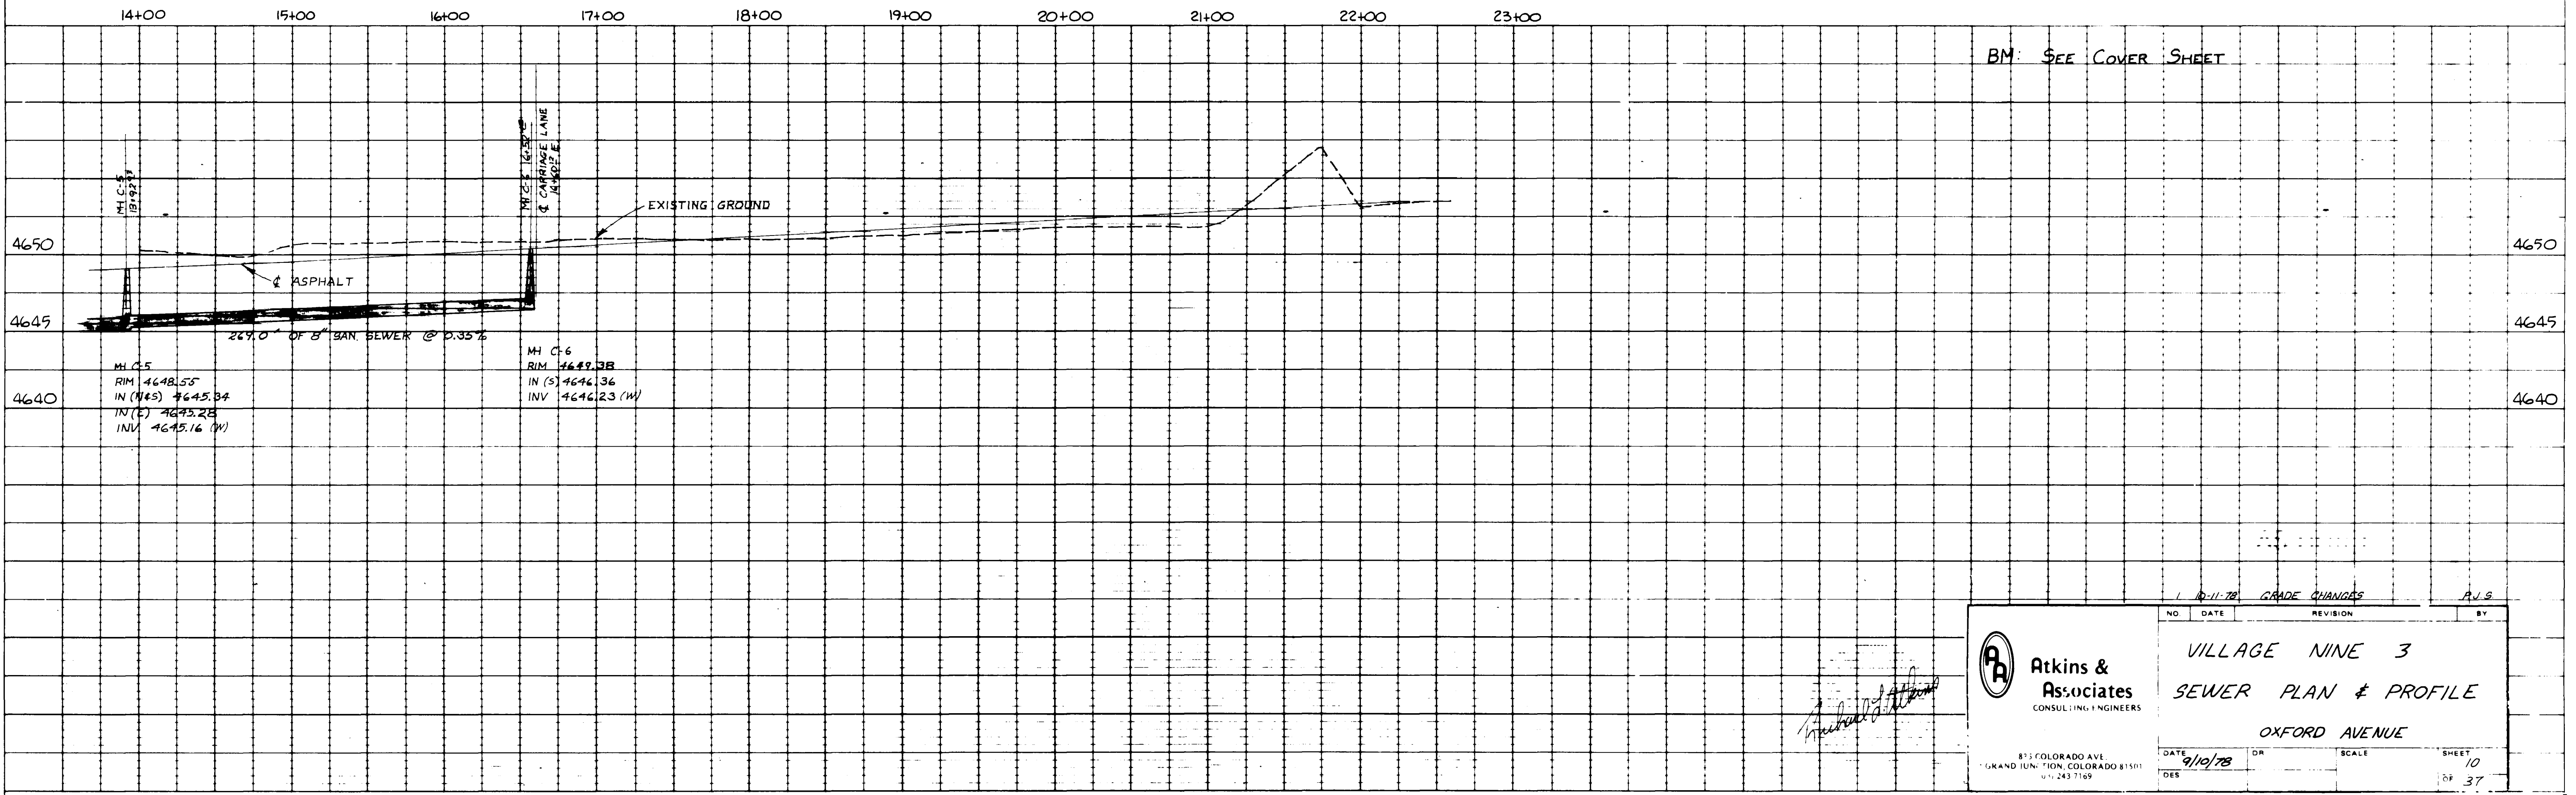



10-11-78		GRADE CHANGES		AUG	
NO.	DATE	REVISION	BY		
Atkins & Associates CONSULTING ENGINEERS					
VILLAGE NINE 3 SEWER PLAN & PROFILE OXFORD AVENUE					
DATE	DR	SCALE	SHEET		
9/10/78			10		
DES			OF 37		

02-212

NOTE:
 Shaded pipe on profile indicates "As Built"
 All other not constructed.

- NOTES 1. The Maximum Stub Length is 5' Past MH C-3.6
 2. All Services Shall Extend 5' L.F. Into Each Lot
 3. The Pipe Will Be Laid Continuously Through MH's C-3.1, C-3.2, & C-3.4

SCALE
 HORIZ. 1"=50'
 VERT. 1"=5'

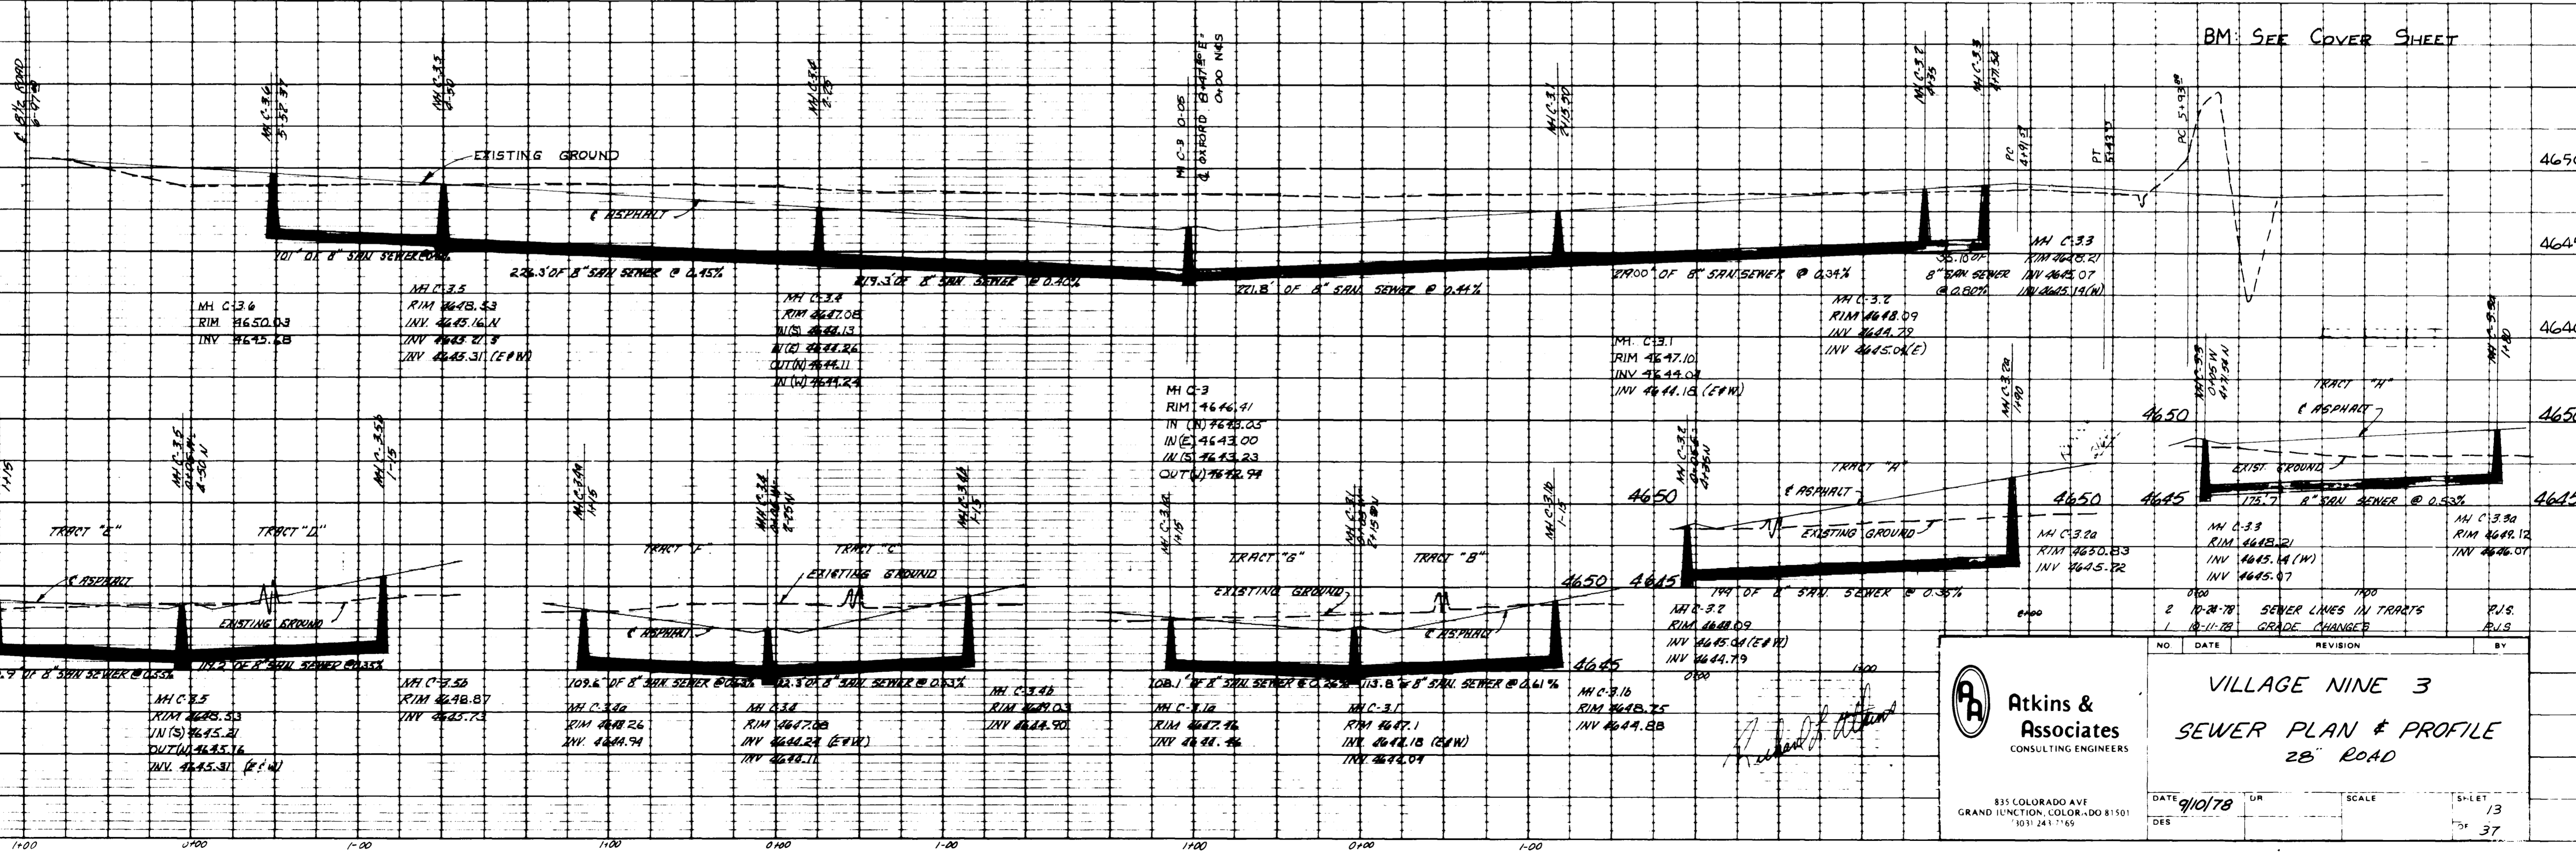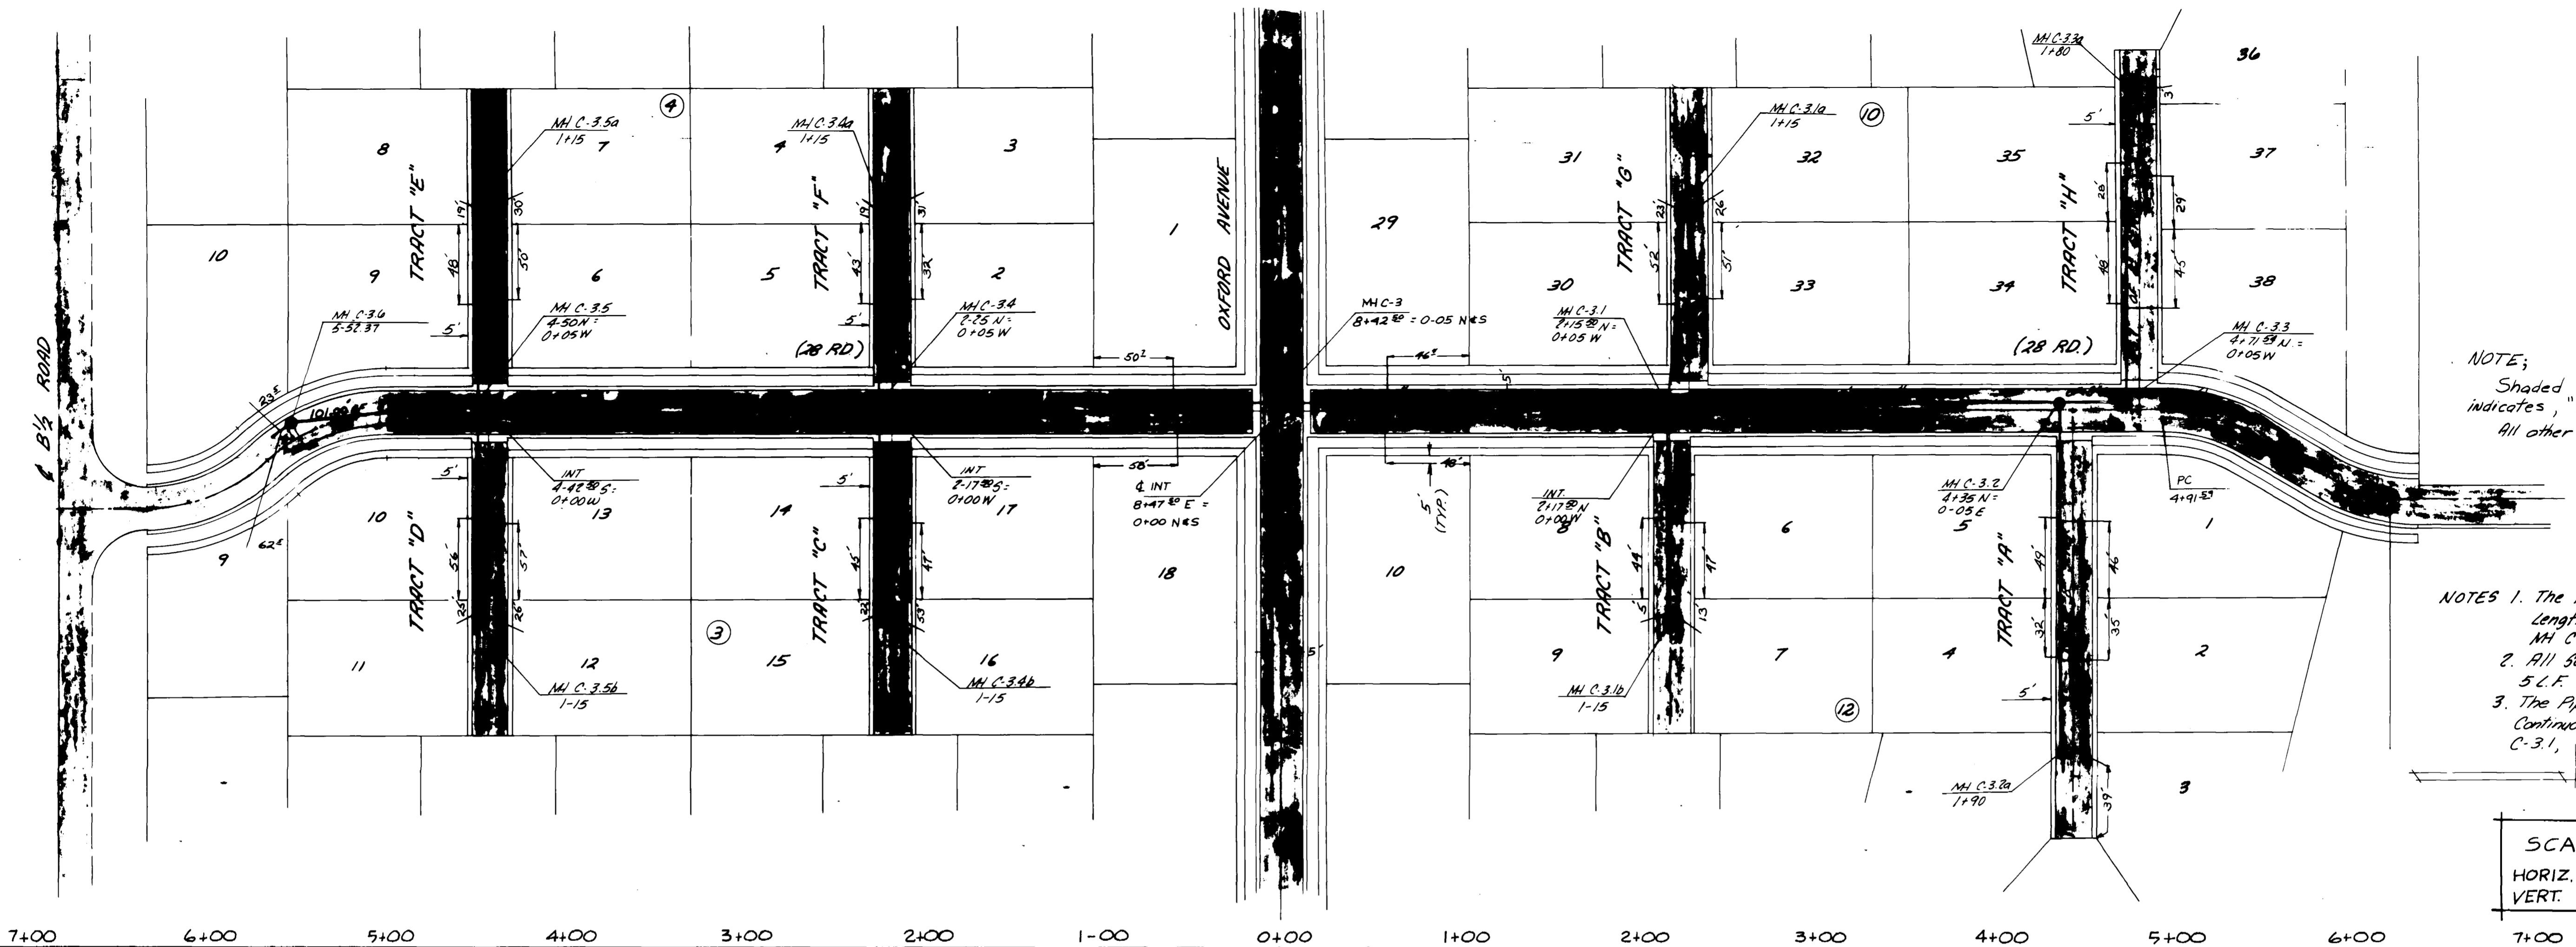


Atkins & Associates
 CONSULTING ENGINEERS

VILLAGE NINE 3
 SEWER PLAN & PROFILE
 28th ROAD

NO.	DATE	REVISION	BY
1	10-21-78	SEWER LINES IN TRACT'S GRADE CHANGES	P.L.S.
2	12-11-78		P.L.S.

DATE 9/10/78
 SCALE
 SHEET 37 OF 37

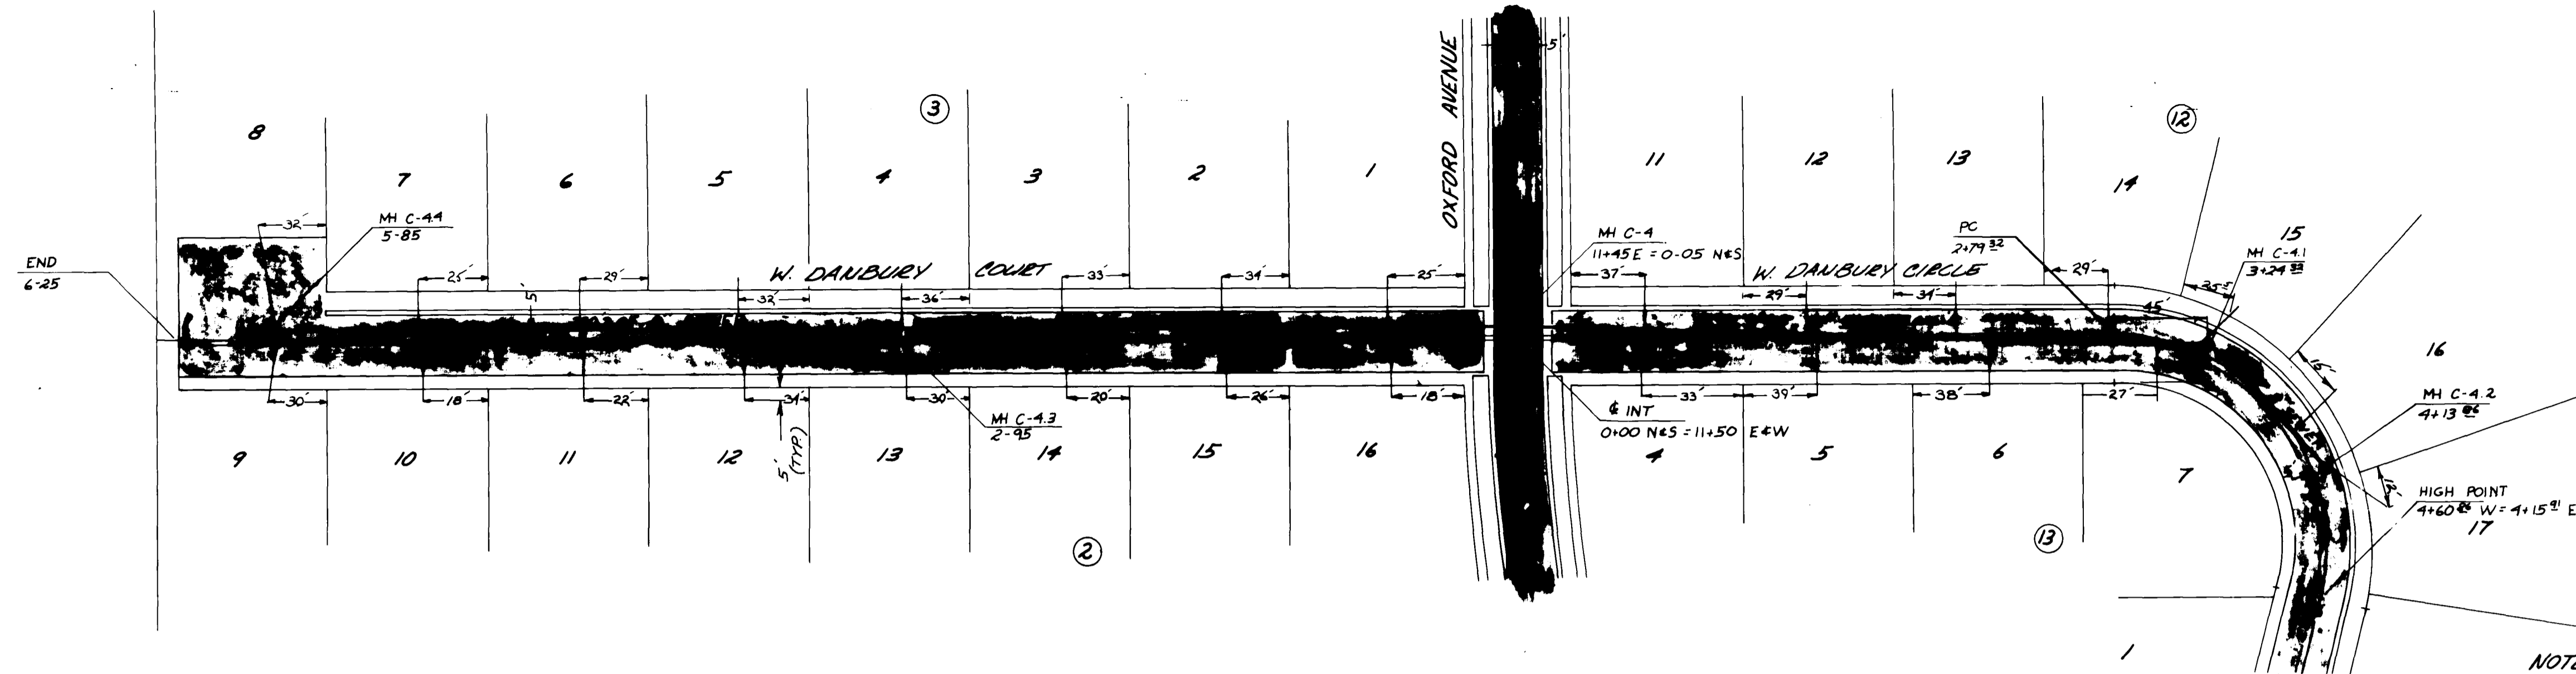


NOTE: 1. All Services Shall Extend 5' L.F. Into Each Lot
 2. The Pipe Will Be Laid Continuously Through MH C-4.3

3. The Maximum Stub Length Is 5' Past MH C-4.2

SCALE
 HORIZ 1"=50'
 VERT 1"=5'

NOTE:
 Shaded pipe on profile indicates "As Built."
 All other not constructed.


7-00 6-00 5-00 4-00 3-00 2-00 1-00 0+00 1+00 2+00 3+00 4+00 5+00 6+00

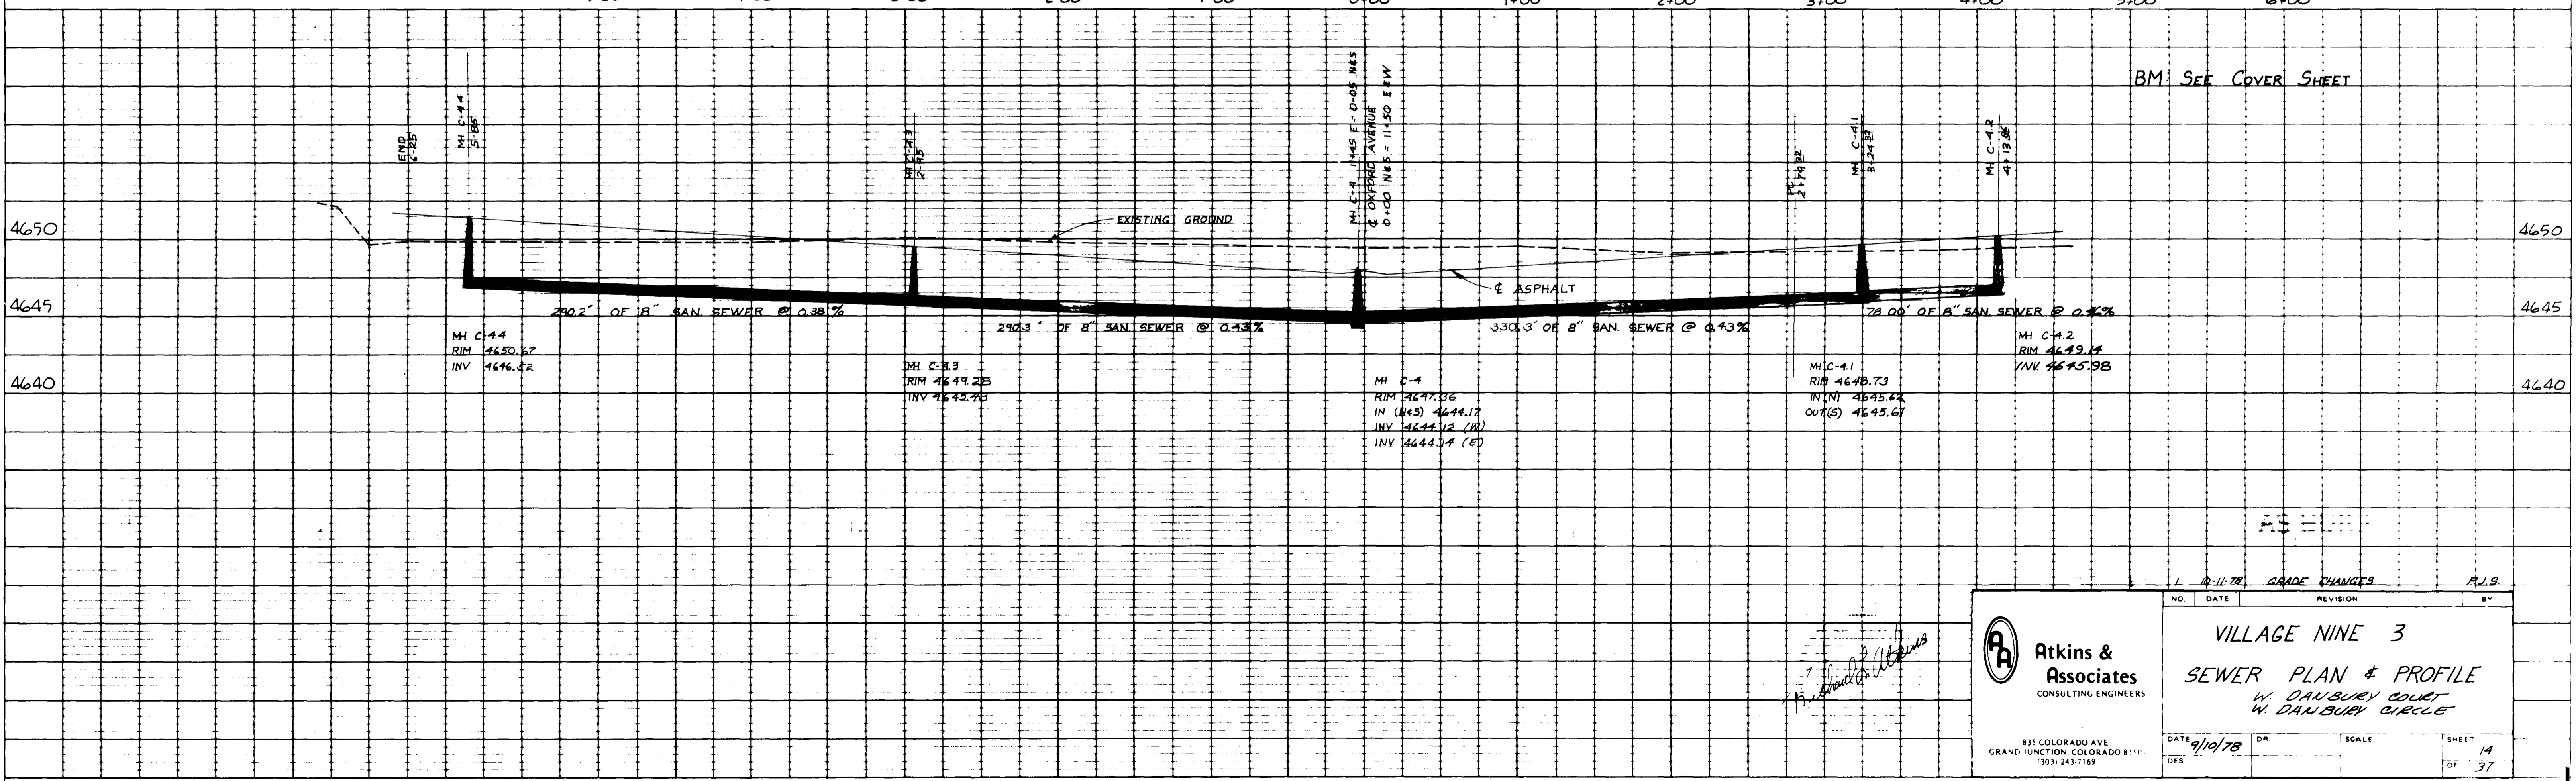

BM SEE COVER SHEET

AS SHOWN


<p>Atkins & Associates CONSULTING ENGINEERS</p> <p>835 COLORADO AVE. GRAND JUNCTION, COLORADO 81501 (930) 243-7169</p>	NO. _____ DATE 9/10/78 DES. _____	REVISION 1. 10-11-78 GRADE CHANGES P.J.S.	BY _____
	VILLAGE NINE 3 SEWER PLAN & PROFILE W. DANBURY COURT W. DANBURY CIRCLE		
	SCALE HORIZ 1"=50' VERT 1"=5'	SHEET 14 OF 37	

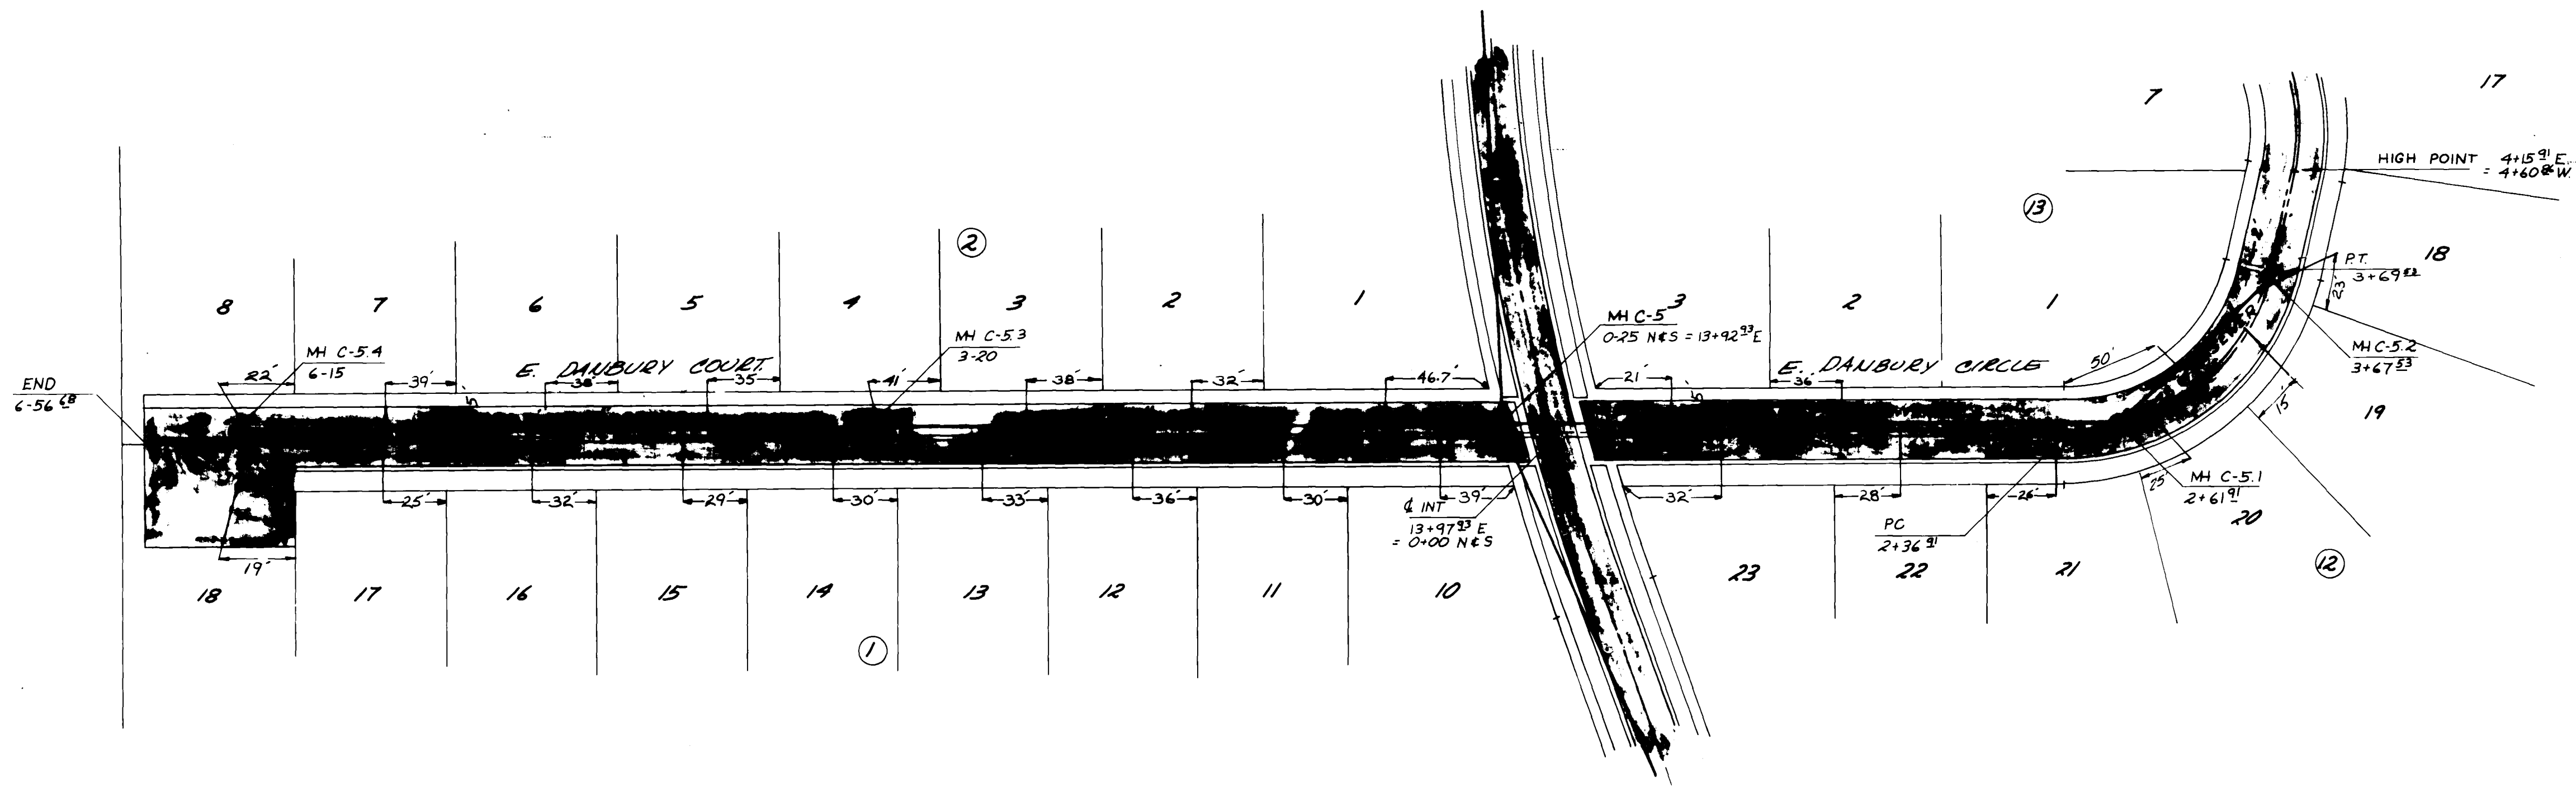



SCALE
 HORIZ. 1"=50'
 VERT. 1"=5'

- NOTE: 1. All Services Shall Extend 5 L.F. Into Each Lot
 2. The Pipe Will Be Laid Continuously Through MH C-5.3
 3. The Maximum Stub Length Is 5' Past MH C-5.2

NOTE:
 Shaded pipe on profile indicates "As Built."
 All other not constructed.

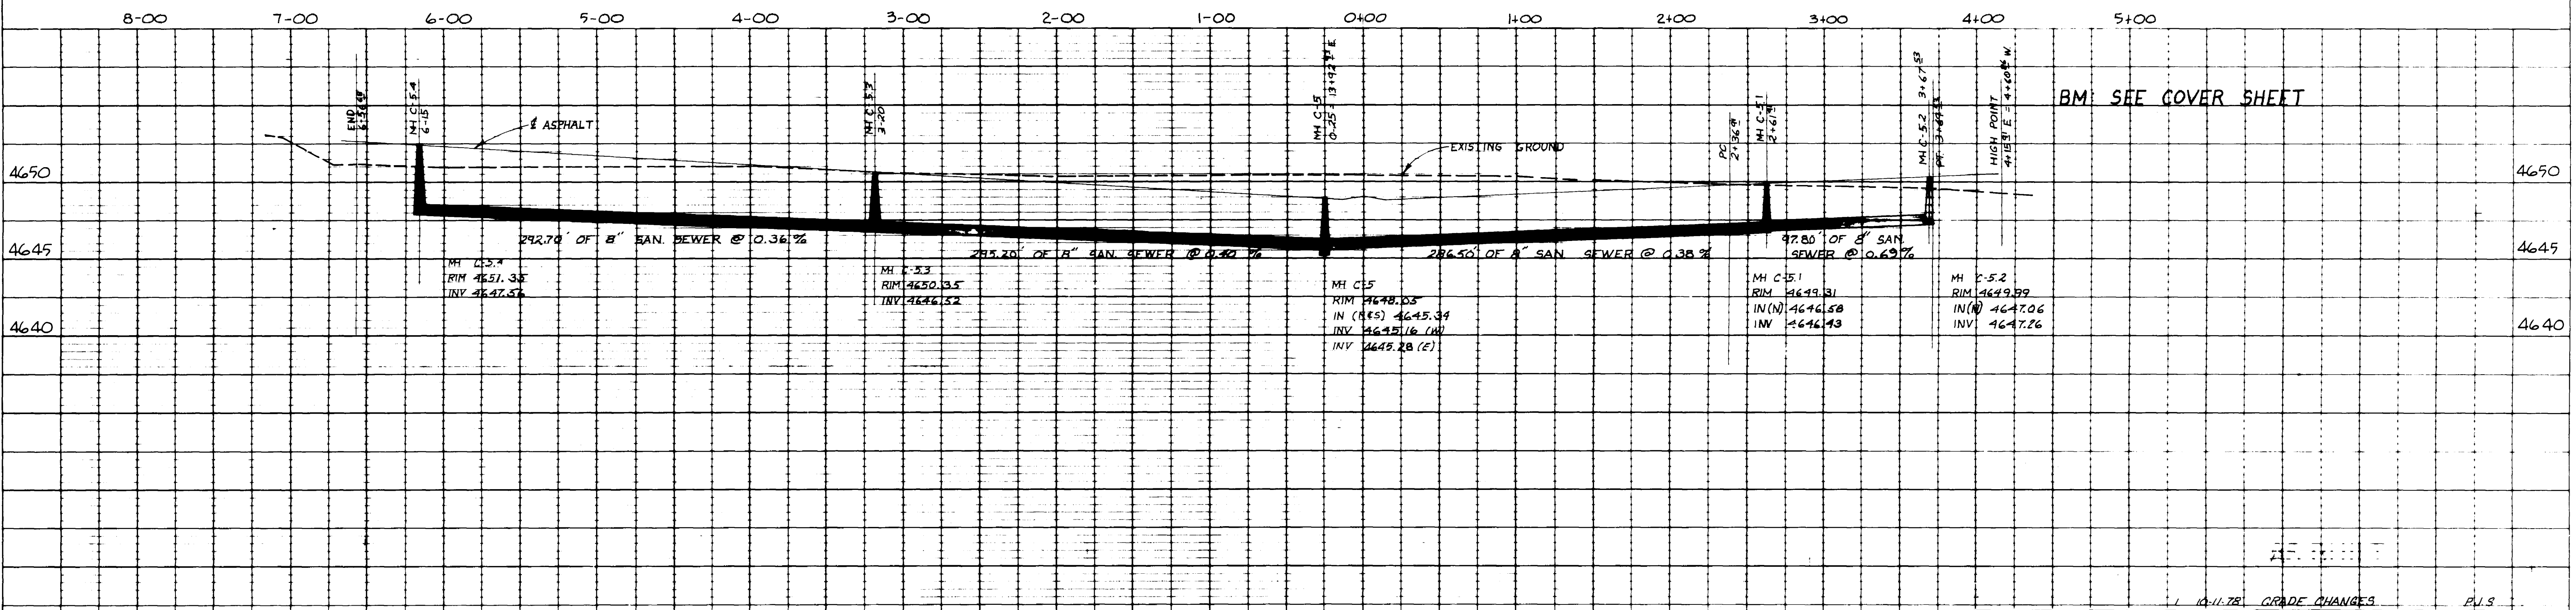

NO.		DATE		REVISION		BY	
Atkins & Associates CONSULTING ENGINEERS 835 COLORADO AVE. GRAND JUNCTION COLORADO 81505 (303) 241-7169							
VILLAGE NINE 3 SEWER PLAN & PROFILE E. DANBURY COURT E. DANBURY CIRCLE				DATE: 9/9/78		SCALE: 15/37	

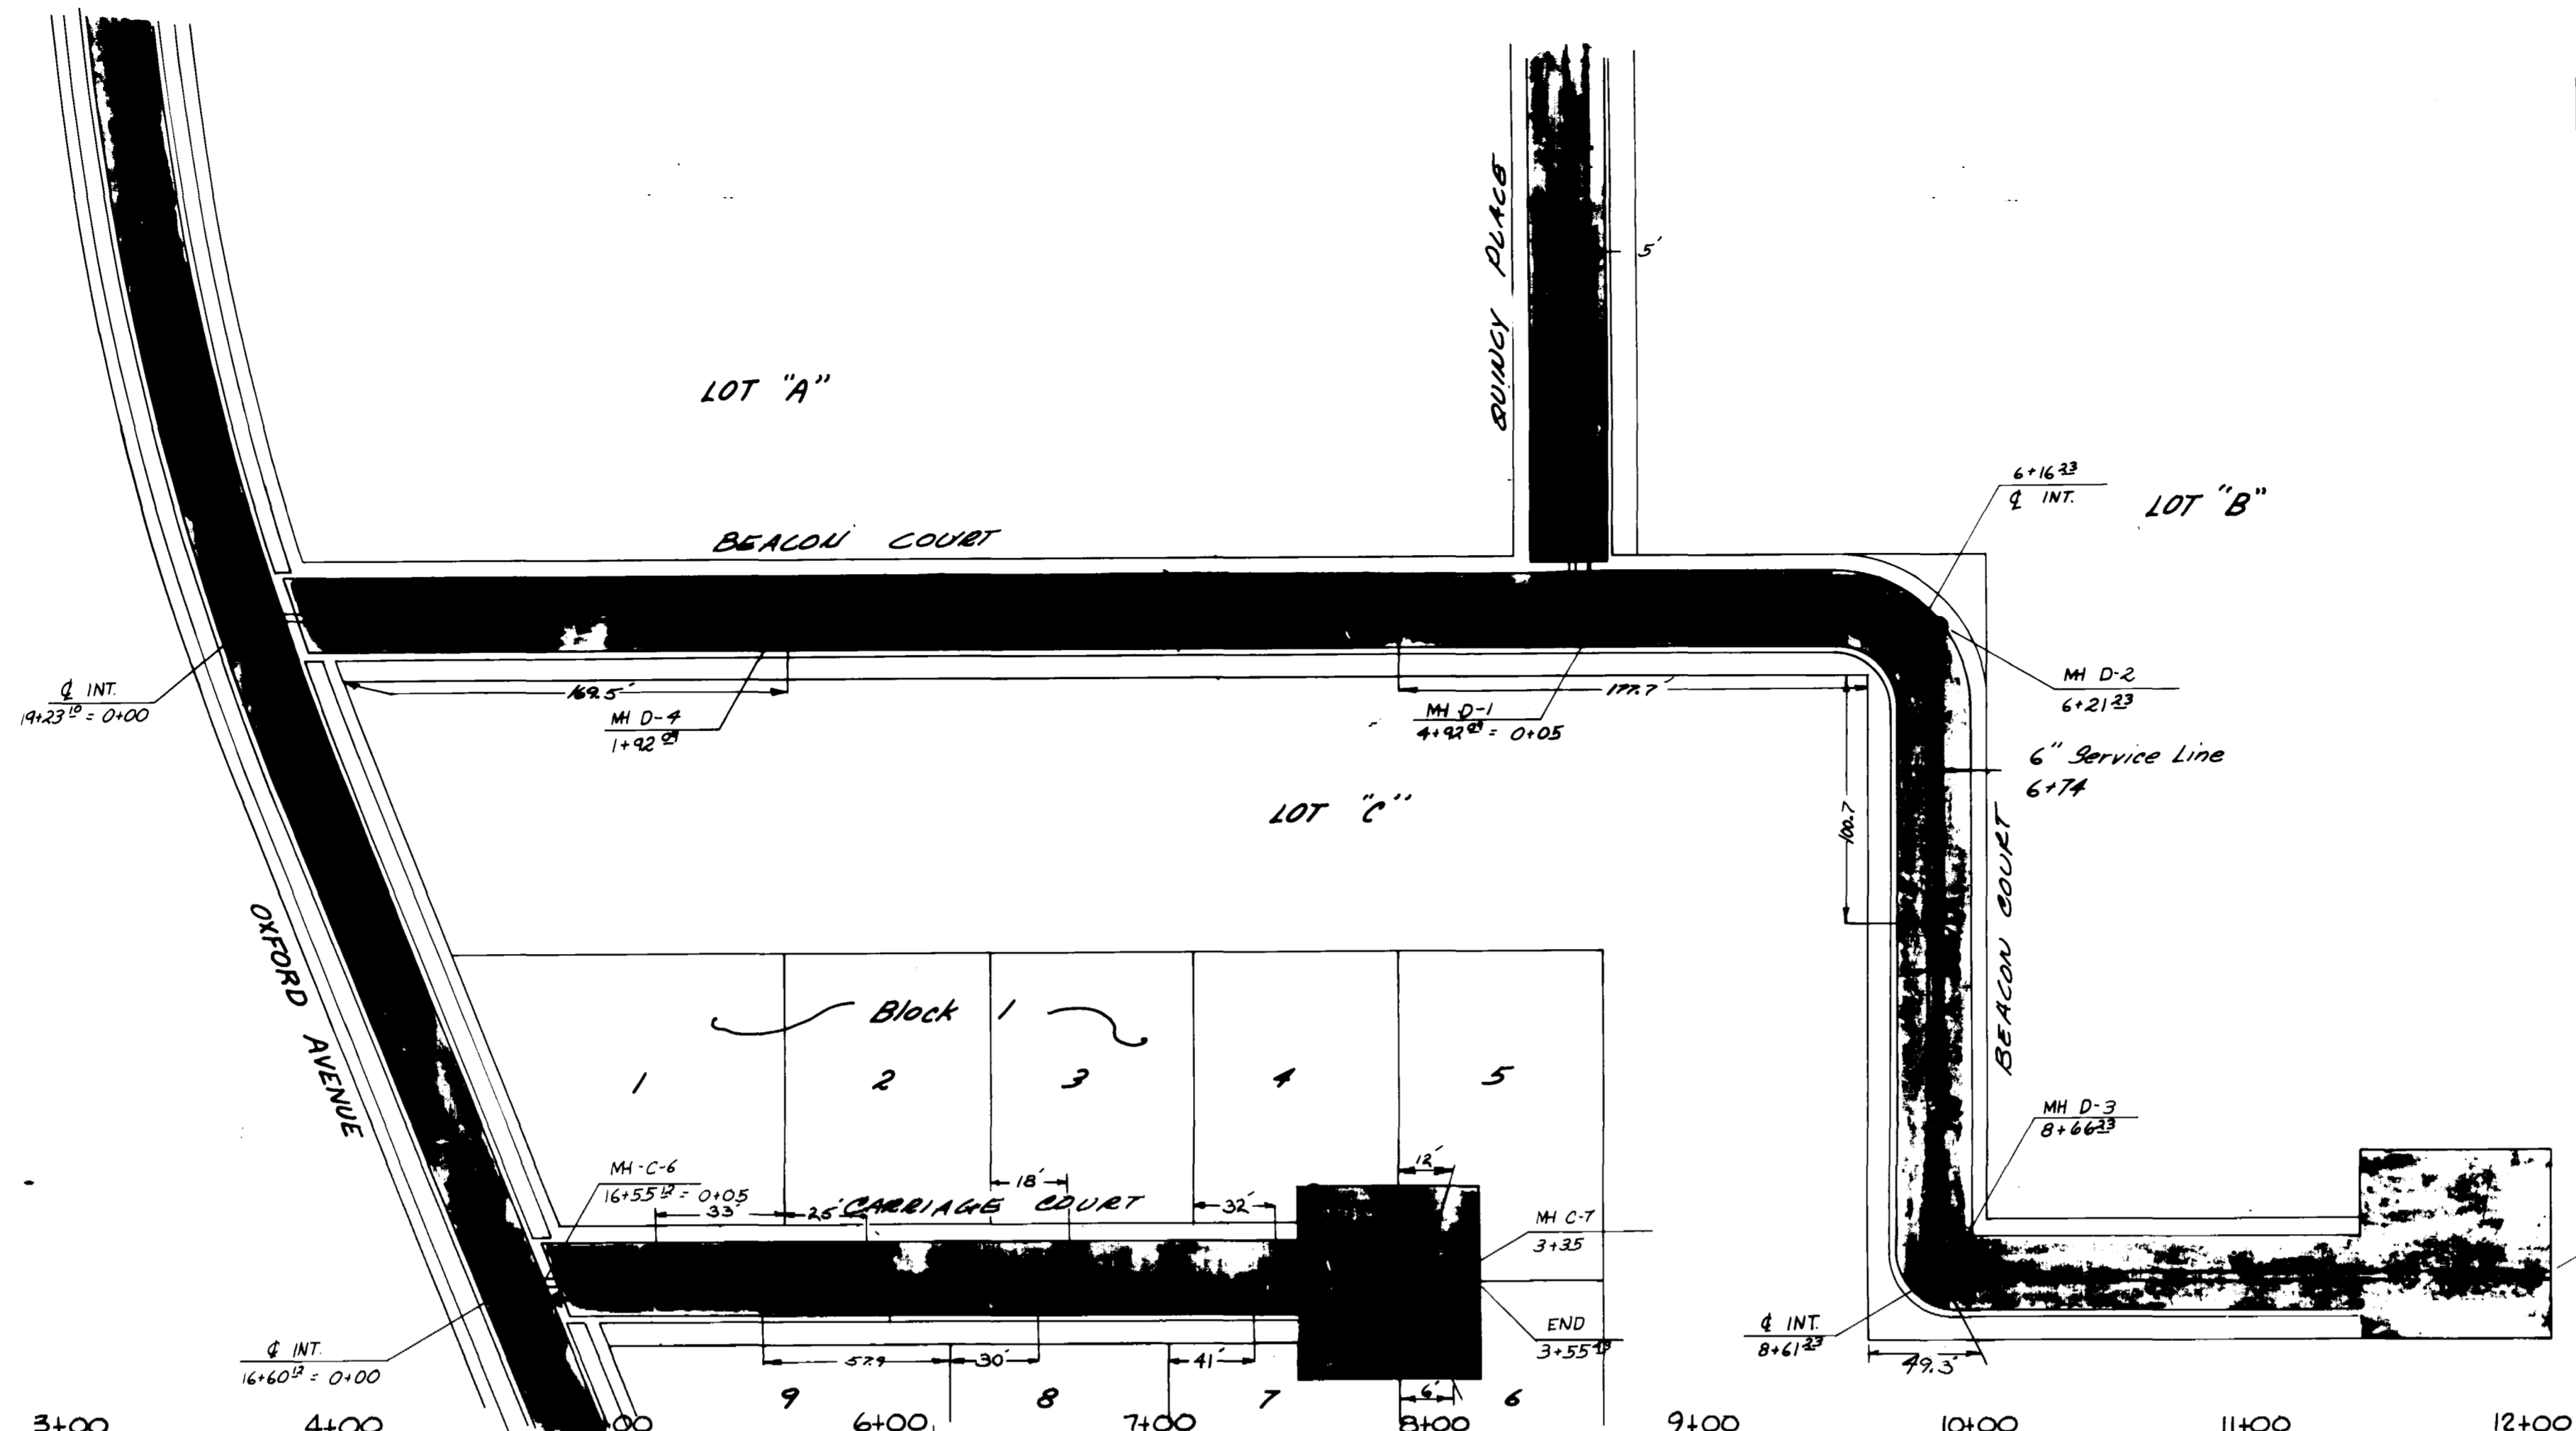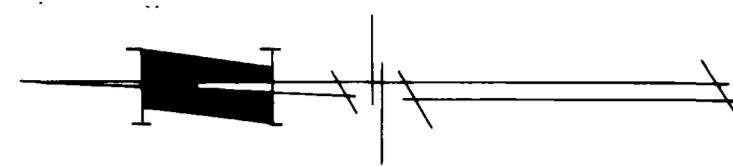

Note 1. All Services Shall Extend 5'L.F. Into Each Lot

NOTE:
Shaded pipe on profile indicates "As Built".
All other Not Constructed.

SCALE
HORIZ 1"=50'
VERT 1"=5'




NO.	DATE	REVISION	BY
1	10-11-78	GRADE CHANGES	R.J.S.

Atkins & Associates
CONSULTING ENGINEERS

VILLAGE NINE 3
SEWER PLAN & PROFILE
BEACON COURT
CARRIAGE COURT


DATE: 9/8/78
SCALE: SHEET 16 OF 37

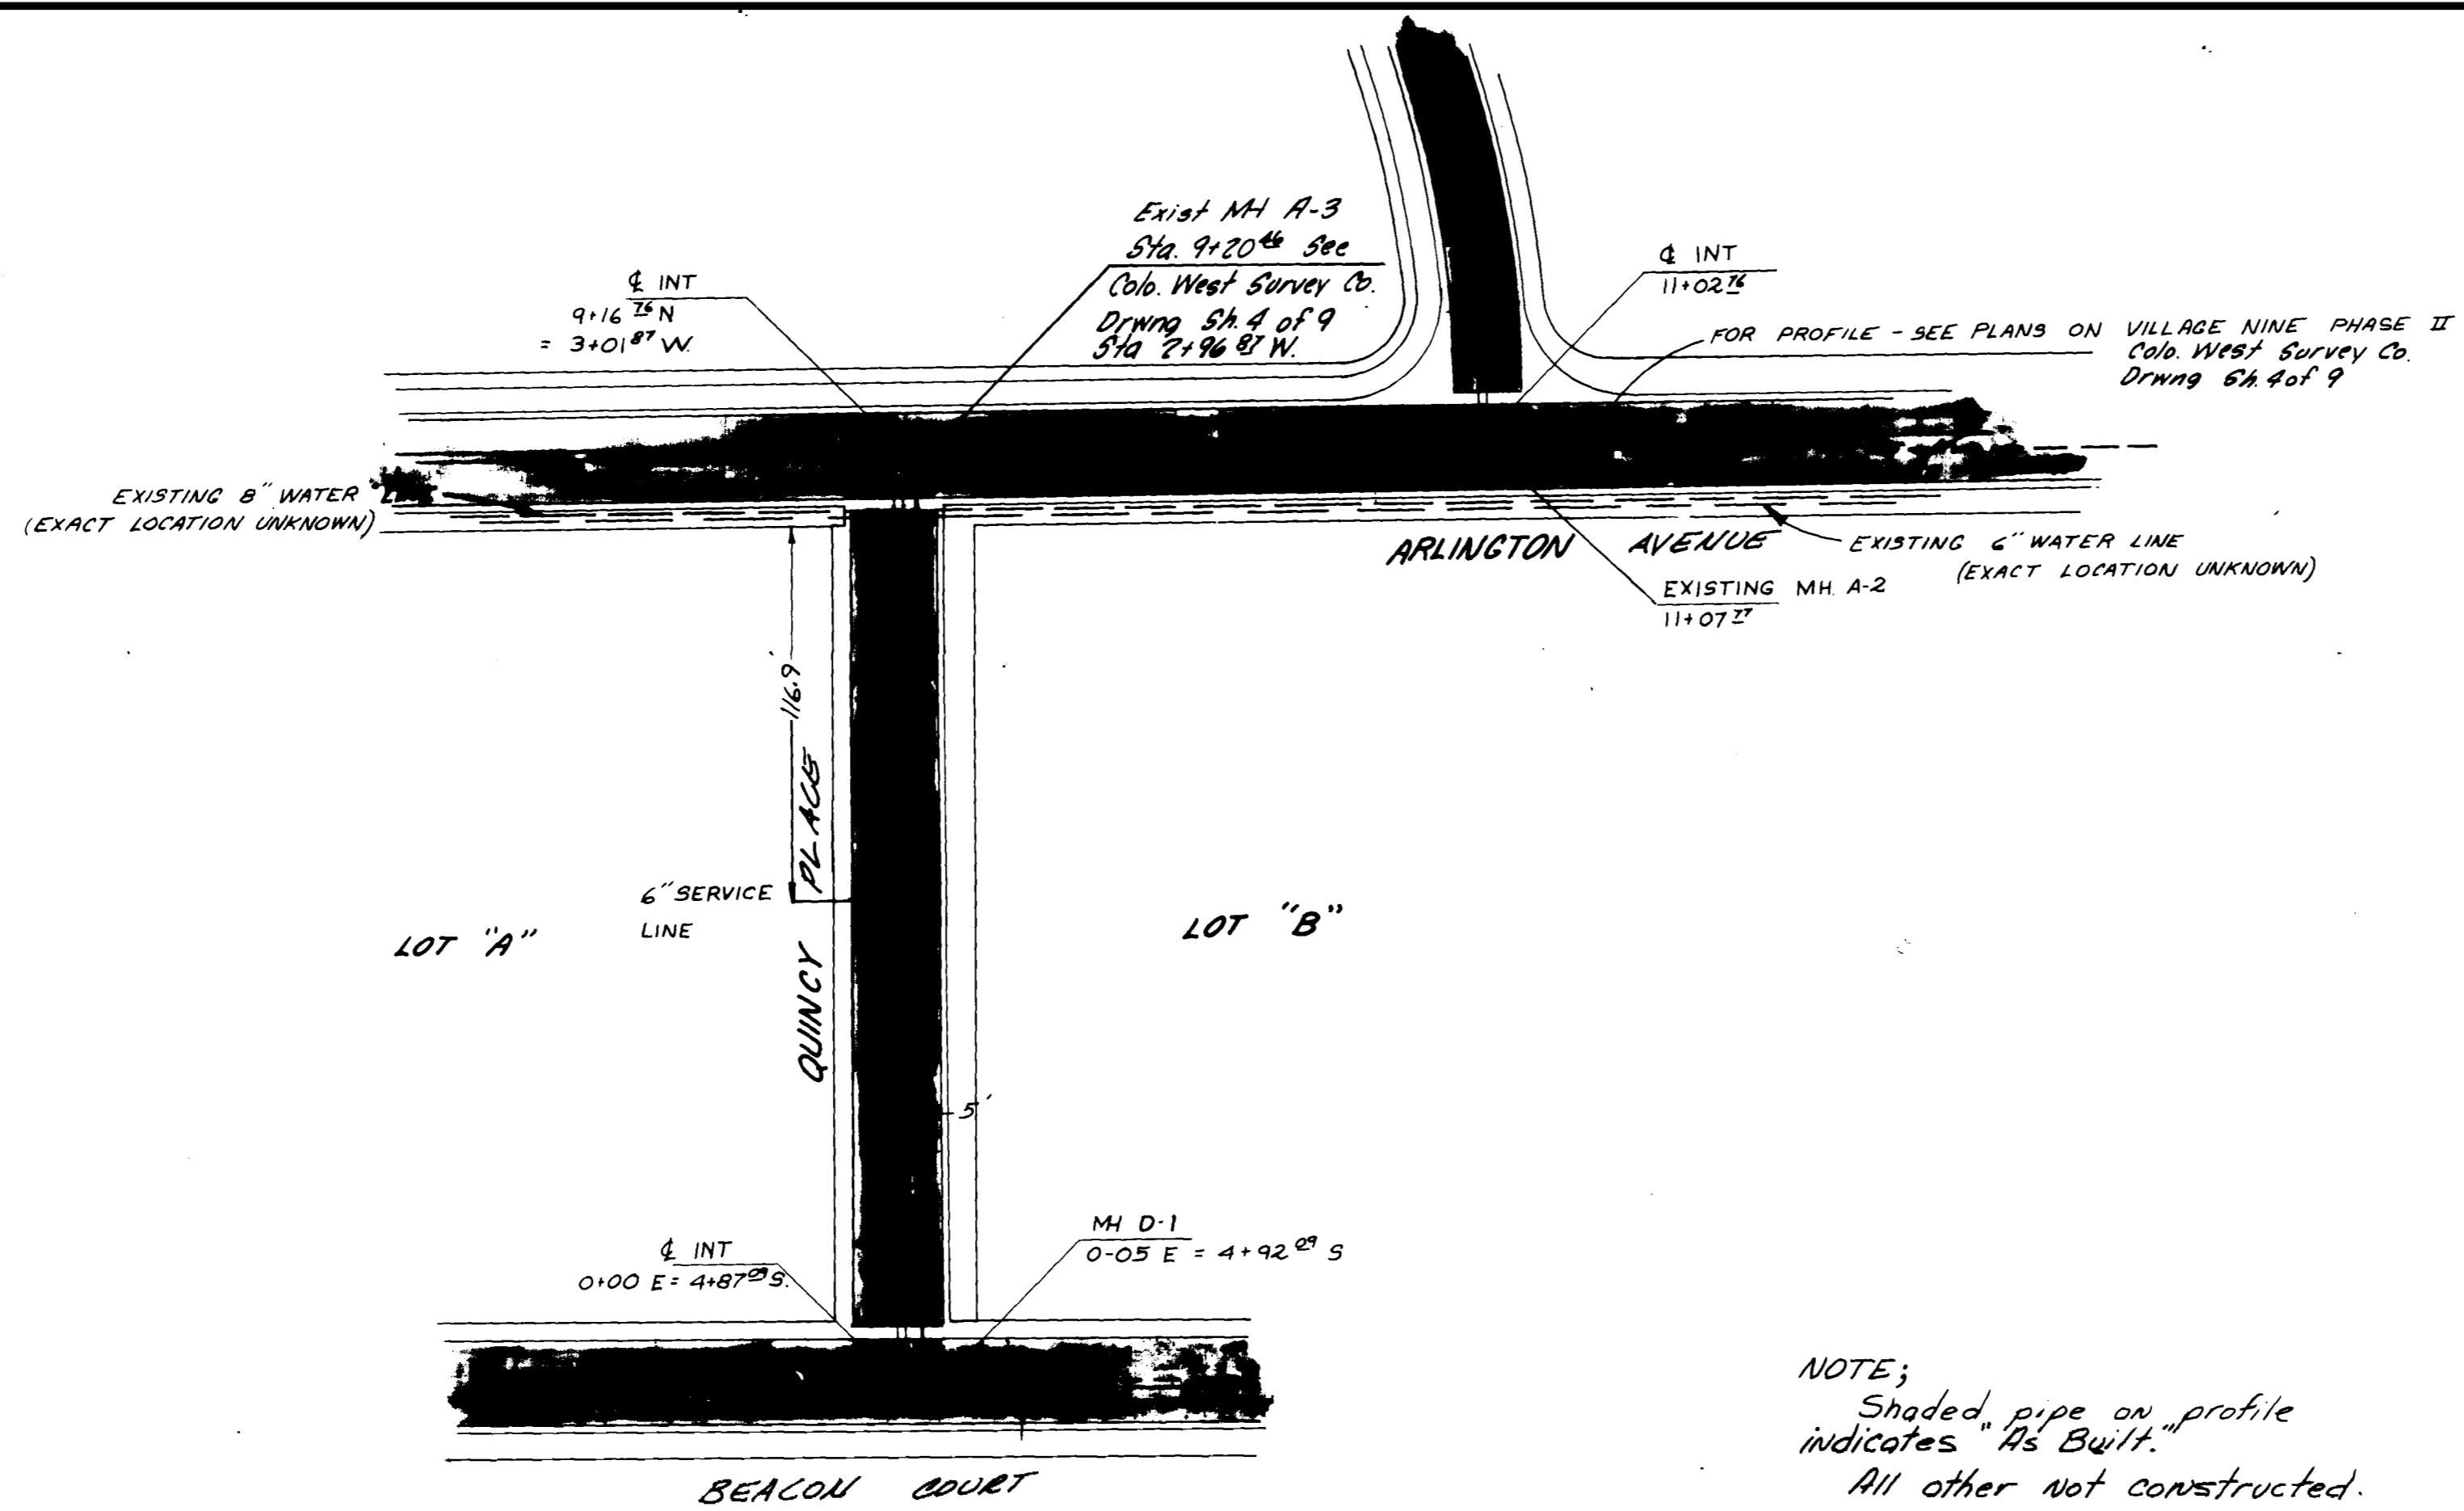

Note: All Services Shall Extend
5 LF Into Each Lot

NOTE;
Shaded pipe on profile
indicates "As Built."
All other not constructed.

SCALE
HORIZ. 1"=50'
VERT. 1"=5'

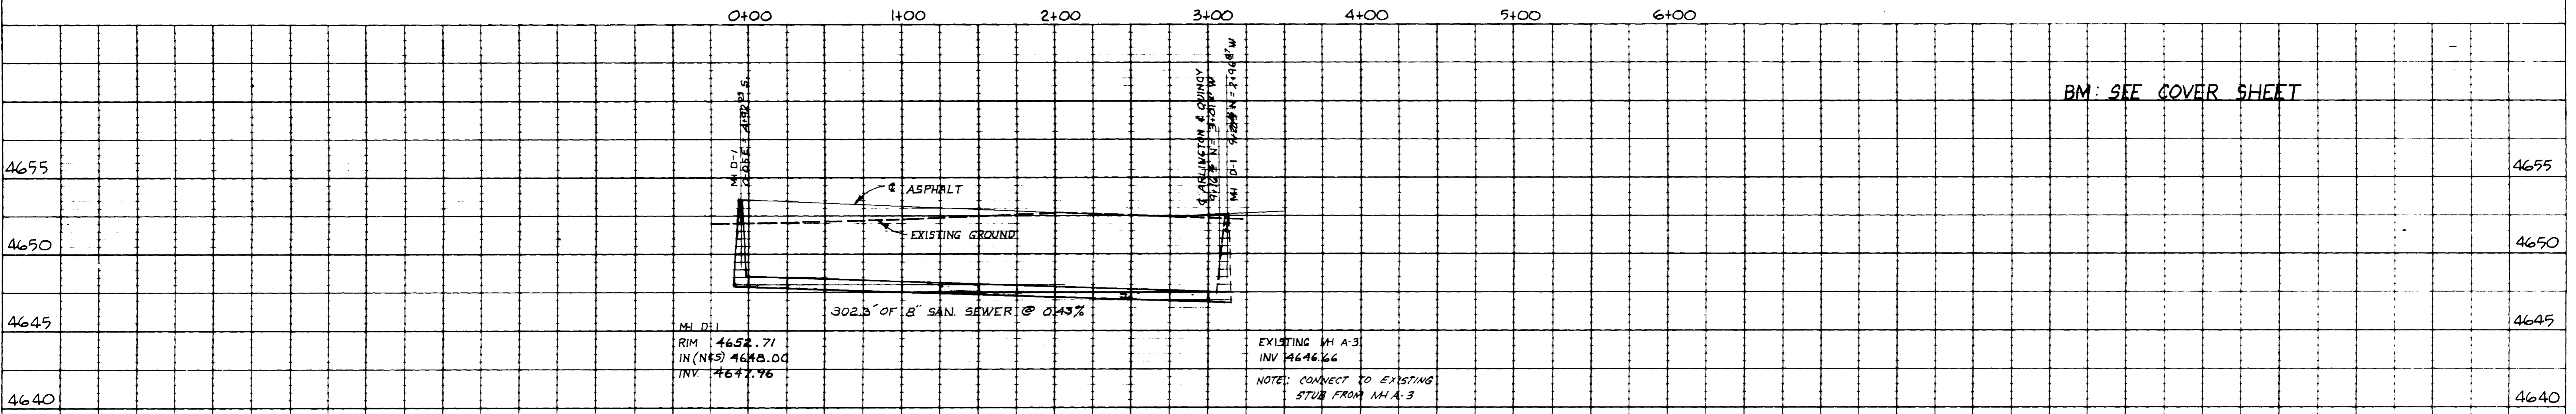

<p>Atkins & Associates CONSULTING ENGINEERS</p> <p>135 COLORADO AVE. LEAF AND JUNCTION, COLORADO 81511 303-343-7125</p>	10-11-78 GRADE CHANGES		P.J.S.
	NO.	DATE	REVISION
<p>VILLAGE NINE 3 SEWER PLAN & PROFILE BEACON COURT</p>			
DATE	9/9/78	OR	SCALE
DES			SHEET
			17 37