
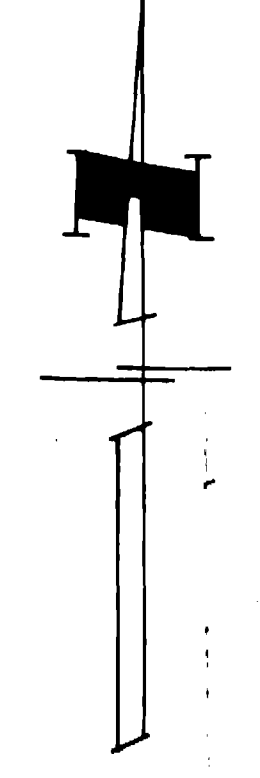


STANDARD MANHOLE

STANDARD SERVICE CONNECTION
No Scale

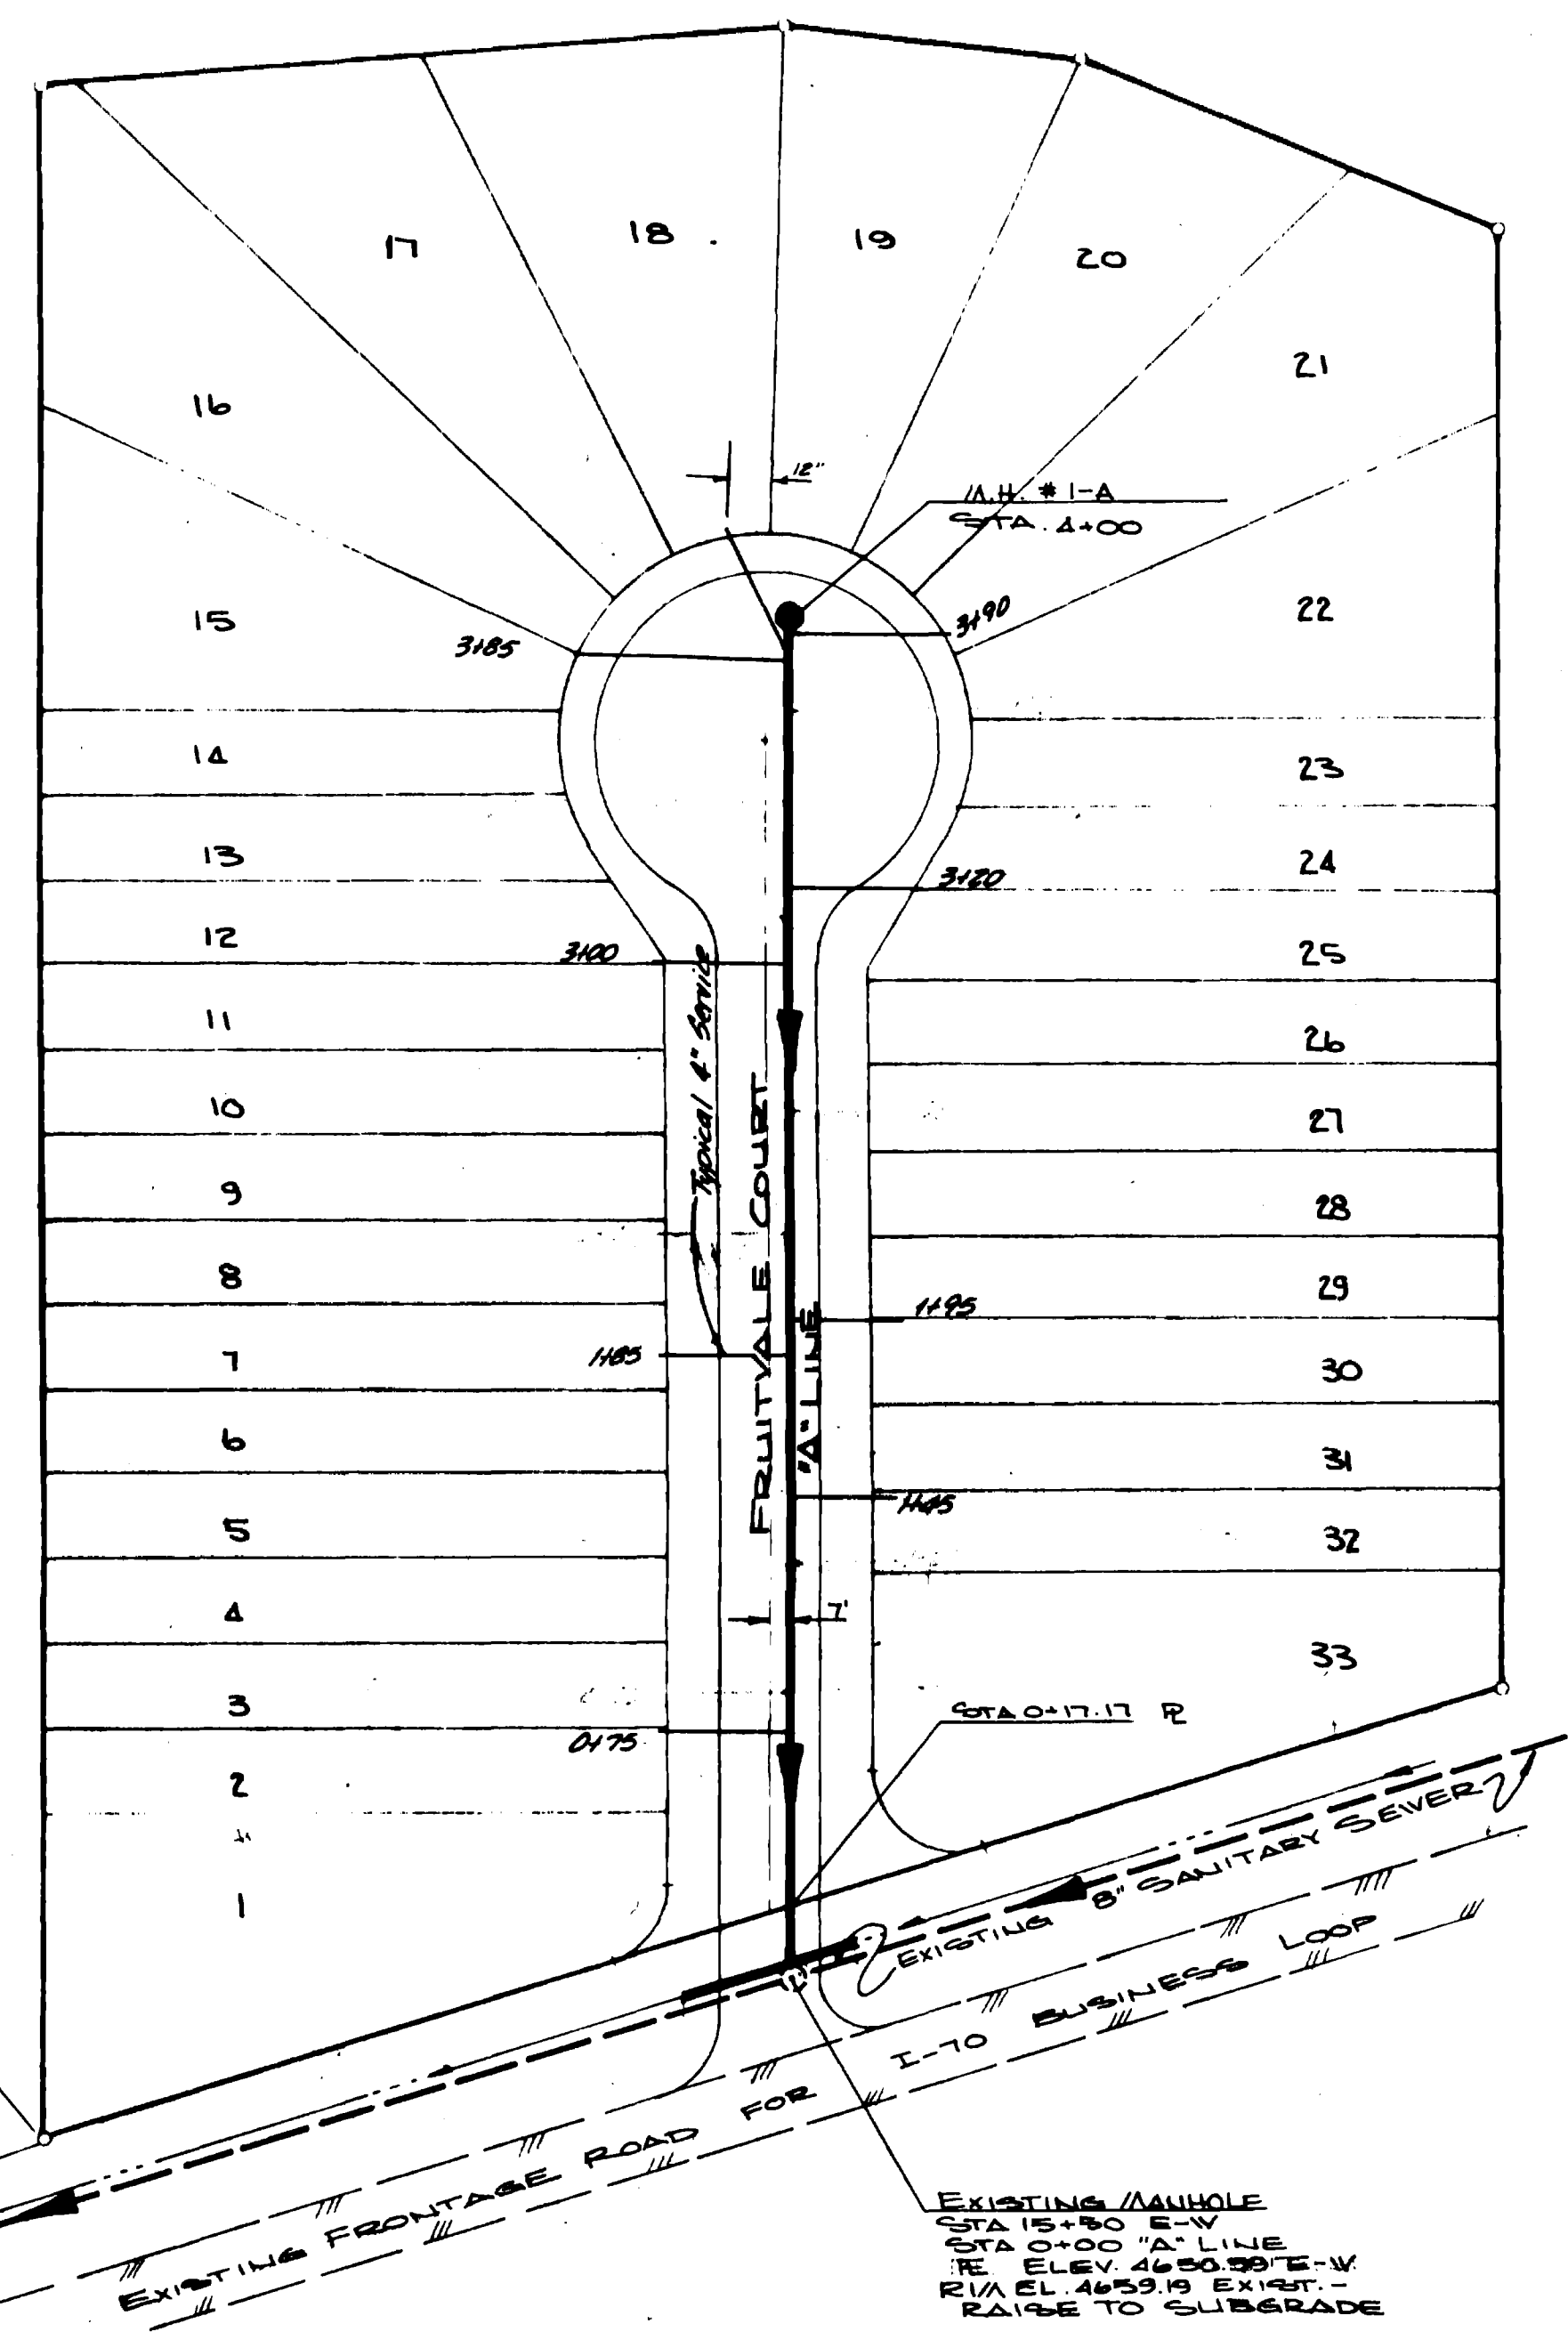

SCALE: 1" = 50'

- QUANTITIES**
- 400 L.F. 8" SANITARY SEWER
 - 1 STANDARD MANHOLE
 - 9 SERVICE CONNECTIONS

EXISTING MANHOLE
STA 15+80 E-W
STA 0+00 'A' LINE
ELEV 4650.99 E-W
EVA EL 4655.19 EXIST.
RAISE TO SUBGRADE

AGGREGATE BED COURSE (ASHTO M 43 STD SIZE NO. 5, 56 OR 57)



AS BUILT DRAWINGS

APPROVED _____ DATE _____
CENTRAL GRAND VALLEY SANITATION DISTRICT