


Scale 1" = 100'

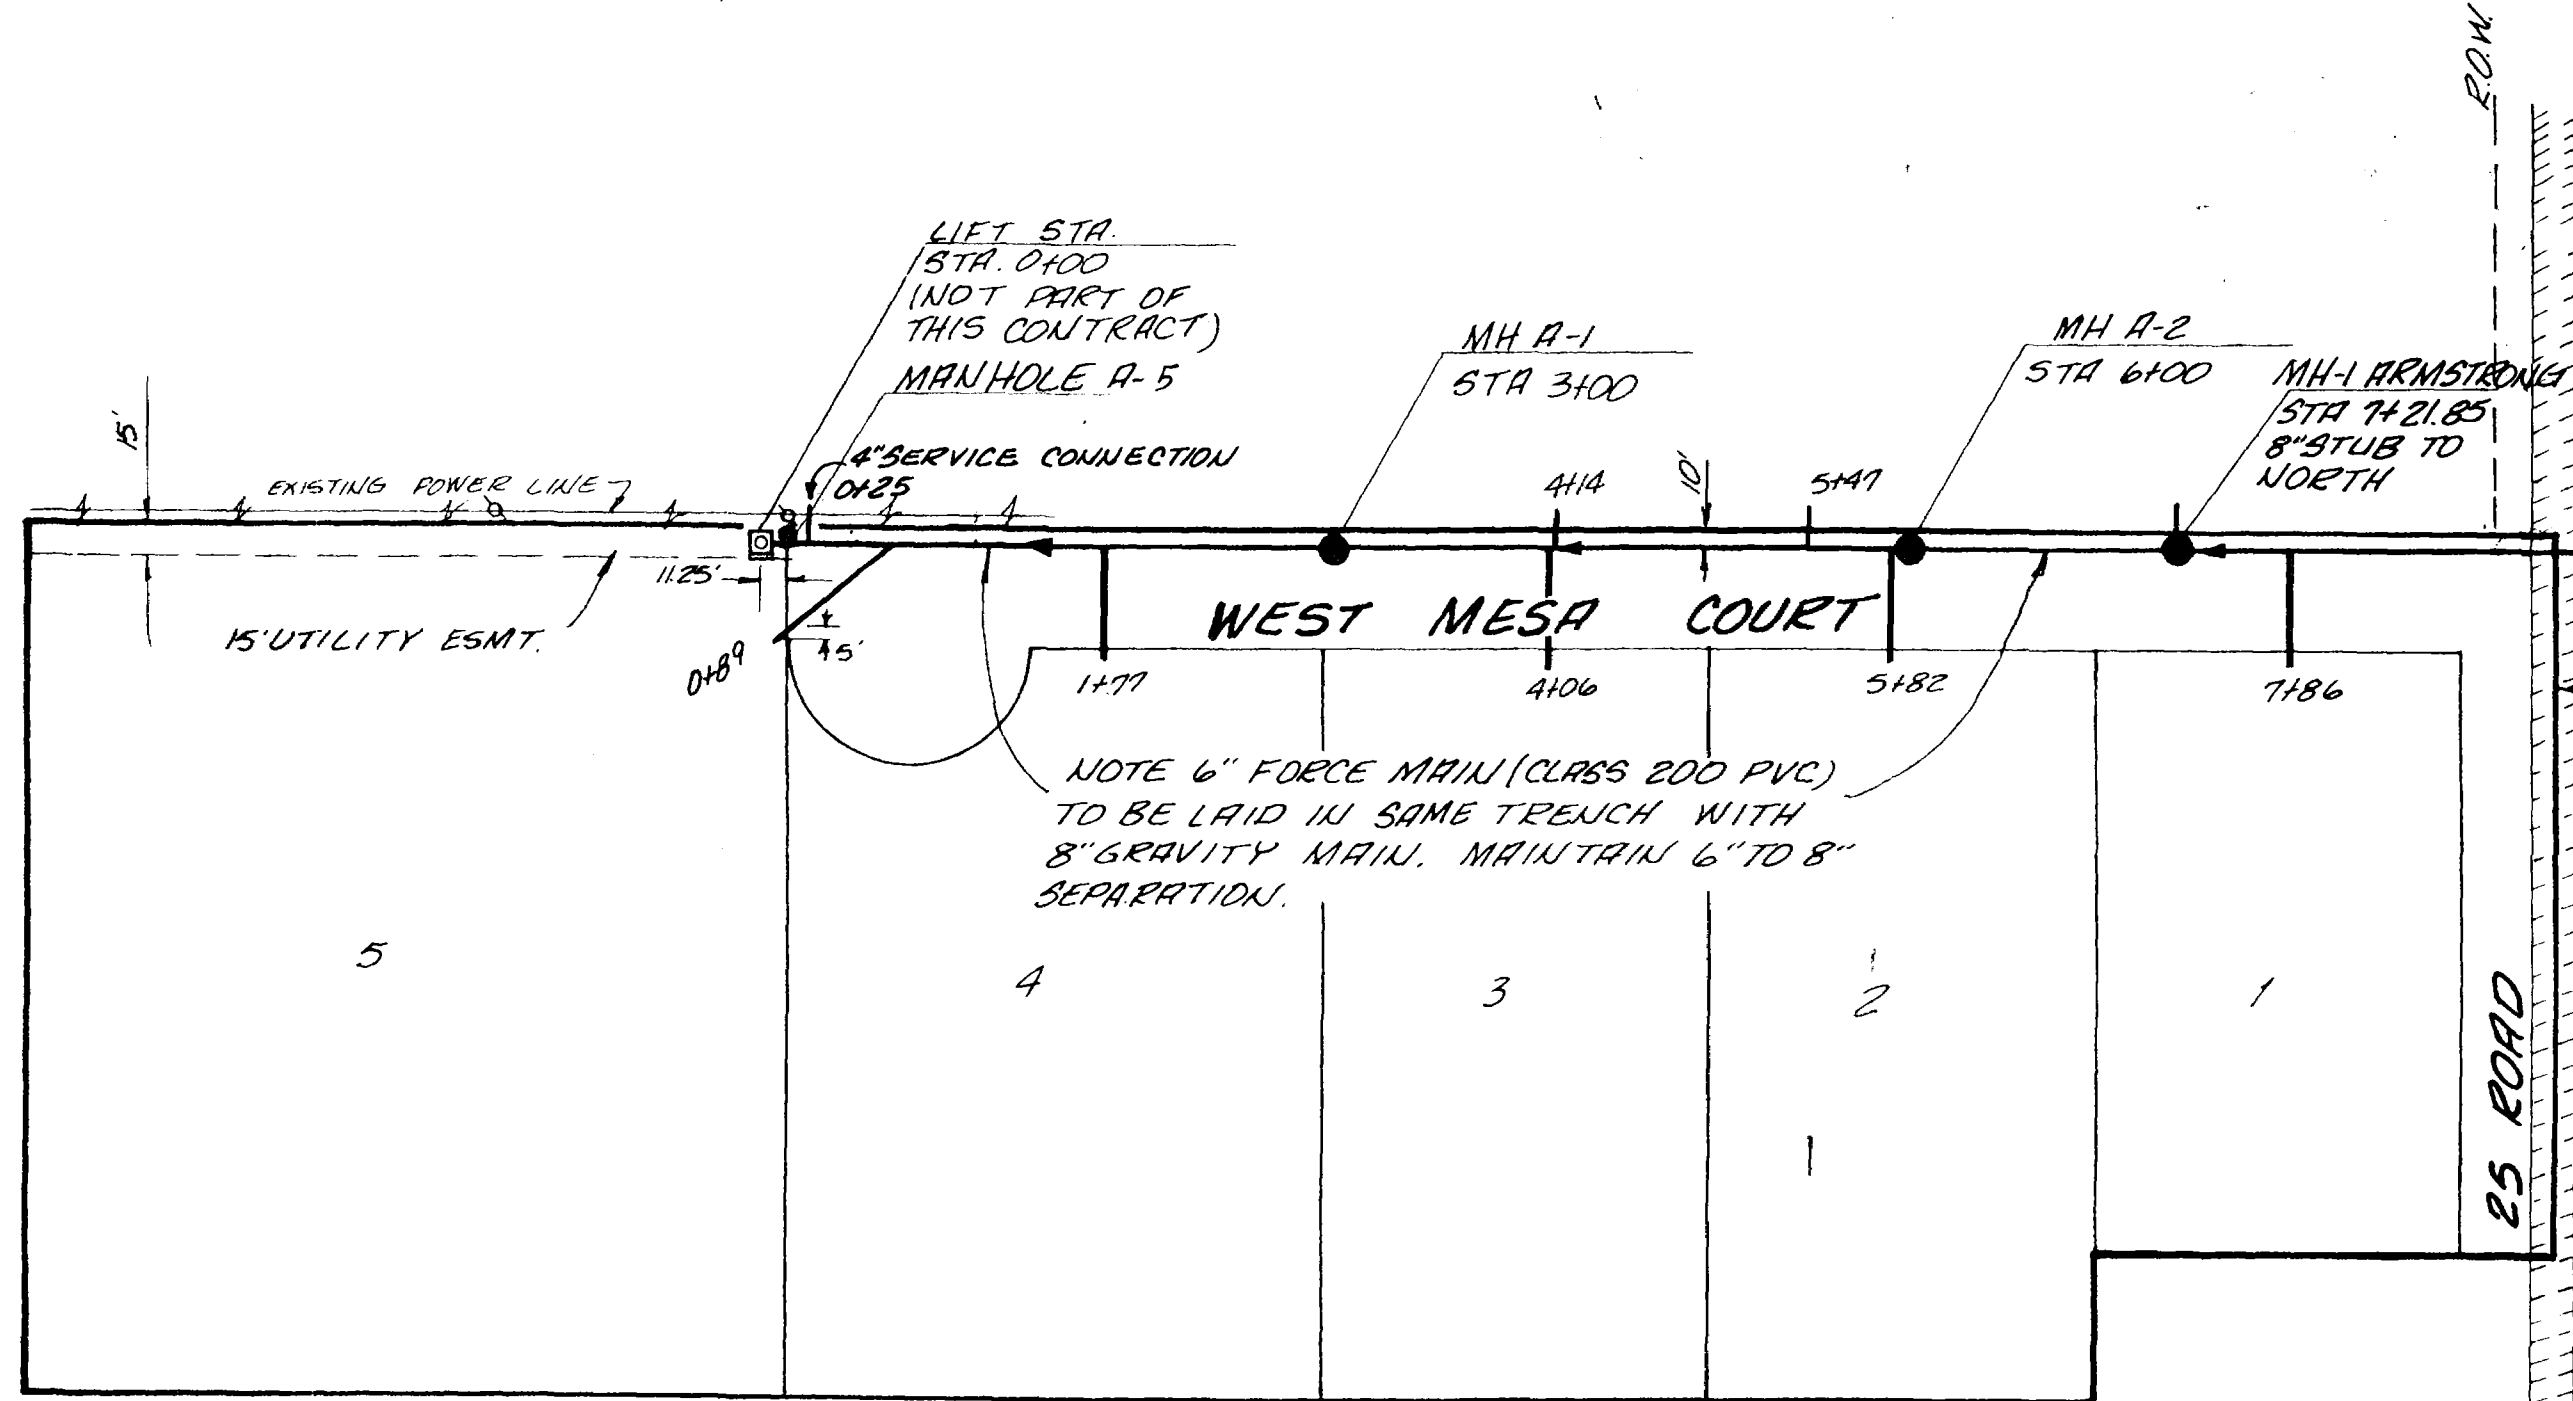

WESLO COMMERCIAL SUBDIVISION

MH A-4 STA 11+30.75  
5'-0" TO 4'-0" FORCE MAIN - MAKE 90° BEND IN MH


MH A-3 STA 9+69.75 FORCE MAIN - MAKE 90° BEND IN MH.

MH A-2 STA 6+00

MH A-1 STA 3+00





MH A-5 (LIFT STA 5+14.00) (NOT PART OF THIS CONTRACT)

GRAVITY & FORCE MAINS BY OTHERS

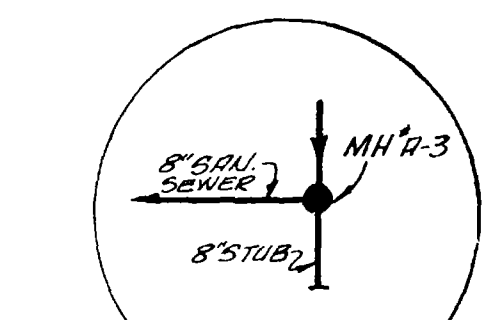


NOTE: 6" FORCE MAIN (CLASS 200 PVC) TO BE LAID IN SAME TRENCH WITH 8" GRAVITY MAIN. MAINTAIN 6"-8" SEPARATION.

- QUANTITIES
- 1130.75 LF 8" SANITARY SEWER
  - 1130.75 LF 6" FORCE MAIN
  - 5 STANDARD MANHOLES
  - 5 SERVICE CONNECTION LATERALS
  - 1 MODEL NO. 400 APCO VALVE, SEWAGE AIR RELEASE VALVE OR APPROVED EQUAL.

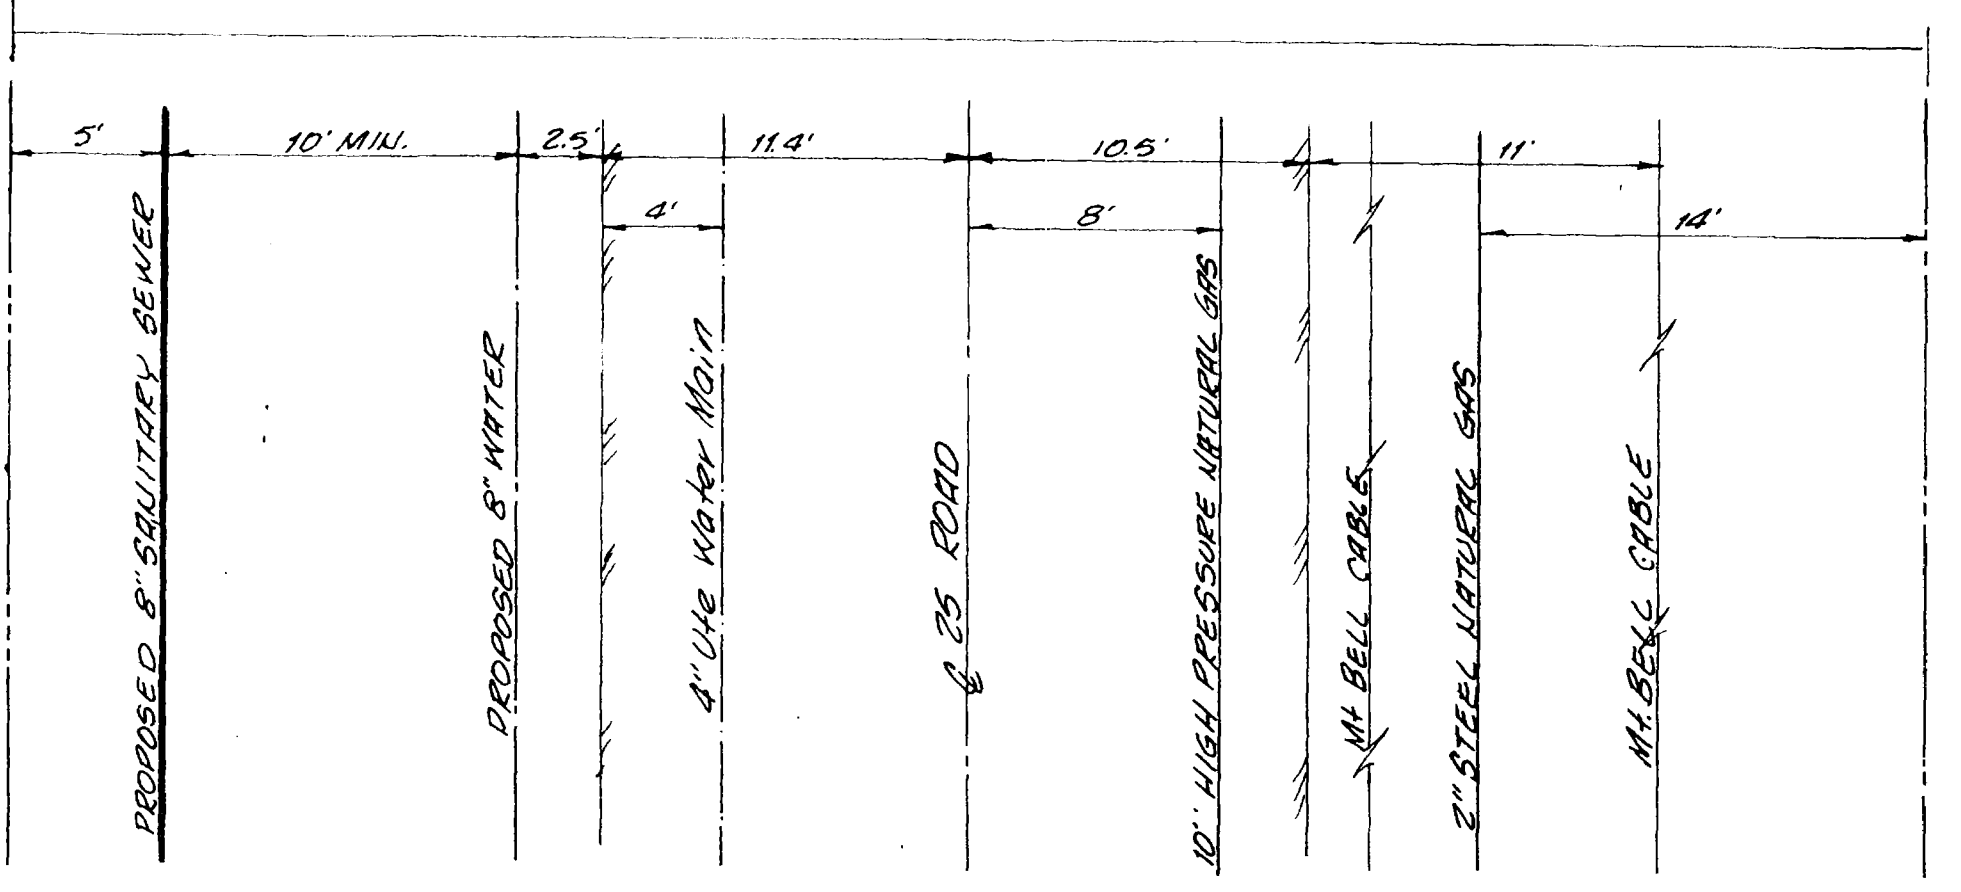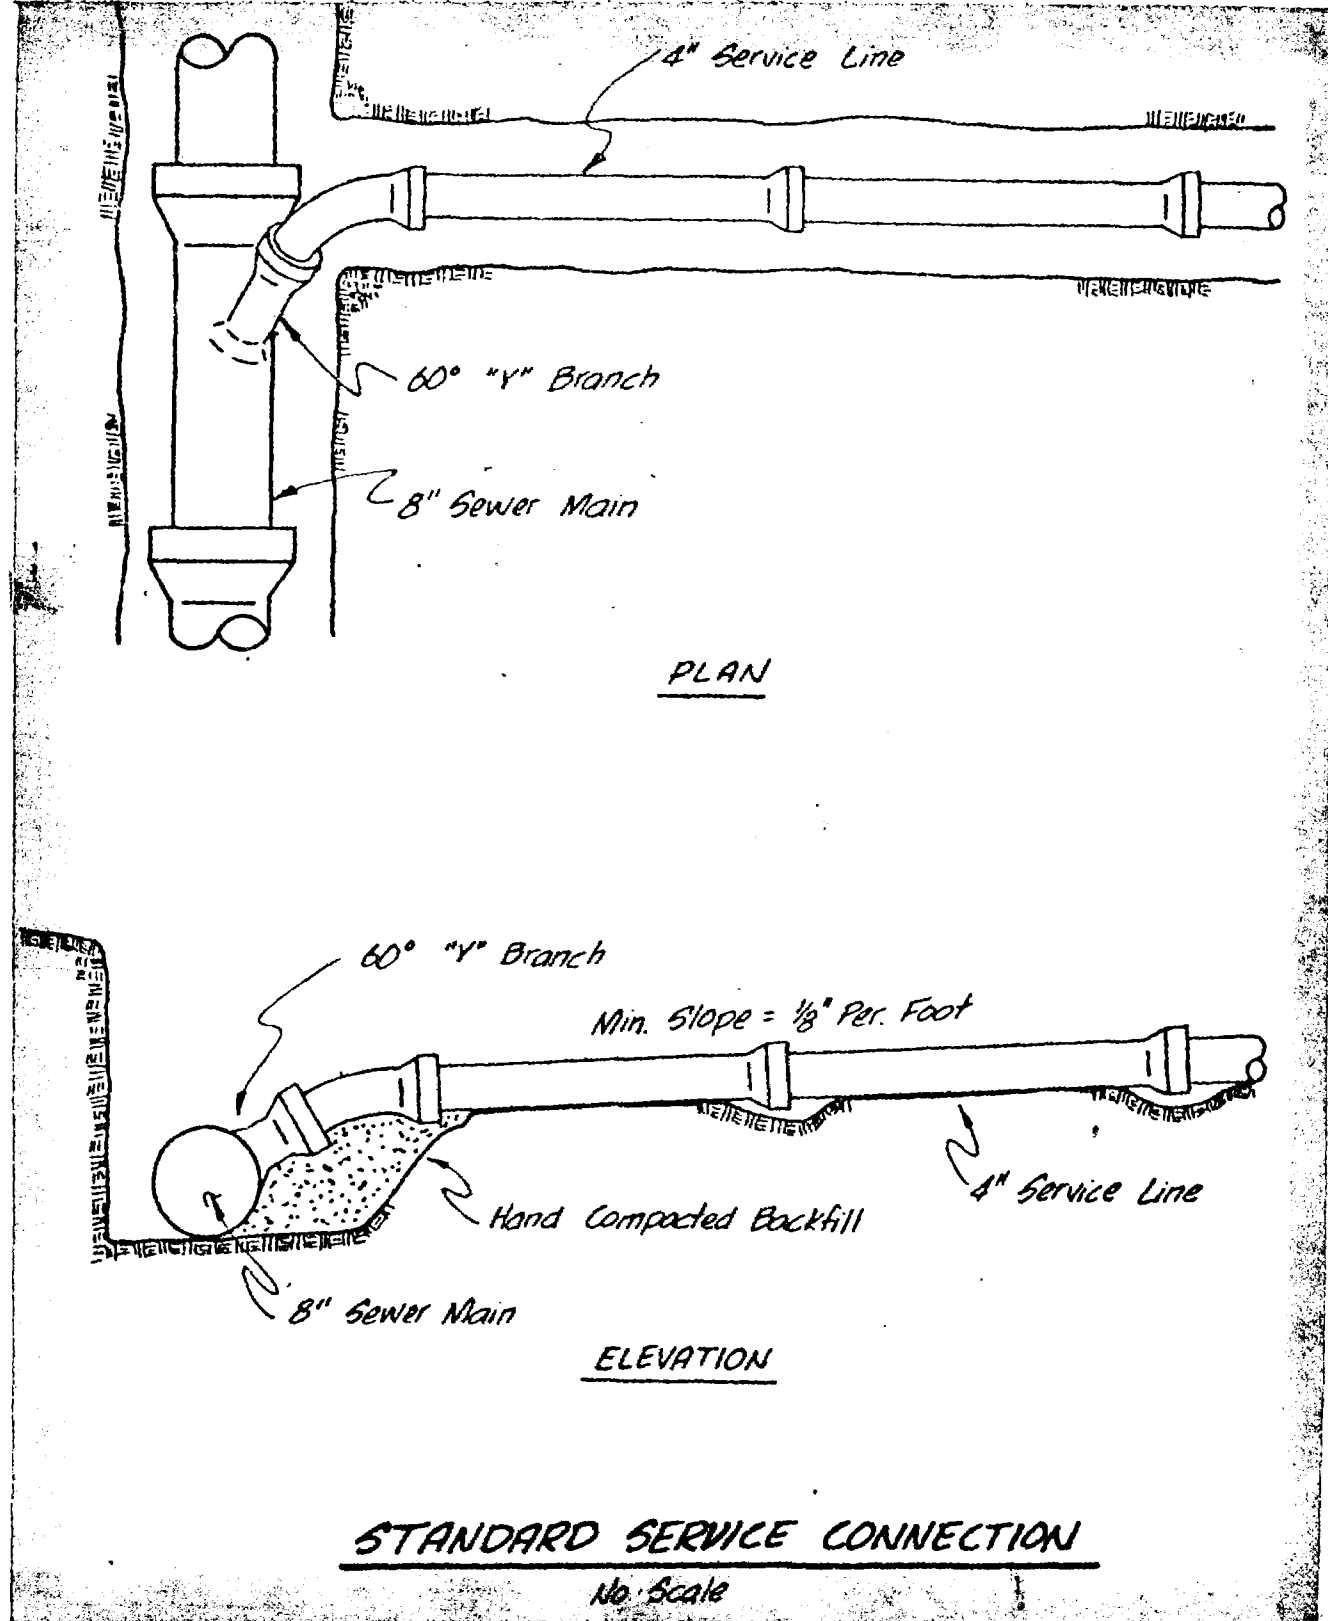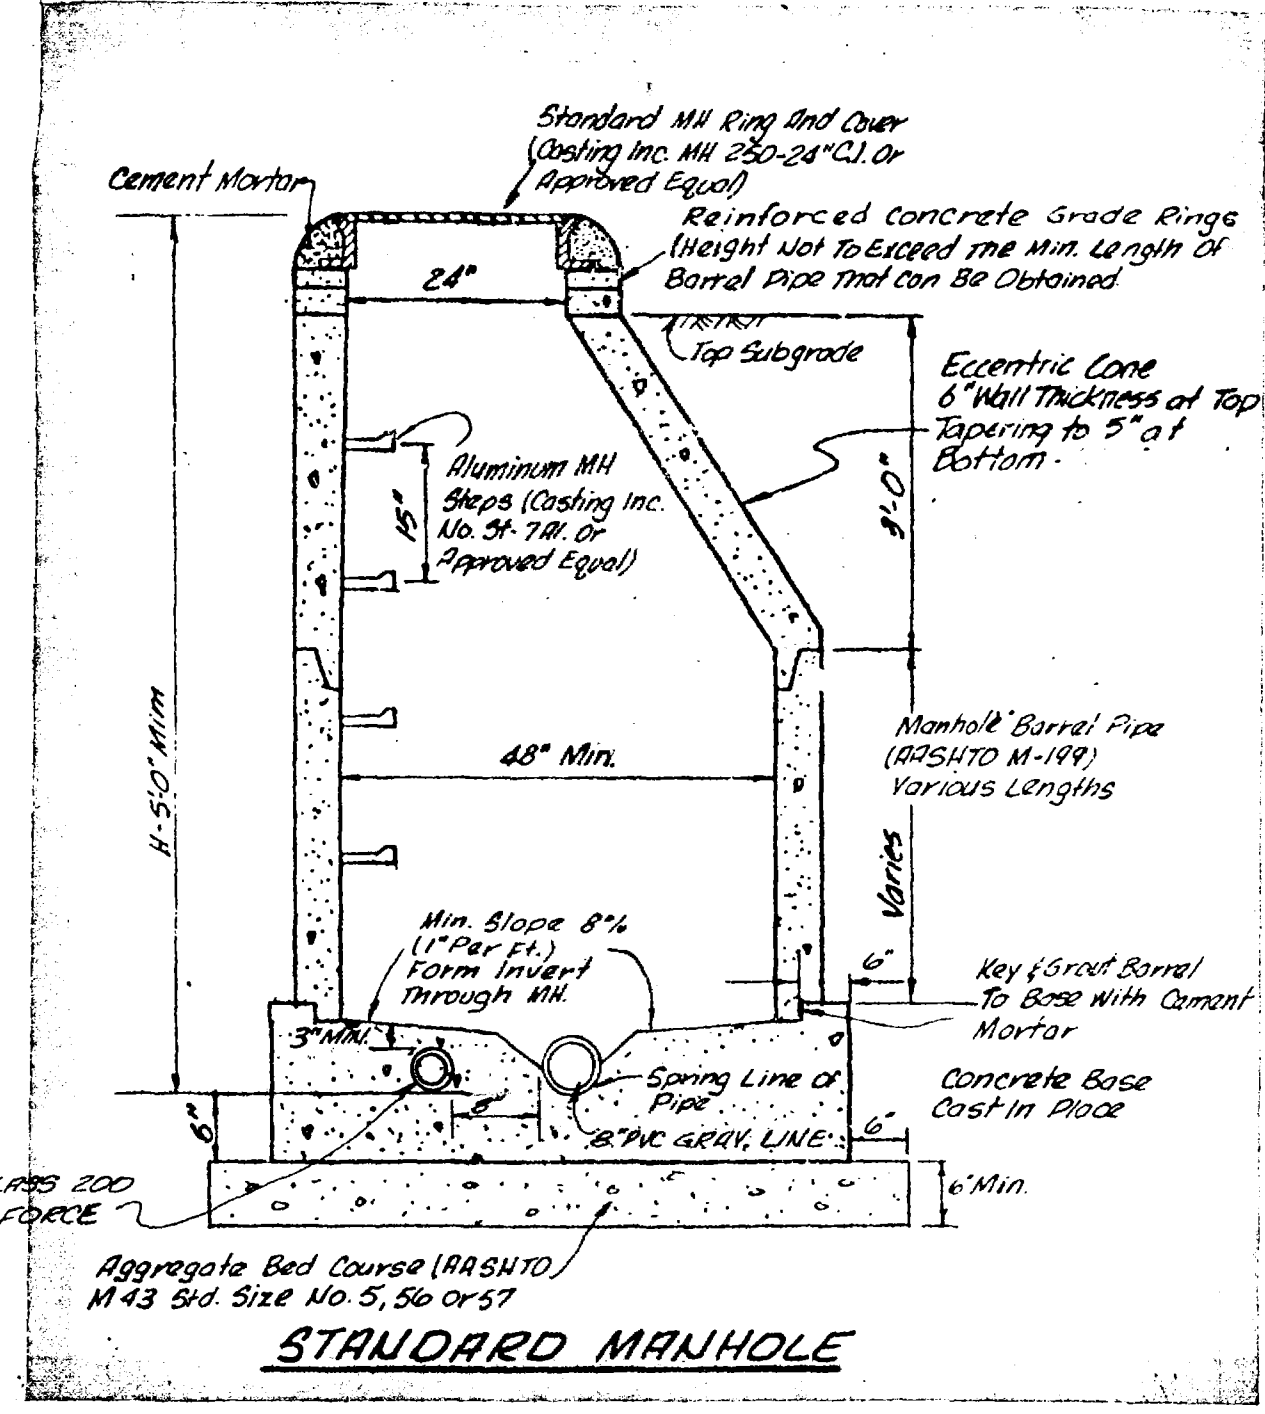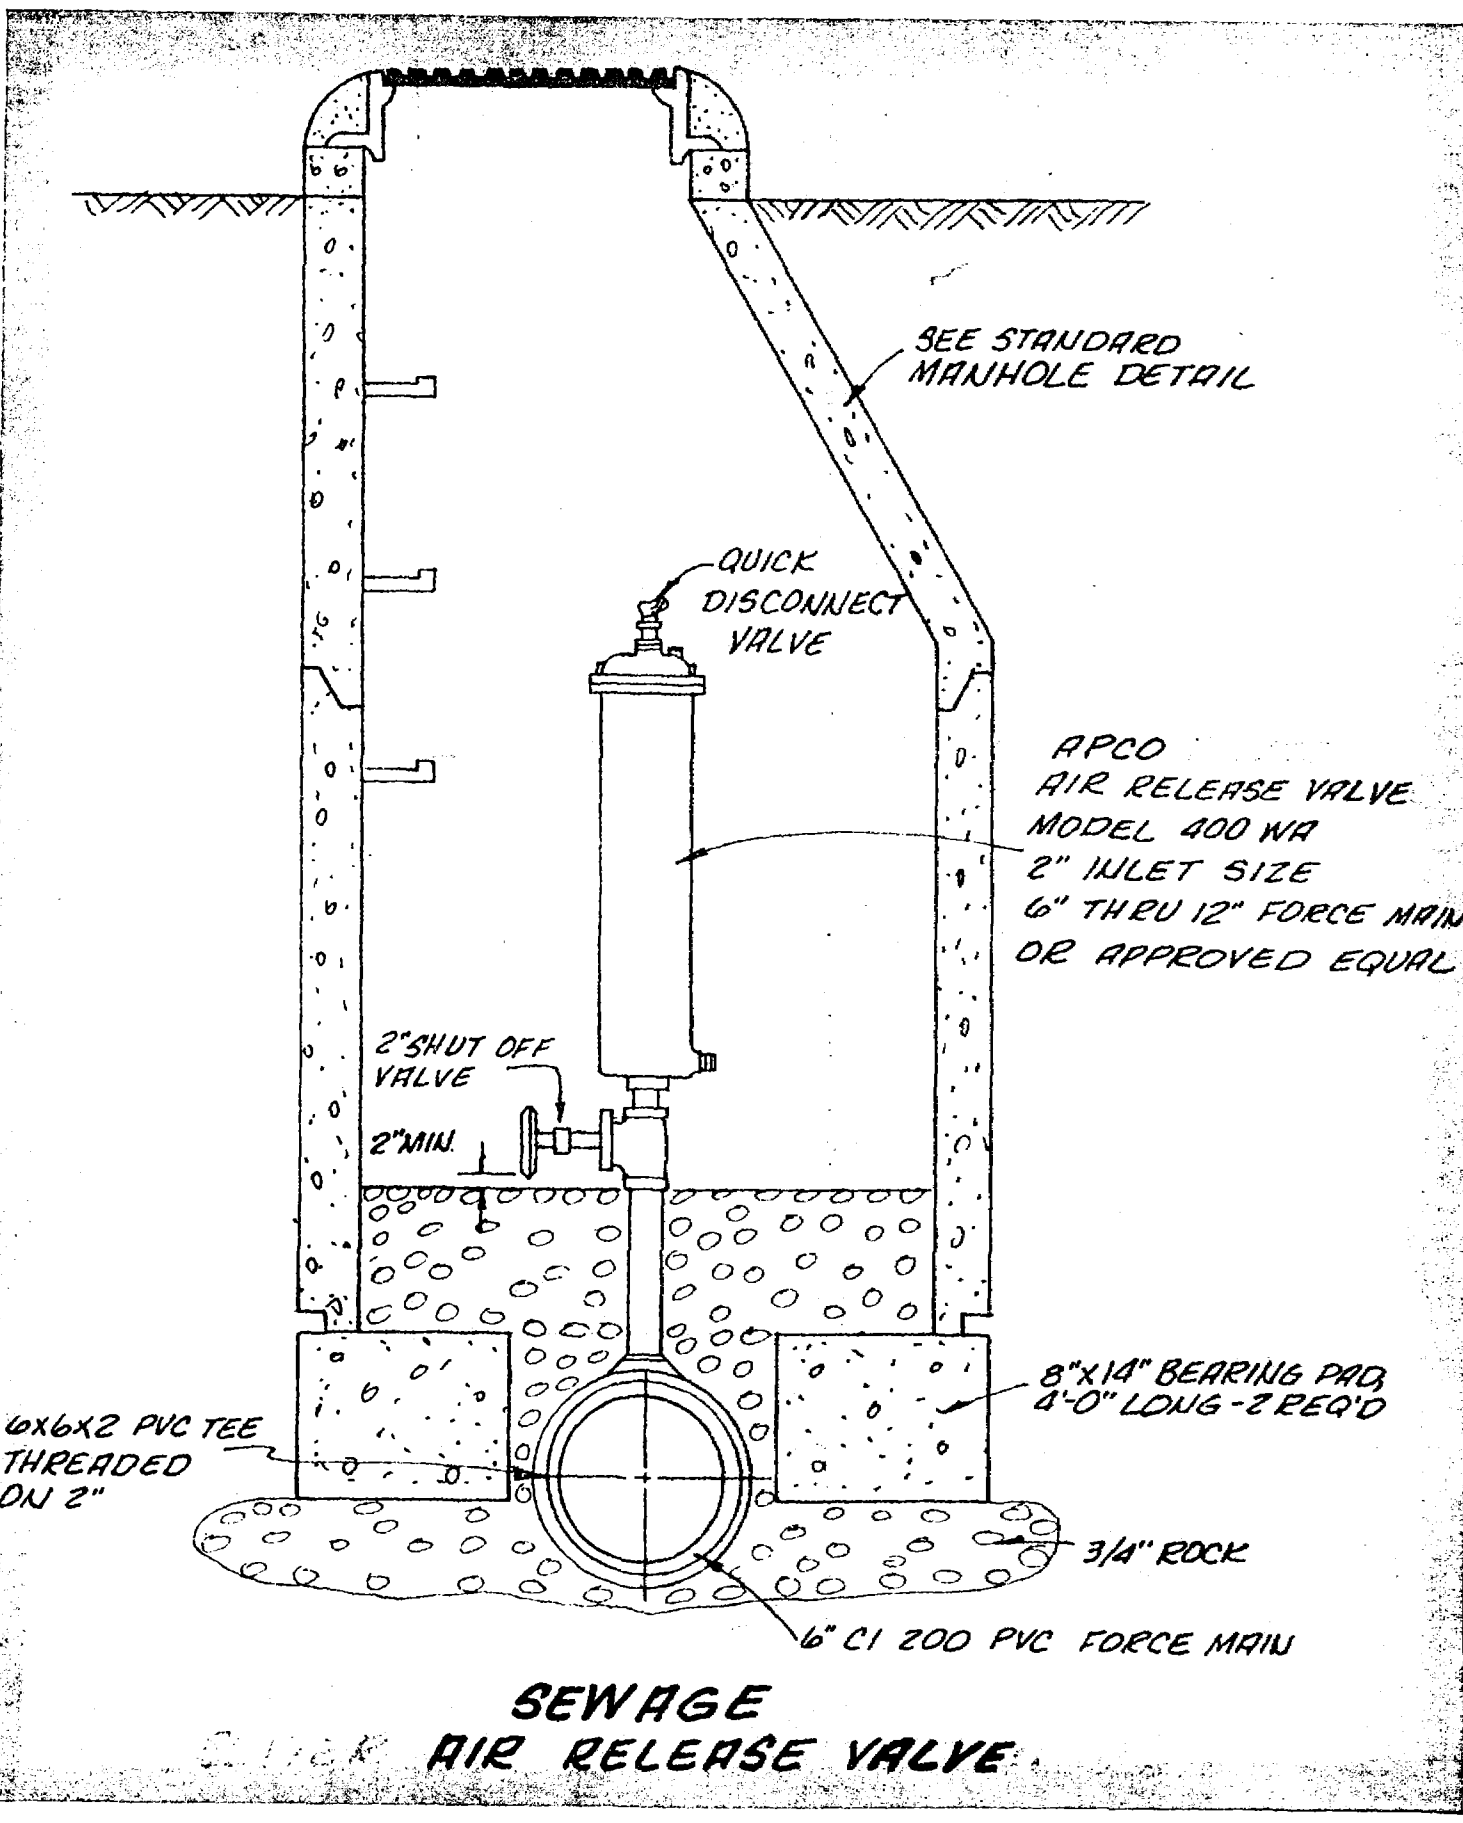

NOTE: This is to certify that the system infiltration does not exceed 200 gallons per inch diameter per mile of length per day.

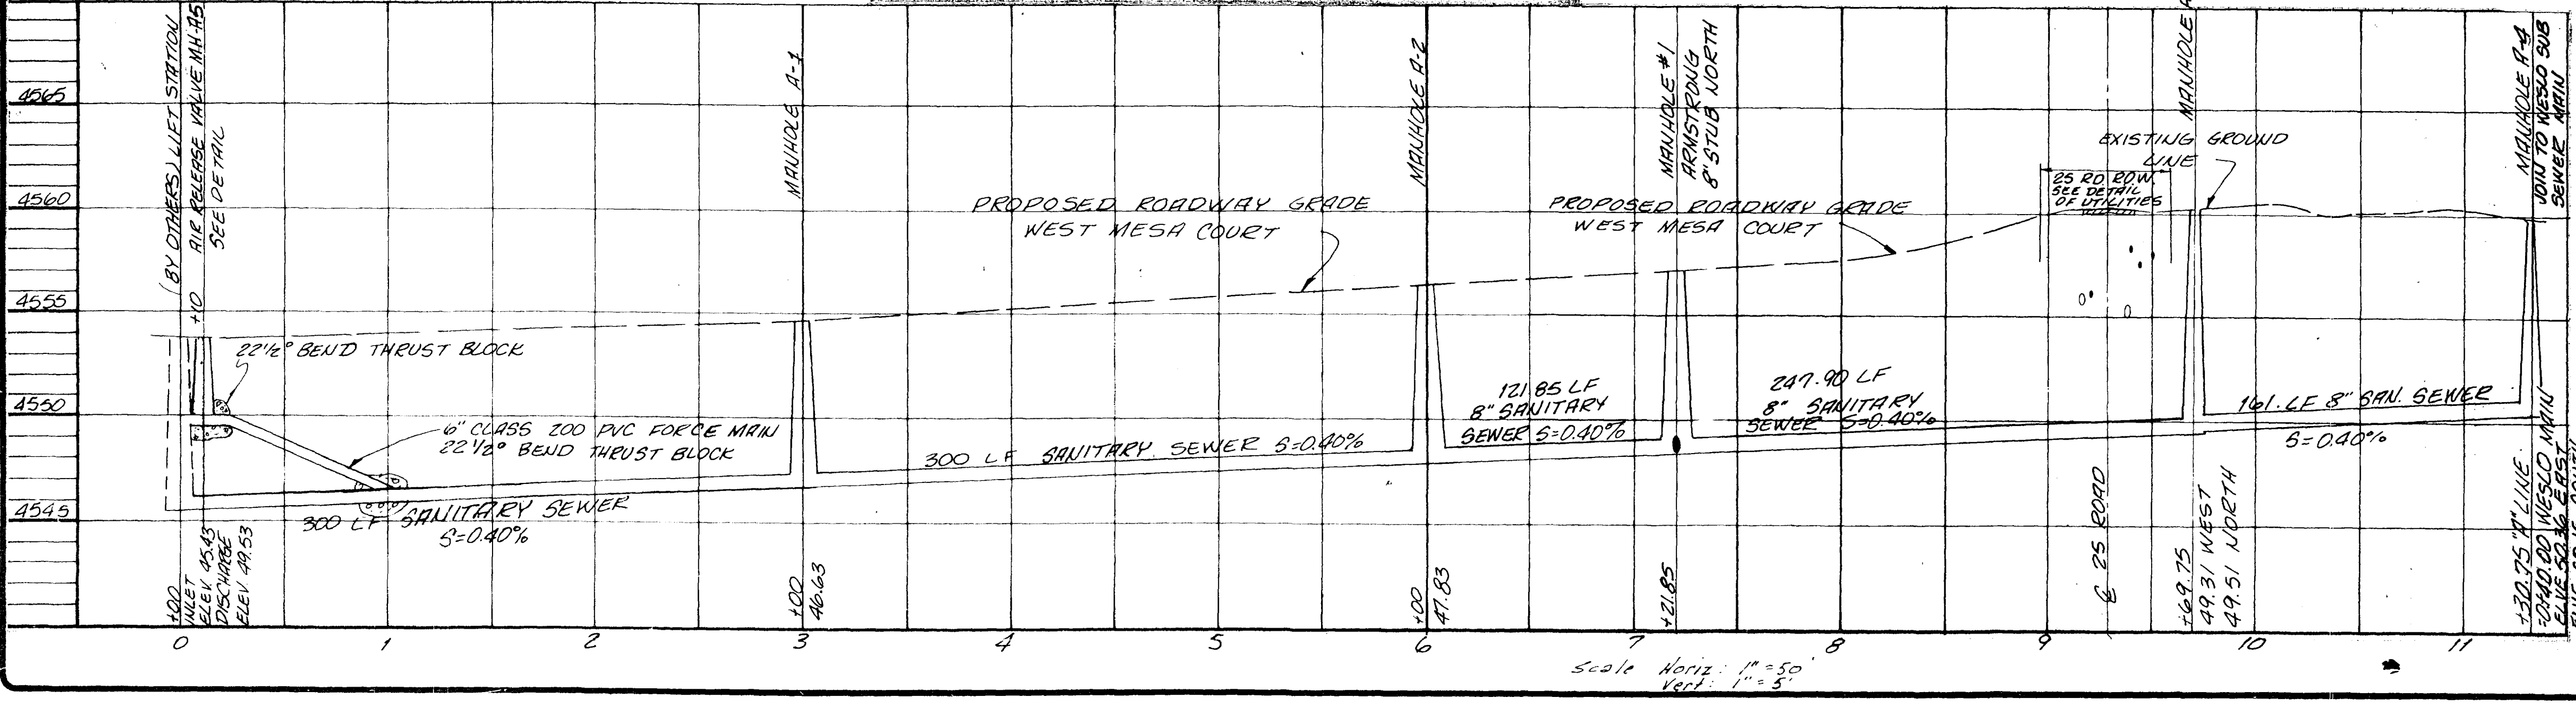


TOP OF VERT. BEND

TABLE OF VOLUMES OF CONCRETE (IN CU. FT.)

SIZE	BEND		
	45°	22 1/2°	11 1/4°
6"	2.92	15.0	7.4

AS BUILT DRAWINGS

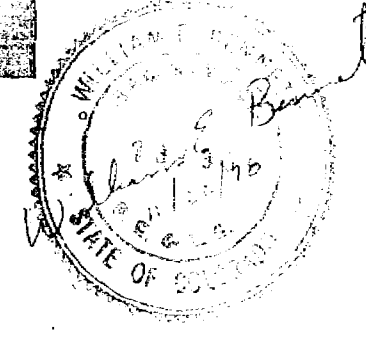

APPROVED \_\_\_\_\_ DATE \_\_\_\_\_

CHECKED

Wayne H. Lill

DATE

FEB 13, 1979




SCALE

As Shown

REVISIONS

NO.	BY	DATE
1	PL	FEB 13, 1979
2	PL	FEB 13, 1979
3	PL	FEB 13, 1979

AS BUILT AUG 15, 1979

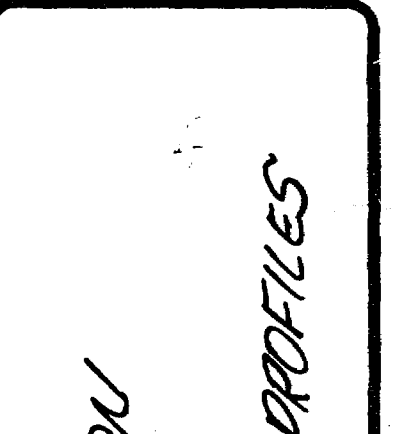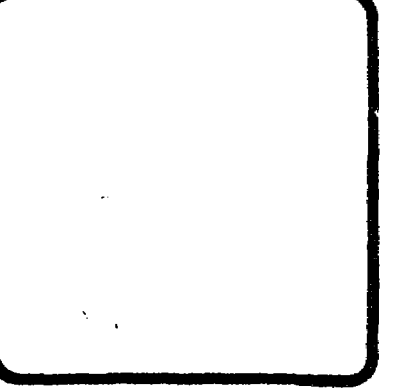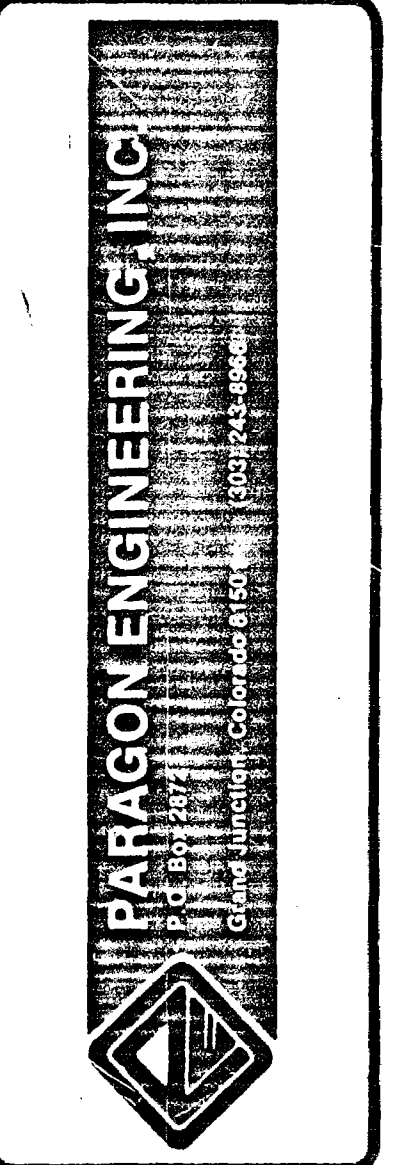

25 ROAD SUBDIVISION  
MESA COUNTY, COLO.  
SANITARY SEWER PLAN & PROFILES

SHEET

1

OF 1 SHEETS