

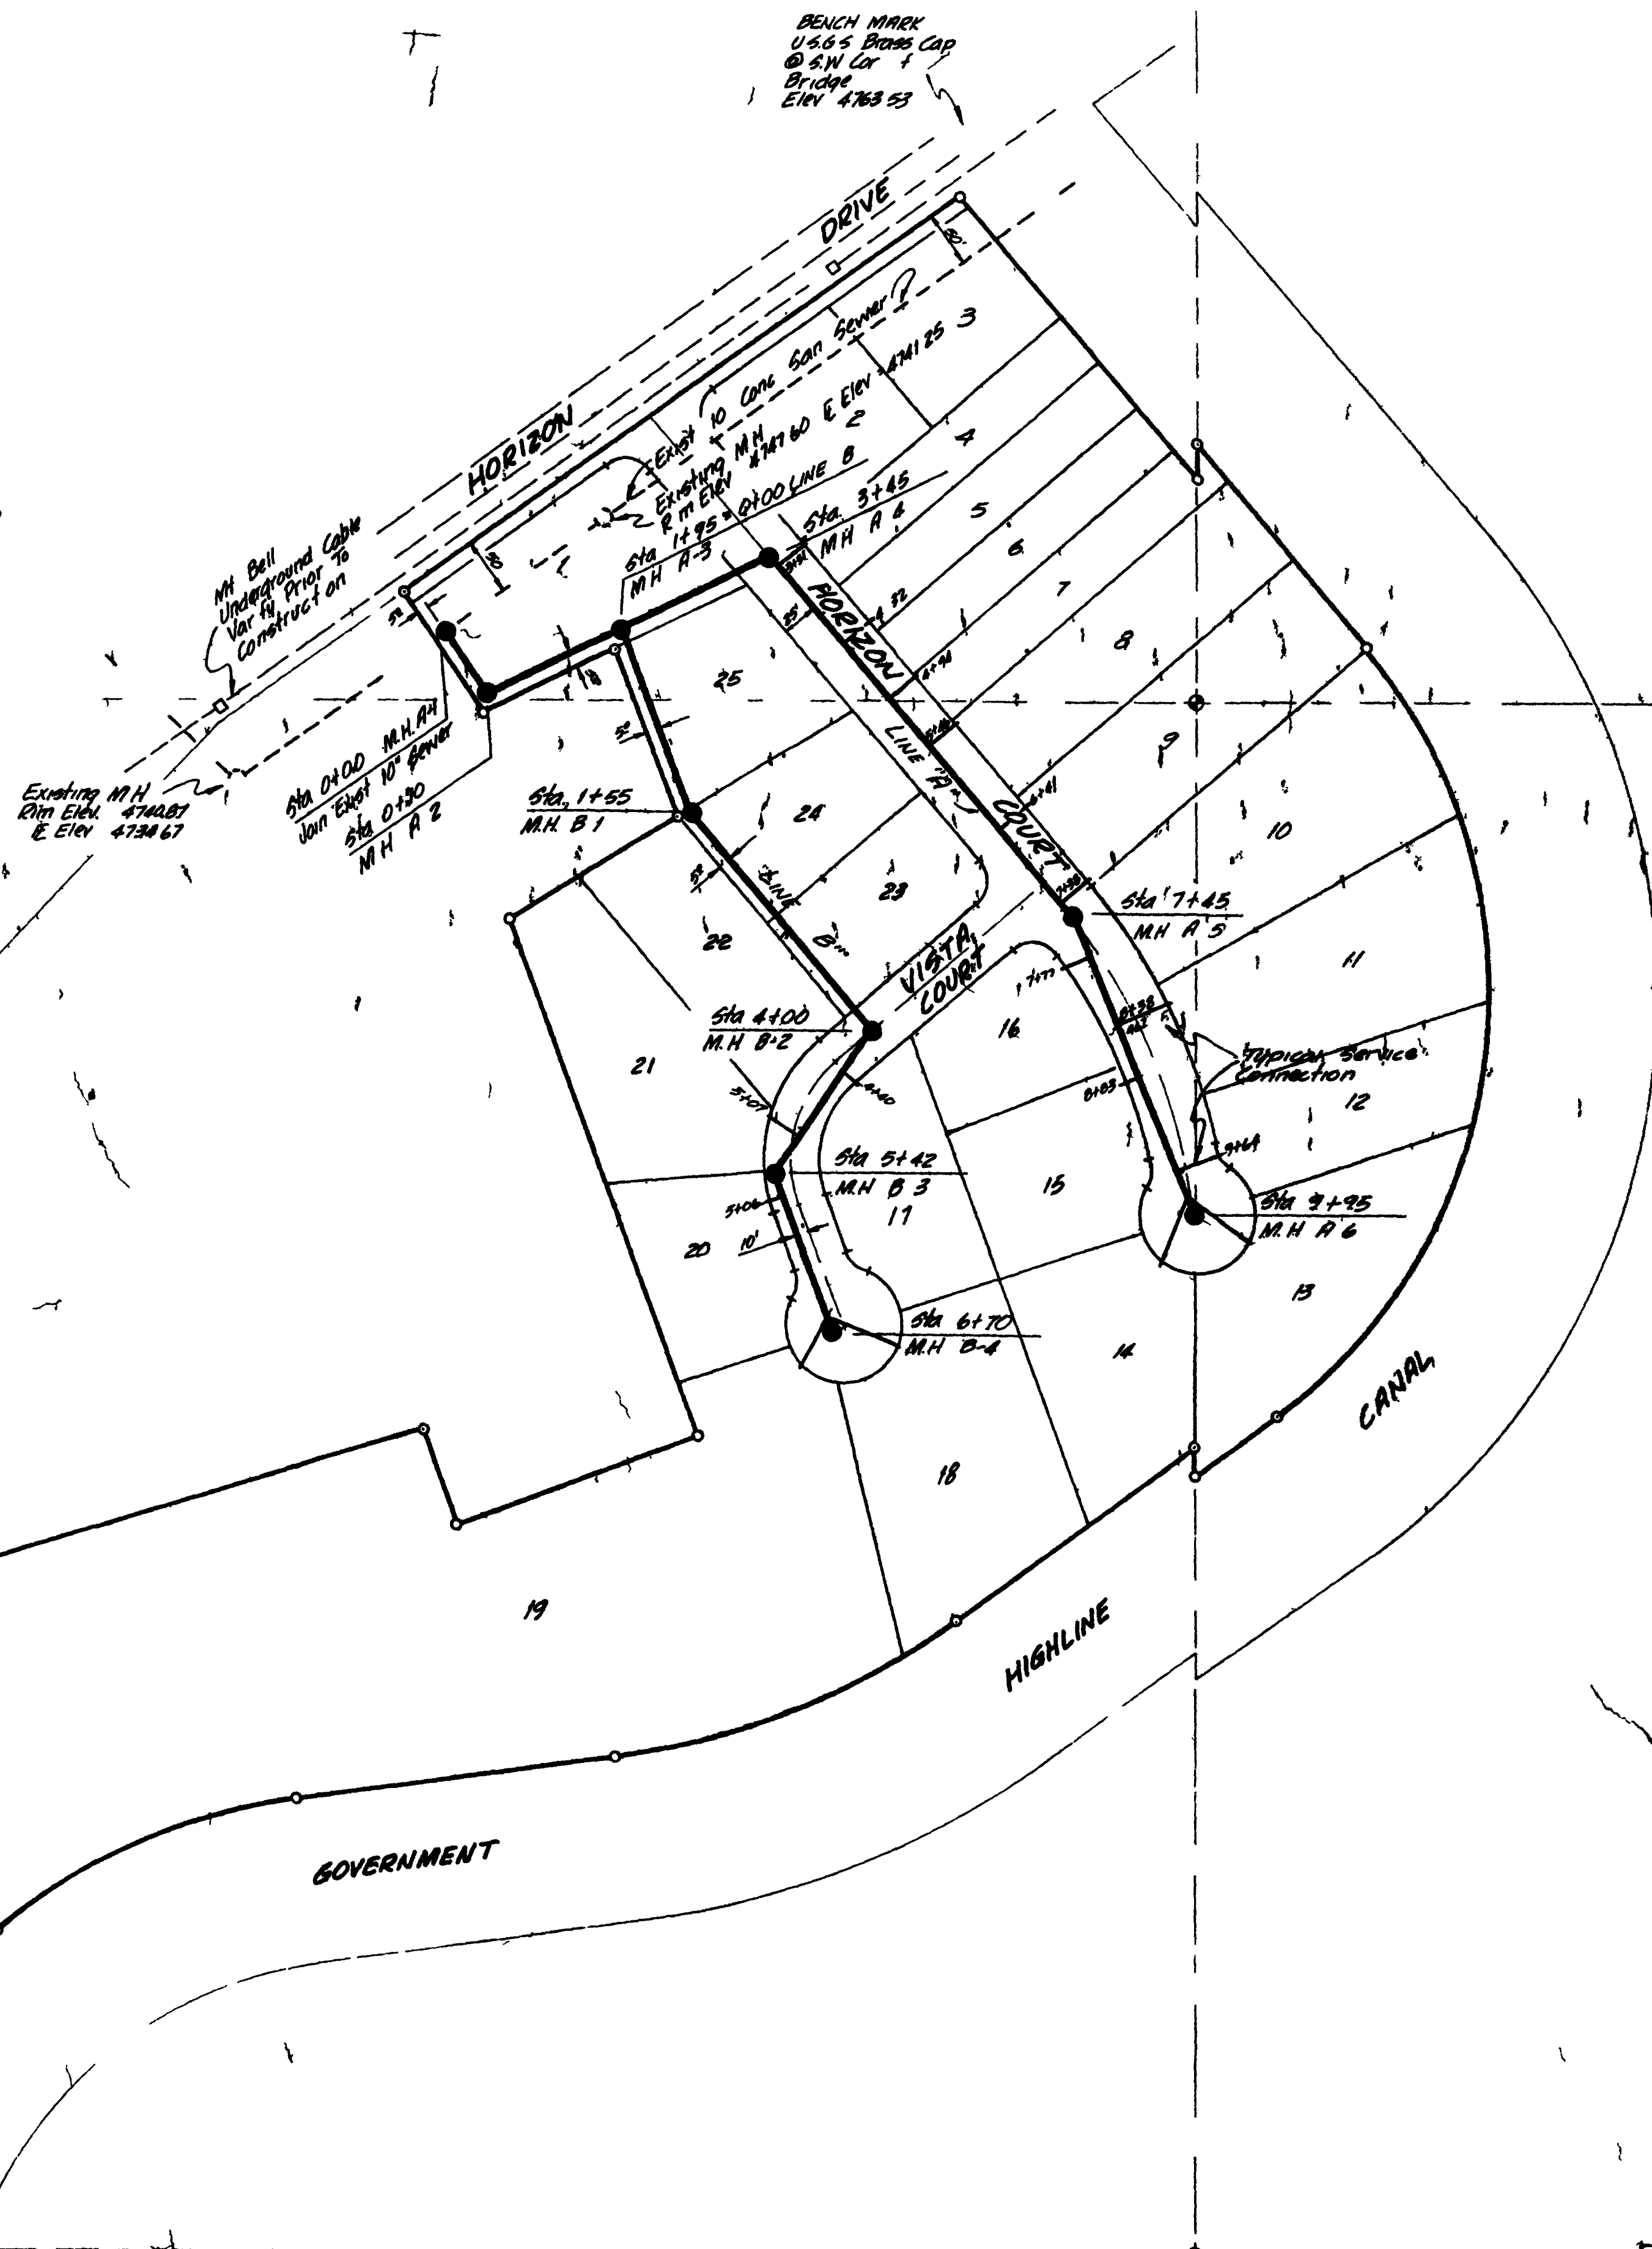
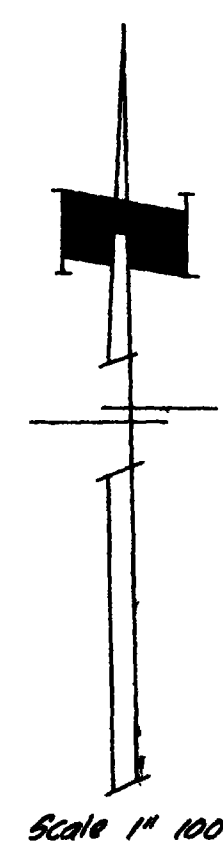
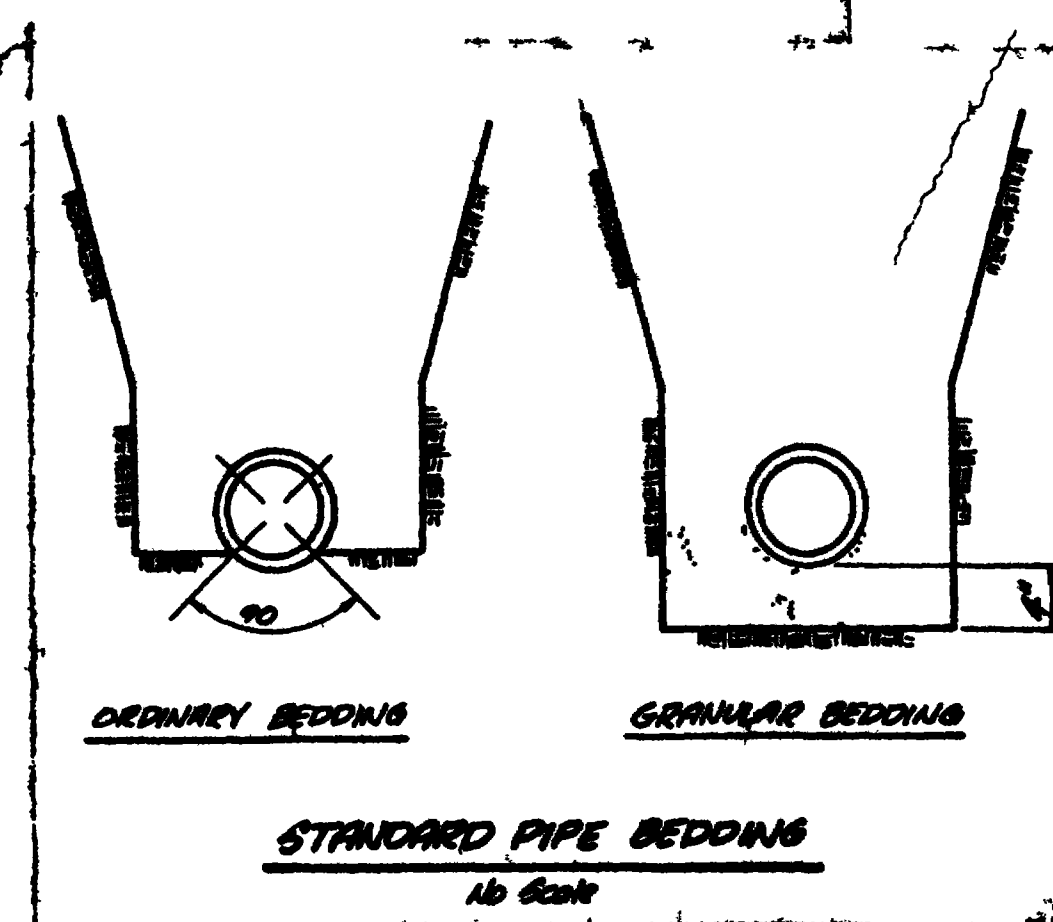


STANDARD SERVICE CONNECTION
No Scale

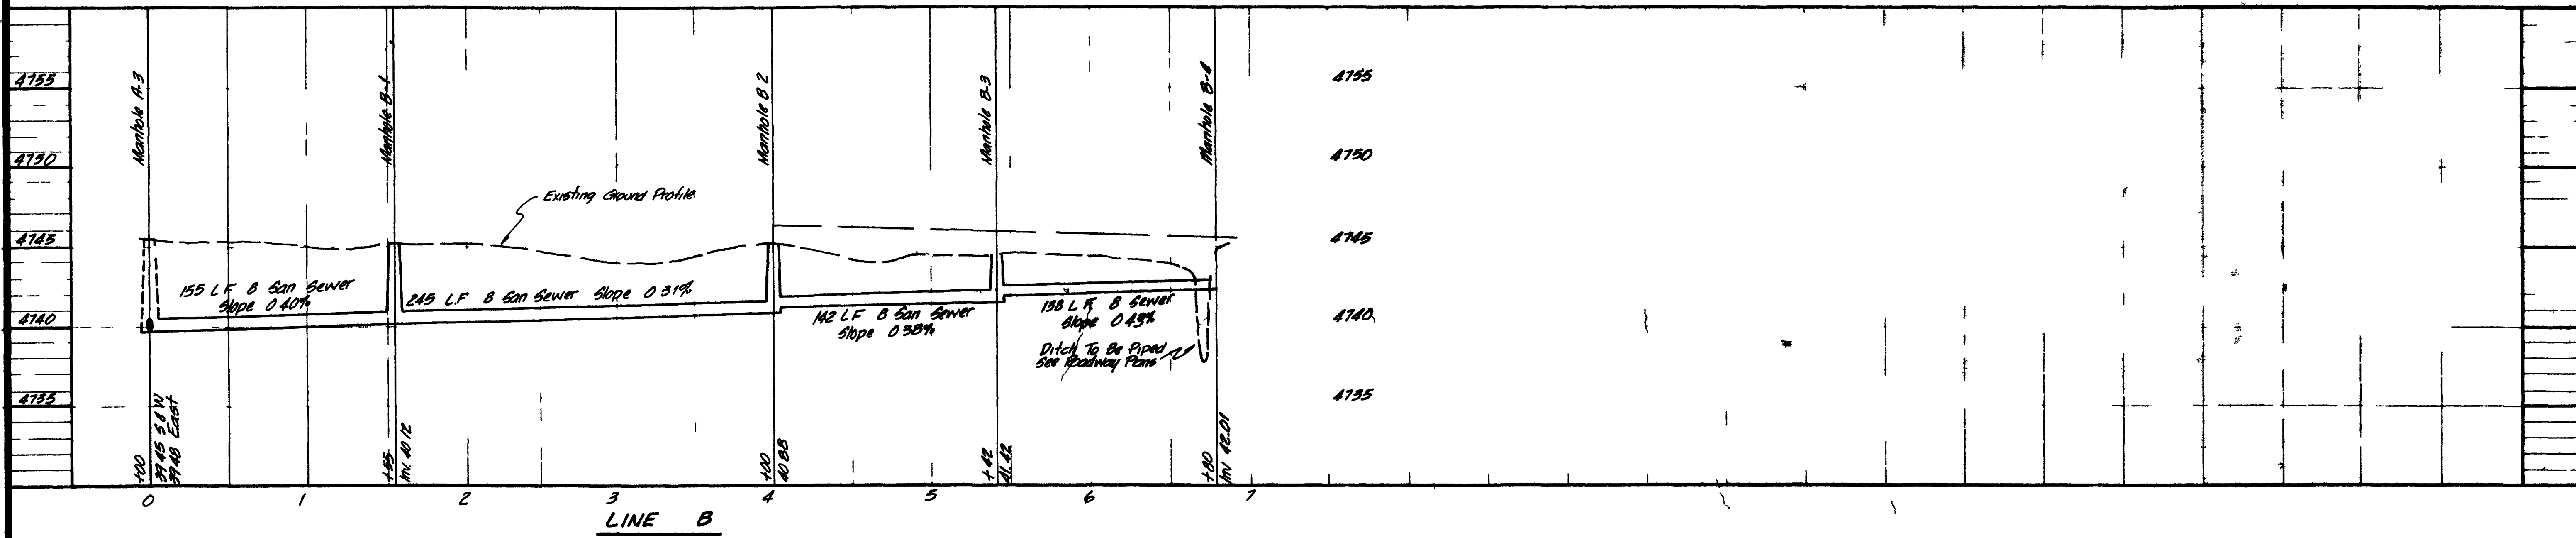

AS-BUILT DRAWINGS

APPROVED _____
 DATE _____
 DRAWN BY _____
 CHECKED BY _____
 PROJECT: HORIZON PARK PLAZA
 MESA COUNTY, COLORADO
 ENGINEER: ROBERT P. GERLOFS
 ENGINEERING CONSULTANTS
 43 8886

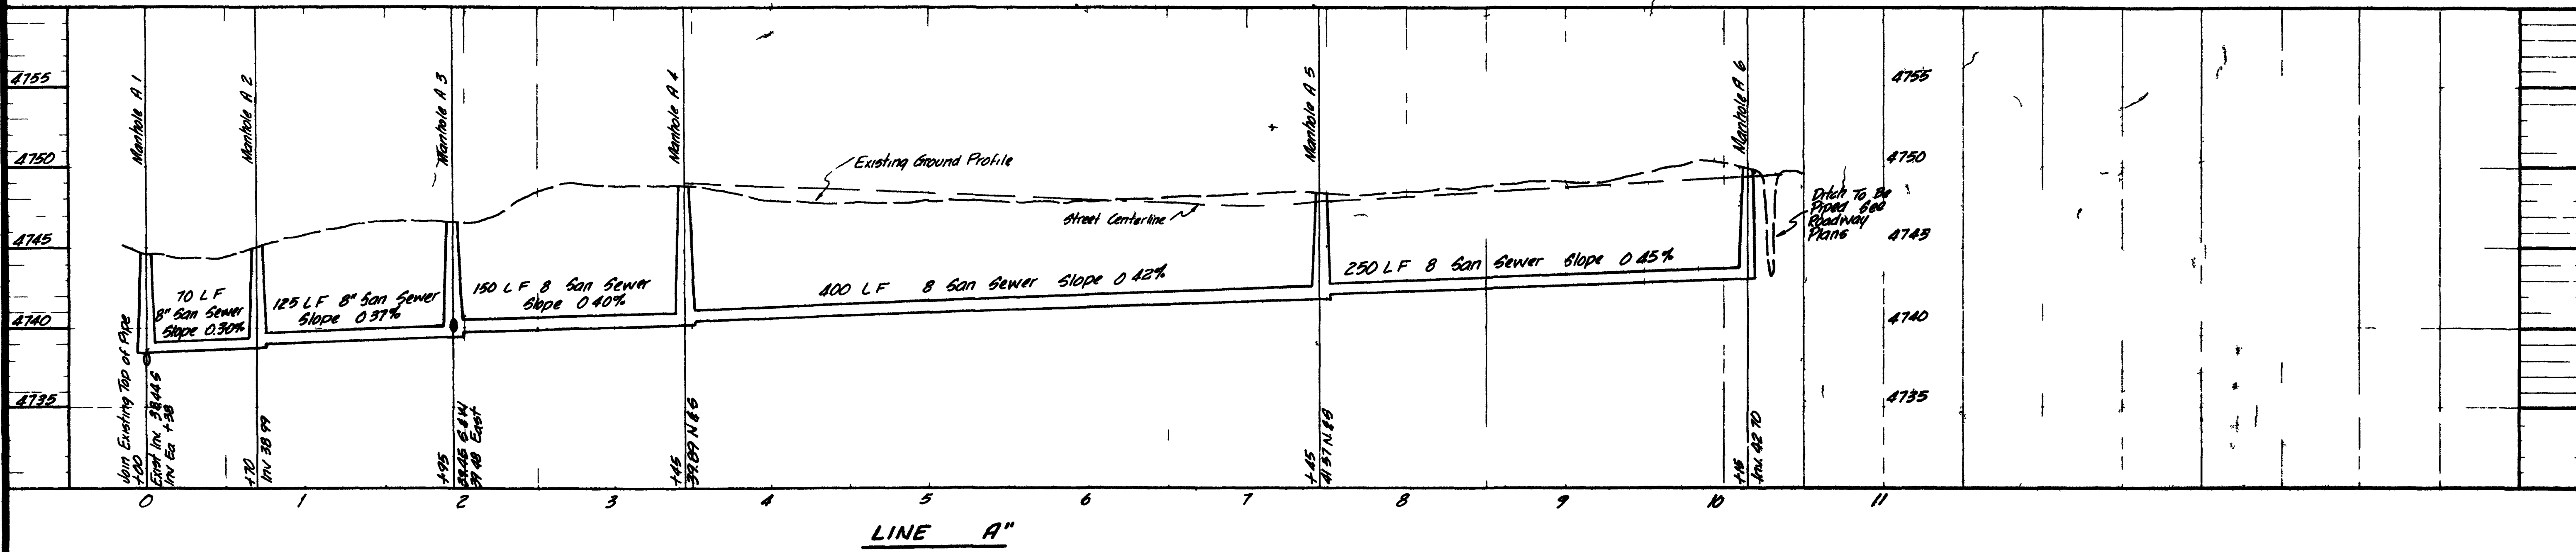

AS BUILT DRAWINGS

SANITARY SEWER PROFILE
 HORIZON PARK PLAZA
 MESA COUNTY COLORADO
 DA March 1978
 P. 20 of 22
 SC
 ROBERT P. GERLOFS
 501 PHONE 243 96