


WESTERN ENGINEERS, INC.
 PLAN & PROFILES-SEWERAGE SYSTEM
 AS CONSTRUCTED
 LAKESIDE SUBDIVISION
 FILING NUMBER TWO
 GRAND JUNCTION, COLORADO
 DESIGNED R.J.M. DRAWN G.L.A. CHECKED C.J.B.
 GRAND JUNCTION, COLORADO DWG. 1-429-6 S-1 11/8/74

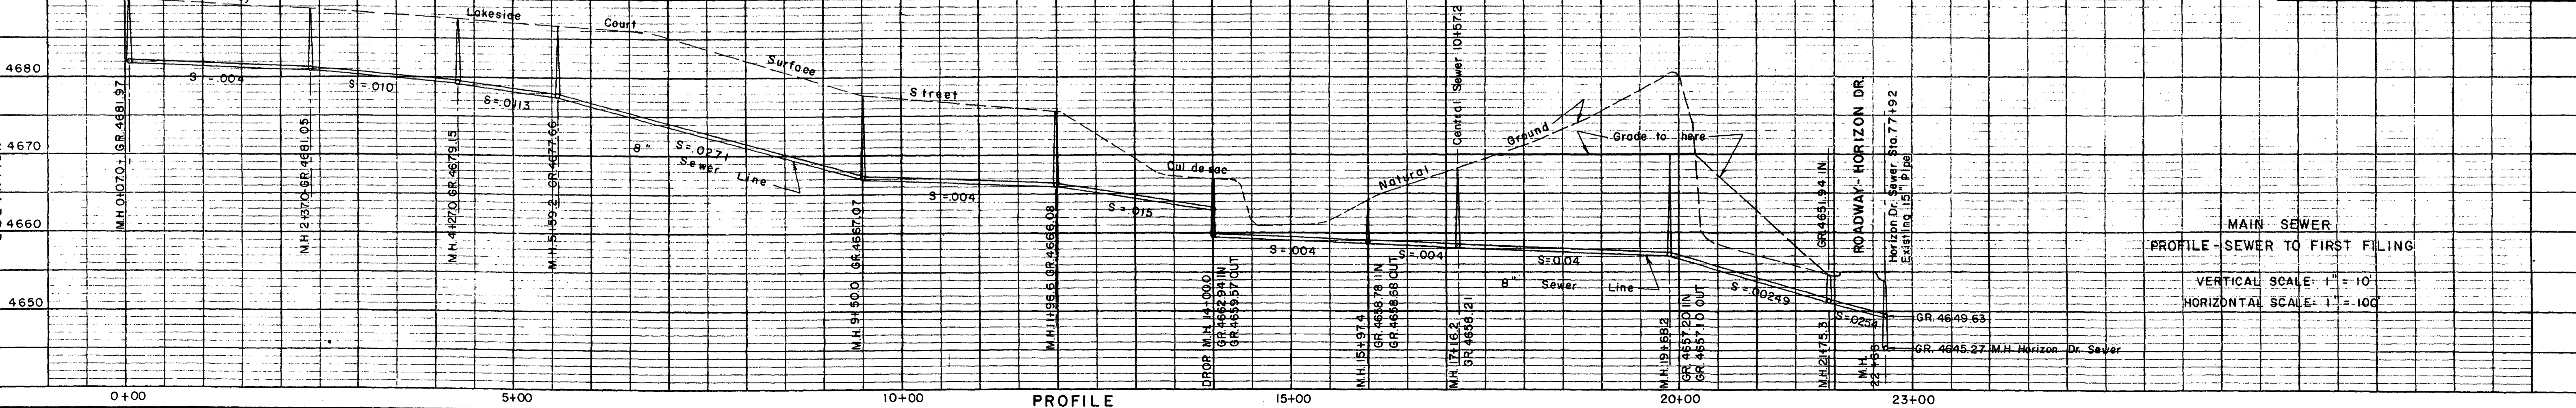

MAIN SEWER
 PROFILE - SEWER TO FIRST FILING
 VERTICAL SCALE: 1" = 10'
 HORIZONTAL SCALE: 1" = 100'