

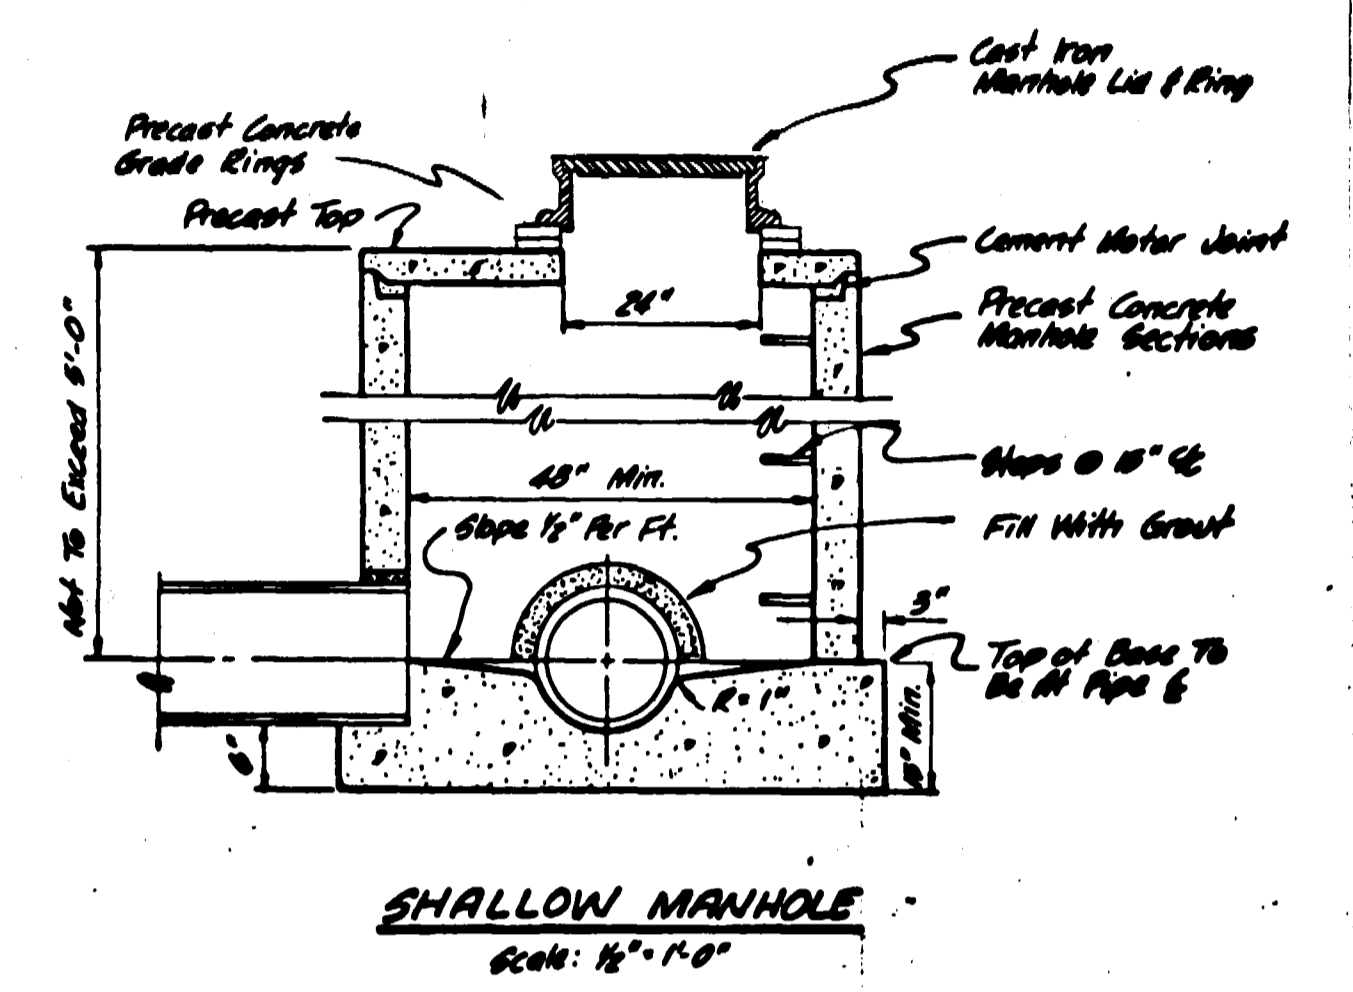
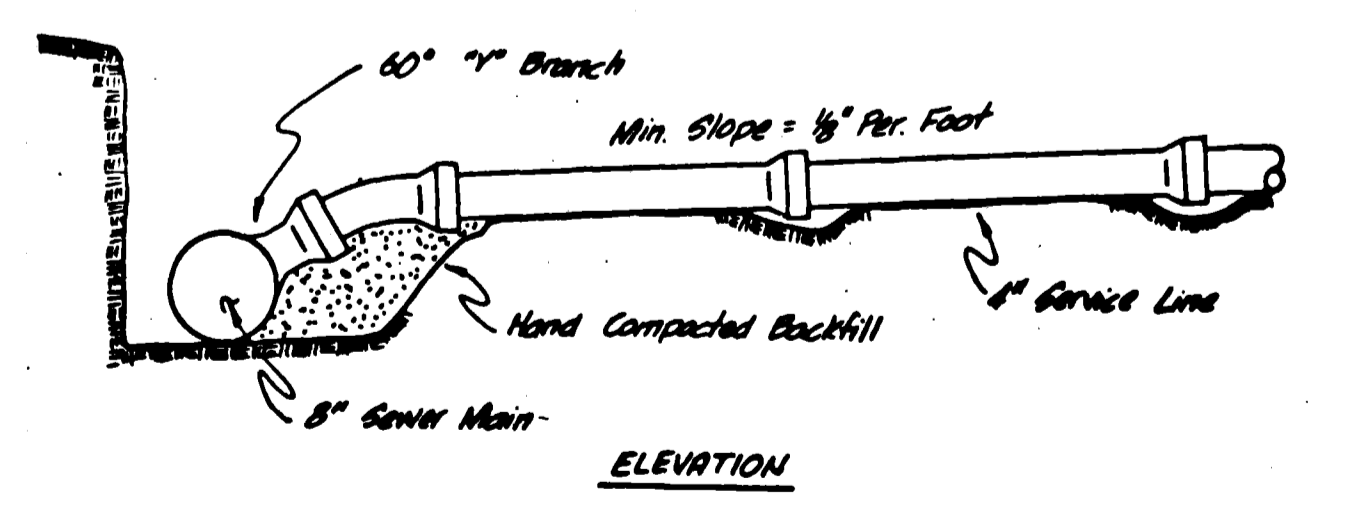


STREET CONTRACTOR IS TO ADJUST LID AND RING TO FINISH GRADE AND PROVIDE CEMENT GROUT.

Note: Precast top to be set level with top subgrade

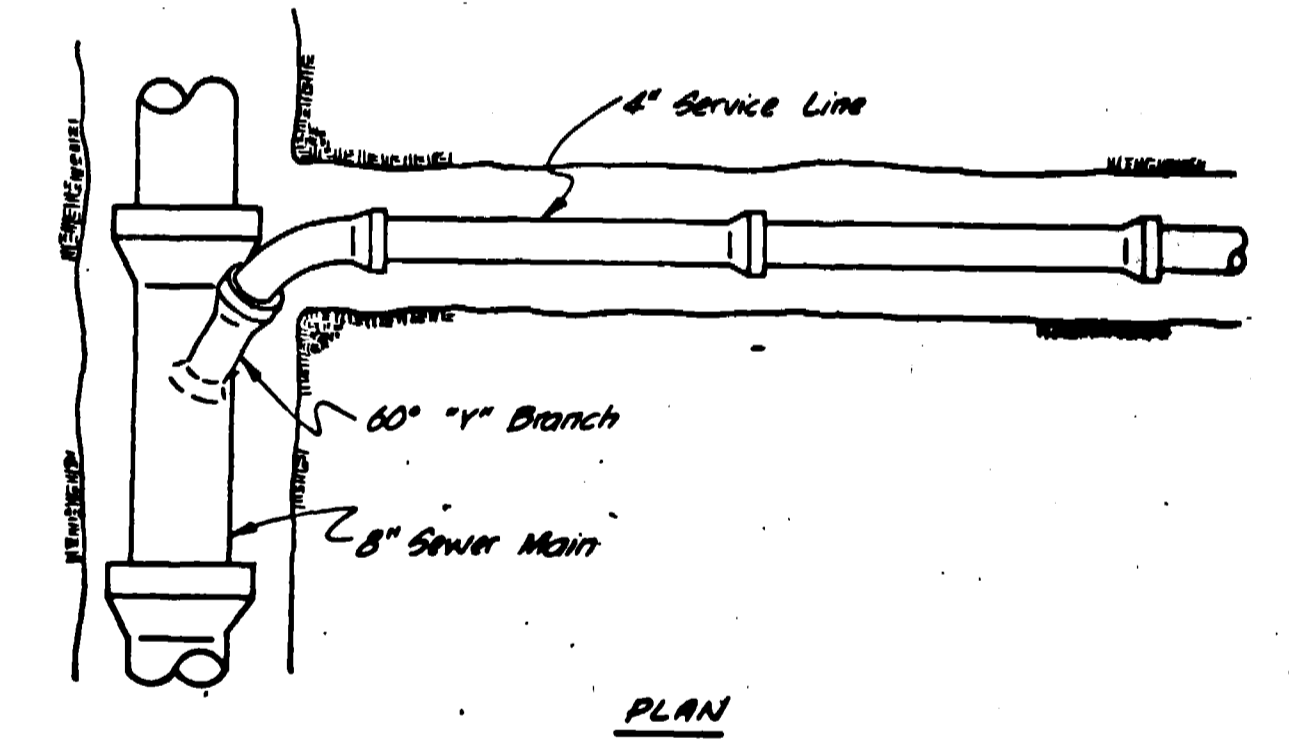

Scale 1" = 50'

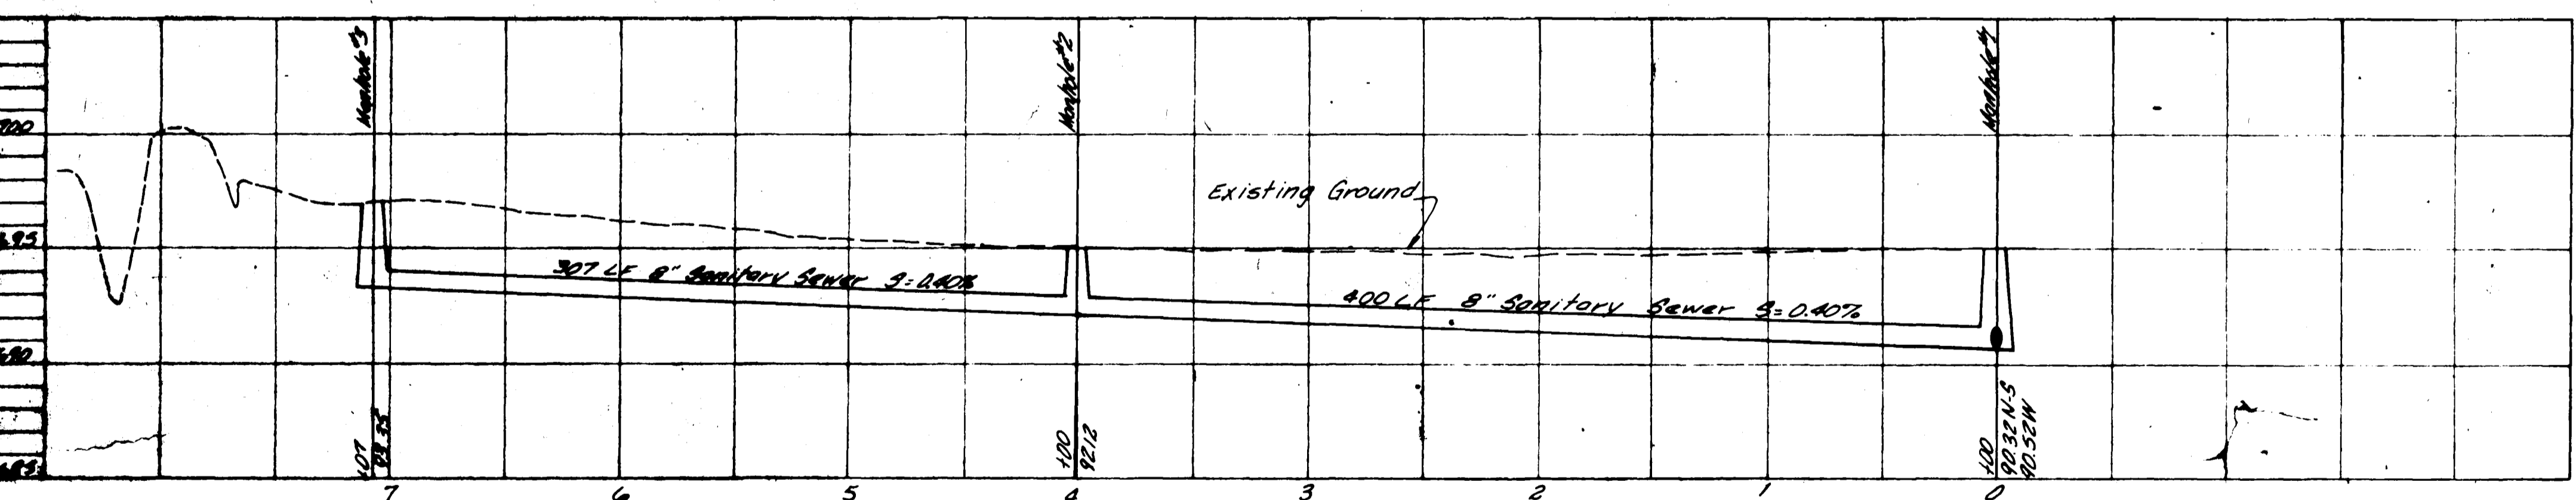

STANDARD SERVICE CONNECTION  
No Scale



Approved \_\_\_\_\_ Date \_\_\_\_\_  
Central Grand Valley Sanitation District

AS BUILT DRAWING