

STANDARD SERVICE CONNECTION
No Scale

GENERAL NOTES
 1 TOP OF ECCENTRIC CONE TO BE SET @ TOP OF SUBGRADE (STREET CONTRACTOR TO SET RIMS TO FINISH GRADE OF STREET)
 2 ALL CONSTRUCTION TO BE DONE IN ACCORDANCE WITH THE ORCHARD MESA SANITATION DISTRICT SPECIFICATIONS

QUANTITIES
 4224 LF 8 SANITARY SEWER
 15 STANDARD MANHOLES
 32 SERVICE LINES

APPROVED _____ DATE _____
 ORCHARD MESA SANITATION DISTRICT



AS BUILT DRAWING




SEWER PLAN & DETAILS

SUNRISE RIDGE SUBDIVISION
 MESA COUNTY, COLORADO


SHEET 1 OF 3




ROBERT P. GERLOFS
 Engineering Consultants
 P.O. BOX 2872 GRAND JUNCTION, COLORADO 81501 PHONE 243-8986

DATE: Oct., 1976
 SCALE: 1" = 50'

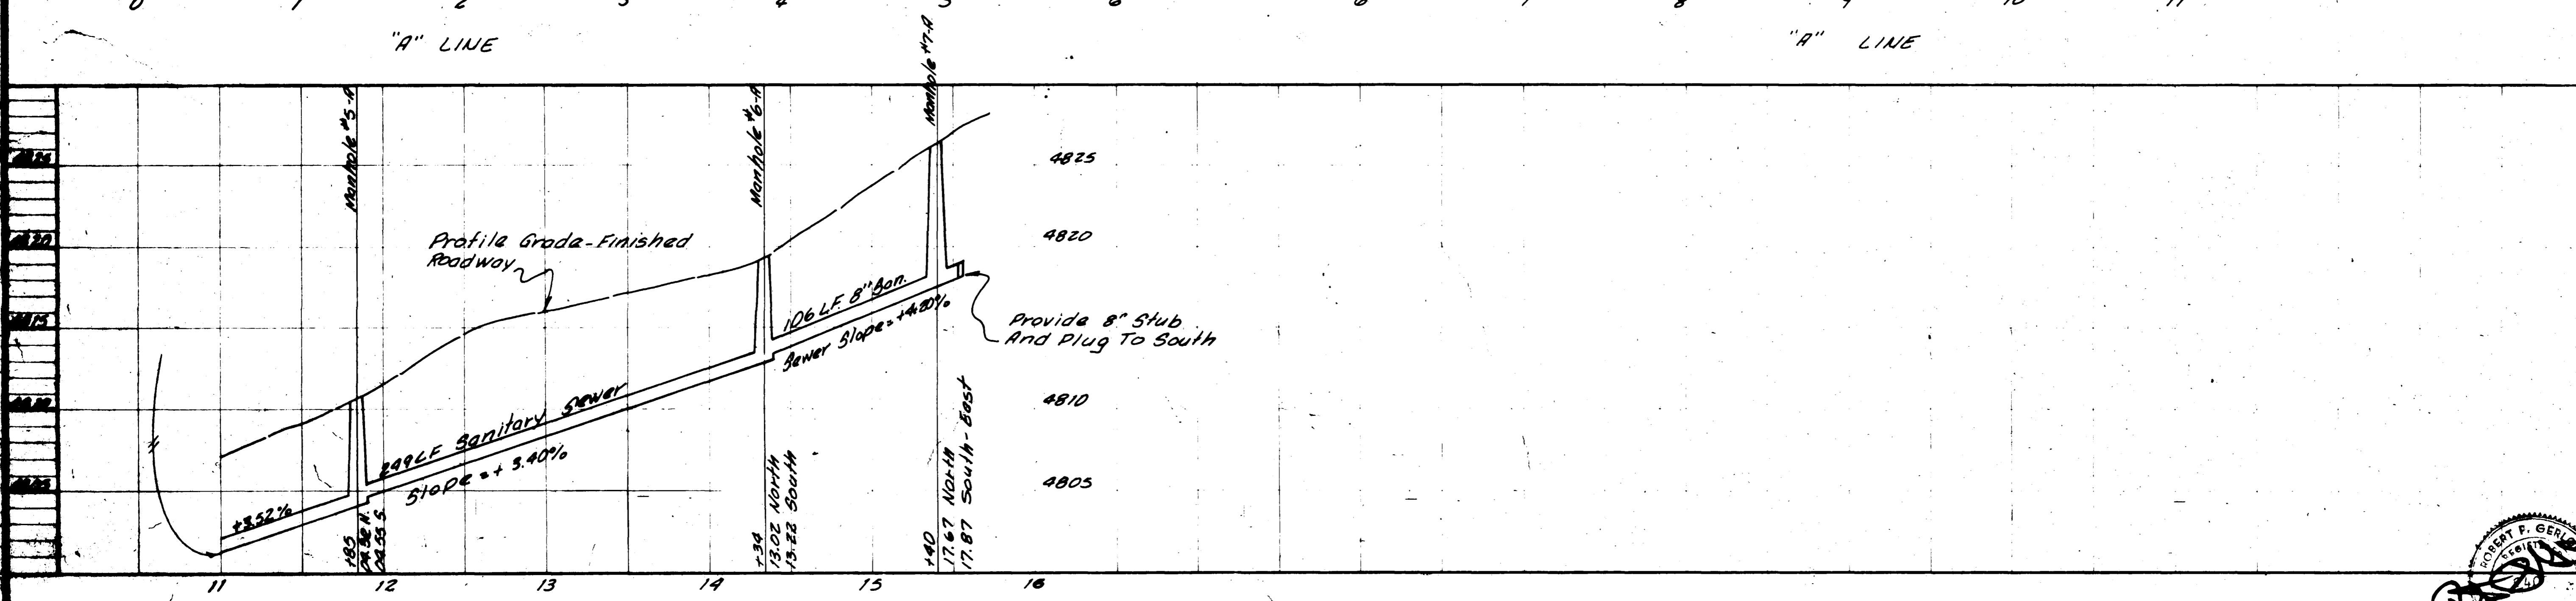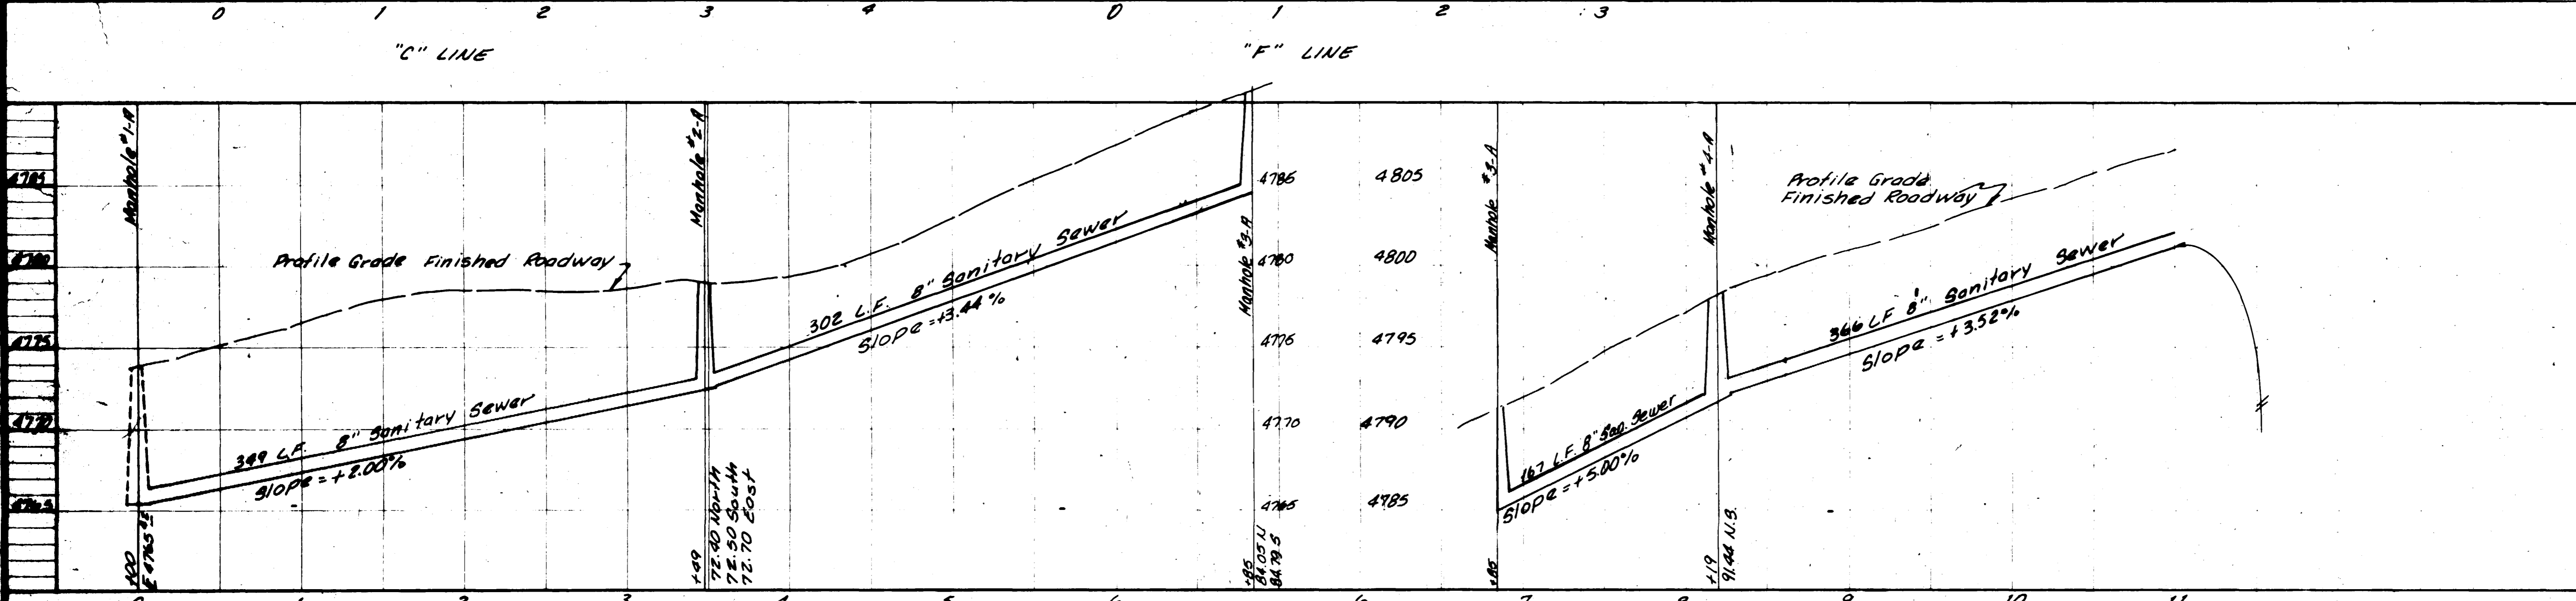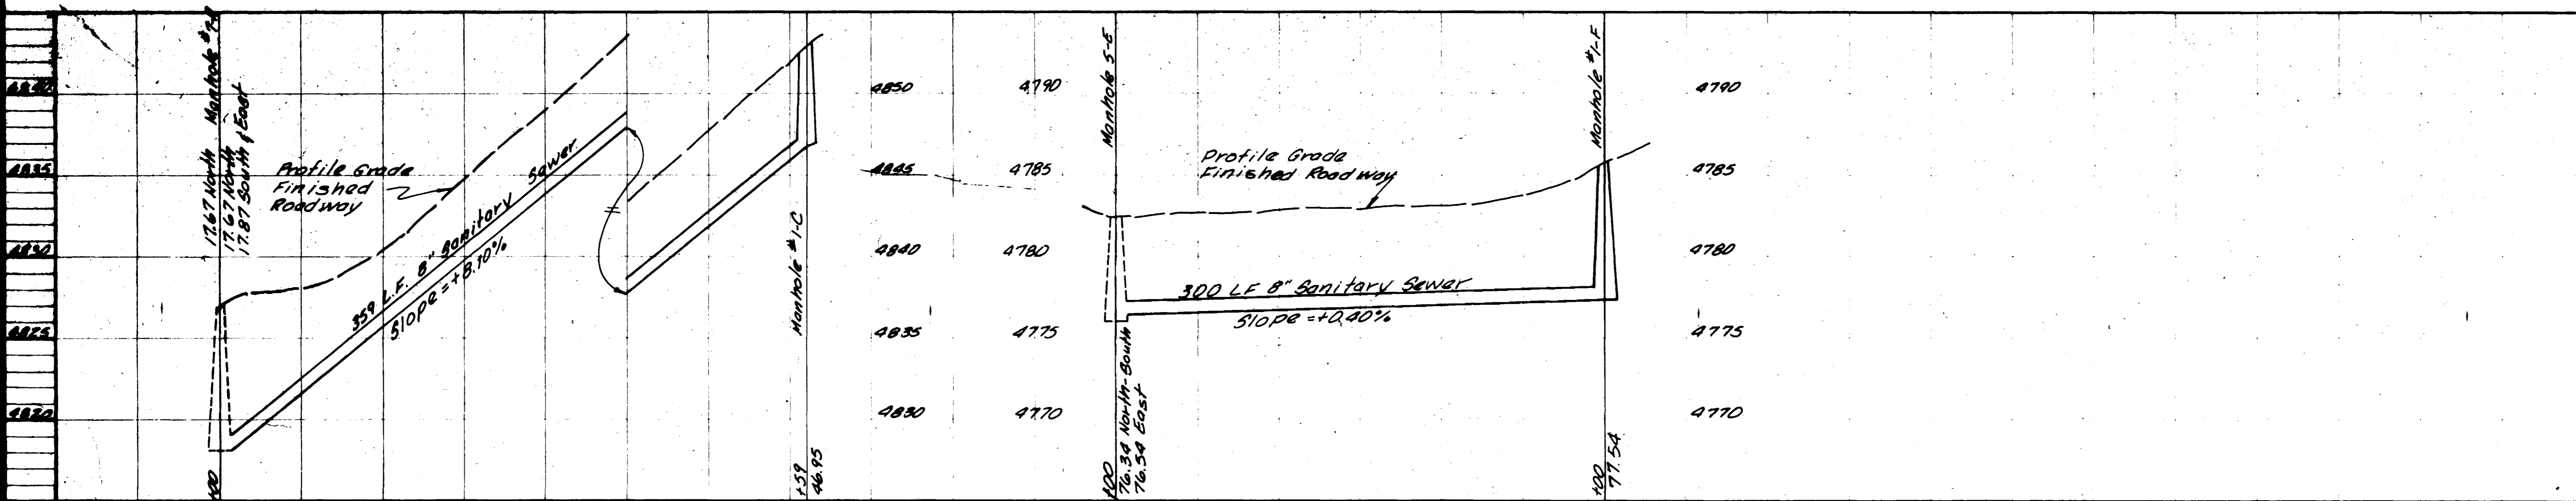

SUNRISE RIDGE SUBDIVISION
 MESA COUNTY, COLORADO
 SHEET 2
 OF 3
 DATE Oct. 1976
 SCALE 1/4" = 1' HORIZ
 1/2" = 1' VERT
 ROBERT P. GERLOFS
 Engineering Consultants
 P.O. BOX 2872 • GRAND JUNCTION, COLORADO • 81501 • PHONE 243-8866

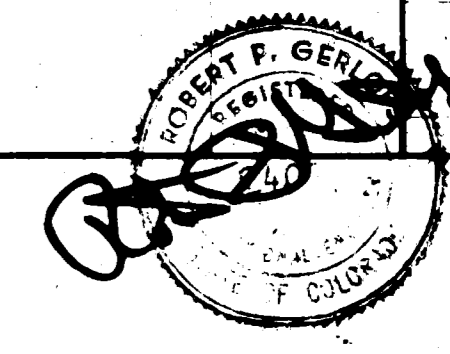

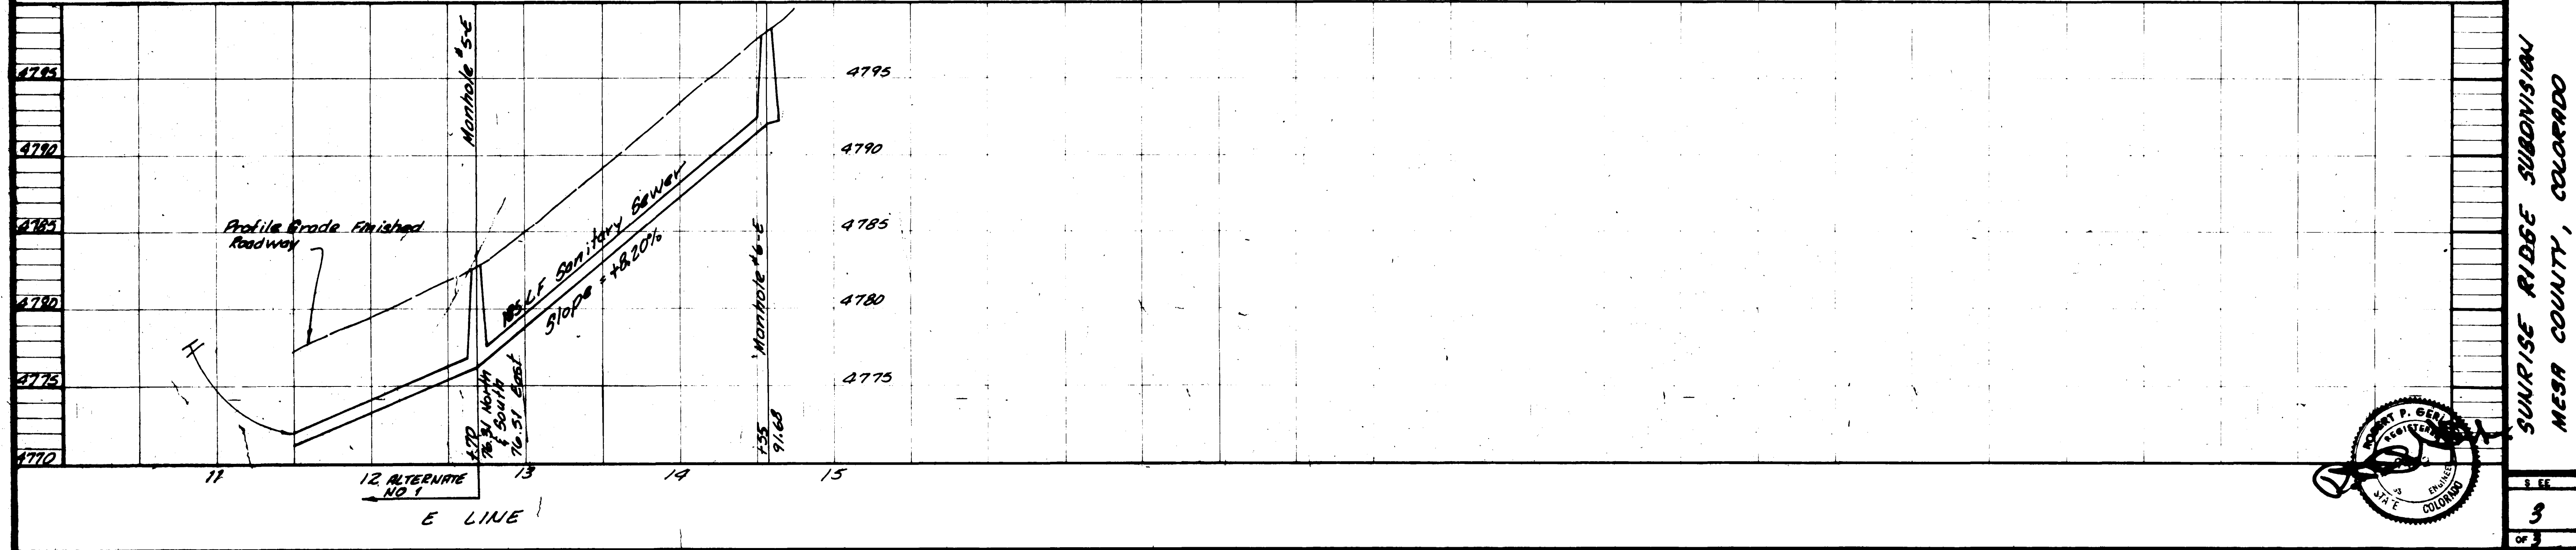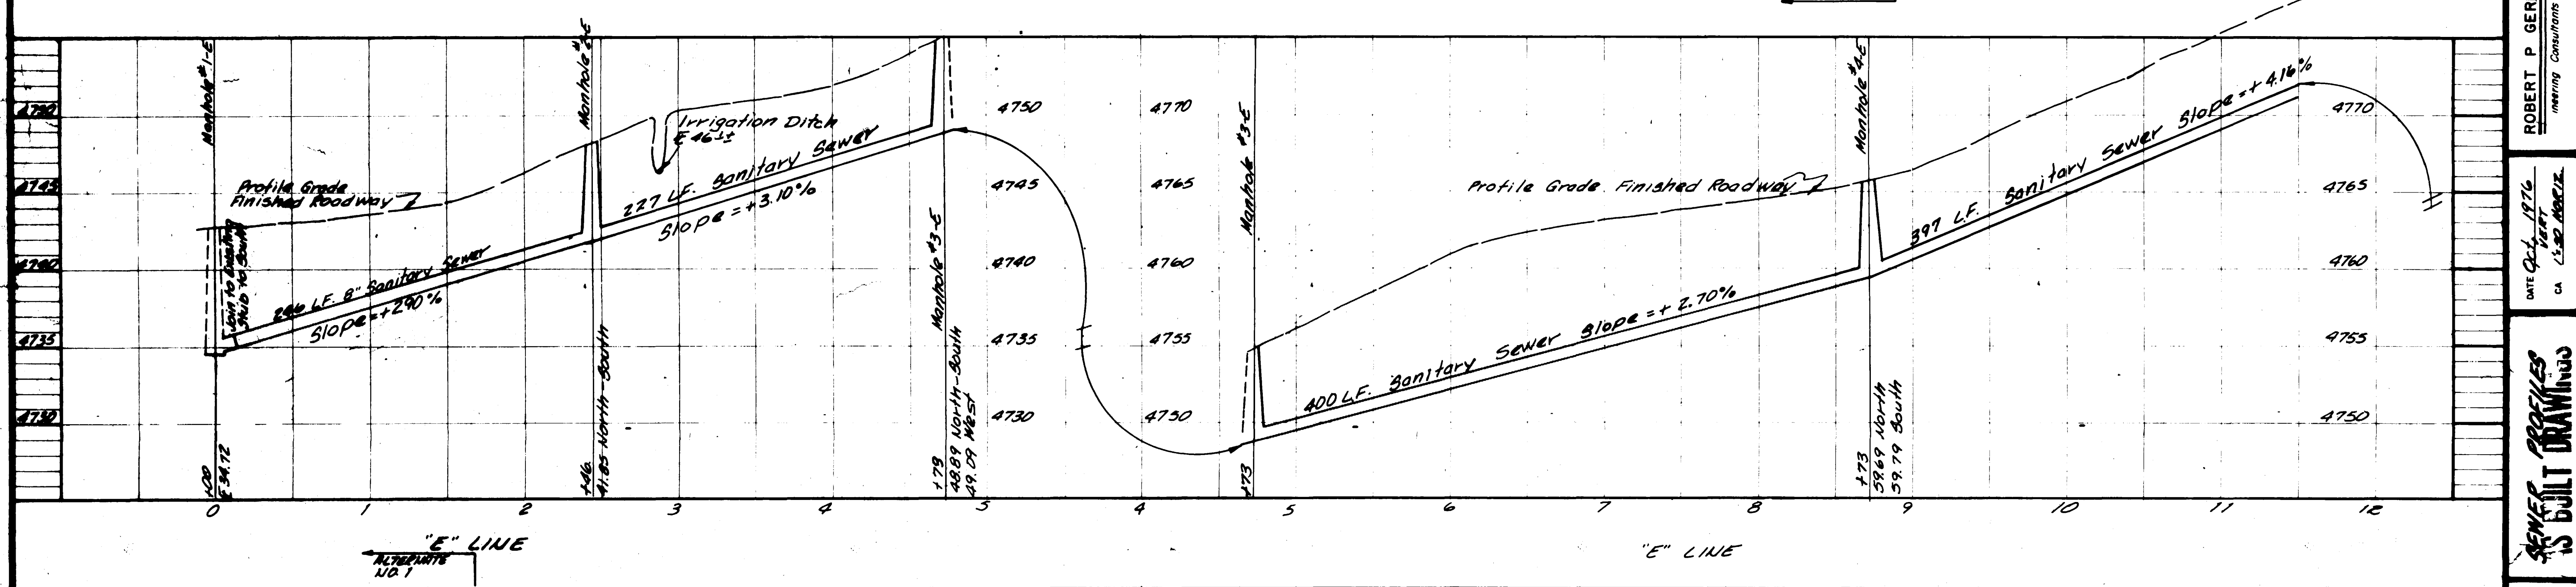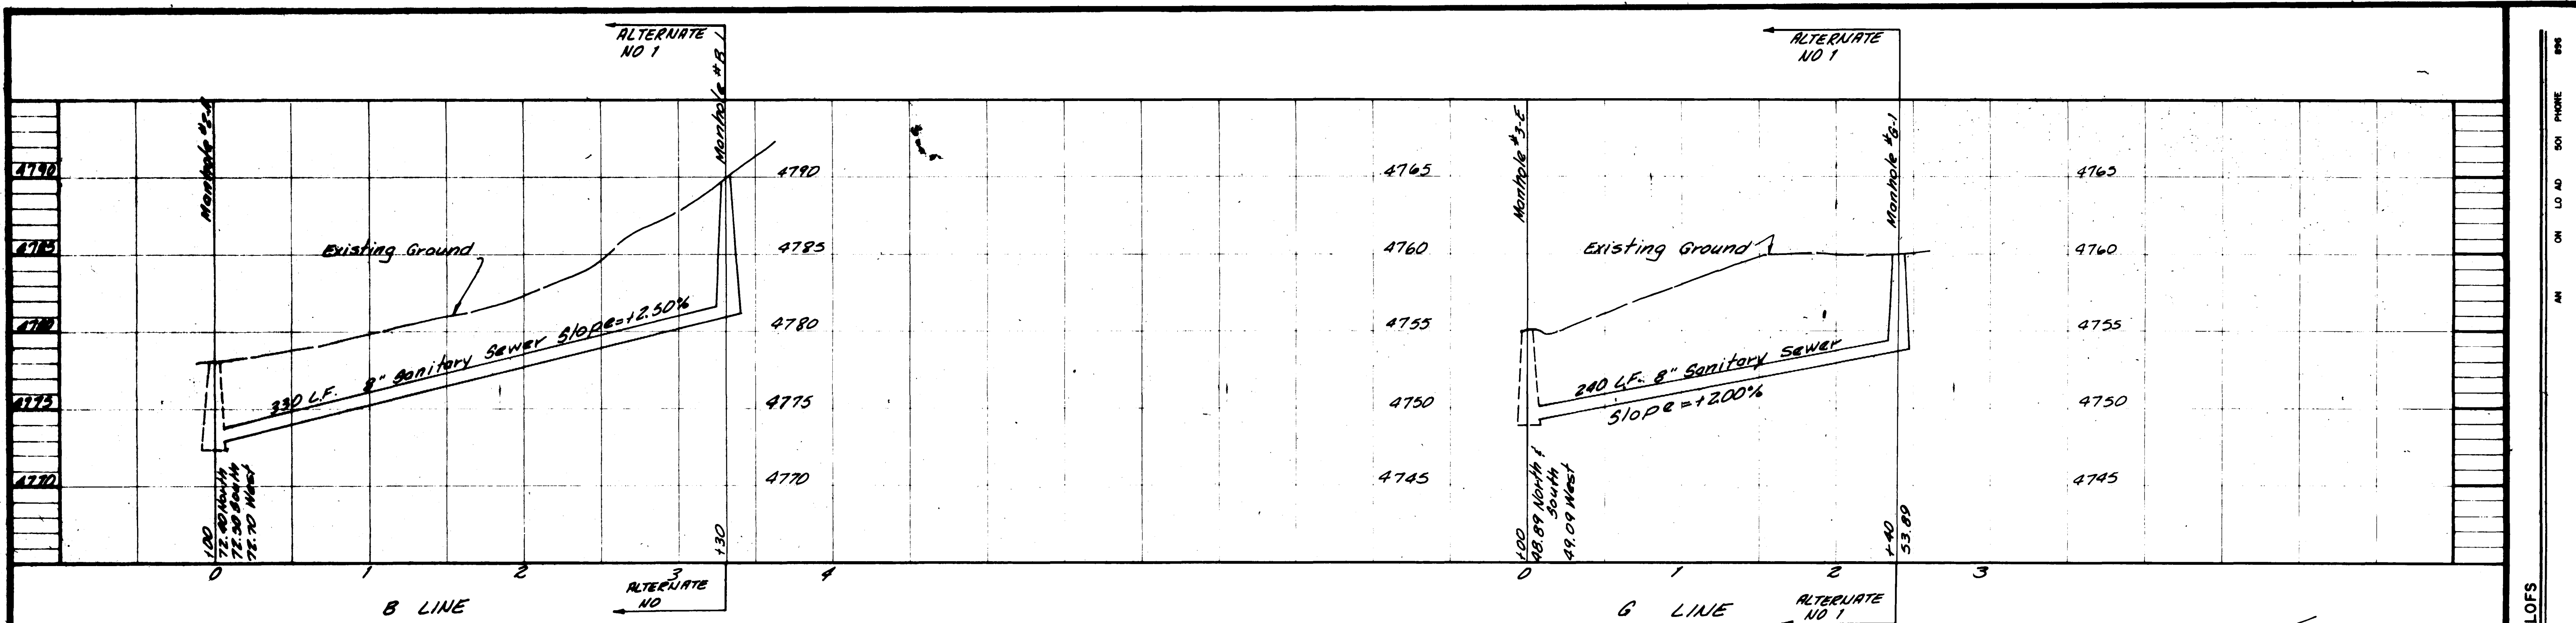

ROBERT P. GERLOFS
 Engineering Consultants
 DATE: 02-1-1976
 BY: J.S.P. HERRIZ
 CA 15-20 HERRIZ
**SEWER PROFILES
 IS BUILT DRAWINGS**
 SUNRISE RIDGE SUBDIVISION
 MESA COUNTY, COLORADO
 SEE
 3
 3

