

**LEGEND:**  
 S — SANITARY SEWER MAIN (AS-BUILT)  
 L.T.#1 — A PART OF LITTLE TRIO SUBDIVISION FIRST ADDITION AND RESUBDIVISION OF LOT 3 LITTLE TRIO SUBDIVISION SEWER PLAN  
 L.T.#2 — A PART OF LITTLE TRIO SUBDIVISION SECOND ADDITION FIRST FILING SEWER PLAN



*Luther T. Mangrove*  
 6-6-77


AS BUILT SEWER PLANS  
 LITTLE TRIO SUBDIVISION FIRST ADDITION  
 AND RESUBDIVISION OF LOT 3 IN  
 LITTLE TRIO SUBDIVISION  
 AND  
 LITTLE TRIO SUBDIVISION  
 SECOND ADDITION  
 FIRST FILING  
 BY  
 MUSGRAVE SURVEYING  
 656 31 ROAD GRAND JUNCTION, COLORADO  
 PH N (303) 434 7089  
 FILE 76 01 02 - 76 05 08  
 MARCH 17 1977  
 SHEET 1 OF 3

NE E 4 SE 5 E M  
 ELEV. M. S.M. 4876

NOTE: MANHOLE RIM ELEVATIONS SHOWN BELOW ARE PROPOSED FINISH RIM ELEVATIONS. MANHOLES ARE TO BE BROUGHT TO FINISH ELEVATION BY PAVING CONTRACTOR.

SCALE: 1" = 50' HORIZONTAL  
1" = 4' VERTICAL

AS-BUILT SEWER PLANS  
LITTLE TRIO SUBDIVISION - FIRST ADDITION  
AND RESUBDIVISION OF LOT 3  
LITTLE TRIO SUBDIVISION  
AND  
LITTLE TRIO SUBDIVISION  
SECOND ADDITION  
FIRST FILING  
BY  
MUSGROVE SURVEYING  
656 31 ROAD, GRAND JUNCTION, COLO.  
PHONE: 434-7089  
FILE: 76-01-02 + 76-05-08  
MARCH 17, 1977  
SHEET 2 of 3

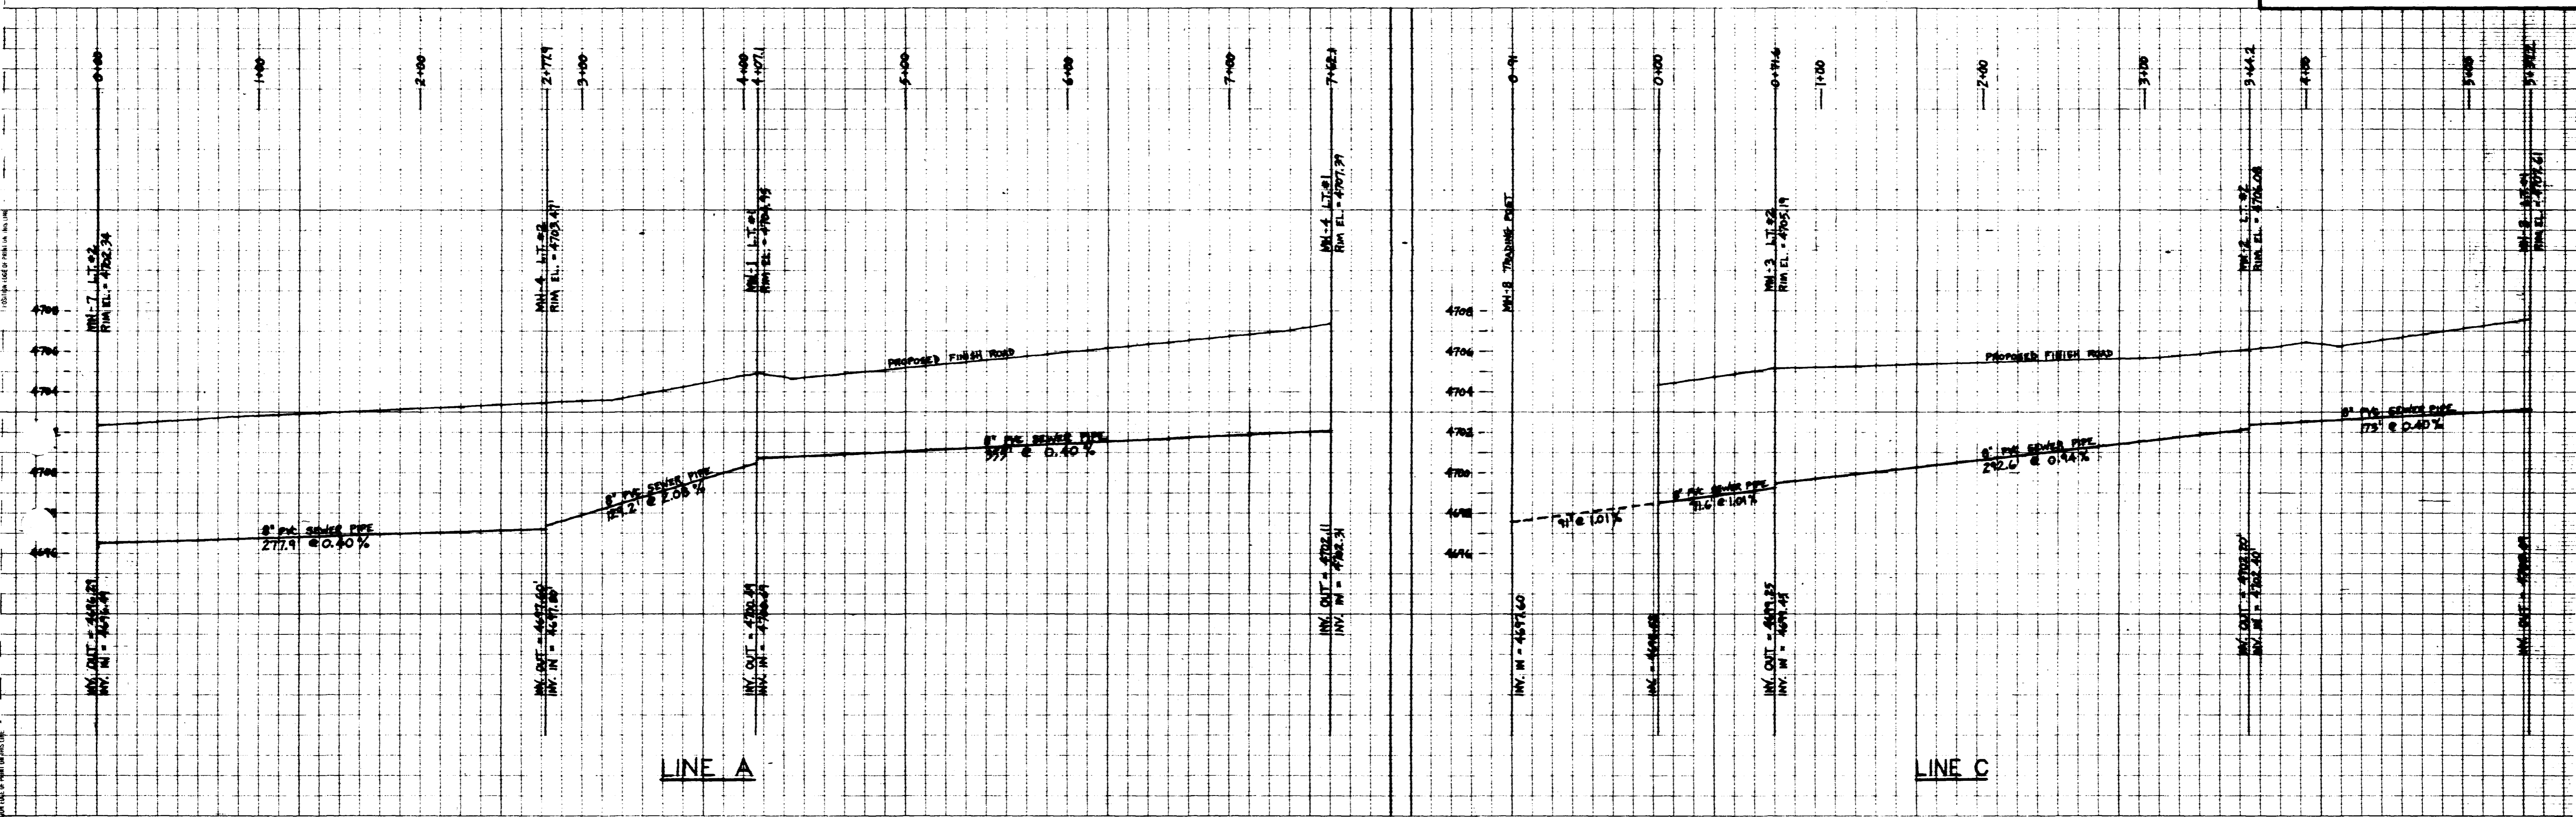

NOTE: MANHOLE RIM ELEVATIONS SHOWN BELOW ARE PROPOSED FINISH RIM ELEVATIONS. MANHOLES ARE TO BE BROUGHT TO FINISH ELEVATION BY PAVING CONTRACTOR.

SCALE: 1" = 50' HORIZONTAL  
1" = 4' VERTICAL

AS-BUILT SEWER PLANS  
LITTLE TRIO SUBDIVISION - FIRST ADDITION  
AND RESUBDIVISION OF LOT 3  
LITTLE TRIO SUBDIVISION  
AND  
LITTLE TRIO SUBDIVISION  
SECOND ADDITION  
FIRST FILING  
BY  
MUSGROVE SURVEYING  
656 31 ROAD, GRAND JUNCTION, COLO.  
PHONE: 434-7009  
FILE: 76-01-02 + 76-05-08  
MARCH 17, 1977  
SHEET 3 of 3

