
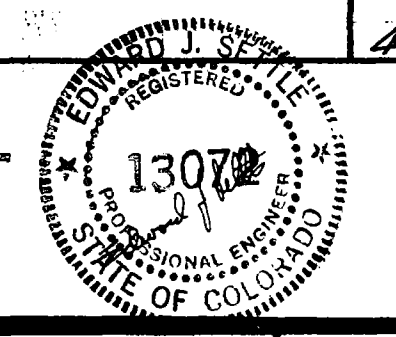
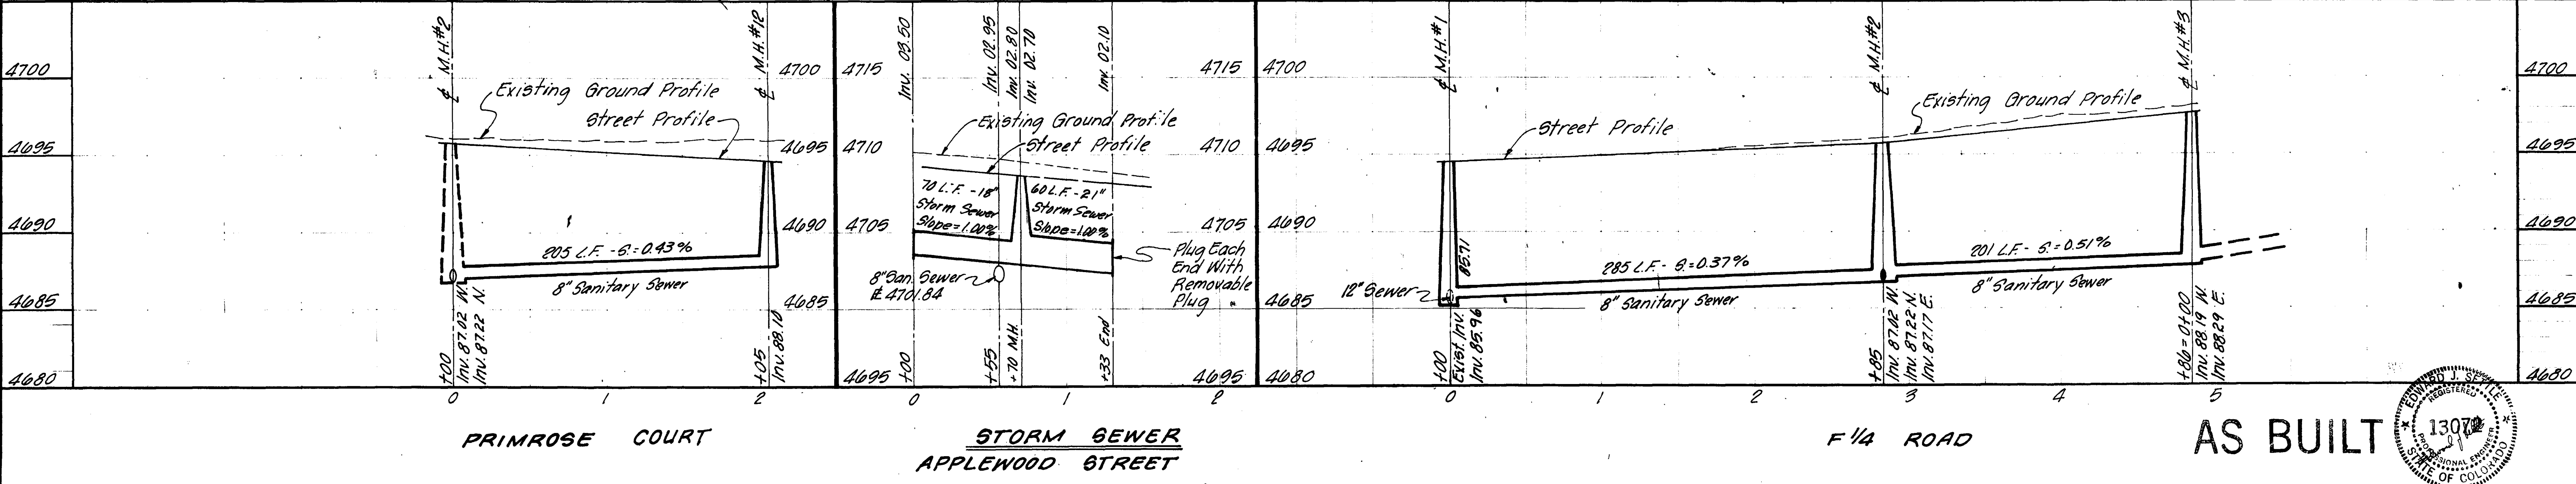
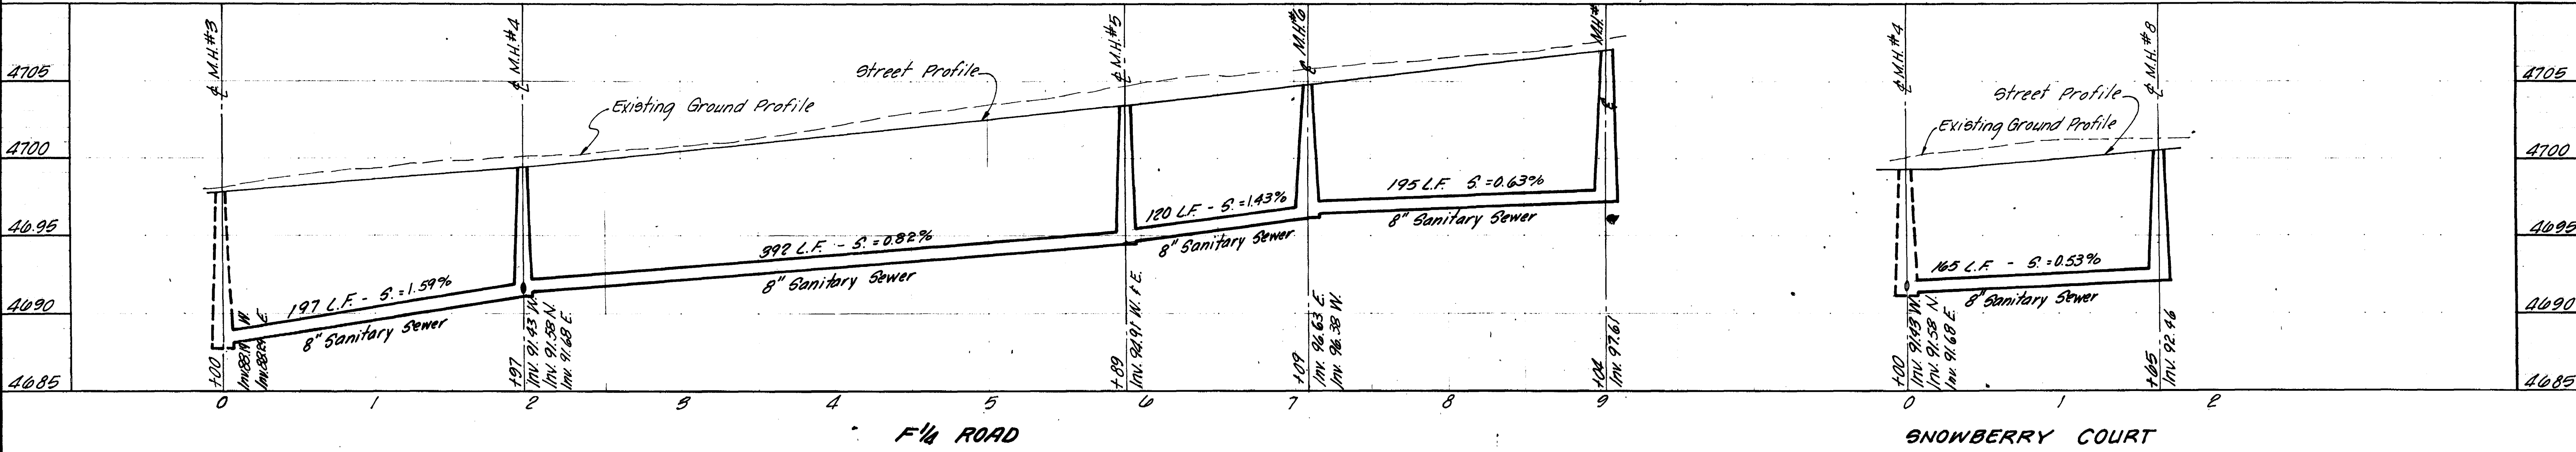


STANDARD MANHOLE

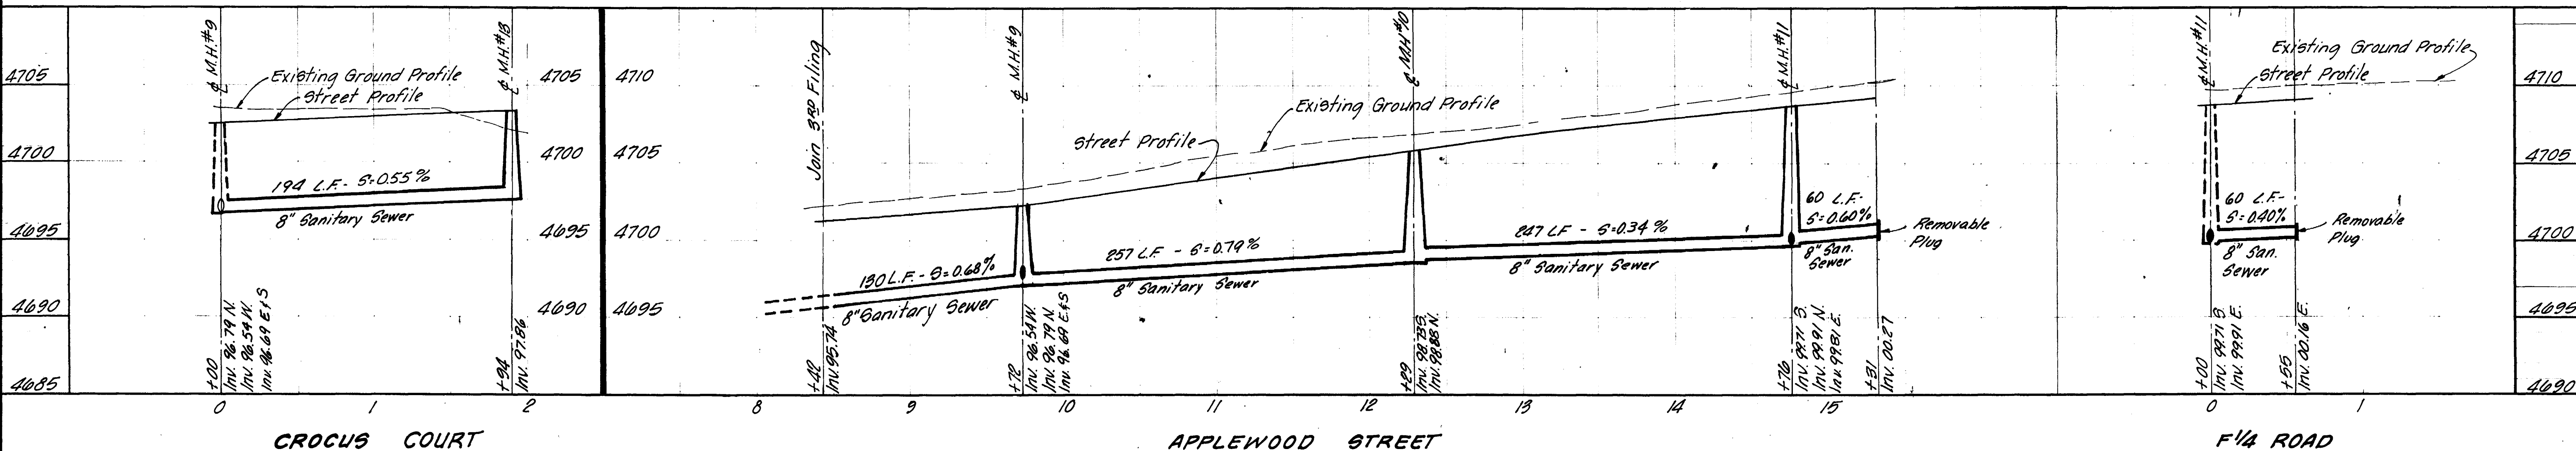

1	MES. 6/10/77	EJS.	As Built Drawings
NO.	BY	DATE	APPROVED

DATE: February, 1976
 SCALE: Horiz: 1"=50', Vert: 1"=5'
 DRAFTSMAN: B.L. Shaw
 PROJECT ENGR: E.J. Settle
 PROJECT MGR: E.J. Settle

ENGINEERING CONSULTANTS
NELSON - HALEY - PATTERSON AND QUIRK
 ENGINEERING CONSULTANTS
 GRAND JUNCTION COLORADO

SPRING VALLEY FILING & MESA COUNTY, COLORADO

AS BUILT
 SANITARY SEWER PROFILE
 SHEET 6 OF 7
 PROJECT NO. 74-P-ENG-0541

