


QUANTITIES
 10 SANITARY SEWER 704 LF
 8 SANITARY SEWER - M.N. LF
 MANHOLES 11
 4 SERVICE CONNECTIONS 45

GENERAL NOTES
 1. ALL CONSTRUCTION TO BE DONE IN ACCORDANCE WITH THE CENTRAL GRAND VALLEY SANITARIAN DISTRICT SPECIFICATIONS.
 2. TOP OF ECCENTRIC CONE TO BE SET @ TOP OF SUBGRADE (STREET CONTRACTOR TO BE SET RING TO FINISH GRADE OF STREET)




APPROVED _____ DATE _____
 CENTRAL GRAND VALLEY SANITARIAN DISTRICT
AS BUILT DRAWING


ROBERT P. GERLOFFS
 STATE OF MICHIGAN
 NO. 12450
 EX BOW SUBDIVISION
 SANITARY SEWER PLAN
 AND DETAILS
 FILE NO. THREE

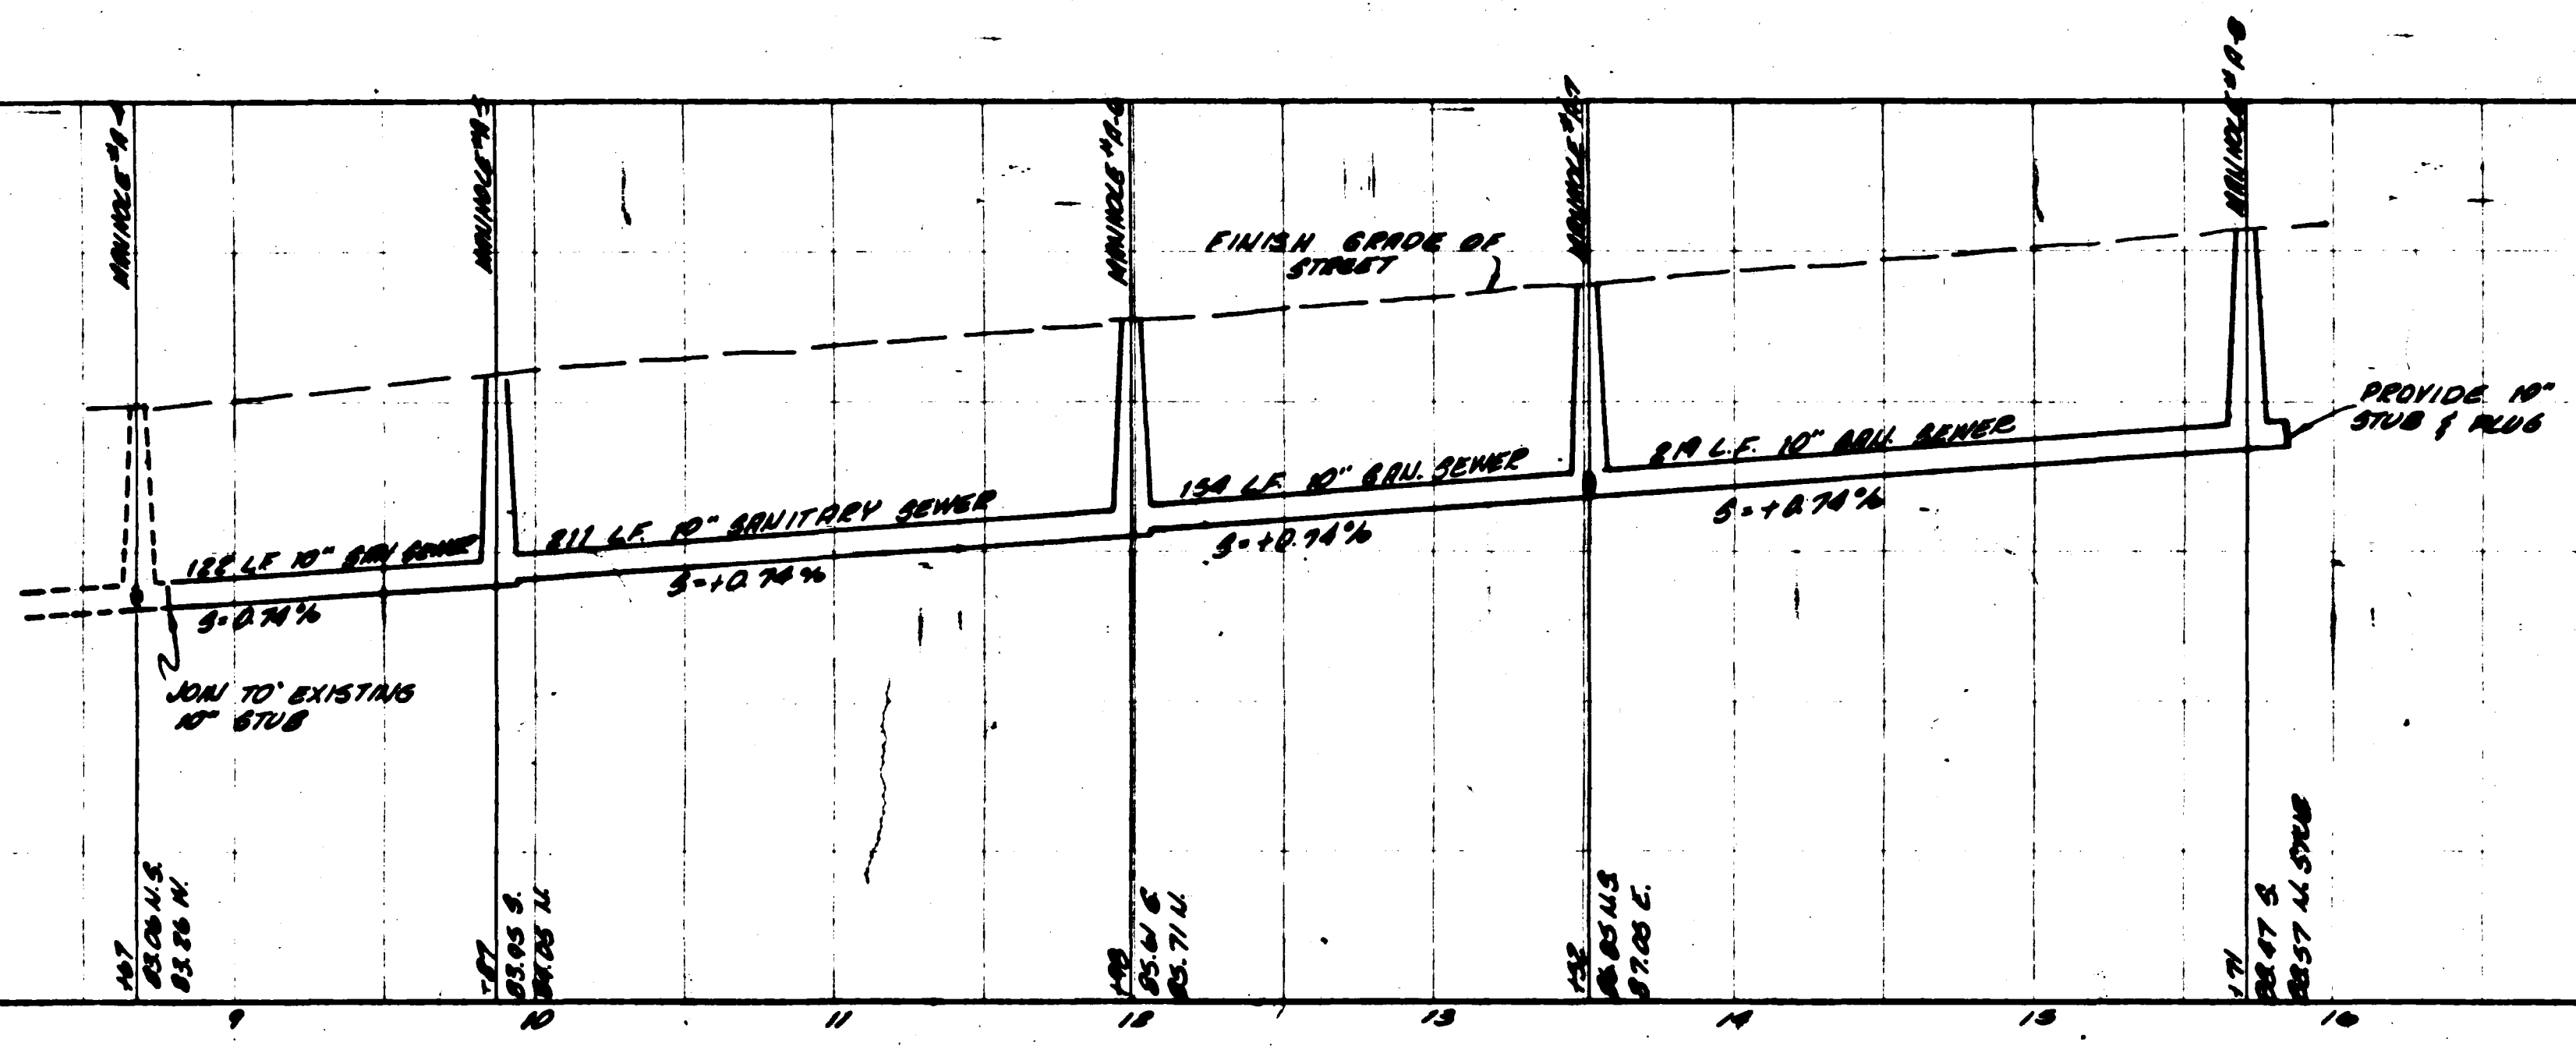

LINE A

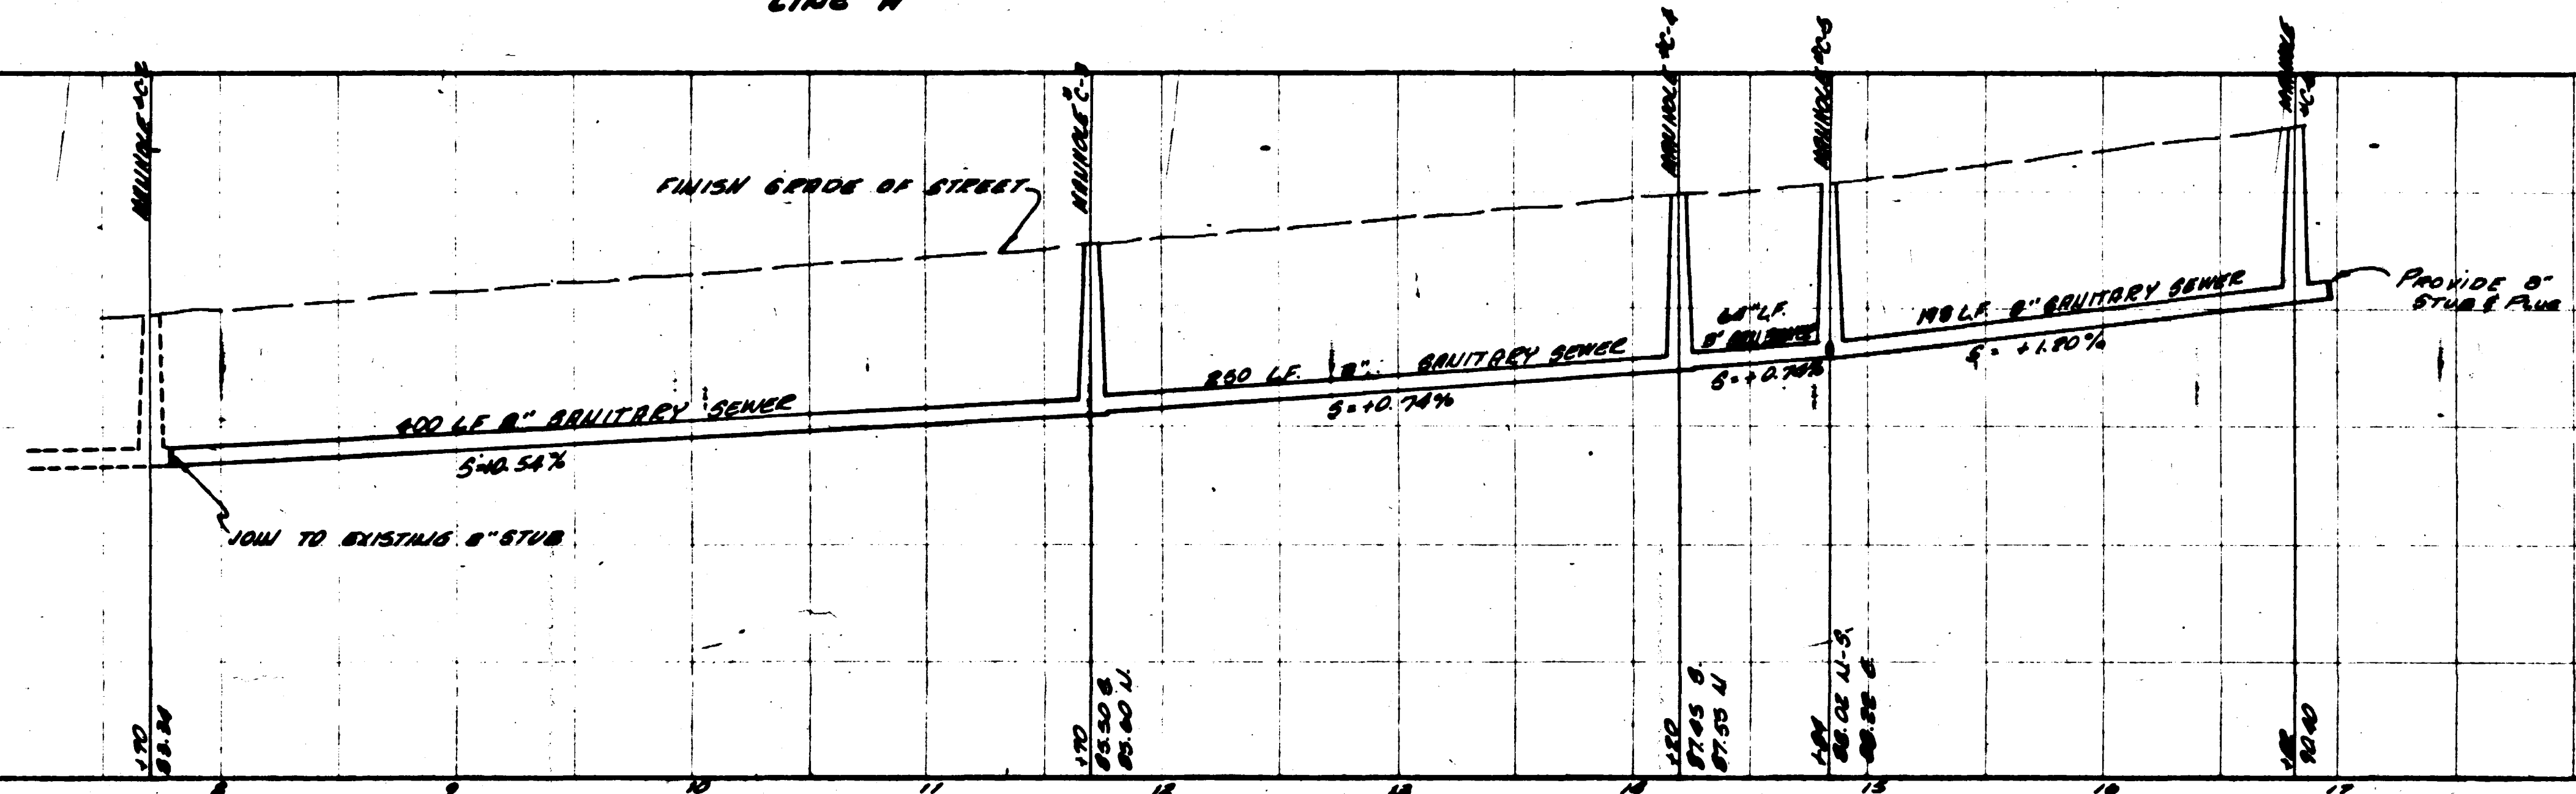

LINE C

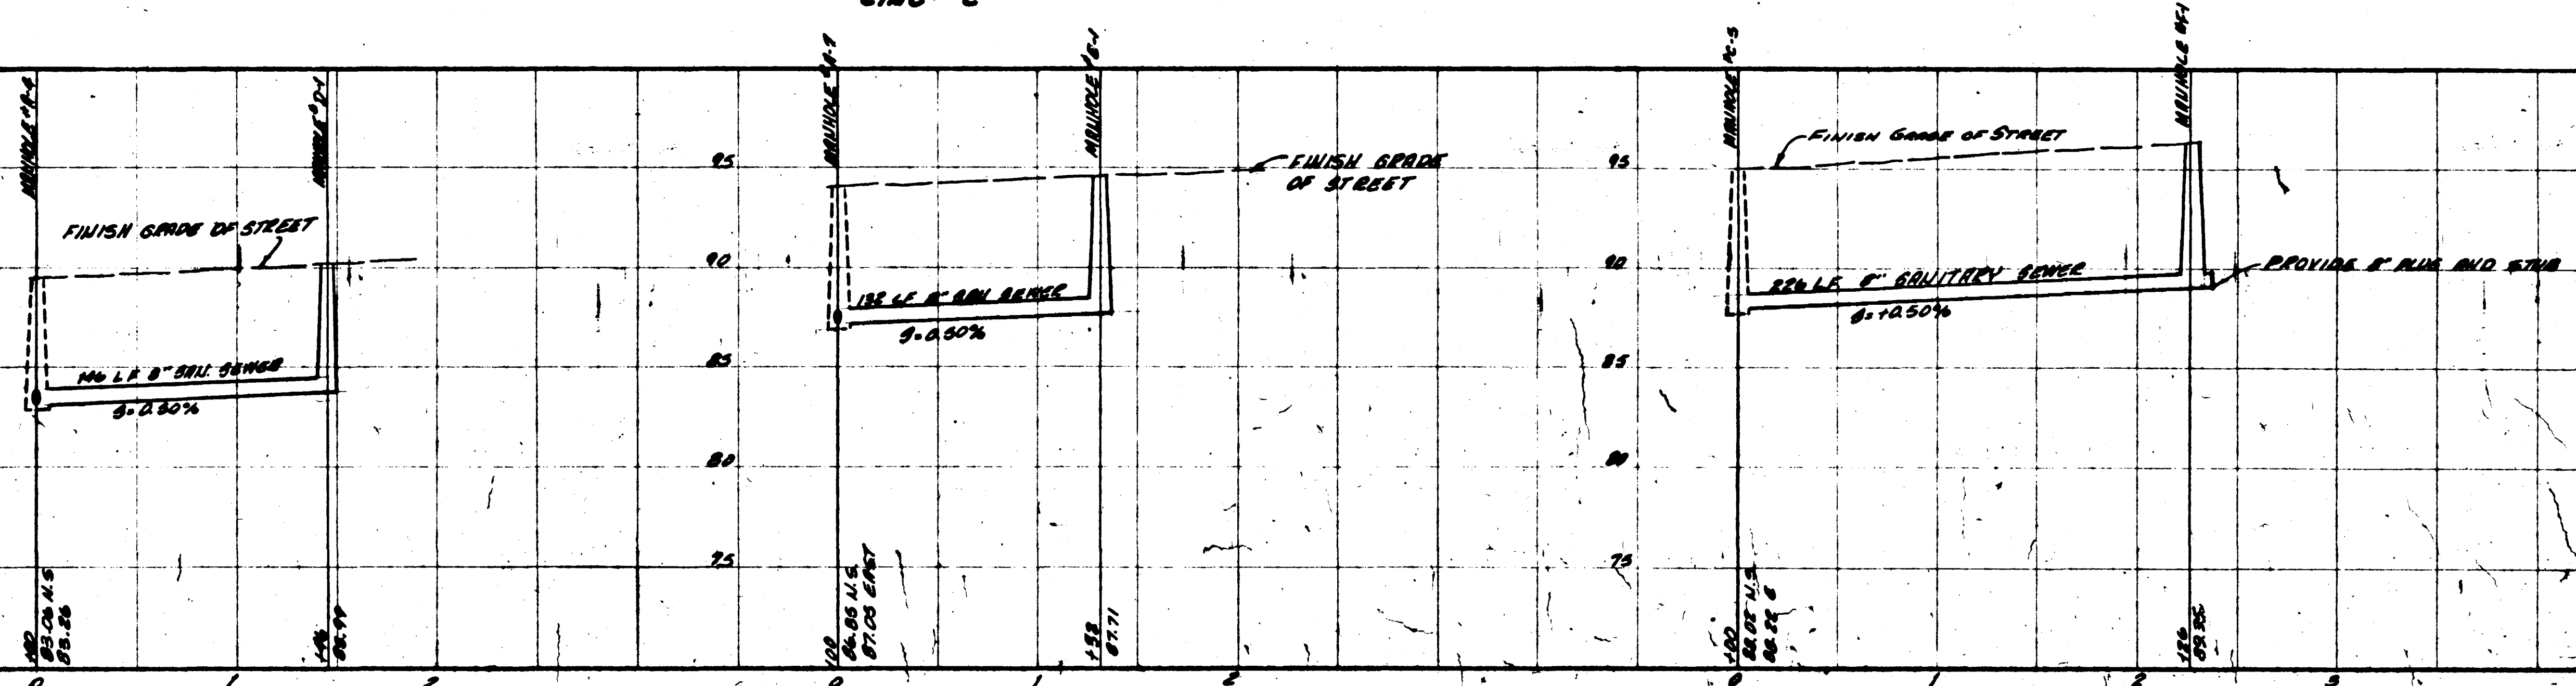

LINE D

LINE E

LINE F



AS BUILT DRAWINGS
12-27-77

OX-BOW SUBDIVISION FRMS NO. THREE
 MESA COUNTY, COLORADO
 SHEET NO. 3
 OF 3
 DATE: MARCH 1977
 SCALE: 1" = 30' HORIZ.
 1" = 4' VERT.
 ROBERT P. GERLOFS
 Engineering Consultant
 P.O. BOX 3872 • GRAND JUNCTION, COLORADO • 81501 • PHONE 843-8966