


EXIST. MH # 217  
 STA 23+05 WEST  
 H. ELEV (N) 4604.46  
 F. ELEV (N) 4605.11  
 R.I.A. ELEV 4611.19

**STANDARD MANHOLE**

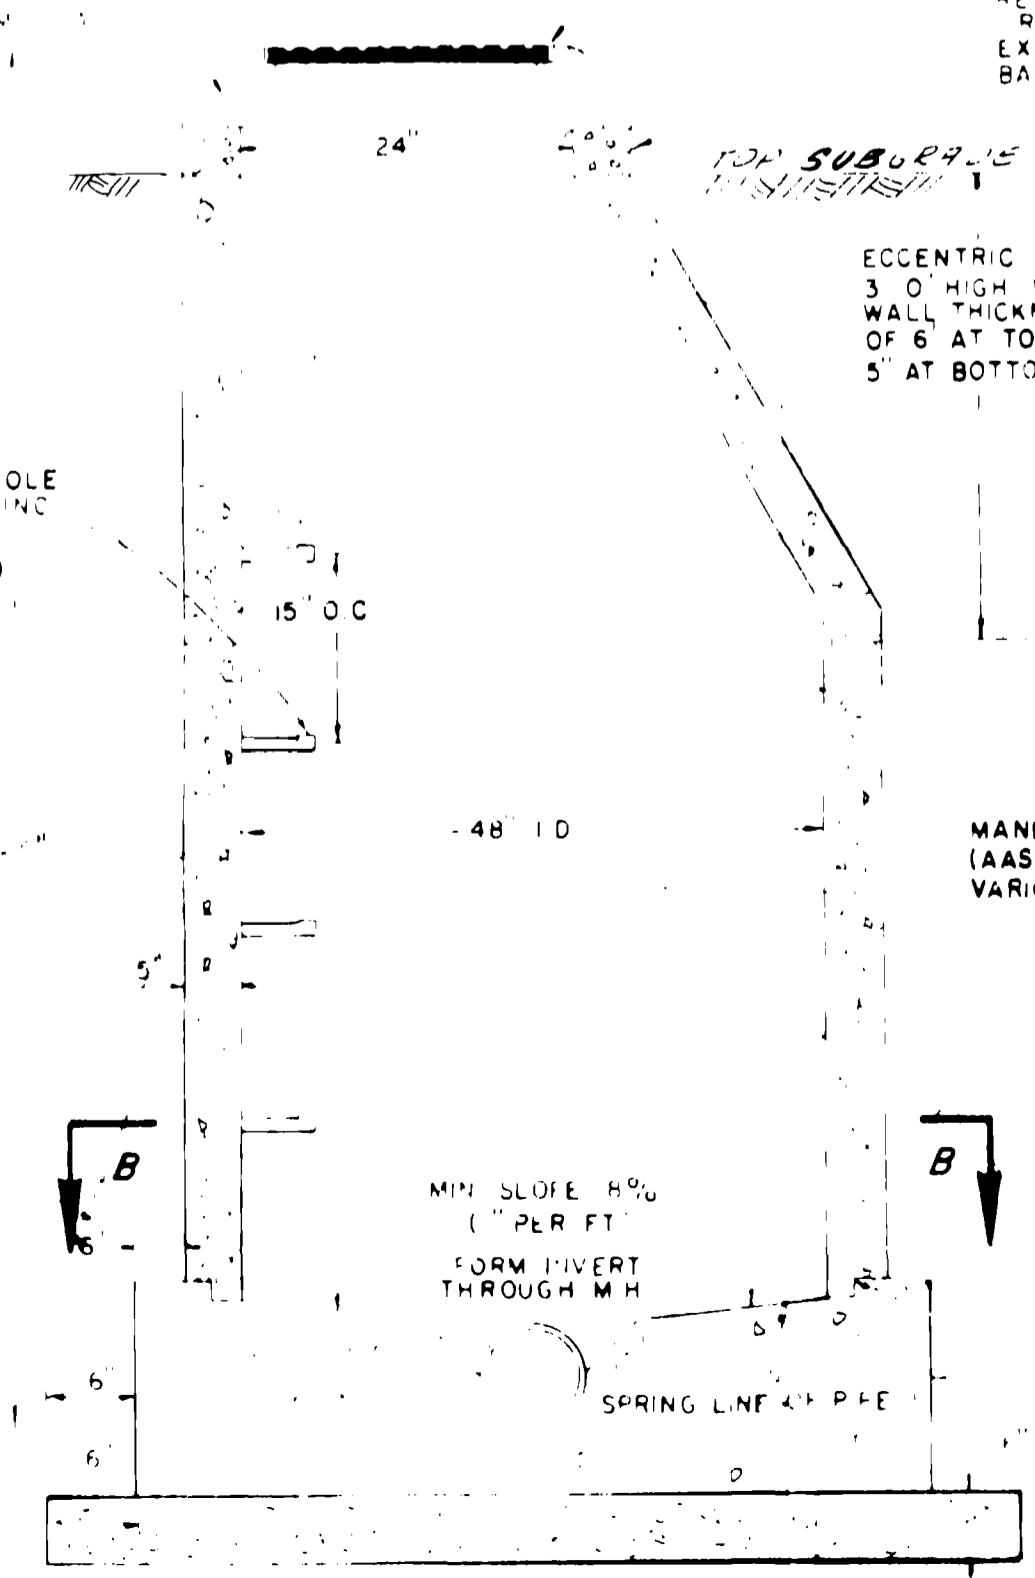

*Quantities*  
 295 L.F. 8\"/>

**GENERAL NOTES**

1. All construction to be done in accordance with the specifications of the Fruitvale Sanitation District.
2. Top of Eccentric Cone to be set at top of subgrade. (Street contractor to set 2\"/>

APPROVED:  
 FRUITVALE SANITATION DIST.  
 DATE: \_\_\_\_\_

**AS BUILT DRAWINGS**  
 12-27-77

ROBERT P. GERLOFS  
 Engineering Consultant

SANITARY SEWER  
 PLAN, PROFILES & DETAILS

REVISIONS BY: PAV SUBDIVISION  
 CITY OF GRAND JUNCTION, COLORADO

SHEET  
 1  
 OF ONE