


NOTE:
 1. ALL CONSTRUCTION TO BE DONE IN ACCORDANCE WITH THE CITY OF GRAND JUNCTION SPECIFICATIONS.
 2. 4" SERVICE CONNECTIONS TO BE LOCATED AT TIME OF CONSTRUCTION.

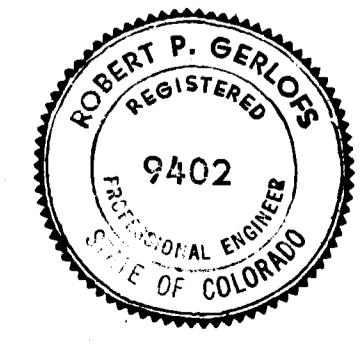

AS BUILT DRAWINGS
 1/9/78