


REVISIONS/	BY






PARAGON ENGINEERING, INC.  




SUNRISE GARDENS SUBDIVISION  
 MESACOUNTY, COLORADO  
 WATER & SEWER PLANS & DETAILS

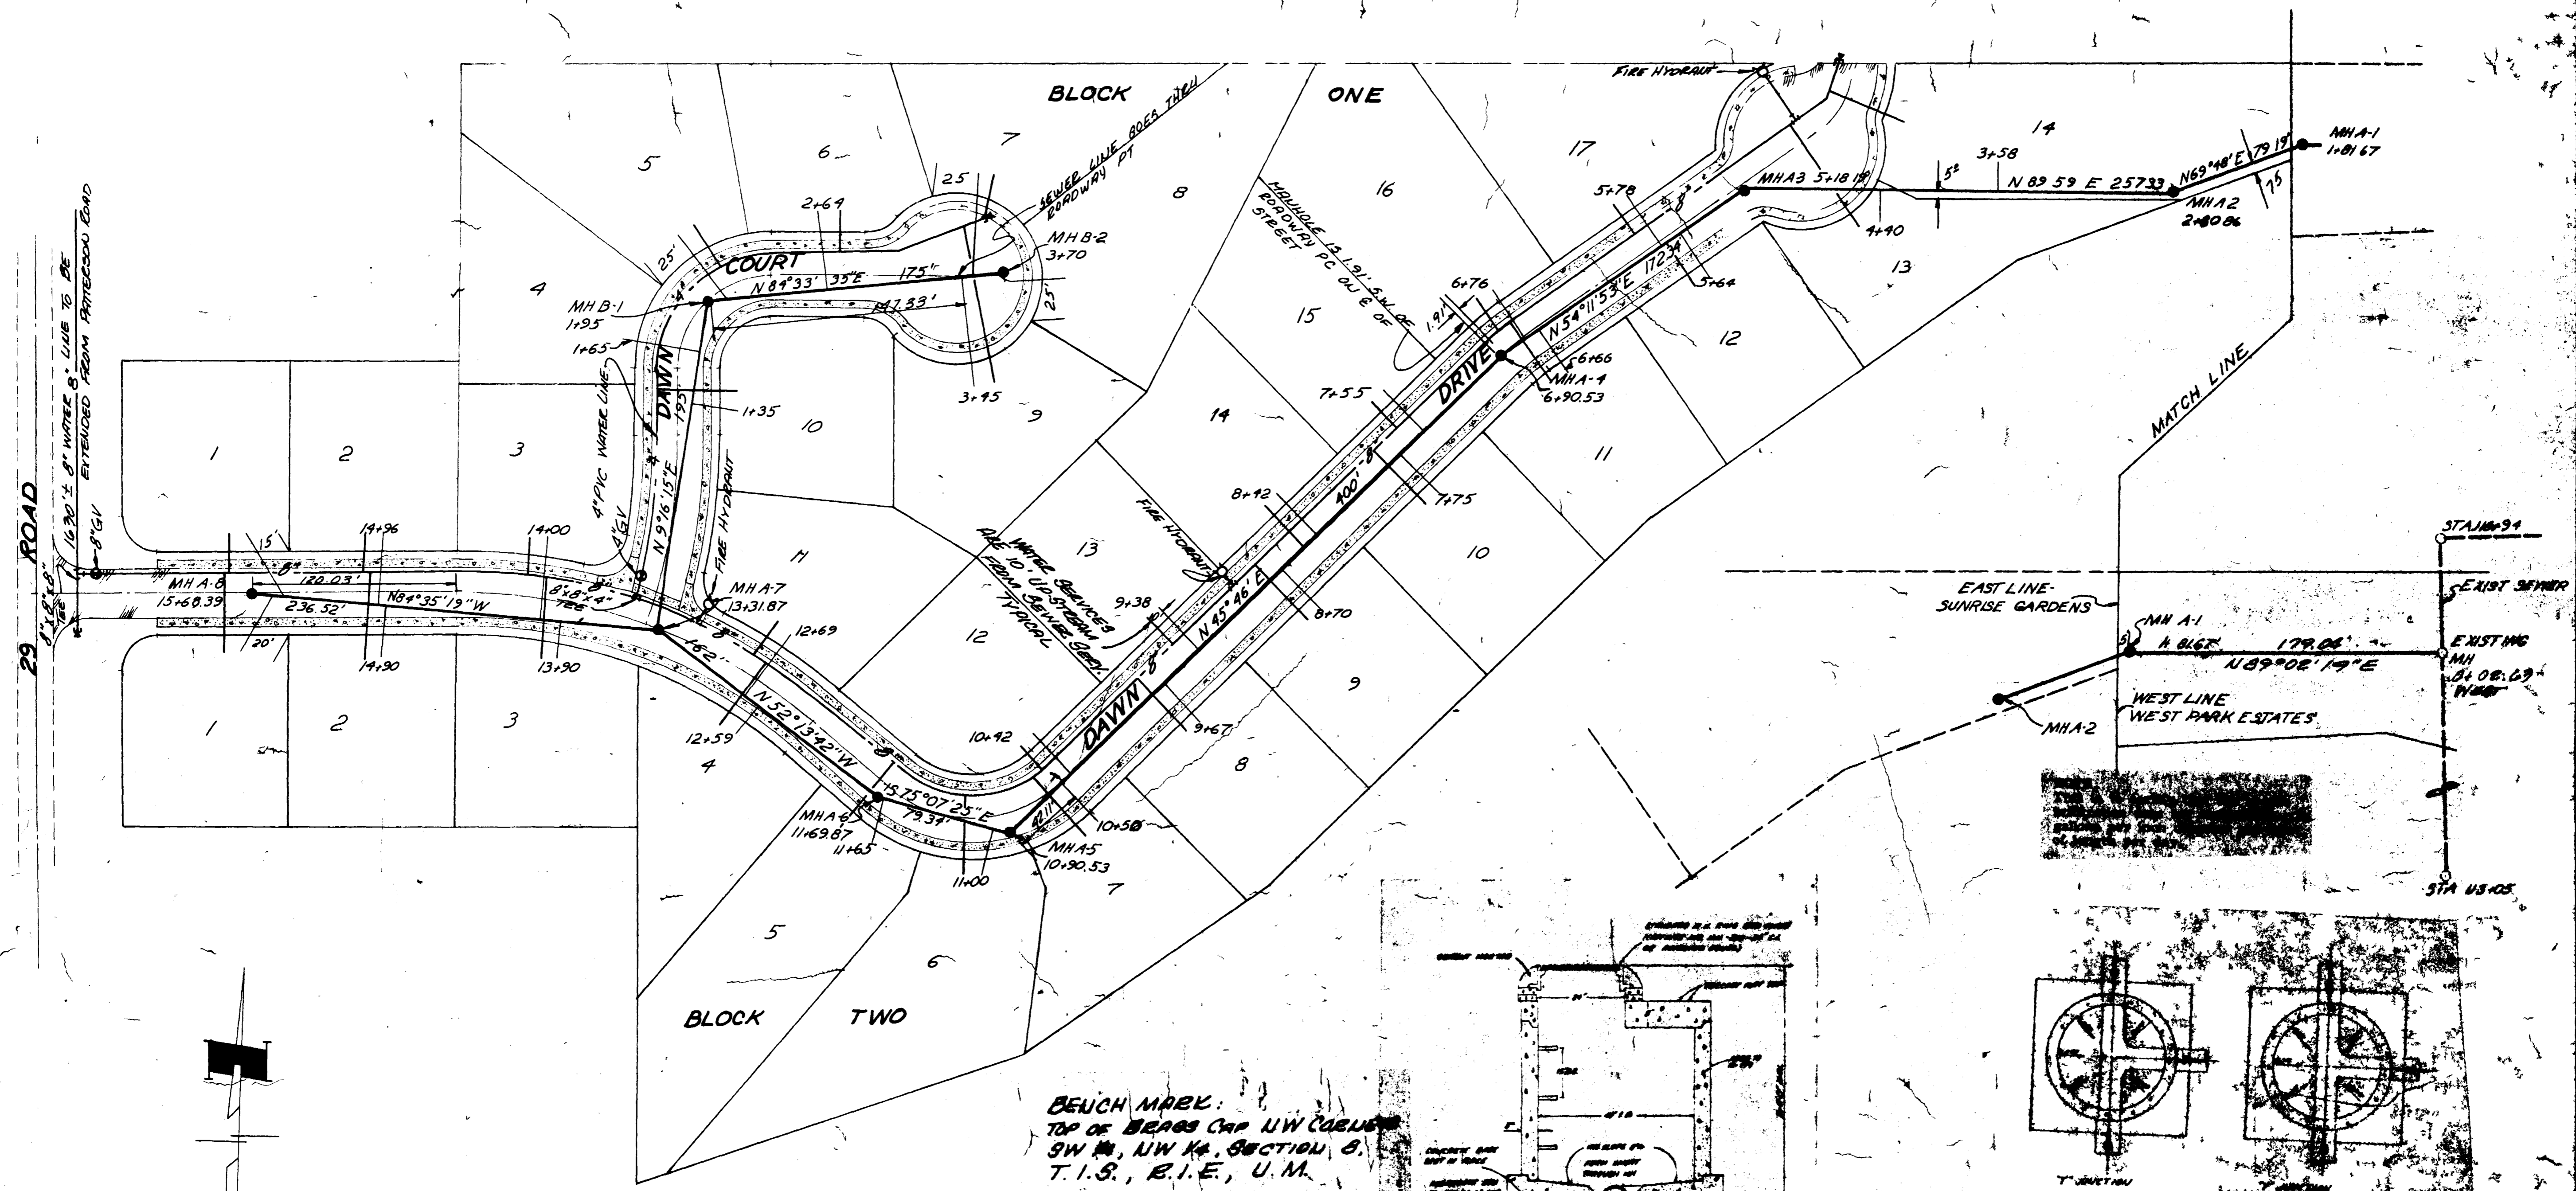

BENCH MARK:  
 TOP OF BEARS CAP, NW CORNER  
 SW 1/4, NW 1/4, SECTION 8,  
 T.1.S., R.1.E., U.M.  
 ELEV. = 4670.89

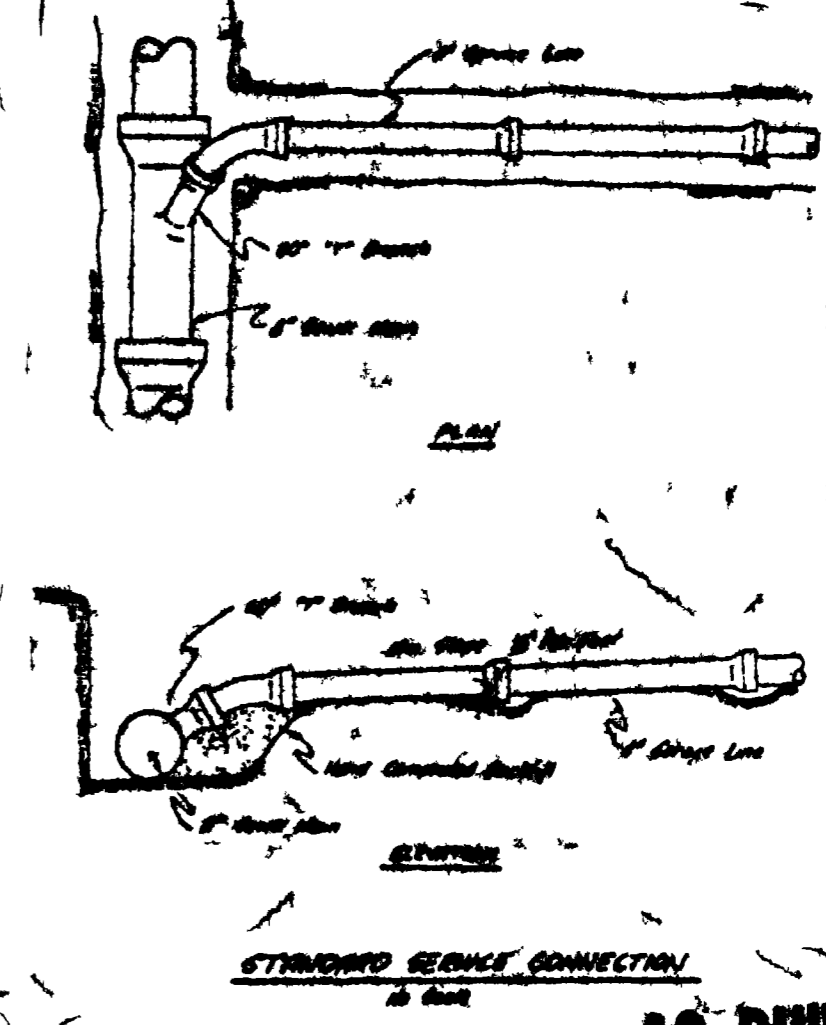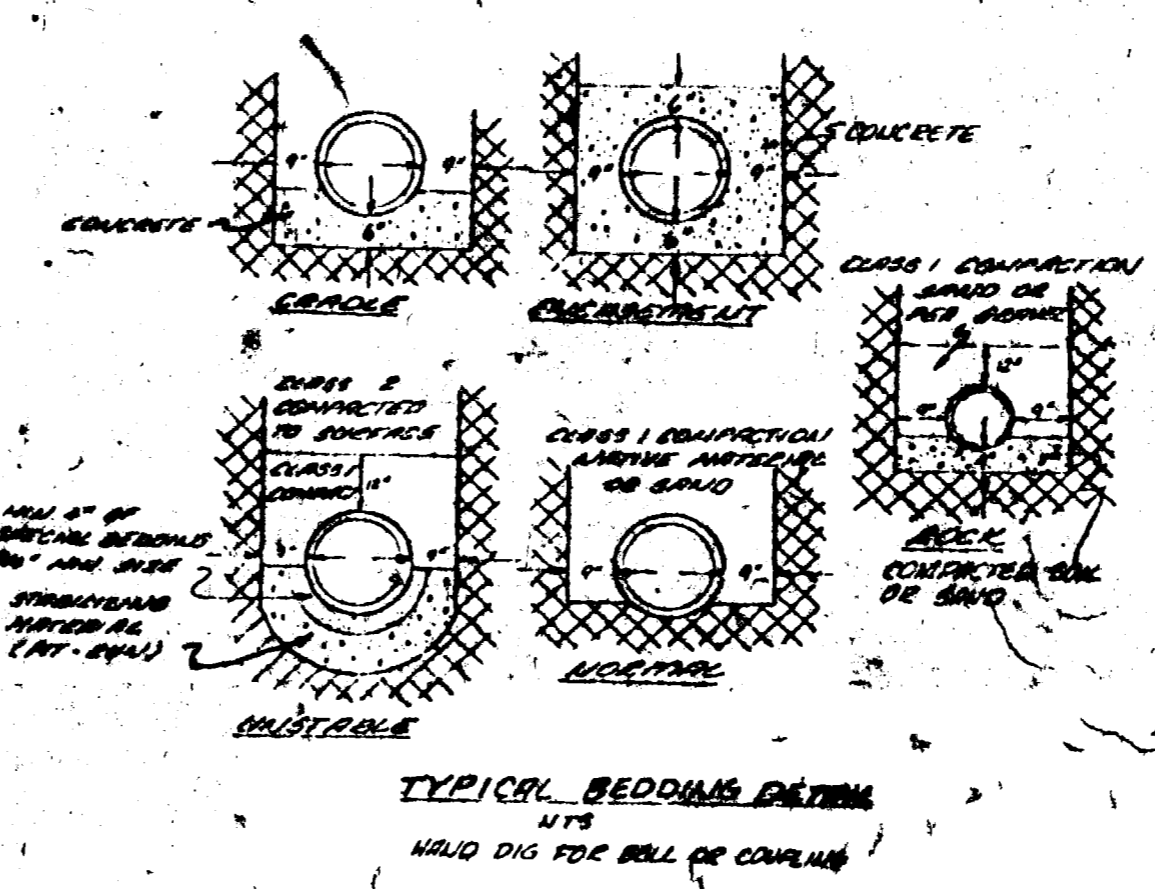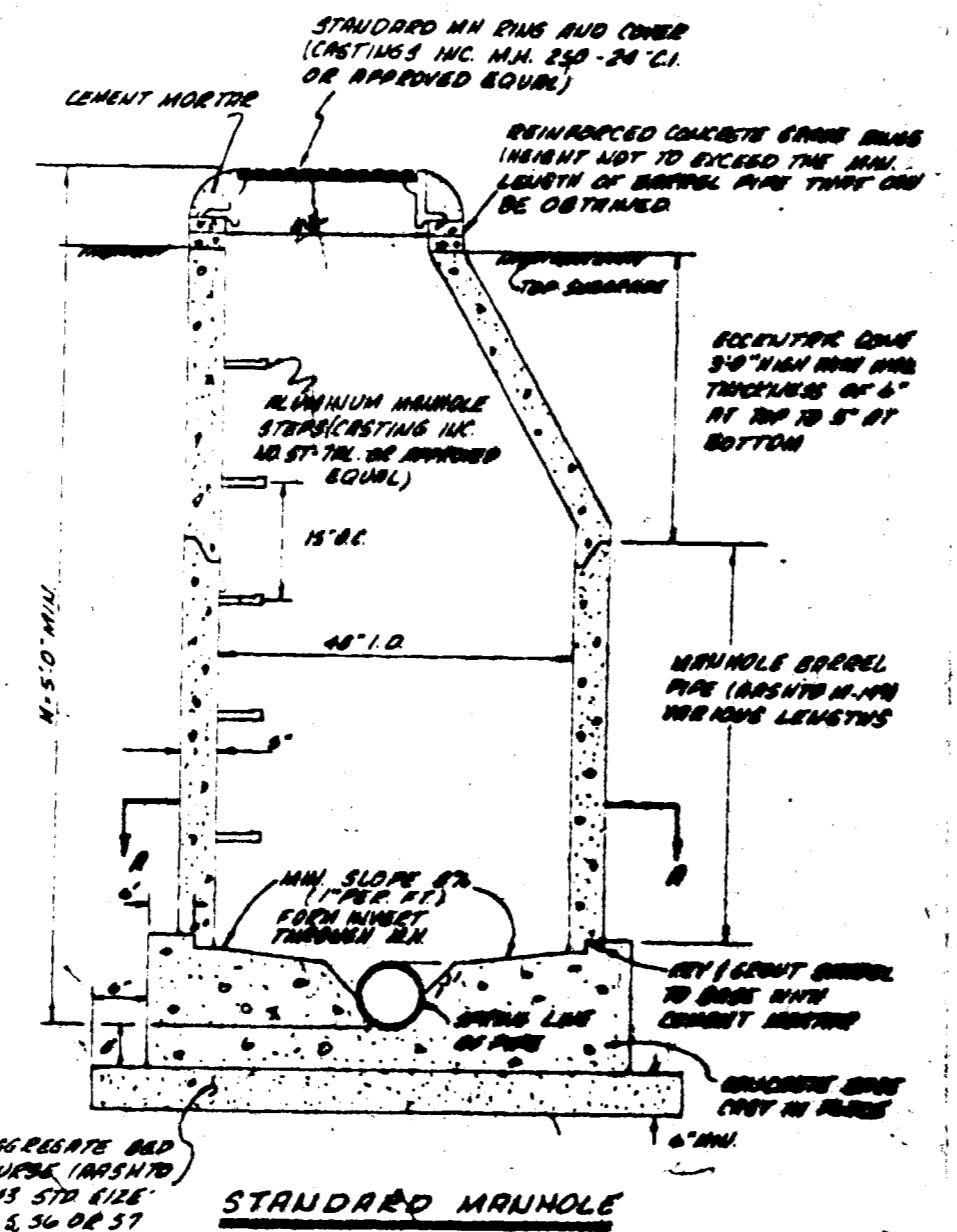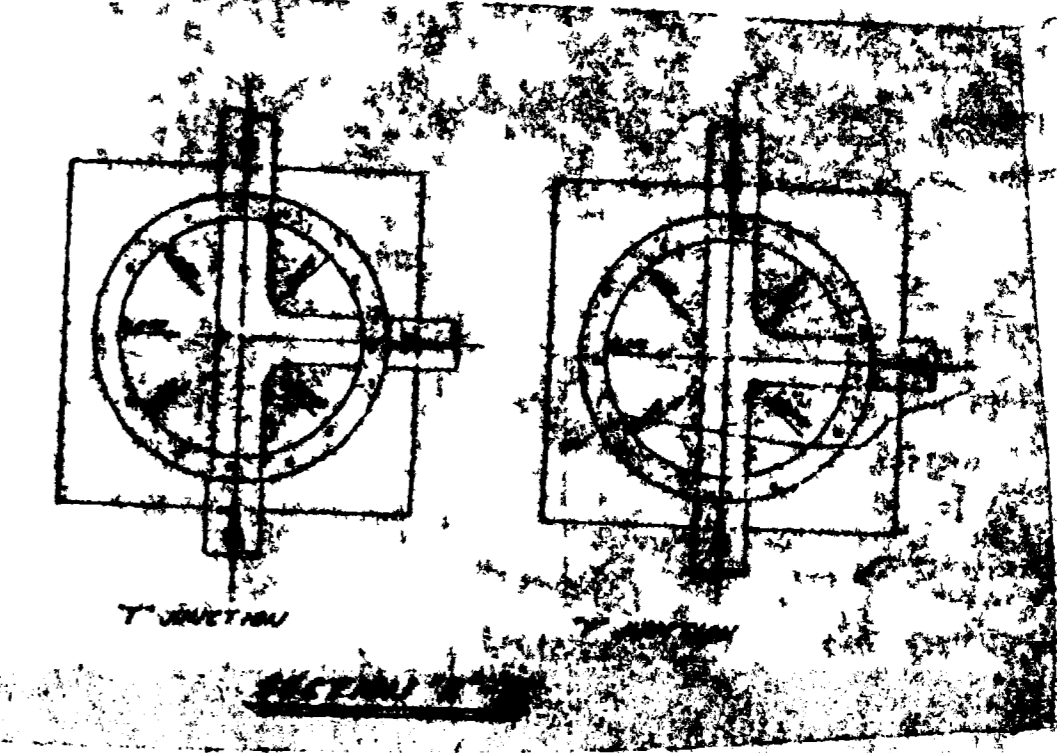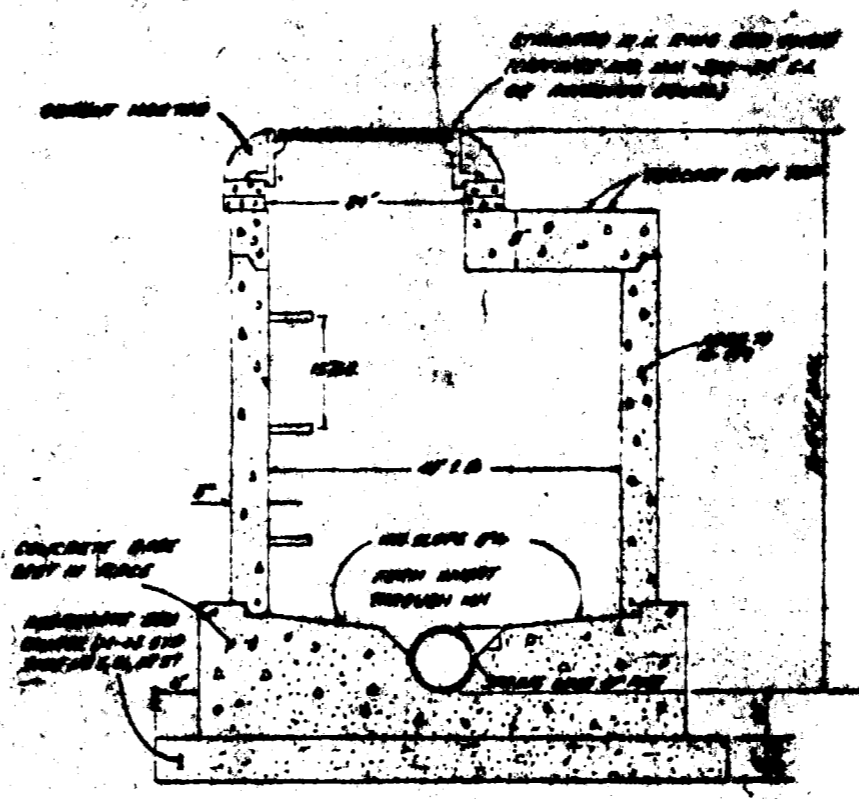

AS BUILT DRAWINGS

SCALE: 1"=50'

- NOTES:
- TOP OF ECCENTRIC CONE TO BE SET TO TOP OF SUBGRADE (STREET CONTRACTOR TO SET RIMS TO FINISH GRADE OF STREET)
  - ALL CONSTRUCTION TO BE DONE IN ACCORDANCE WITH THE CENTRAL GRAND VALLEY SANITATION DISTRICT SPECIFICATIONS.


QUANTITIES: SEWER  
 1339.76 LF 8" SAN SEWER  
 31-SERVICE CONNECTIONS  
 7-STANDARD MANHOLES  
 7-SHALLOW MANHOLES

QUANTITIES: WATER  
 2896 - 8" AC WATER MAIN  
 265' - 4" PVC WATER MAIN  
 31 - SERVICE CONNECTIONS  
 7 - FIRE HYDRANTS W/6" GATE VALVES


CHECKED  
 NAME: N. L. LEE  
 DATE  
 FEBRUARY, 1979  
 HOURS: SCALE: V.O.B.  
 1"=50' 1"=50'

REVISIONS	BY


PARAGON ENGINEERING, INC.  
 P.O. Box 287  
 MESA, ARIZONA 85201 (505) 441-8800




SUNNYSIDE GARDENS SUB.  
 MESA COUNTY, COLORADO  
 SALUTARY SEWER PROFILES

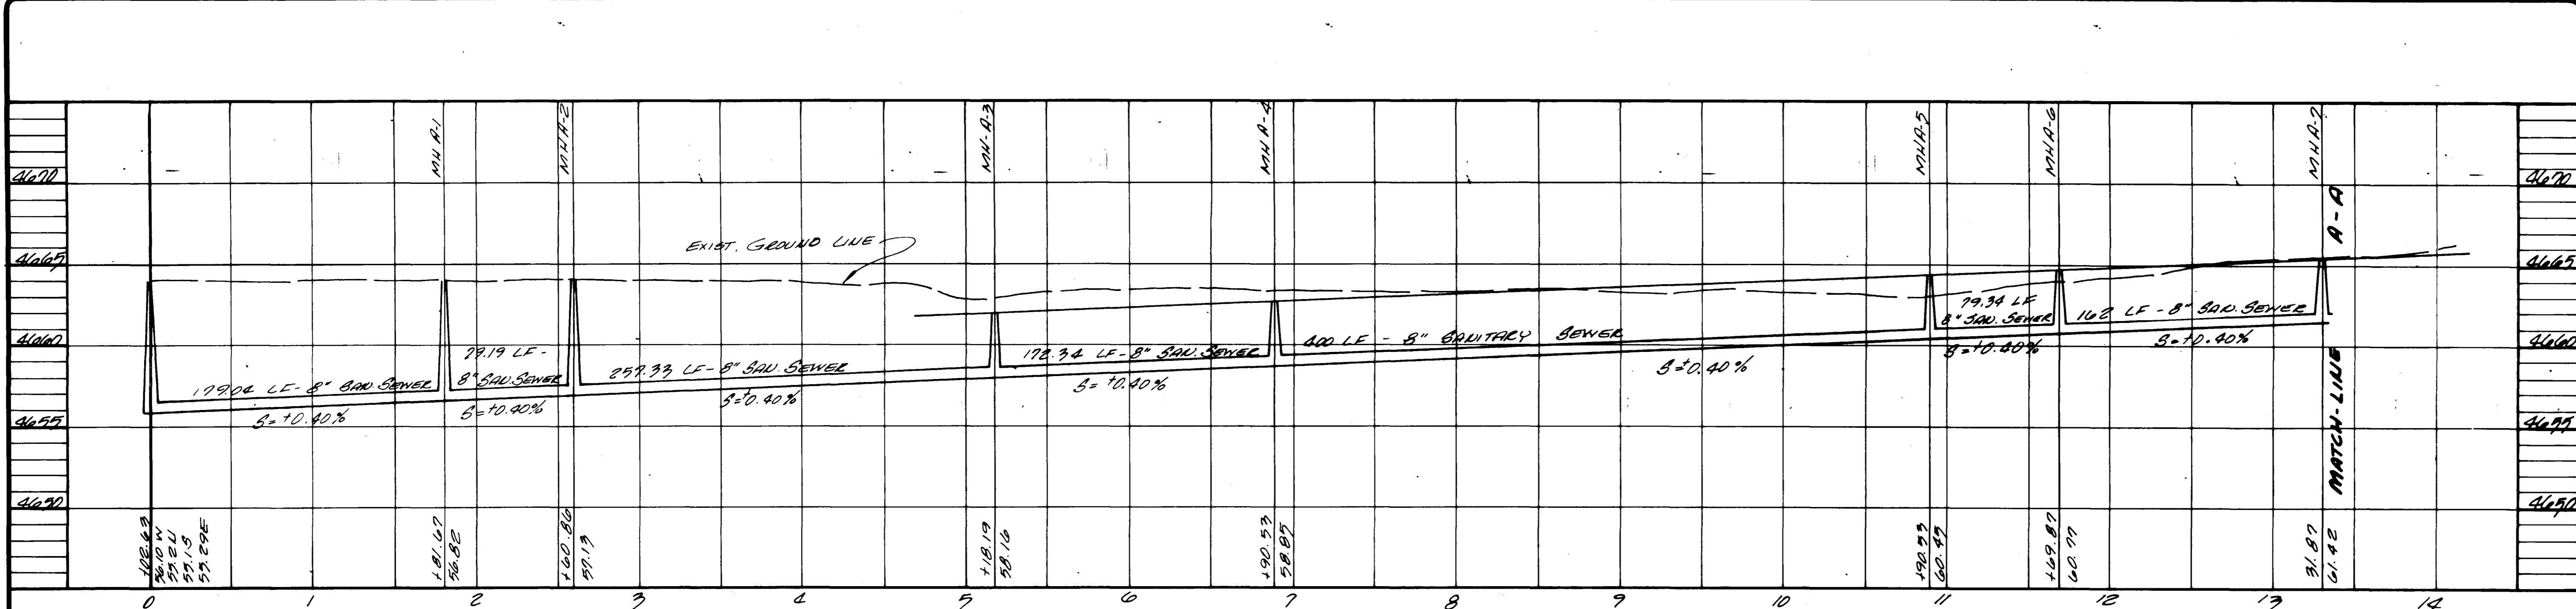

DAWN DRIVE

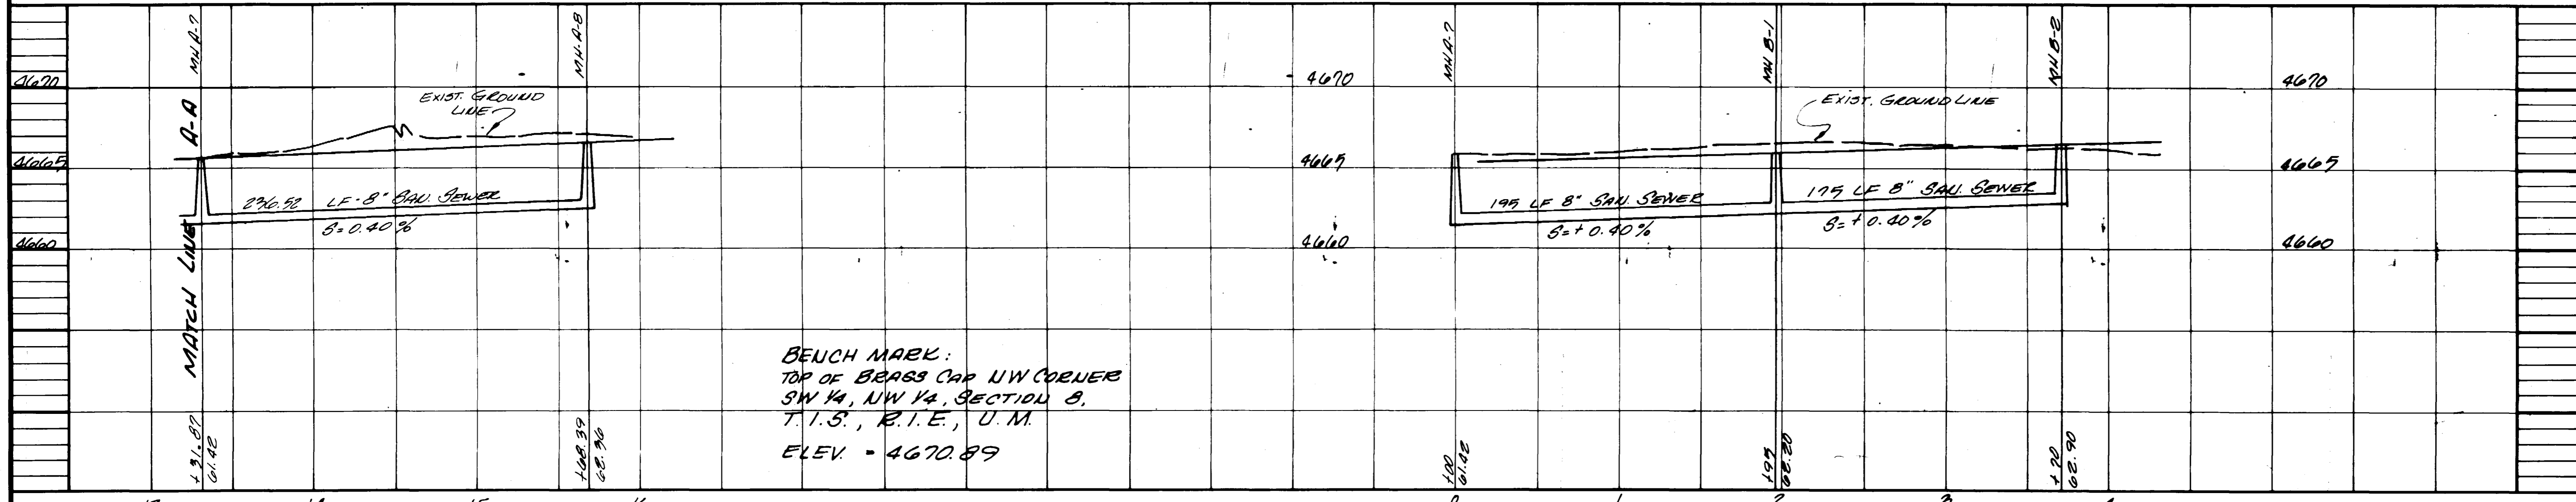

DAWN DRIVE (CONT.)

DAWN COURT

AS BUILT DRAWINGS

SHEET  
 2  
 OF 3 SHEETS