



| REVISIONS | BY |
|-----------|----|
| | |
| | |
| | |
| | |

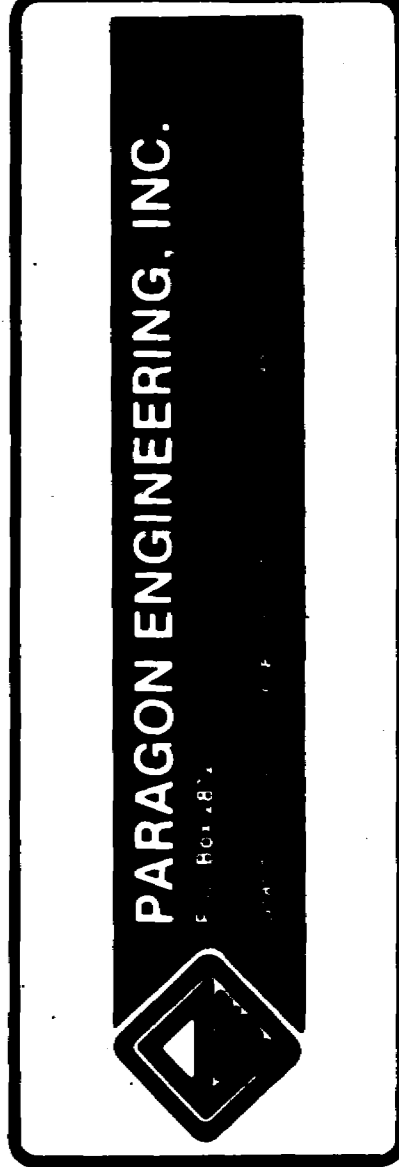

SANITARY SEWER PLAN & PROFILE
FRUITWOOD BYPASS
CENTRAL GRAND VALLEY SEWER DISTRICT

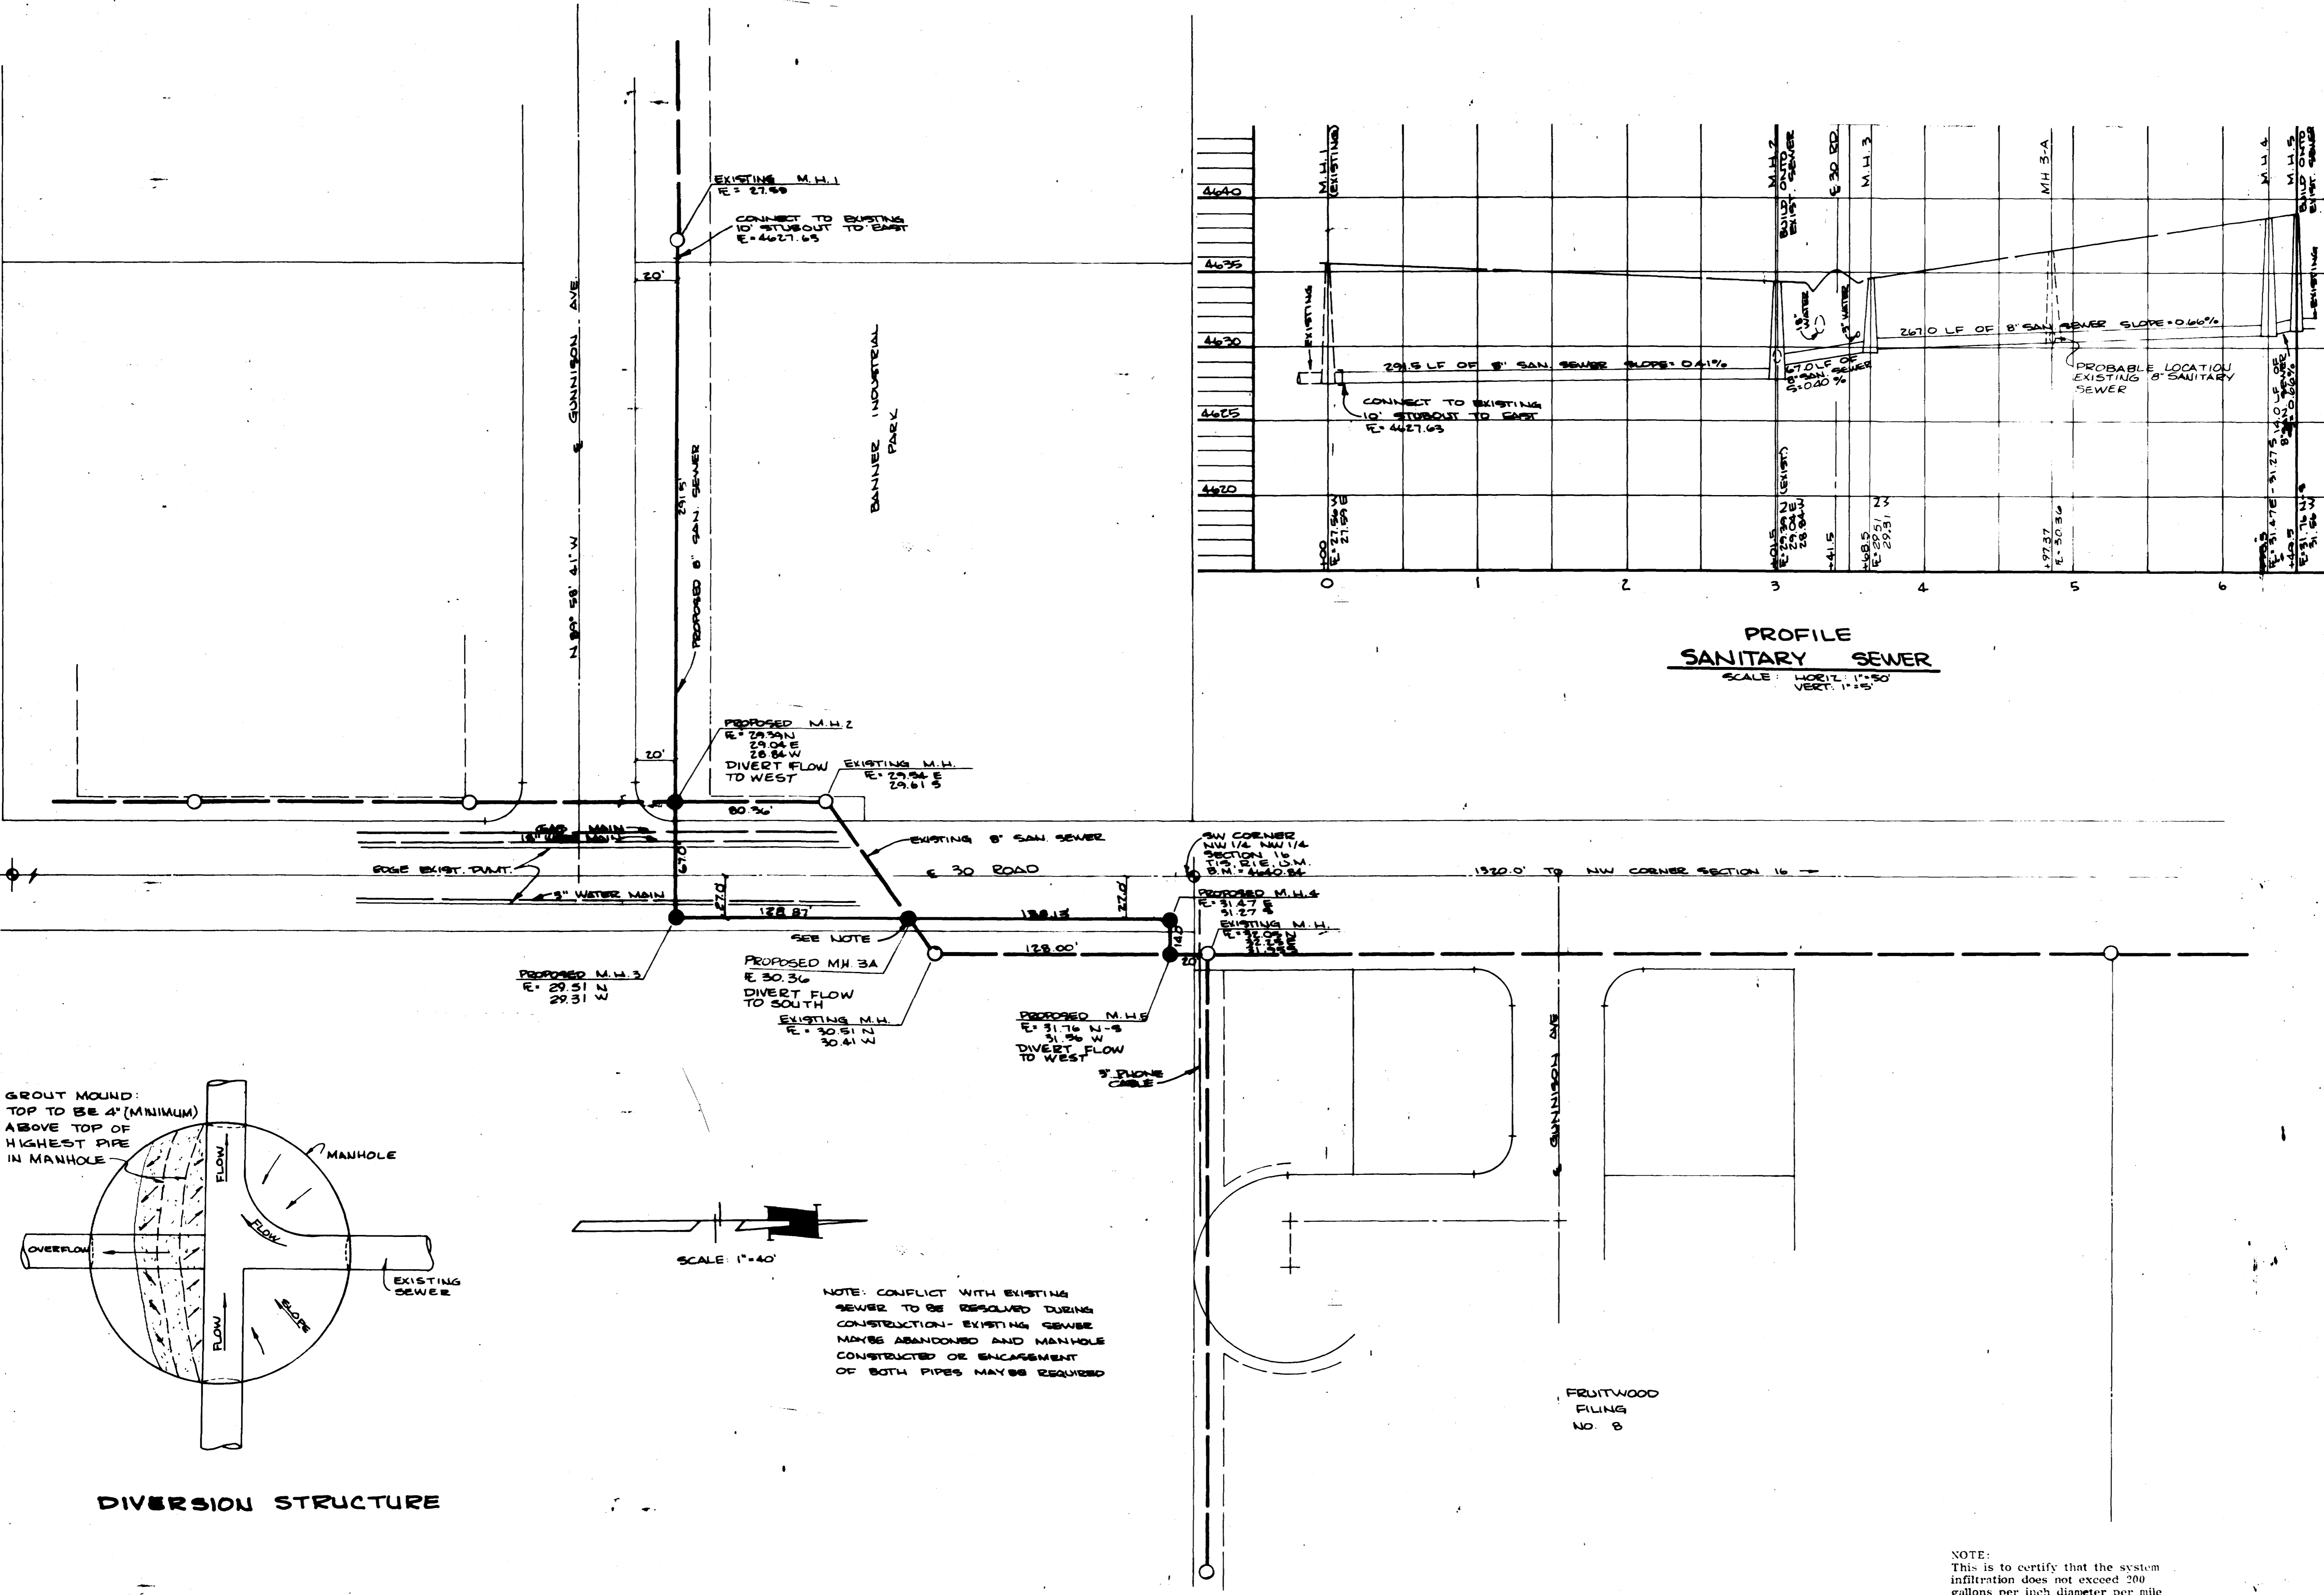

AS BUILT DRAWINGS