
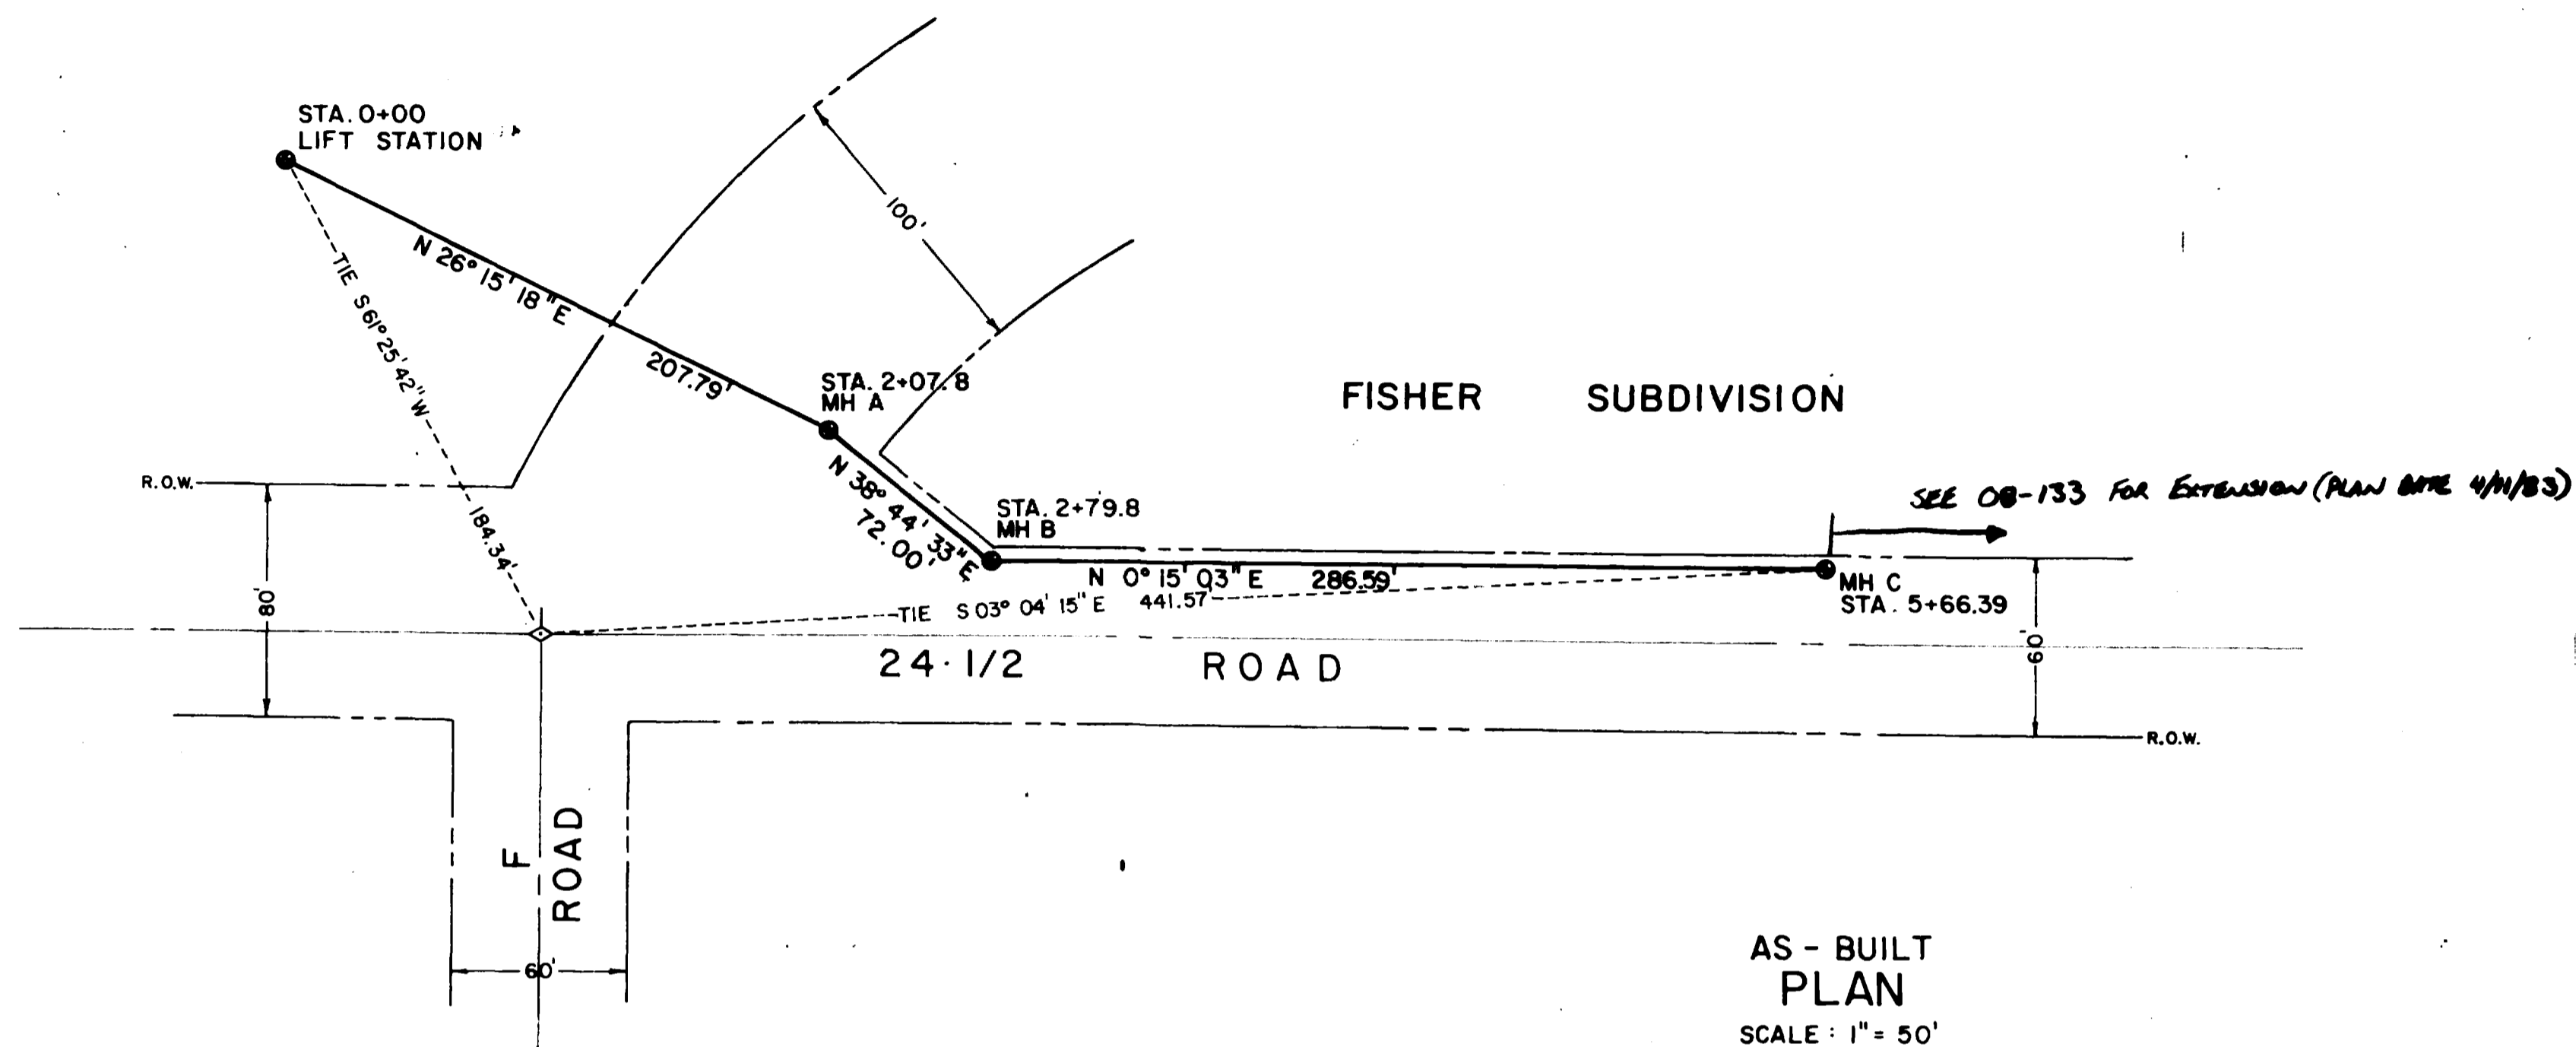


MESA MALL
SHOPPING CENTER

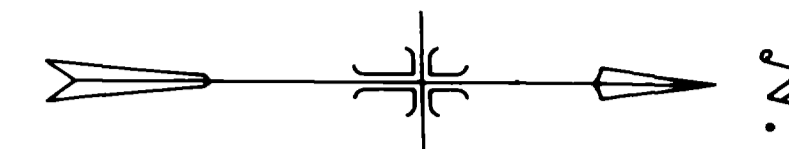

AS - BUILT
PLAN
SCALE: 1" = 50'

INFILTRATION DOES NOT EXCEED 200
GALLONS PER INCH DIAMETER PER
MILE PER DAY.


REVISED 11/27/81
AS-BUILT 5/20/81

WESTERN ENGINEERS INC.

FISHER SUBDIVISION
SANITARY SEWER

MESA COUNTY, COLORADO

ENGINEER: FLW DRAWN: DLH CHECKED: FLW
GRAND JUNCTION, COLO. DWG. 2154-965-2

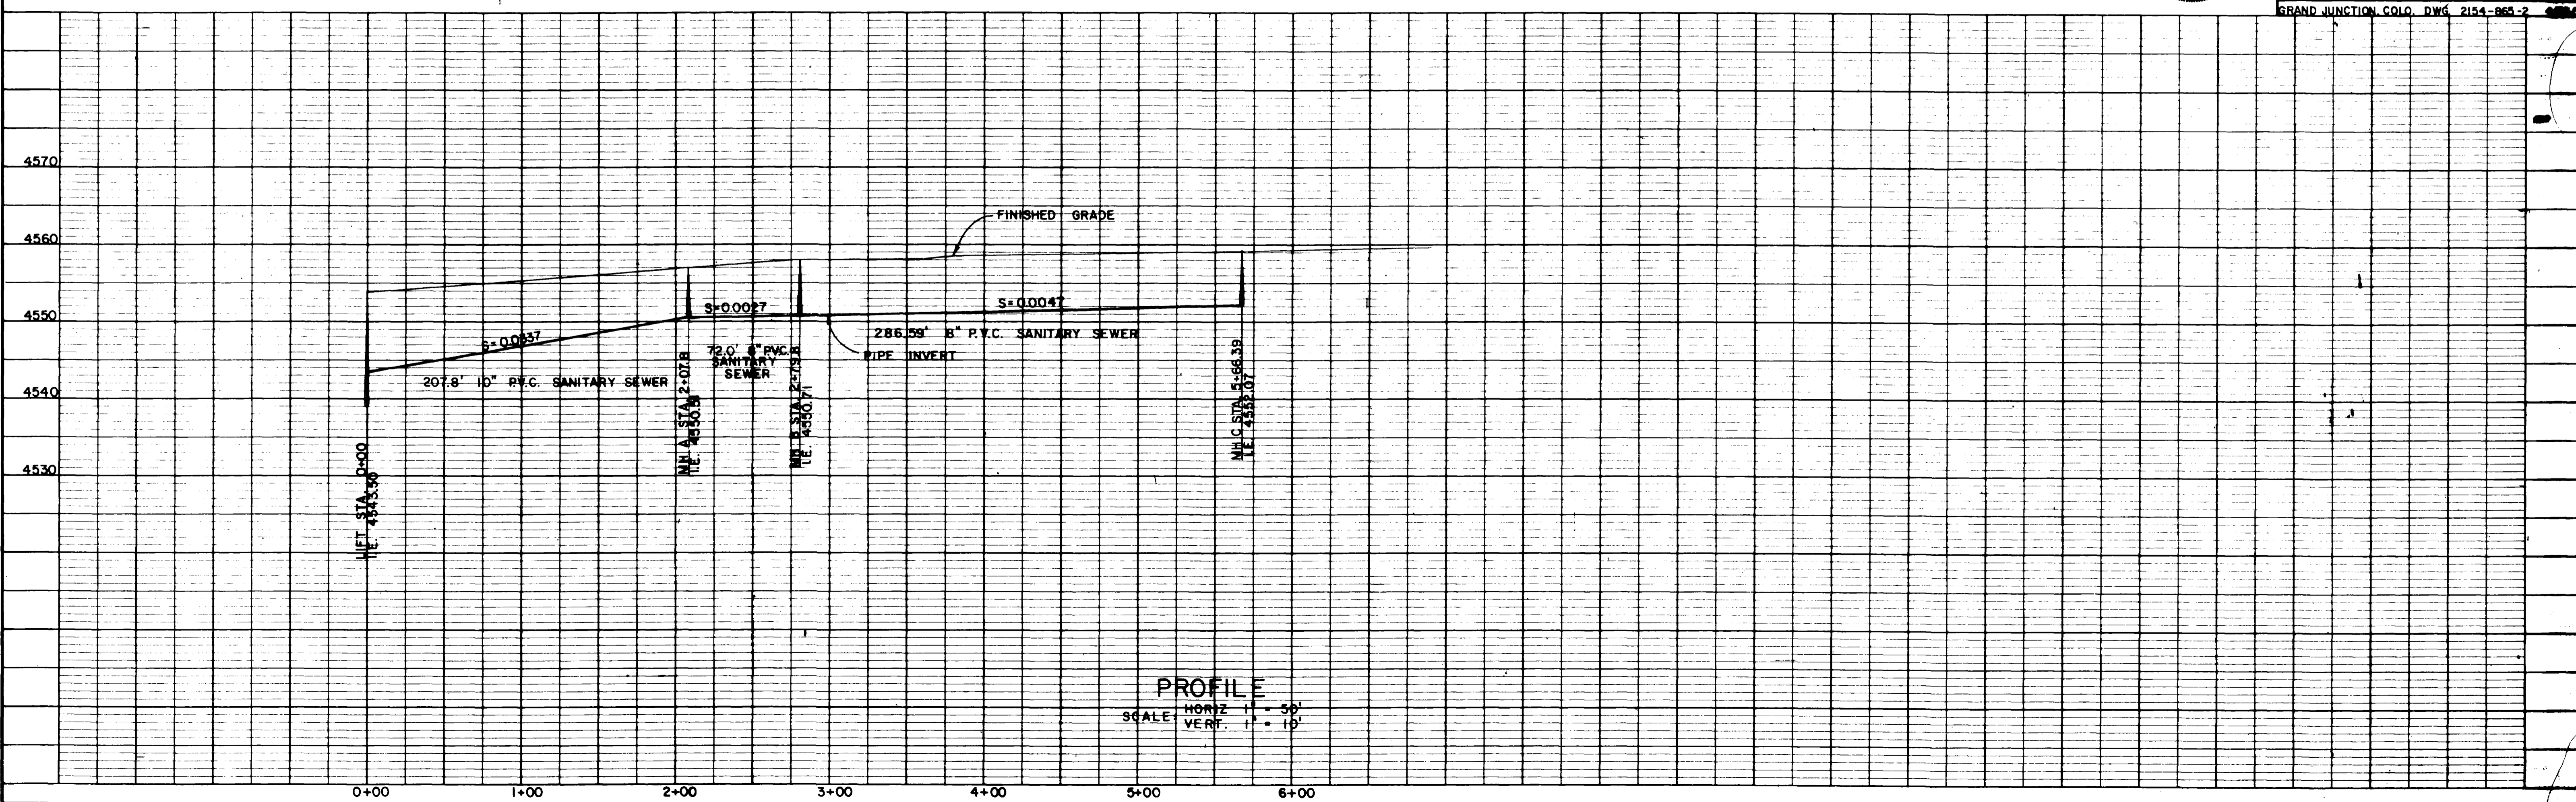

PROFILE
SCALE: HORIZ. 1" = 50'
VERT. 1" = 10'