
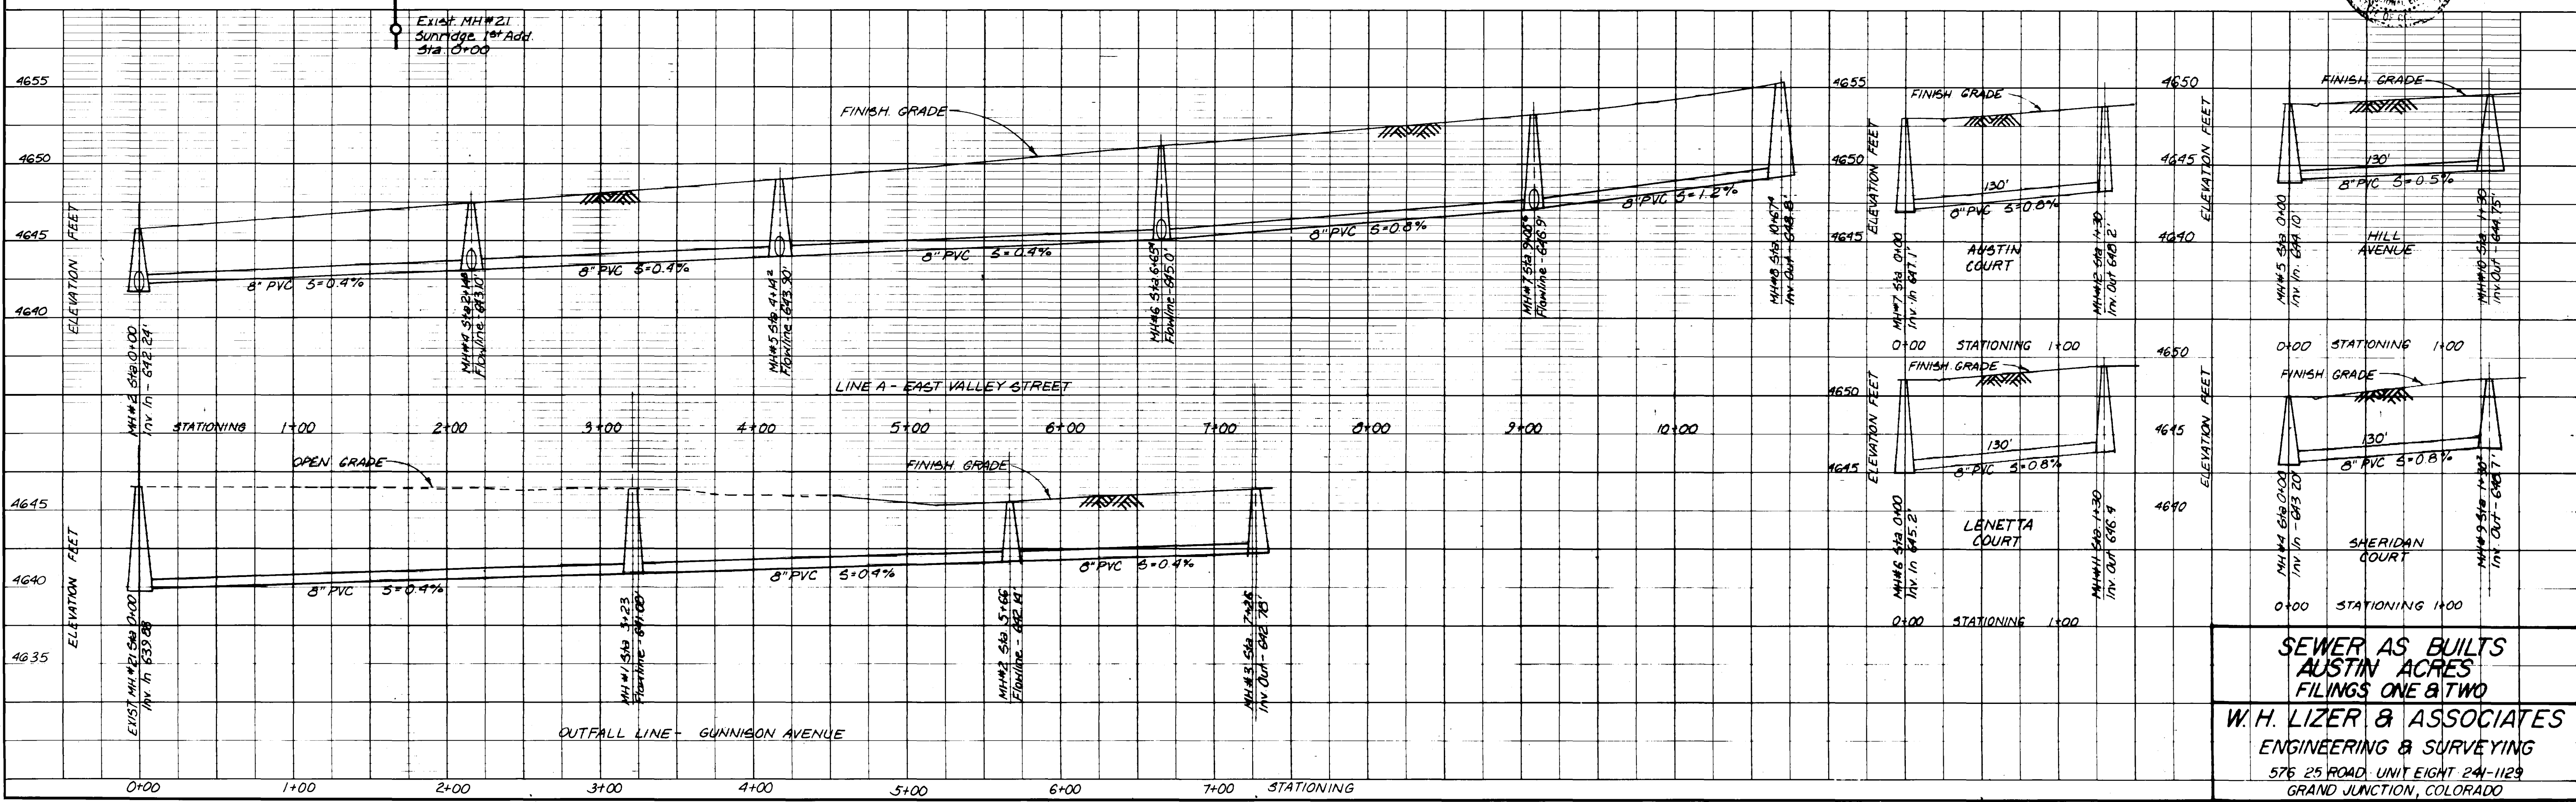


SCALE:  
Vertical - 1" = 5'  
Horizontal - 1" = 50'

GENERAL NOTES:  
This subdivision is served by Central Grand Valley Sanitation District.  
This is to certify that the system infiltration does not exceed 200 gallons per inch diameter per mile of length per day.

Bench Elev. 4659.67  
NE Cor. NW 1/4 NE 1/4 Sec 16, T13, R1E, U.M.

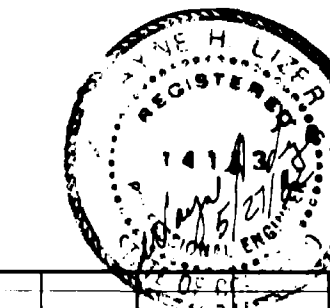

SEWER AS BUILT  
AUSTIN ACRES  
FILINGS ONE & TWO  
W. H. LIZER & ASSOCIATES  
ENGINEERING & SURVEYING  
576 25 ROAD, UNIT EIGHT 241-1129  
GRAND JUNCTION, COLORADO