
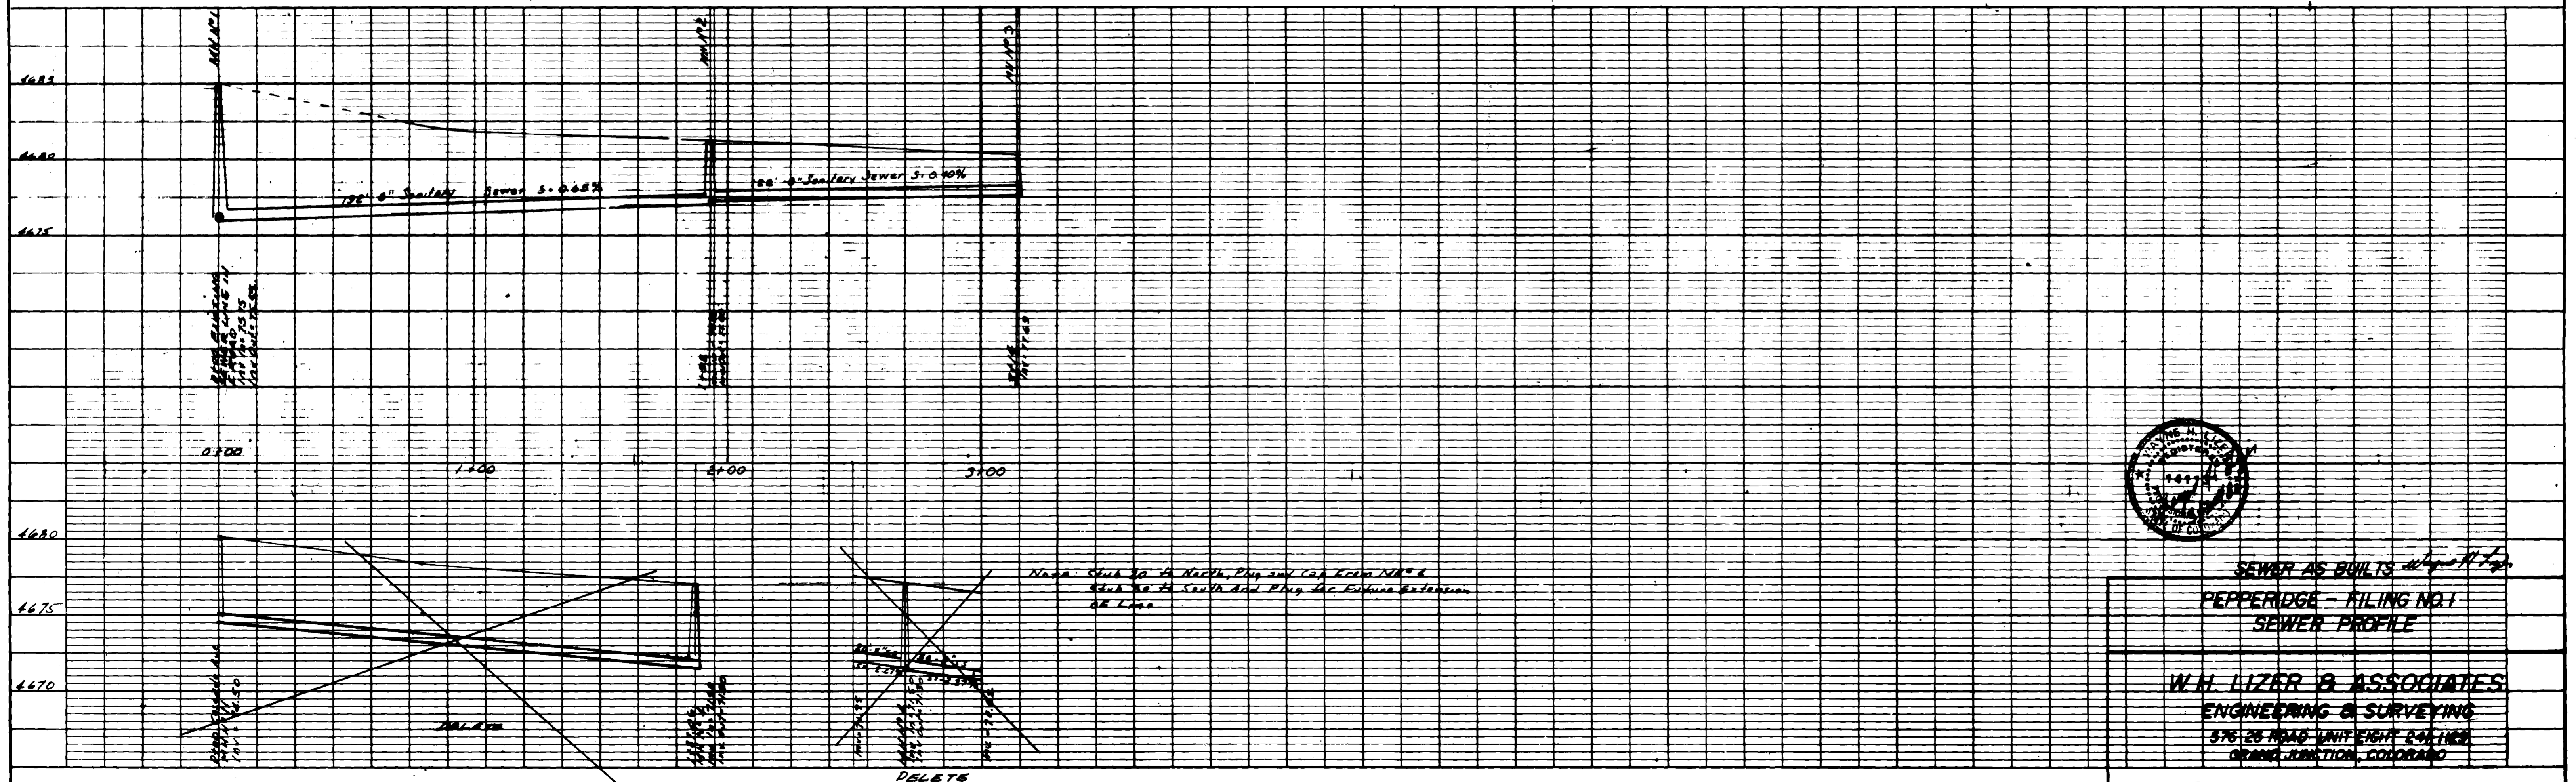
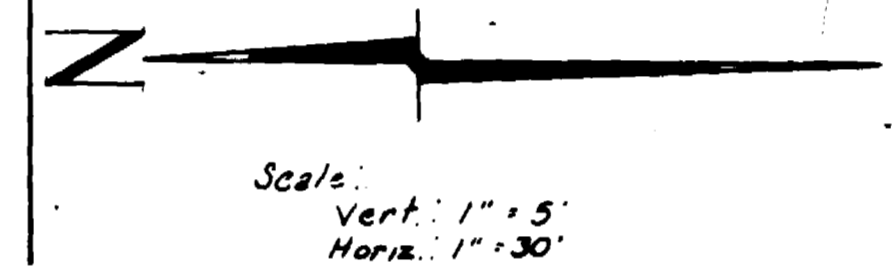


GENERAL NOTES

1. All Construction Shall Be In Accordance With City Of Grand Junction Standard Sanitary Sewer Details Drawing SS-1 And Shall Conform To City Of Grand Junction "Standard Specifications For Construction Of Waterlines, Sanitary Sewers, Storm Drainage And Irrigation Systems", 1901, And City Of Grand Junction General Contract Conditions For Public Works And Utilities Construction GC-3T, GC-50 And GC-65
 "The Contractor Shall Contact The City Utilities Superintendent, Mr. Ralph Sturry, (244-1560) Prior To Any Disturbance Of Existing Sanitary Sewers Including Ties, Ins And / Or Taps. Existing Sanitary Sewer Flows Shall Be Maintained At All Times."
2. This Subdivision Is Served By Central Grand Valley Sanitation District.
3. This Is To Certify That The System Infiltration Does Not Exceed 800 Gallons Per Inch Diameter Per Mile Of Length Per Day. Field Checked 4/4/02 *WHL*
4. SEWER SERVICES SHOWN HAVE BEEN COMPLETED TO BELOWS.

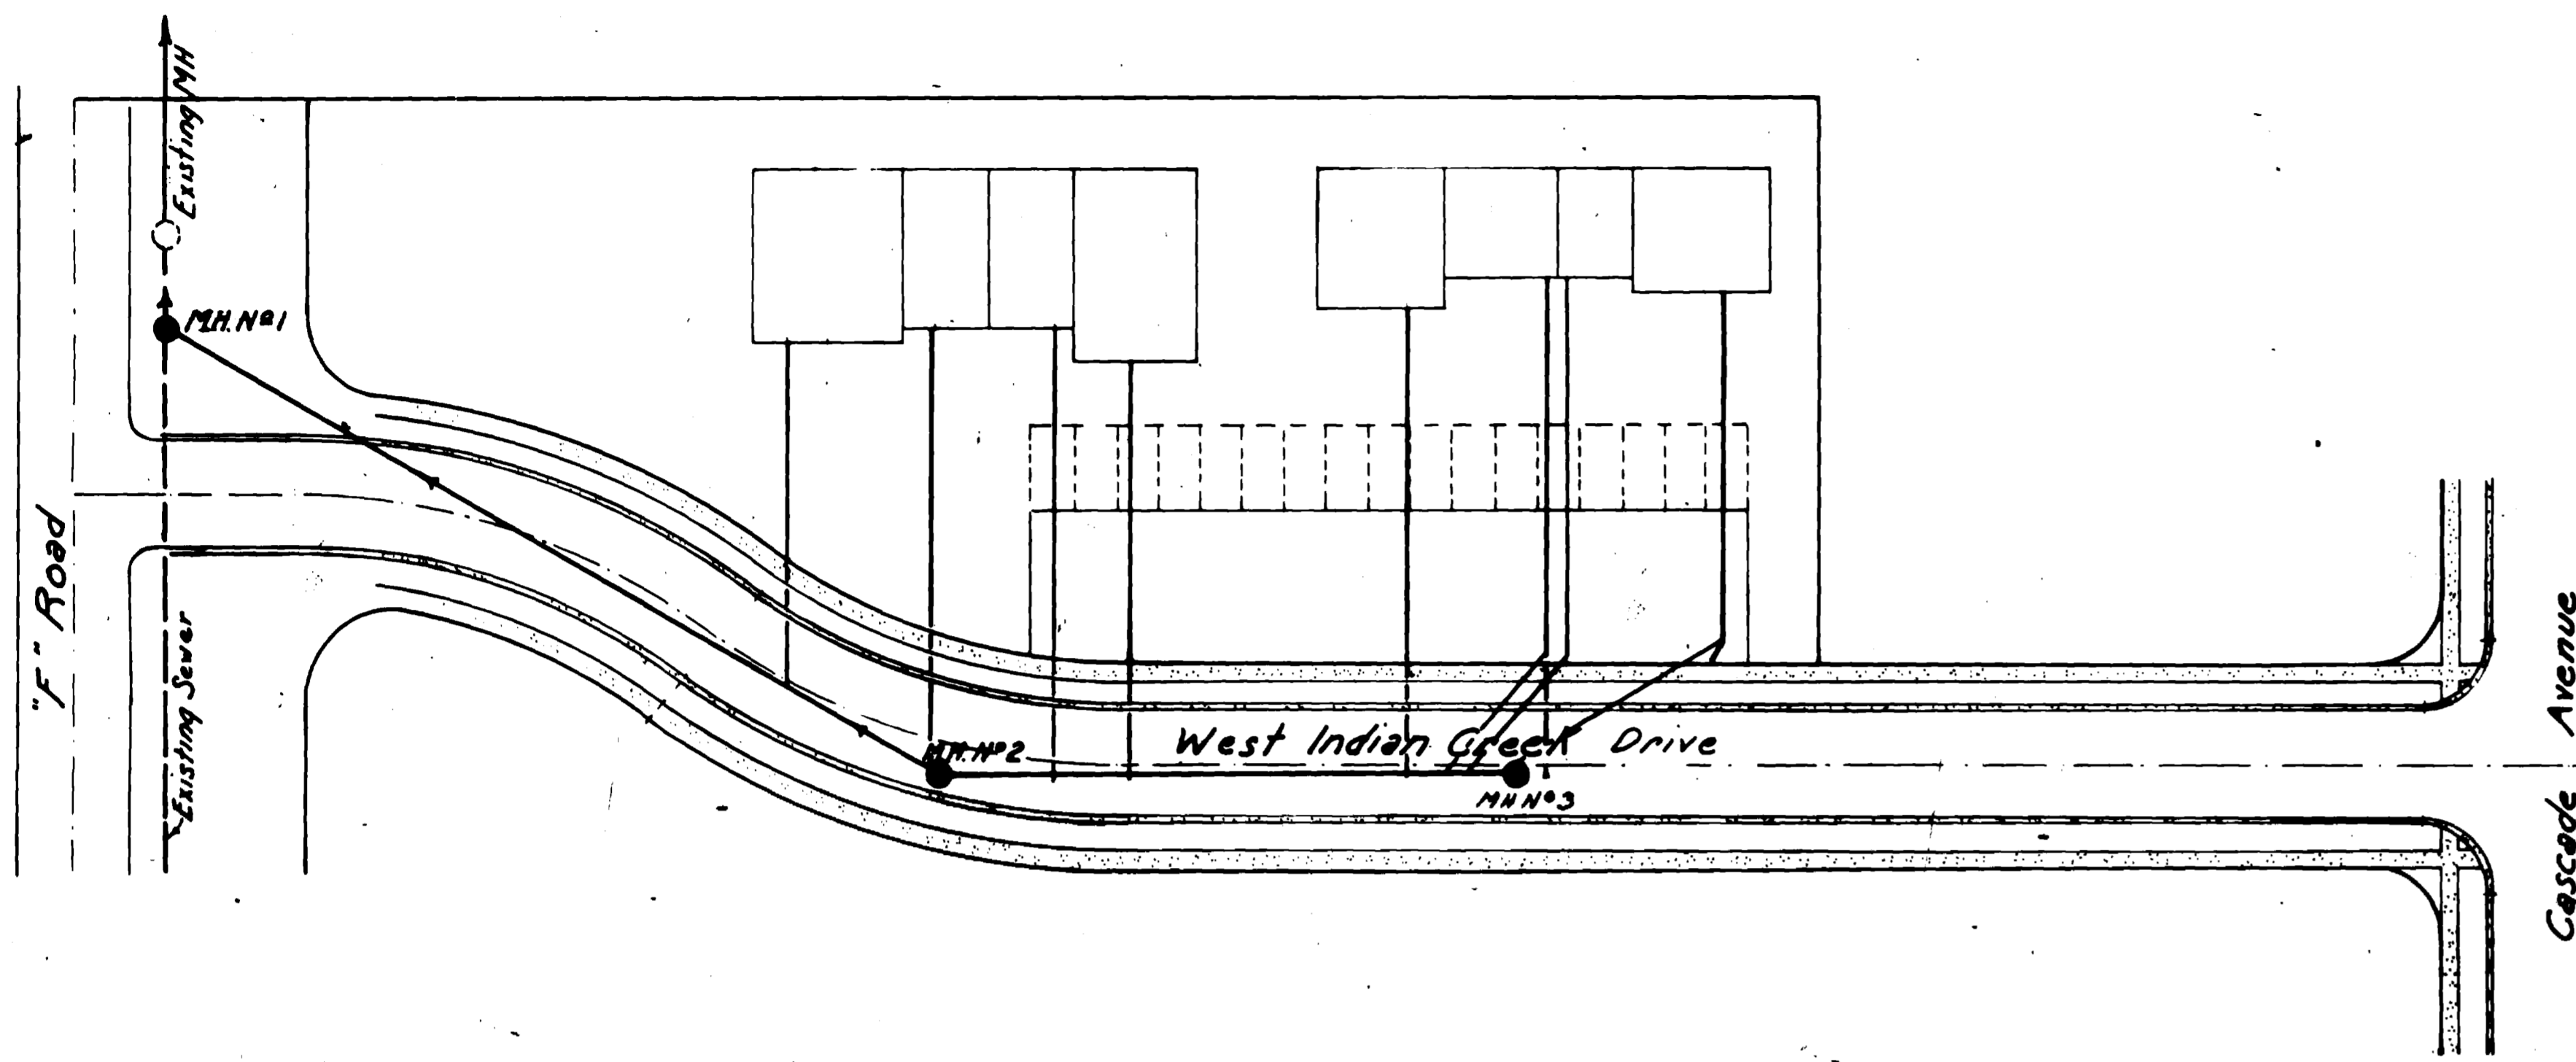

SEWER AS BUILTS *WHL*
 PEPPERIDGE - FILING NO. 1
 SEWER PROFILE

W.H. LIZER & ASSOCIATES
 ENGINEERING & SURVEYING
 576 28 ROAD UNIT EIGHT BAYLOR
 GRAND JUNCTION, COLORADO