

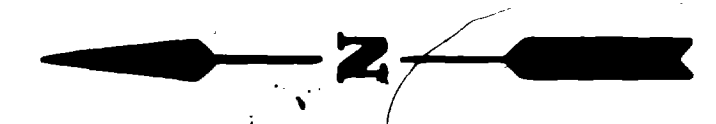


WINTERGREEN ESTATES

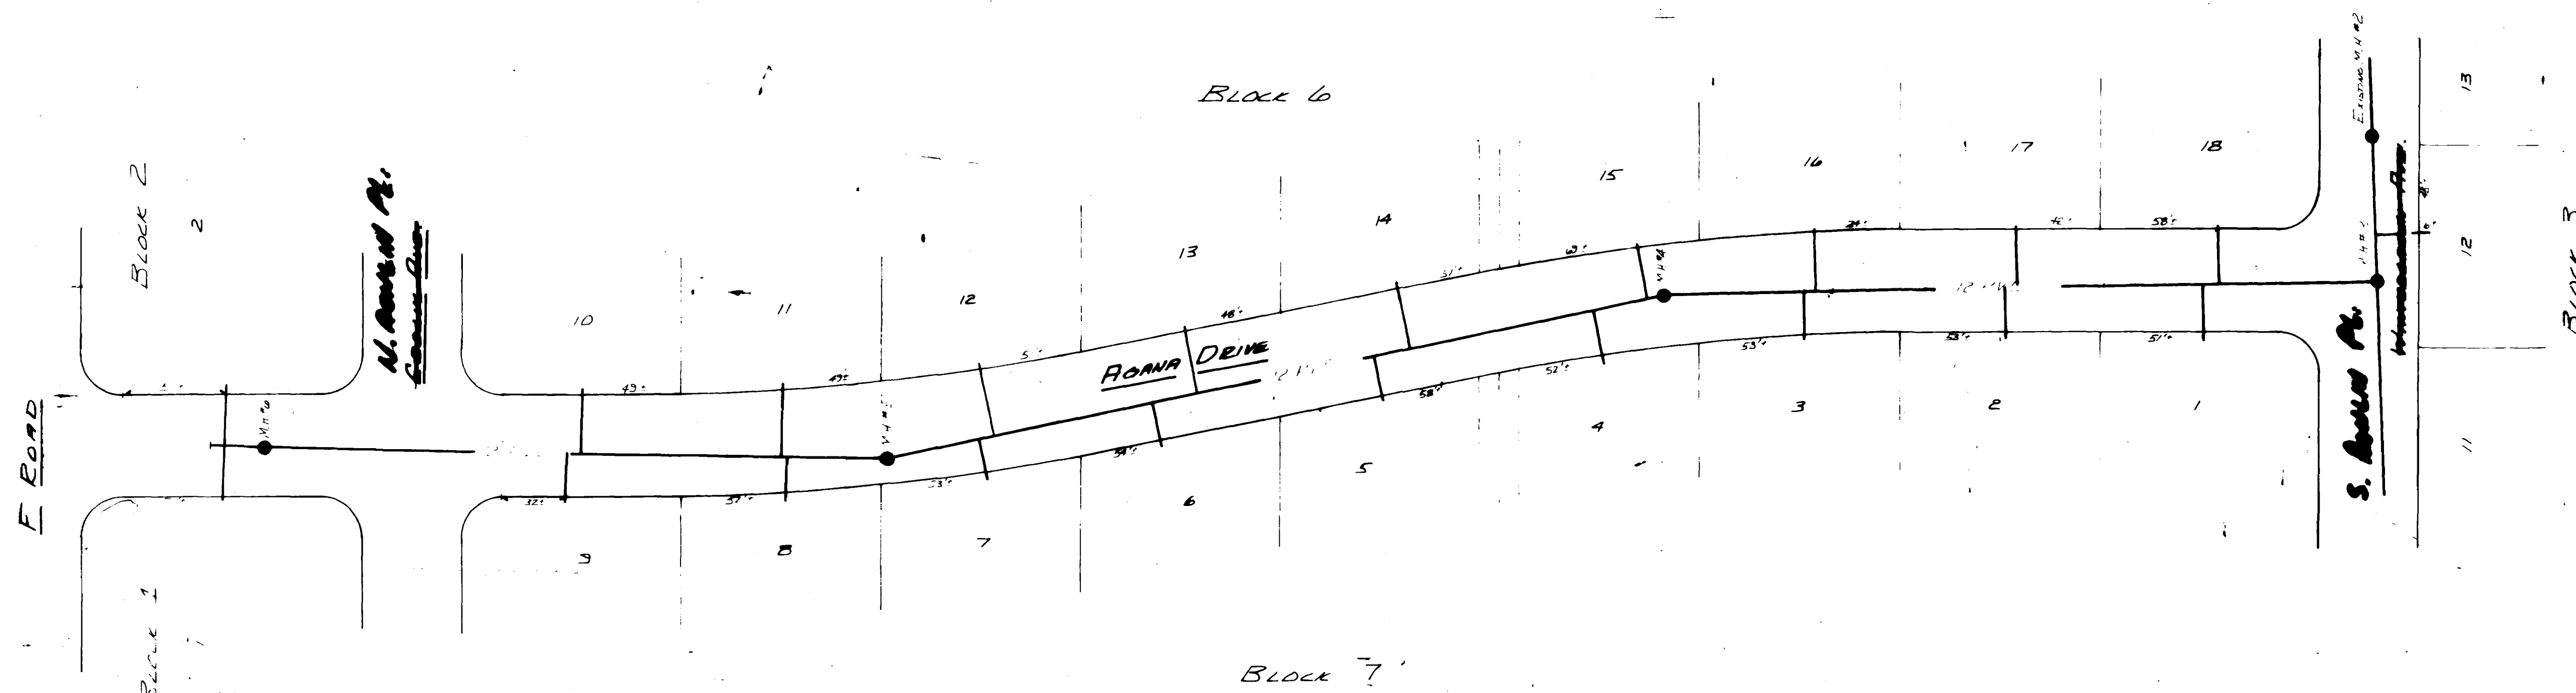

SCALE:
HORIZ. 1" = 50'
VERT. 1" = 5'

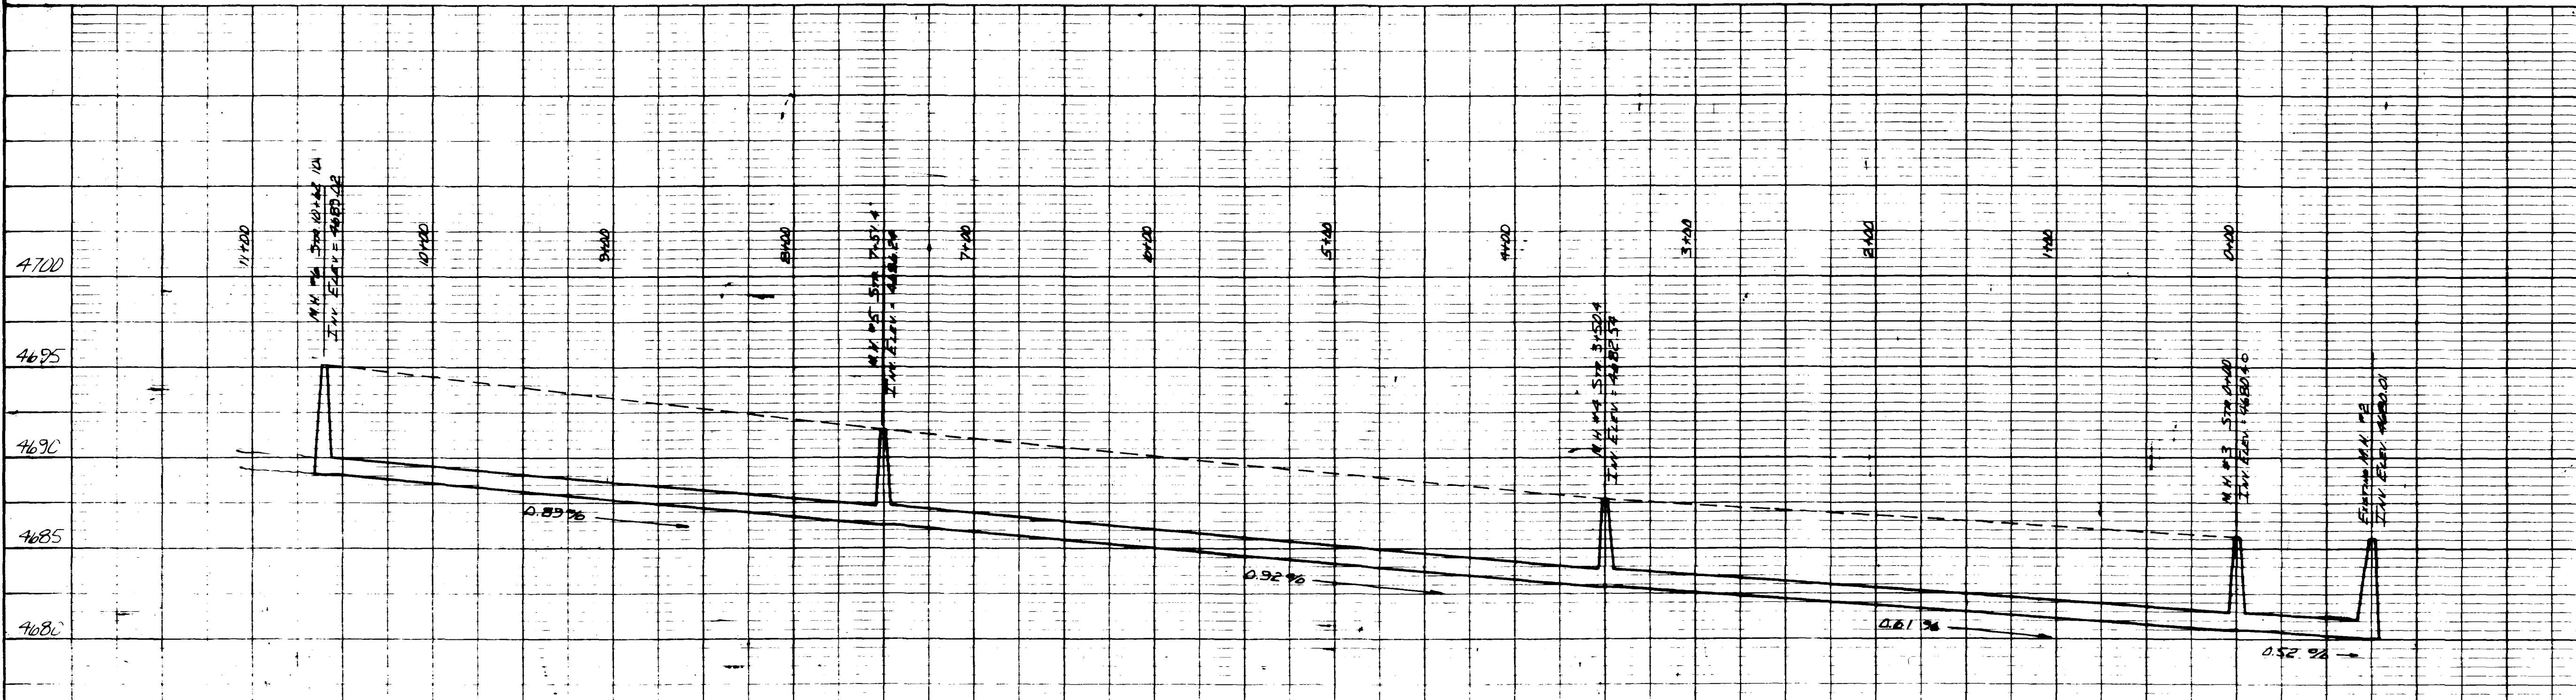

I, ROGER ALLEN HUBBY, BEING DULY REGISTERED & LICENSED TO PRACTICE AS A CIVIL ENGINEER IN THE STATE OF COLORADO, DO HEREBY CERTIFY THAT THE SEWER COLLECTION LINE SHOWN HEREON WAS INSPECTED AFTER CONSTRUCTION AND DEEMED TO BE IN ACCORDANCE WITH THE ABSENCE OF GROUND WATER AND THE ABSENCE OF WATER WITHIN THE PIPE AFTER CONSTRUCTION, INFILTRATION WILL NOT EXCEED 500 GALLONS PER INCH OF PIPE DIAMETER PER MILE OF LENGTH PER DAY.

COLORADO WEST SURVEYING COMPANY
COMPREHENSIVE LAND PLANNING
COMPLETE SURVEYING SERVICE

835 Colorado Avenue
Grand Junction, Colorado 81501
303 245-2767

NO.	DATE	REVISION
1		WINTERGREEN ESTATES SEWER "AS BUILT"



DES: CK
DRS: Hubby
DATE: 09-08-80

SHEET 1 OF 2

WINTERGREEN ESTATES



BLOCK 7

BLOCK 3

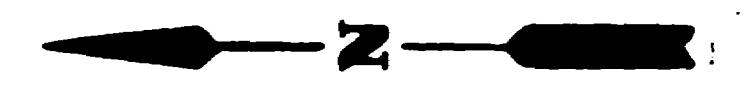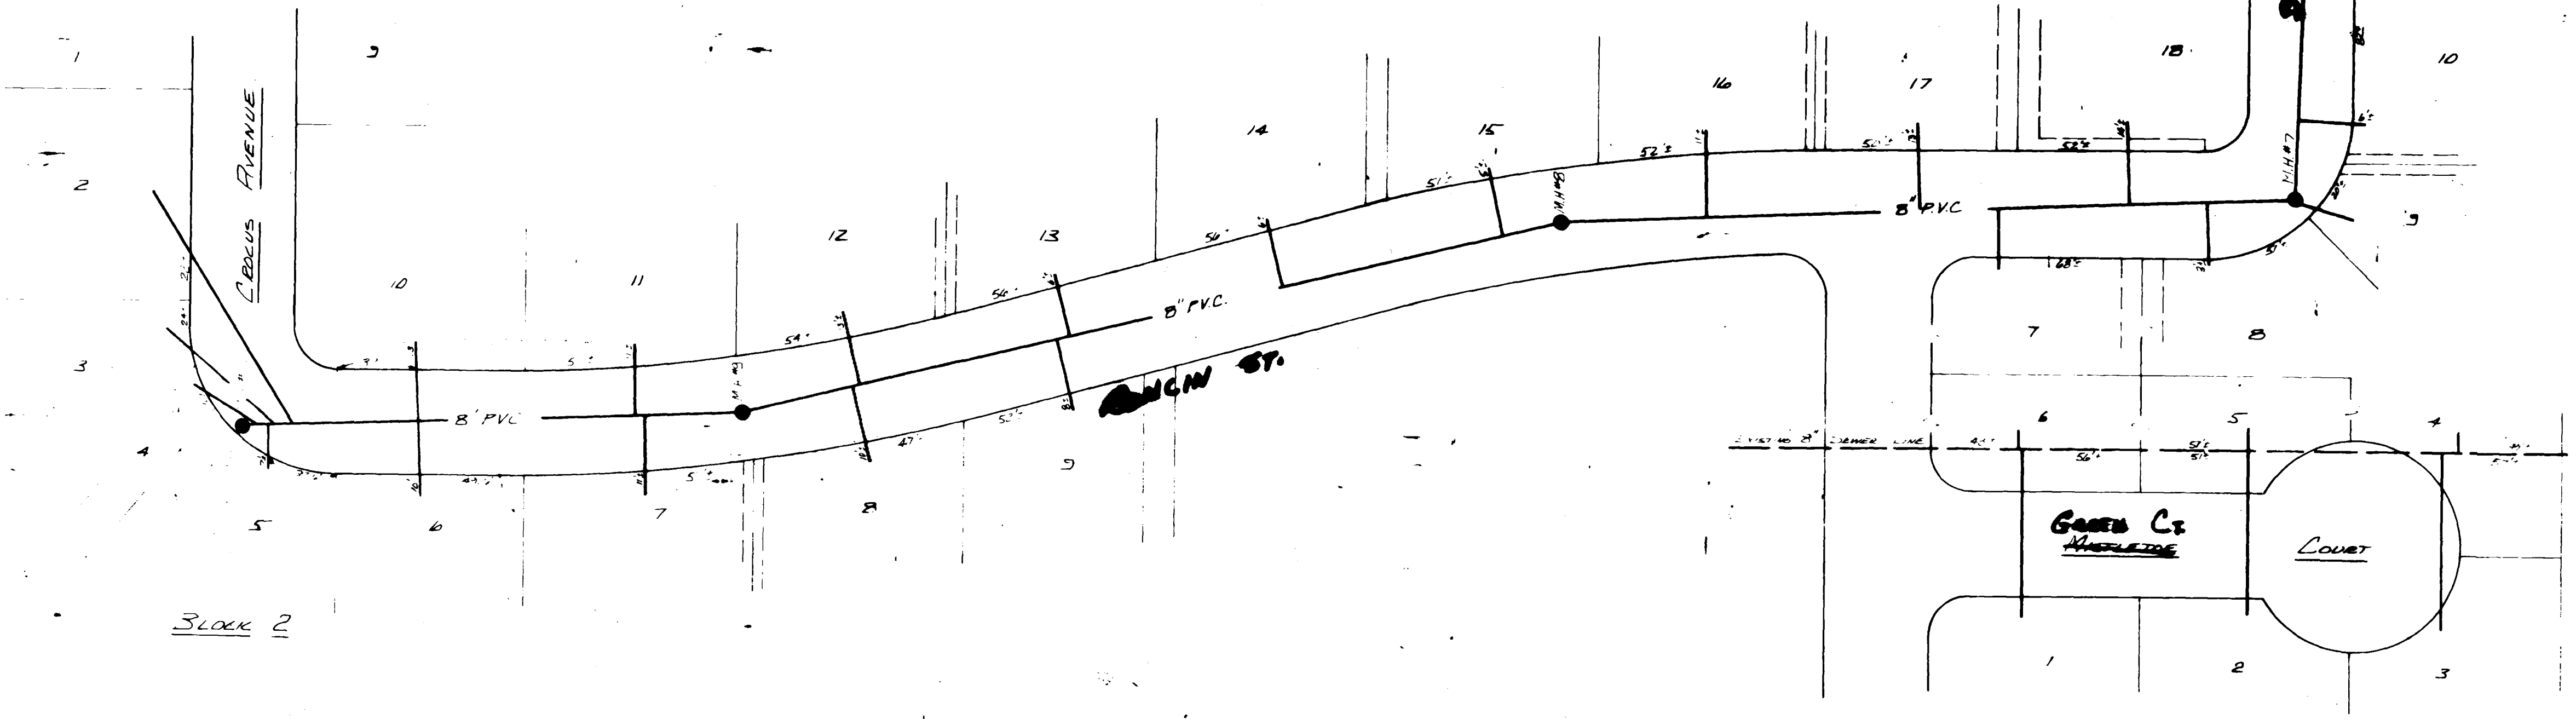

SCALE
 HORIZ = 1" = 50'
 VERT = 1" = 5'

BLOCK 2

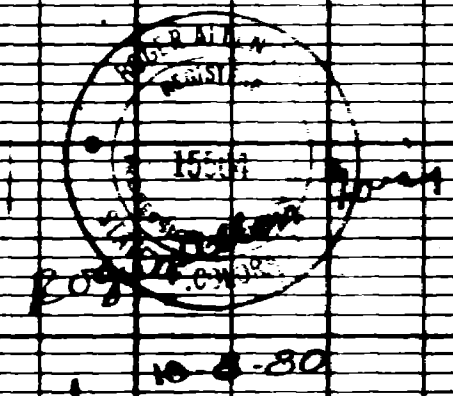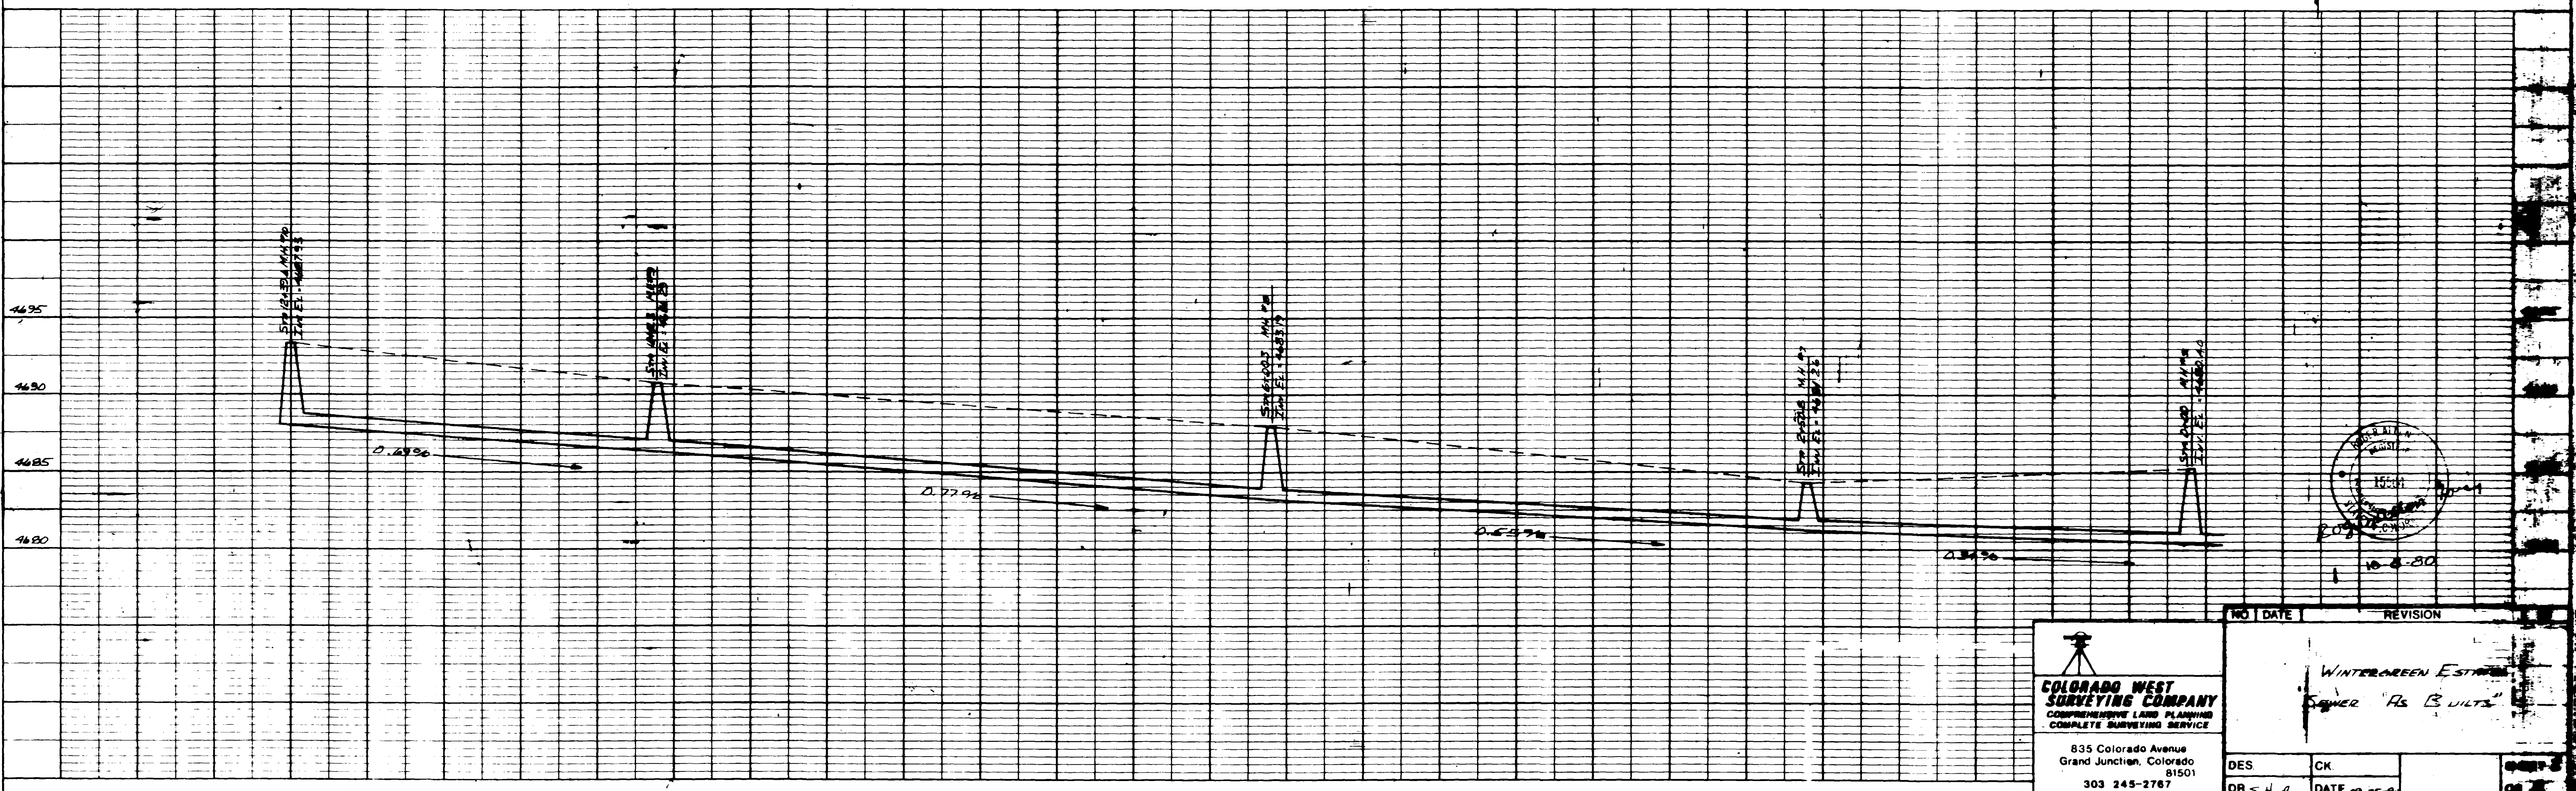

<p>COLORADO WEST SURVEYING COMPANY COMPREHENSIVE LAND PLANNING COMPLETE SURVEYING SERVICE</p> <p>835 Colorado Avenue Grand Junction, Colorado 81501 303 245-2767</p>	NO. DATE		REVISION
	WINTERGREEN ESTATES Sewer "As Built"		
DES	CK	DATE	OF 7
DR S.H.R.		09-25-84	