
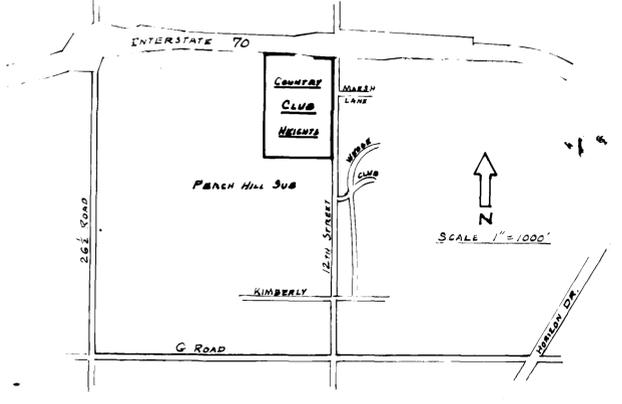


SANITARY SEWER SYSTEM		DATE	4-18-79
COUNTRY CLUB HEIGHTS		FILE NO.	78-08-11
FOR	JACK PAYNE	DESIGNED BY	R.S.C.
BY	C.M.	DRAWN BY	R.S.C.
COUNTRY CLUB HEIGHTS		APPROVED BY	R.S.C.
GRAND JUNCTION, COLO.		SCALE	1" = 5'
SECTIONAL		VERTICAL	1" = 5'


I CERTIFY THE QUALITY OF MATERIALS & INSTALLATION, INCLUDING TRENCH COMPACTION, TO CITY OF GRAND JUNCTION SPECIFICATIONS AND STANDARD SANITARY SEWER DETAILS *Boyle States* 6-4-80

I CERTIFY THE PHYSICAL GEOMETRY OF THE AS BUILT SEWER CONFIGURATION & INFILTRATION-EXFILTRATION DOES NOT EXCEED 200 GR/INCH. *R. S. Colburn P.E. #7444* 6-4-80

NOTE: LATERAL STATIONS, MANHOLE TIES & RIM ELEVATIONS TO BE ADDED AFTER STREET PAVING IS C.

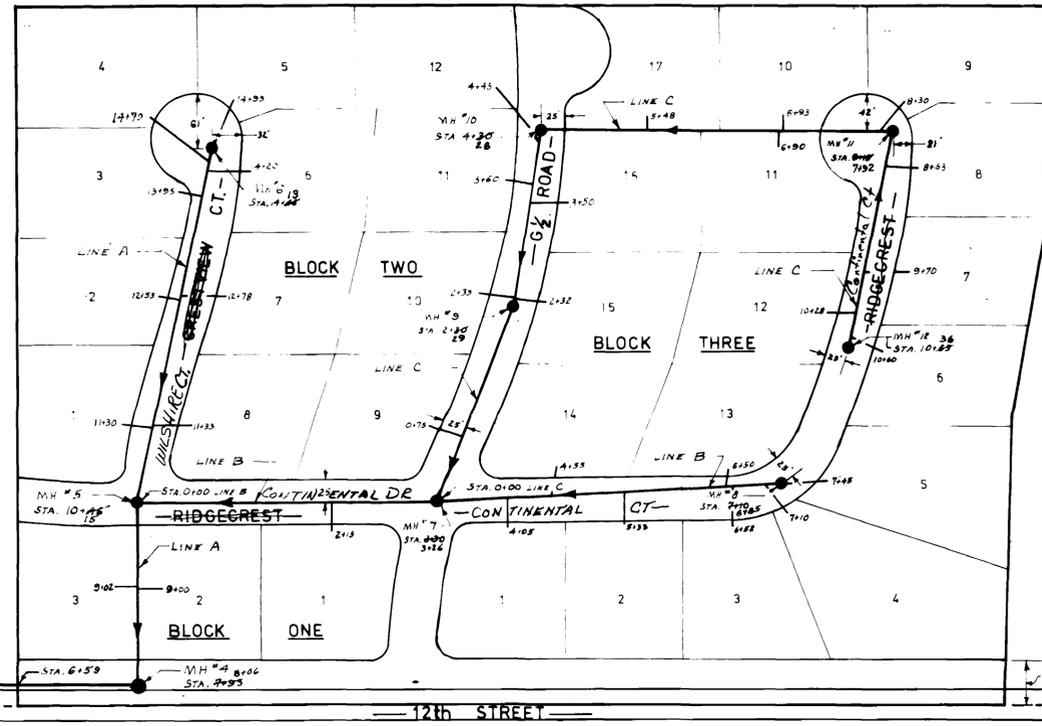

NOTE: LATERAL STATIONS ARE AT THE LOT LINE

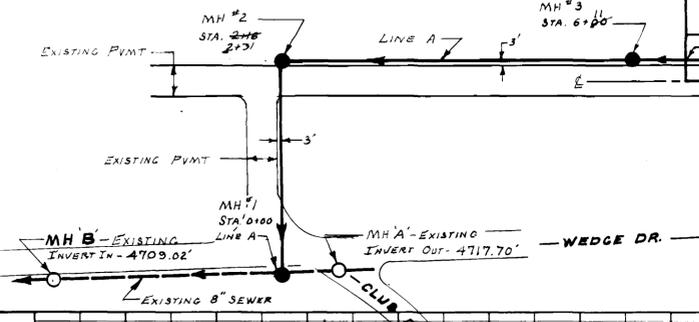

LEGEND:
 ○ - EXISTING MANHOLE (MH)
 ● - NEW MANHOLE (MH)
 — - SEWER LINE & DIRECTION OF FLOW

SCALE 1" = 100'

James T. Patton 4-23-79
 CITY OF GRAND JUNCTION
 OWNER

