




SECTION "A"-A



BENCH MARK
S.W. WING WALL
HORIZON DRIVE
HIGHLINE CANAL
ELEV. 4763.53

QUANTITIES


8" SANITARY SEWER	2791 LF
STANDARD MANHOLE	11
SERVICE LINES	18

- NOTES:
1. All construction to be done in accordance with the City of Grand Junction Specifications.
 2. Top of eccentric cone to be set at top of subgrade (street contractor to set rims to finish grade.)
 3. Service lines as shown are intended to be located 5' downstream from center of lots and shall extend 10 feet beyond the property line.

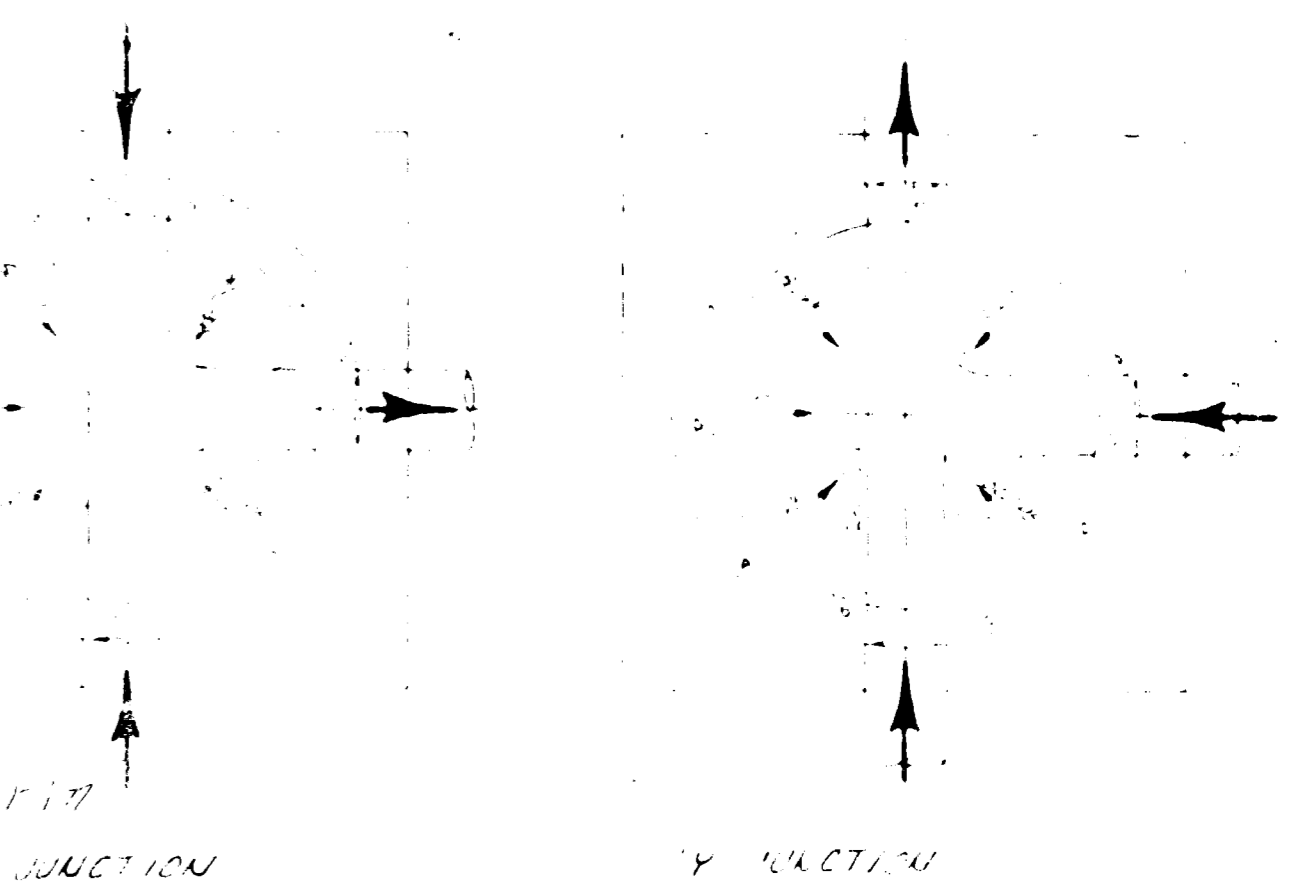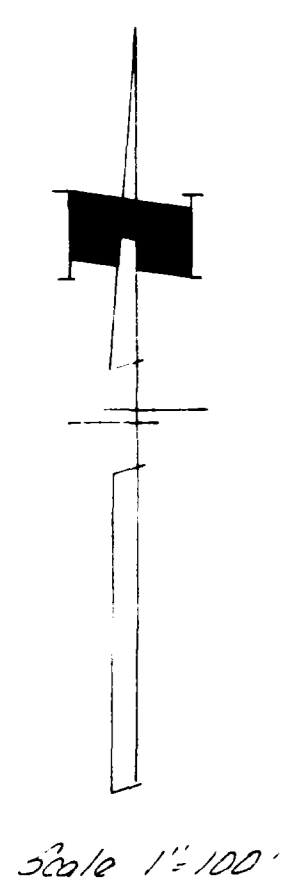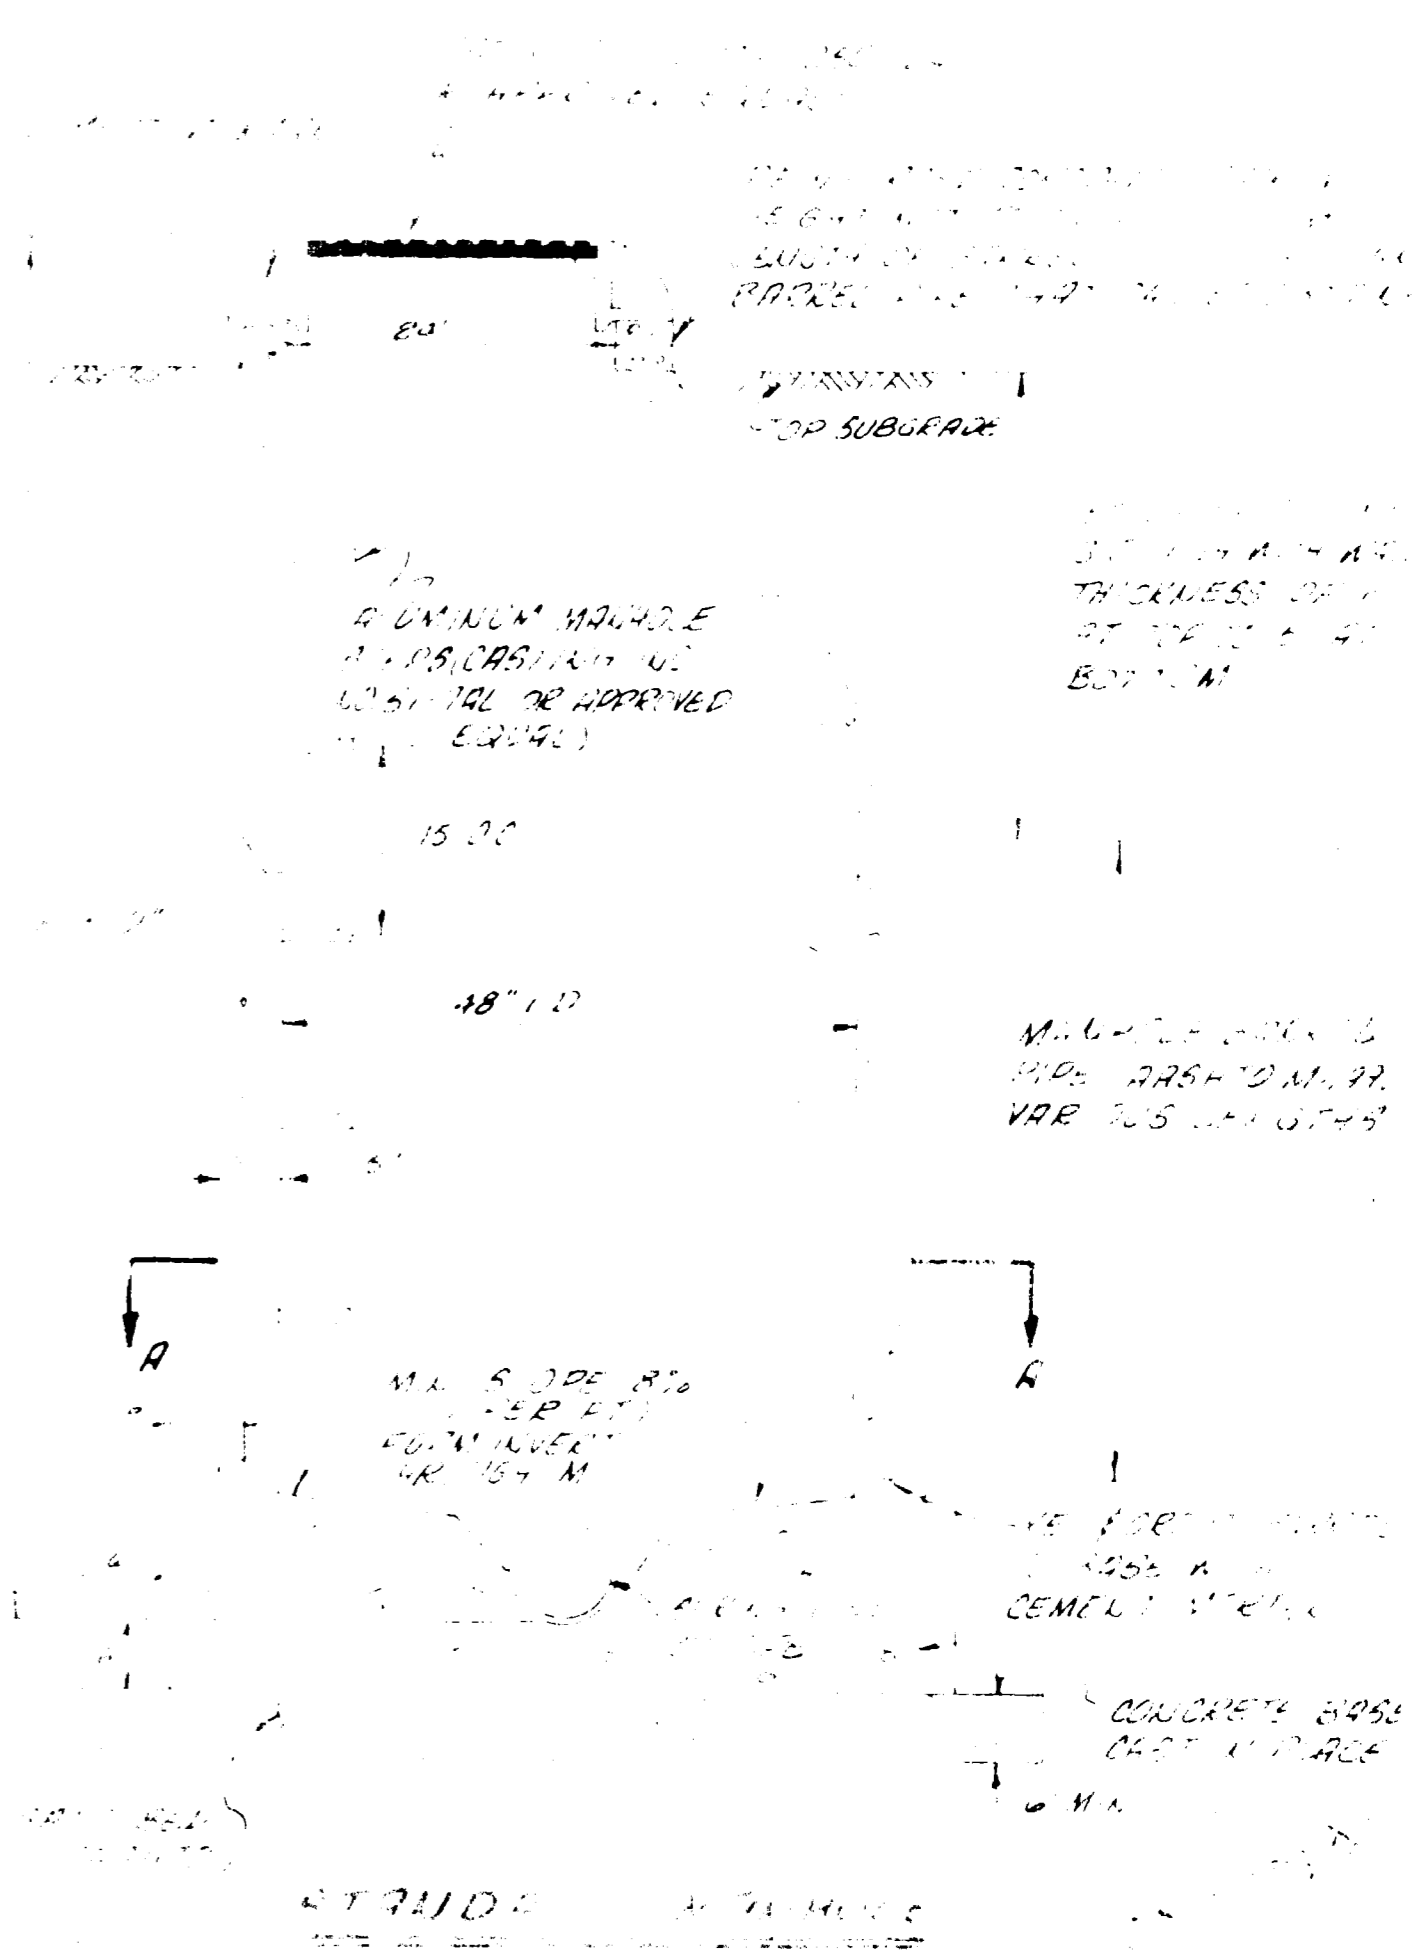

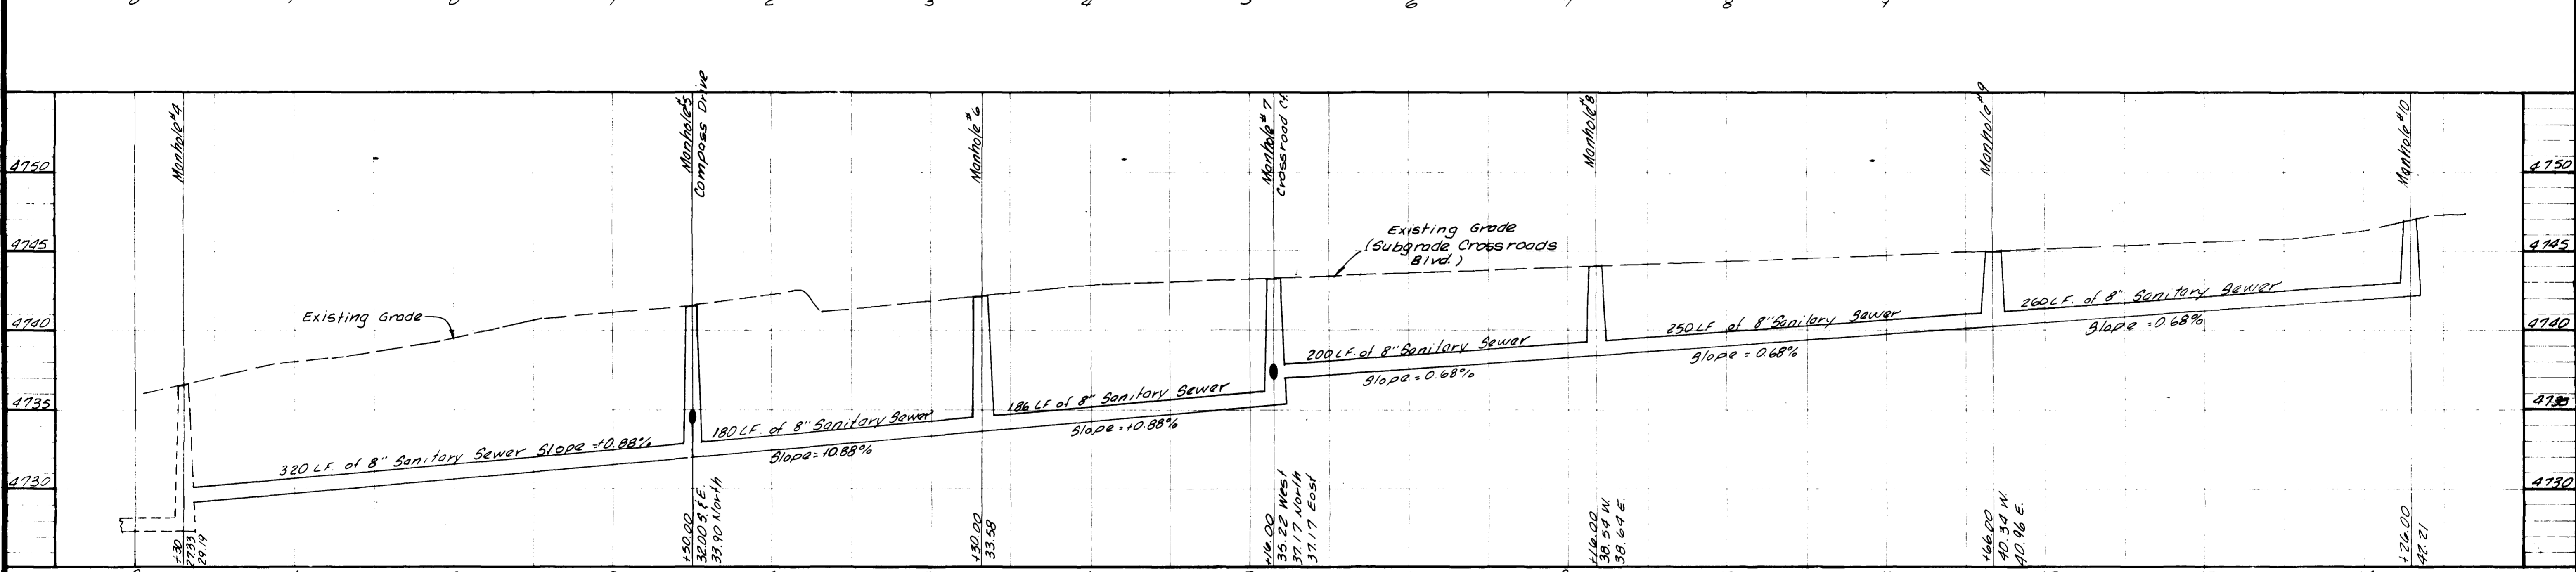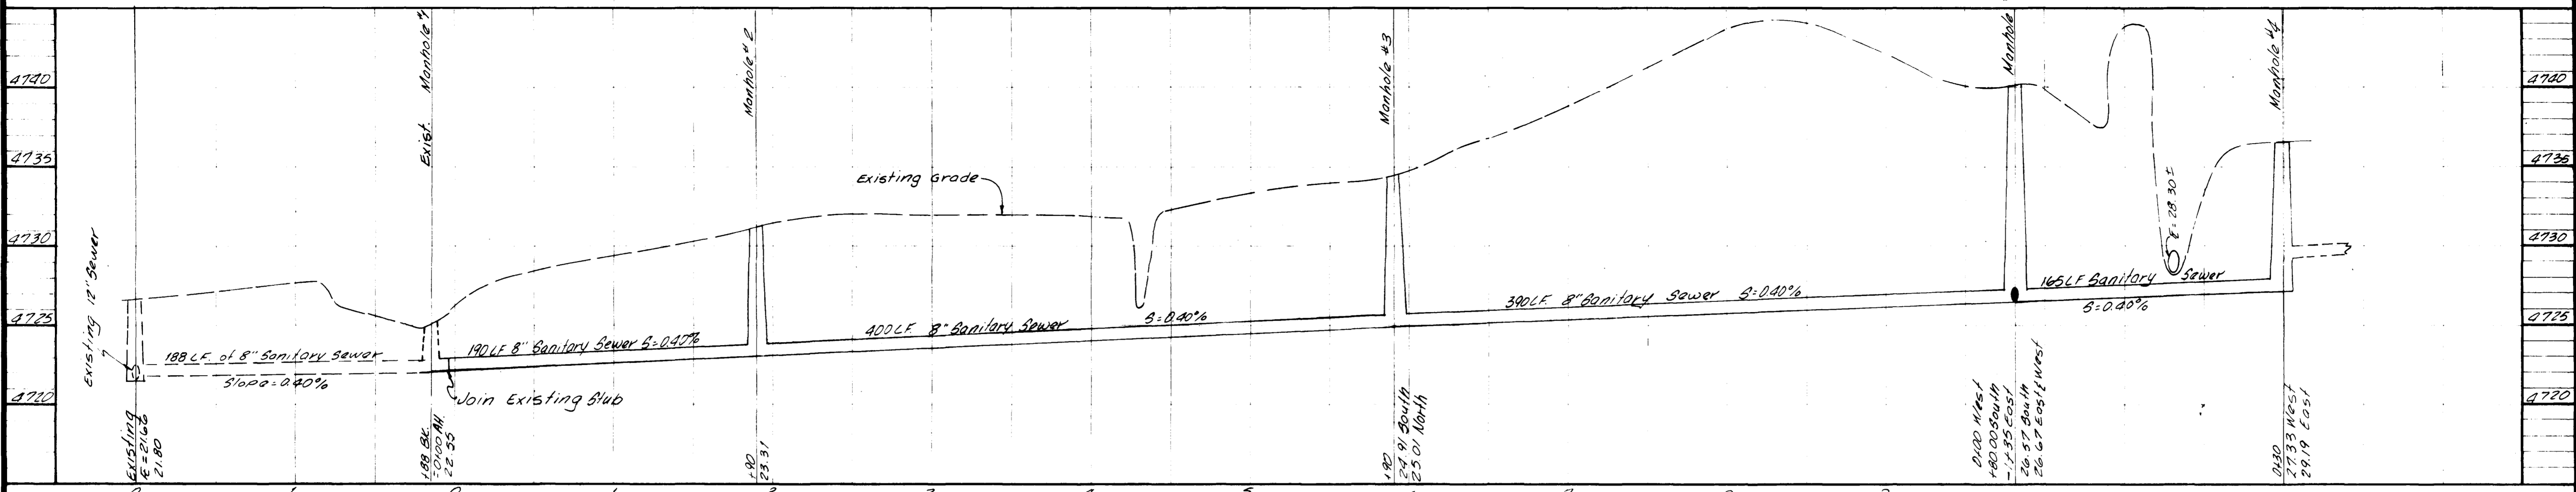

CROSSROADS BLVD.

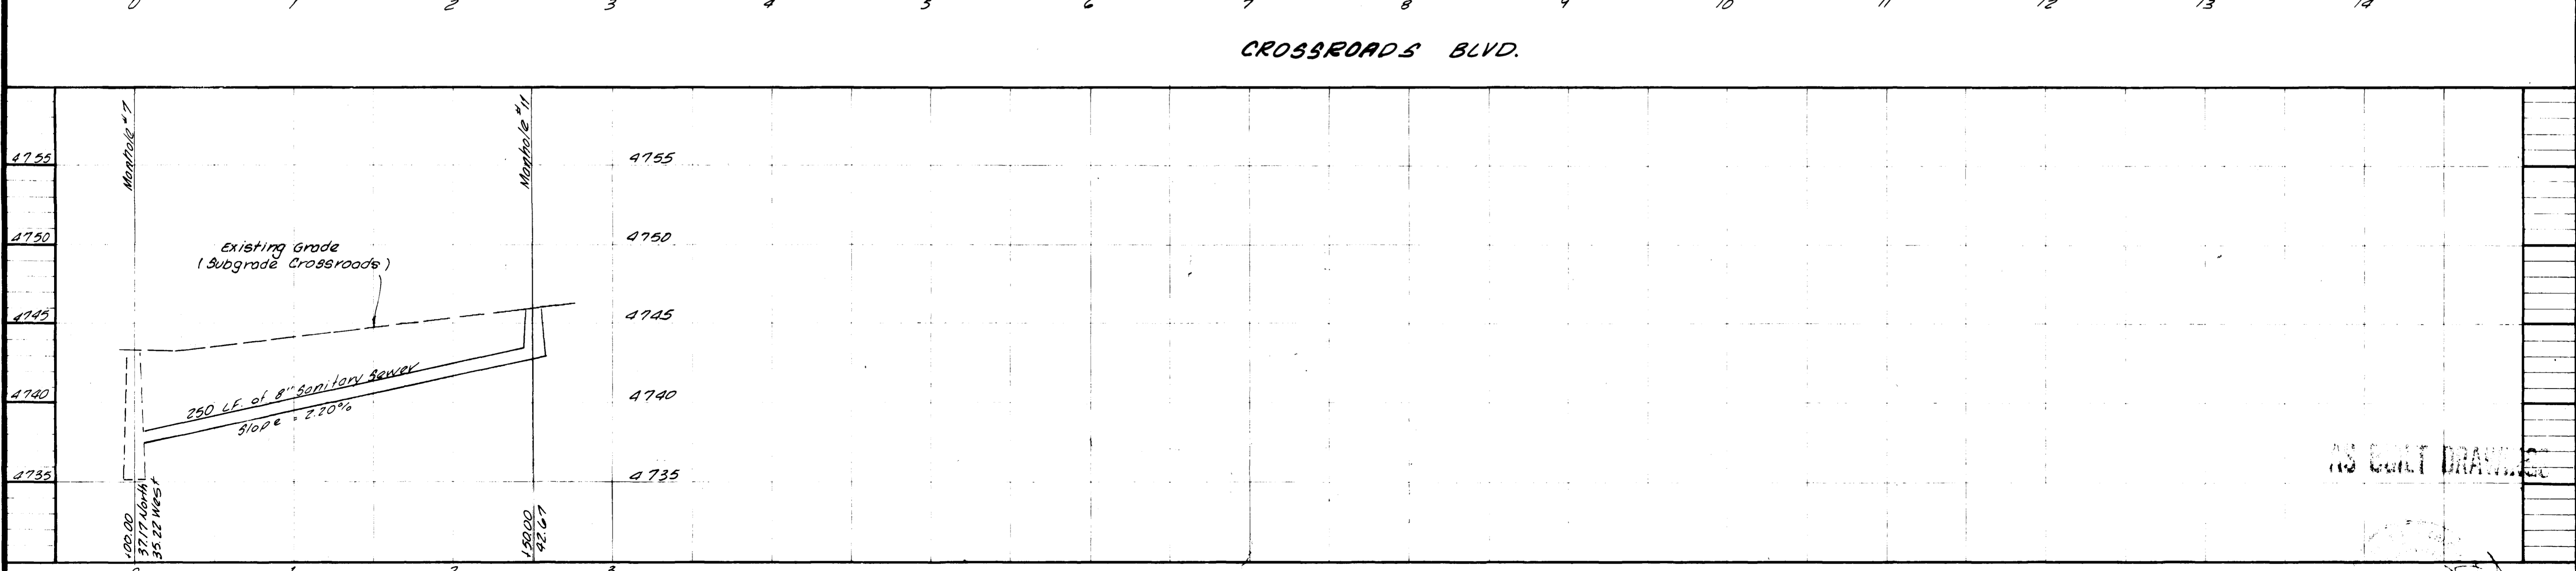

CROSSROADS CT.

AS BUILT DRAWING