



Culdesac To Be Vacated When Road Is Extended For Future Development

Bench Mark Top of Pin Elev. 4708.87

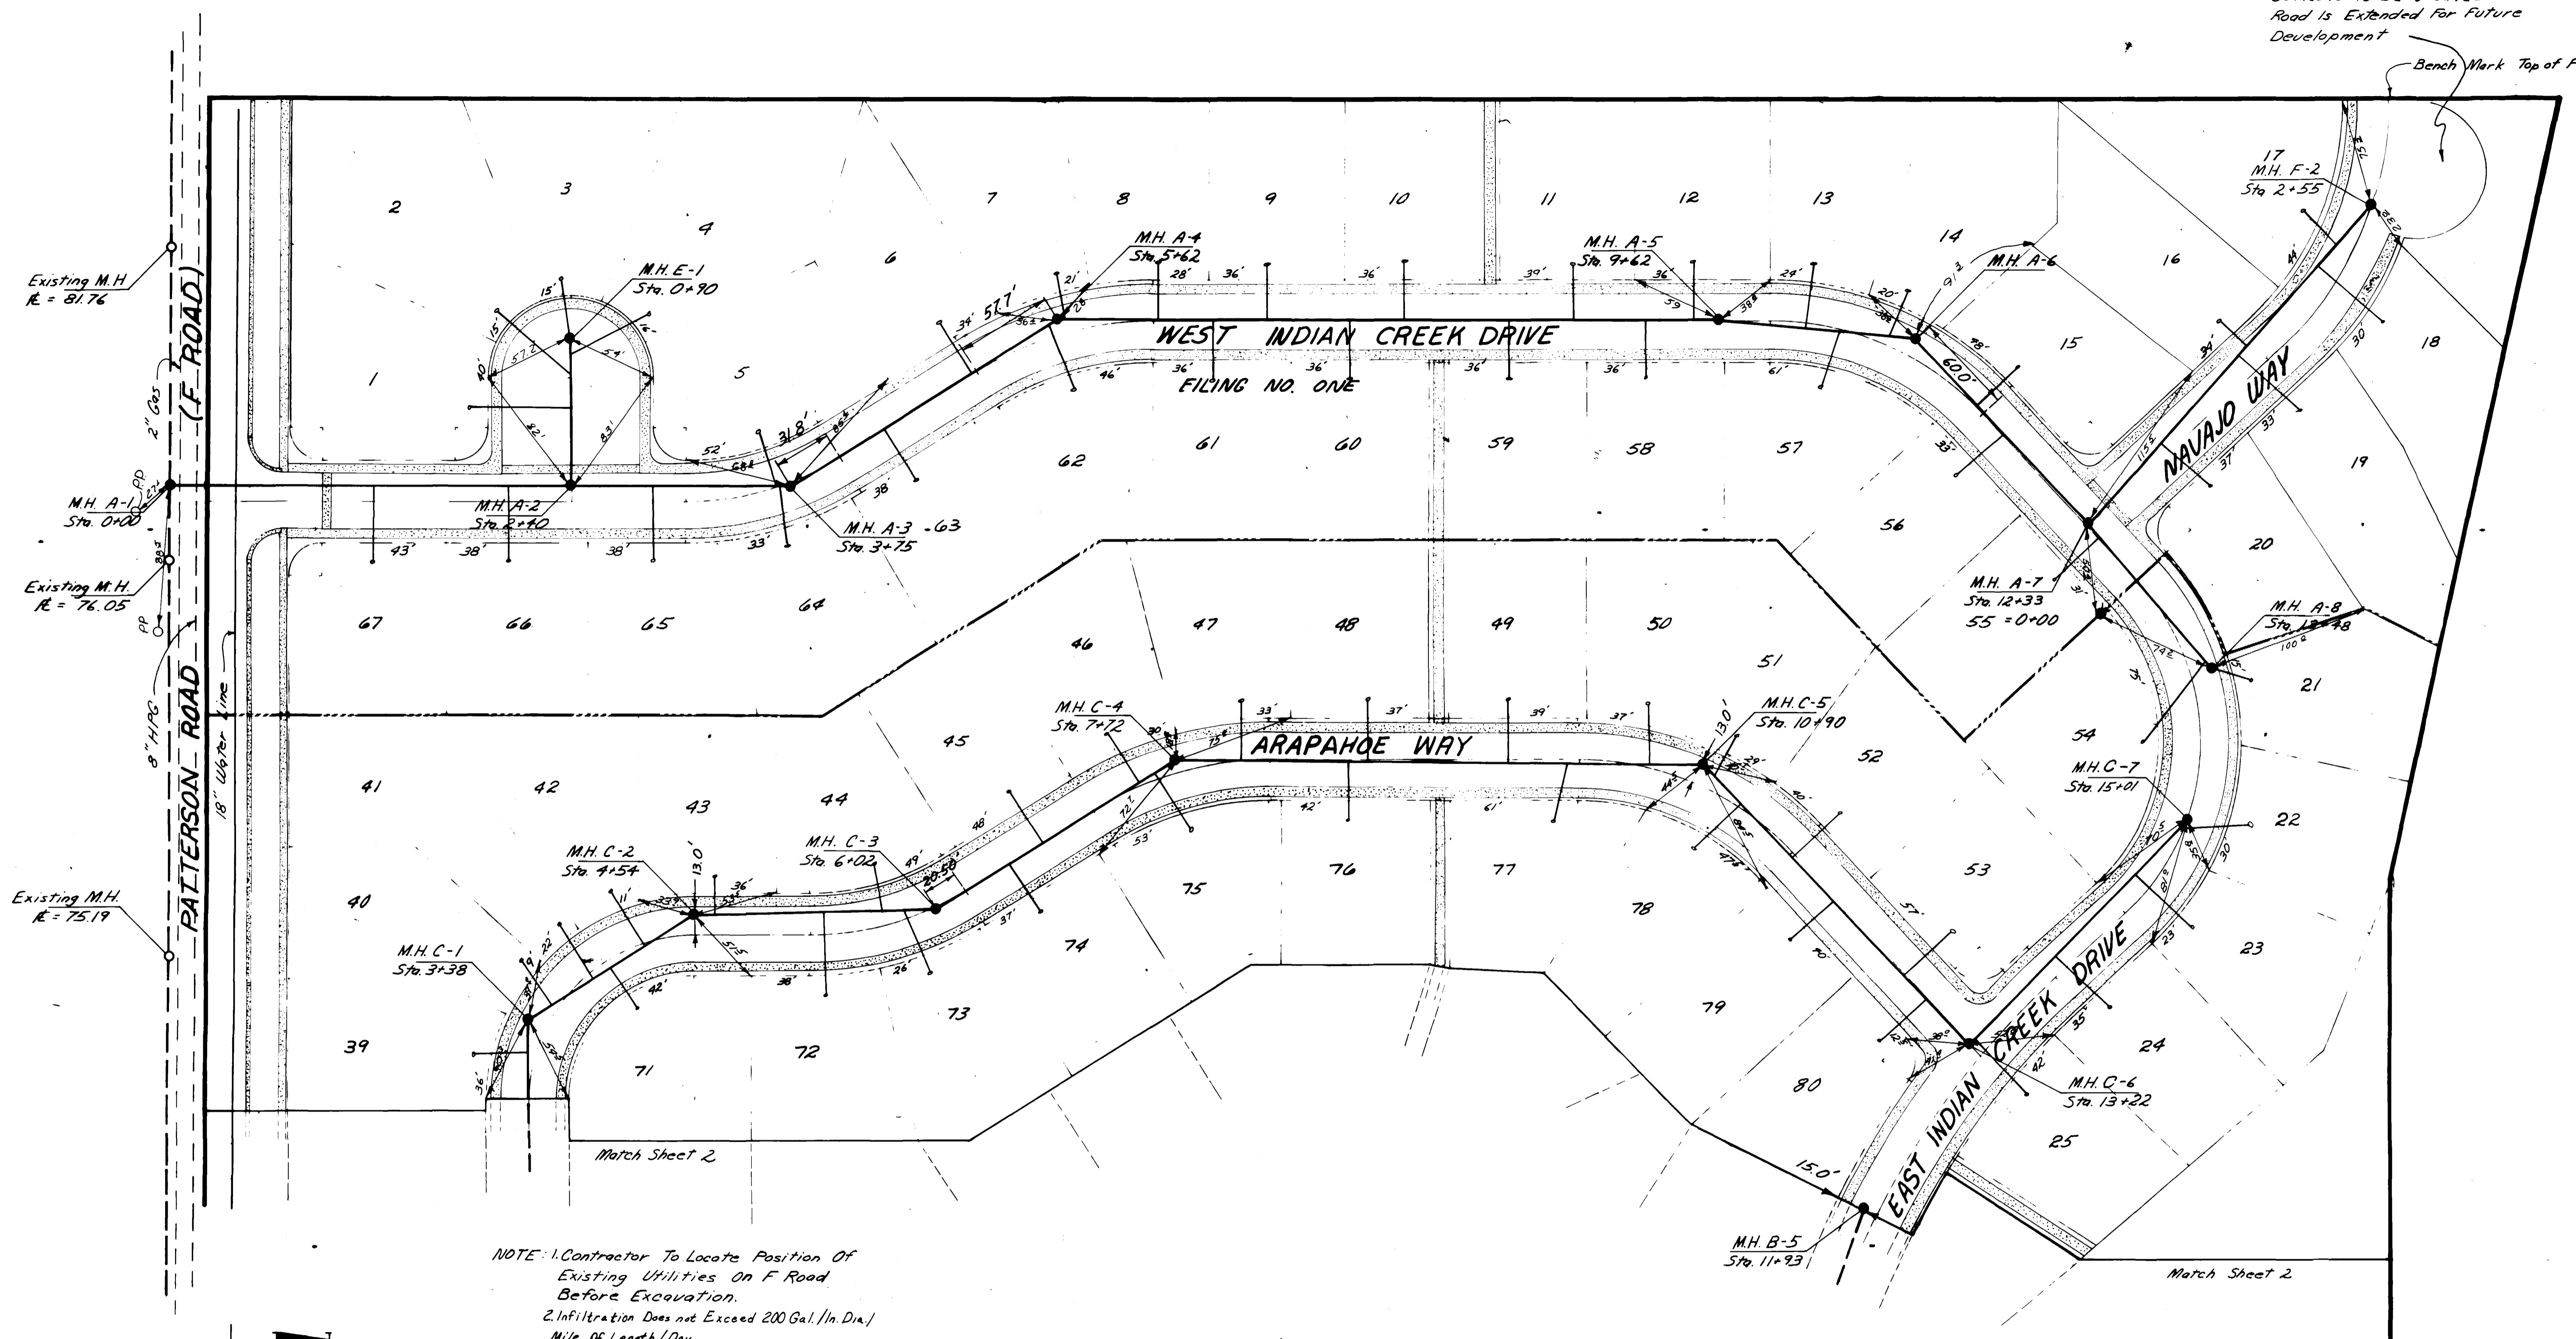

NOTE: 1. Contractor To Locate Position Of Existing Utilities On F Road Before Excavation.
 2. Infiltration Does not Exceed 200 Gal./In. Dia./ Mile Of Length/Day.

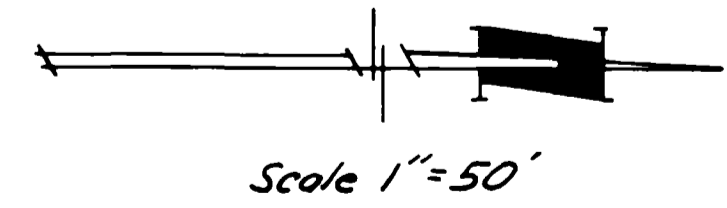


Approved _____ Date _____
 CENTRAL GRAND VALLEY SANITATION DISTRICT

AS BUILT

Edward J. Patterson


DATE AUGUST, 1977	DRAWN BY M.E.S. & D.H.N.	CHECKED BY E.J.S.	PROJECT NO. INDIAN VILLAGE SUBDIVISION MESA COUNTY	PROJECT NO. 77-2-ENG-0177
SCALE 1"=50'	DESIGNED BY E.J.S.	DATE AUGUST, 1977	PROJECT NO. INDIAN VILLAGE SUBDIVISION MESA COUNTY	PROJECT NO. 77-2-ENG-0177
Nelson - Haley - Patterson and Quirk ENGINEERING CONSULTANTS GRAND JUNCTION COLORADO			SHEET 4 SHEETS 1	

NOTE: Contractor To Locate Position Of Existing Utilities On F Road Before Excavation.

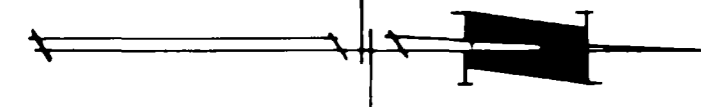

Scale 1" = 50'

Existing M.H.
E. = 75.19

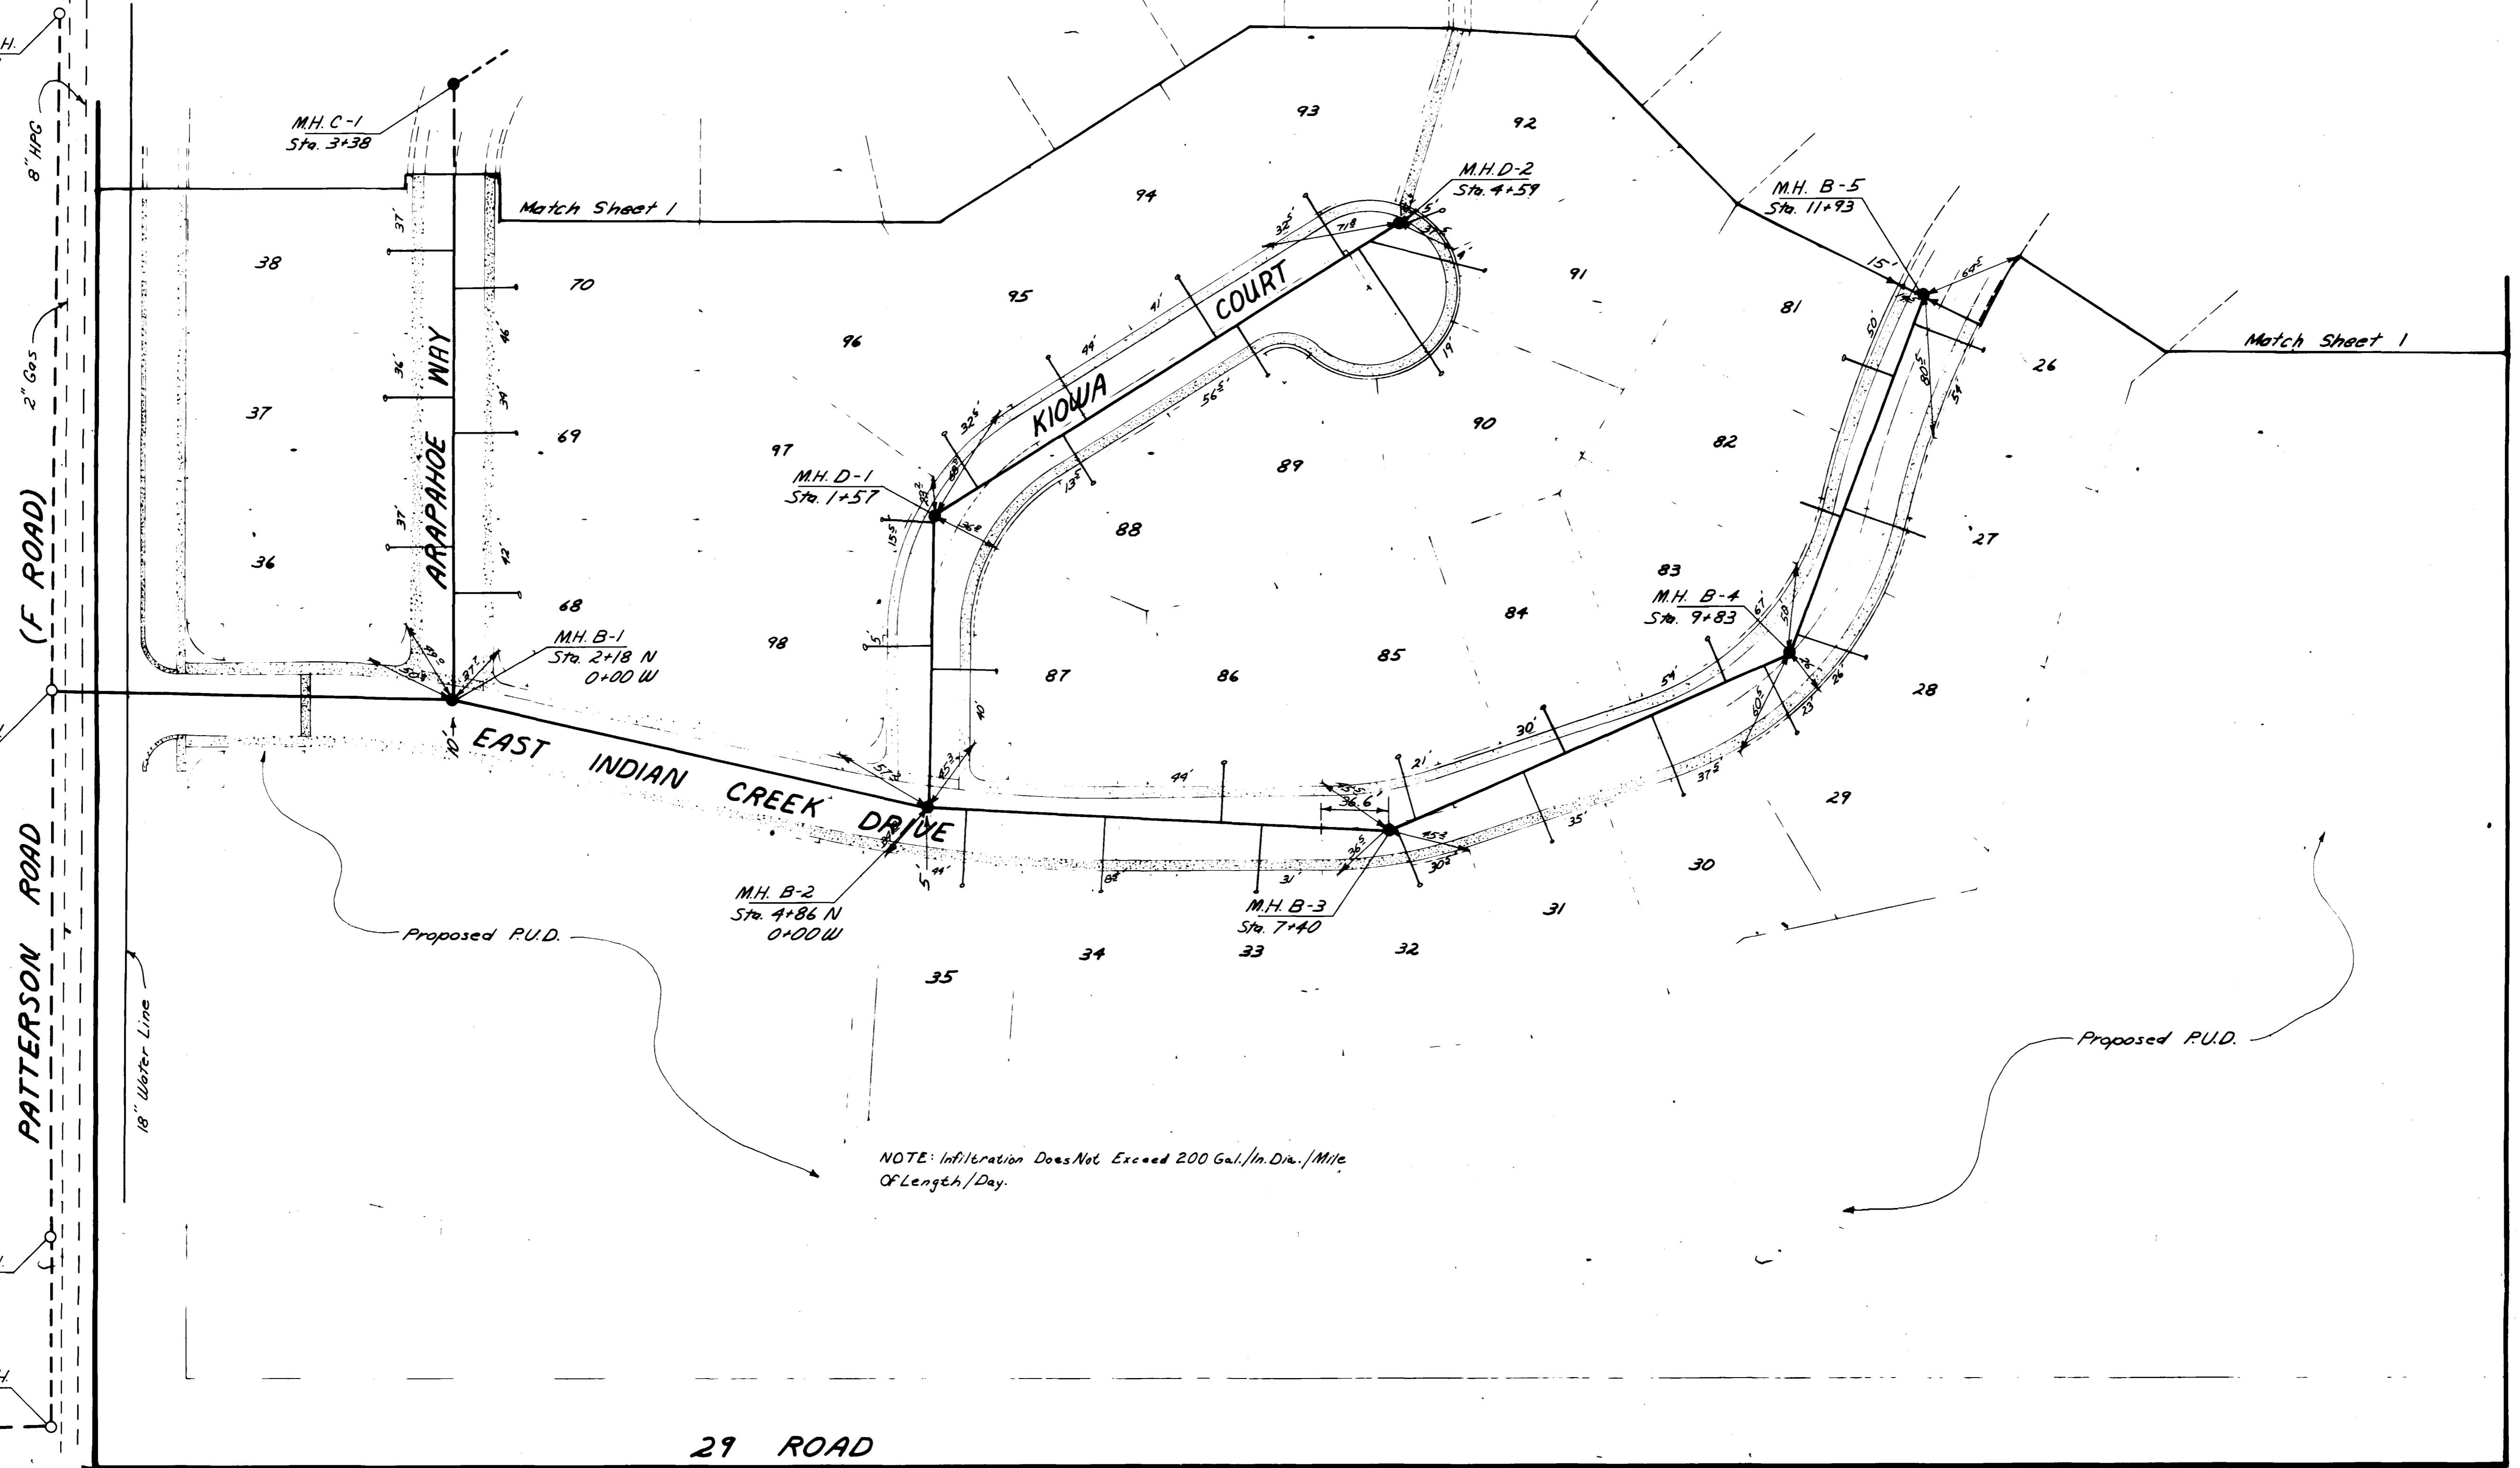

Existing M.H.
Sta. 0+00

PATTERSON ROAD

18" Water Line

Proposed P.U.D.

Proposed P.U.D.

NOTE: Infiltration Does Not Exceed 200 Gal./In. Dia./Mile Of Length/Day.



29 ROAD

Bench Mark Top Mesa
County Brass Cap
Elev. 4683.11


AS BUILT



DATE August 1977		DRAFTSMAN M.E.S. & D.H.N.		DEPT. HEAD		PROJECT NO. 77-2-ENG-0177	
SCALE 1" = 50'		PROJECT ENGR. E.U.S.		CONSULTANT		INDIAN VILLAGE SUBDIVISION MESA COUNTY	
NO.		BY		DATE		APPROVED	
REVISIONS		PROJECT MGR. E.U.S.		CONSULTANT		SEWER PLAN	
		Nelson-Haley-Patterson and Quirk		GRAND JUNCTION COLORADO		SHEET 4 OF 2	

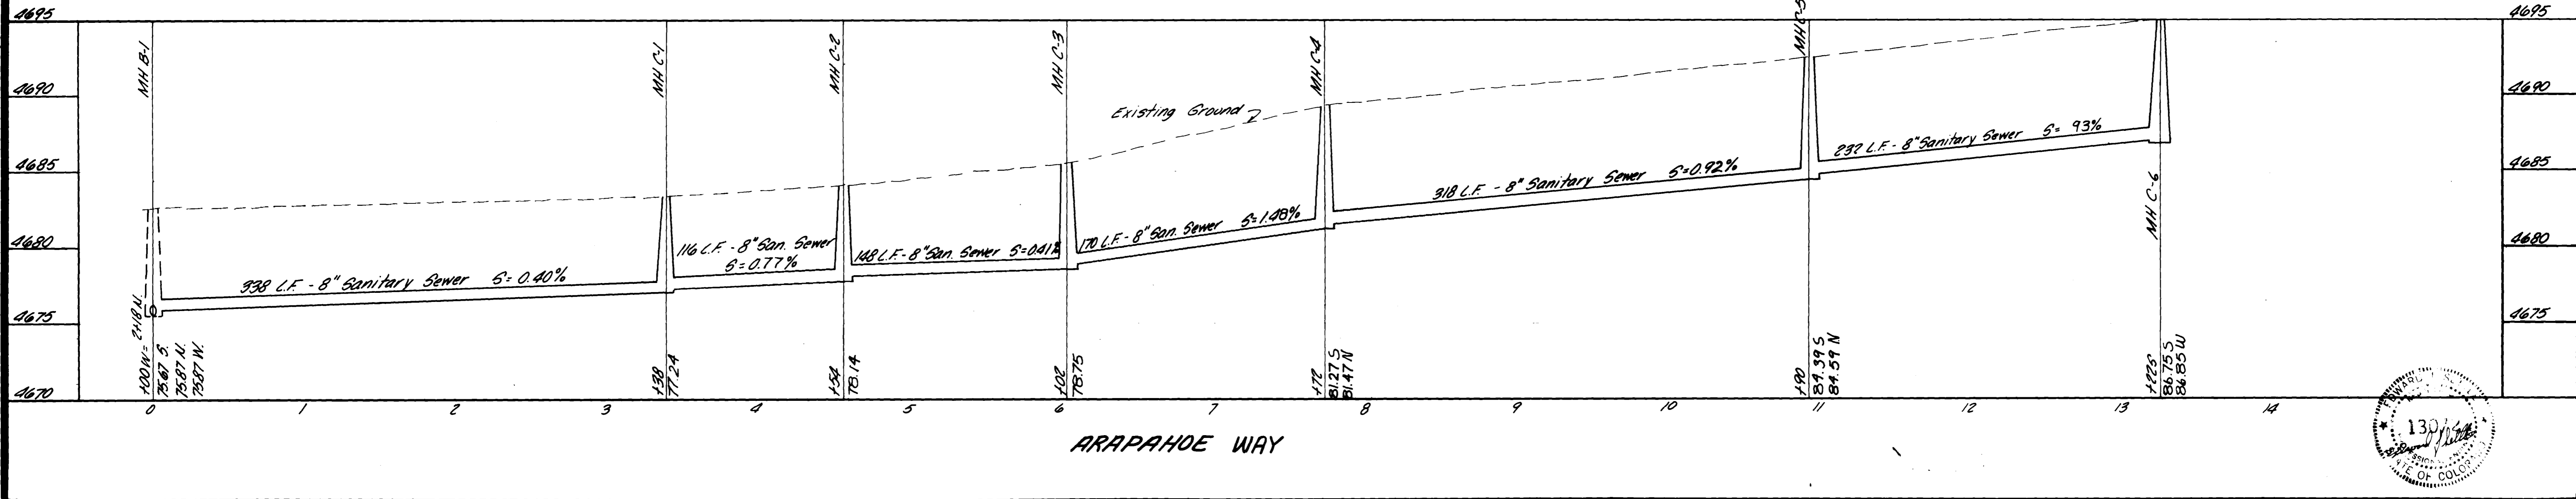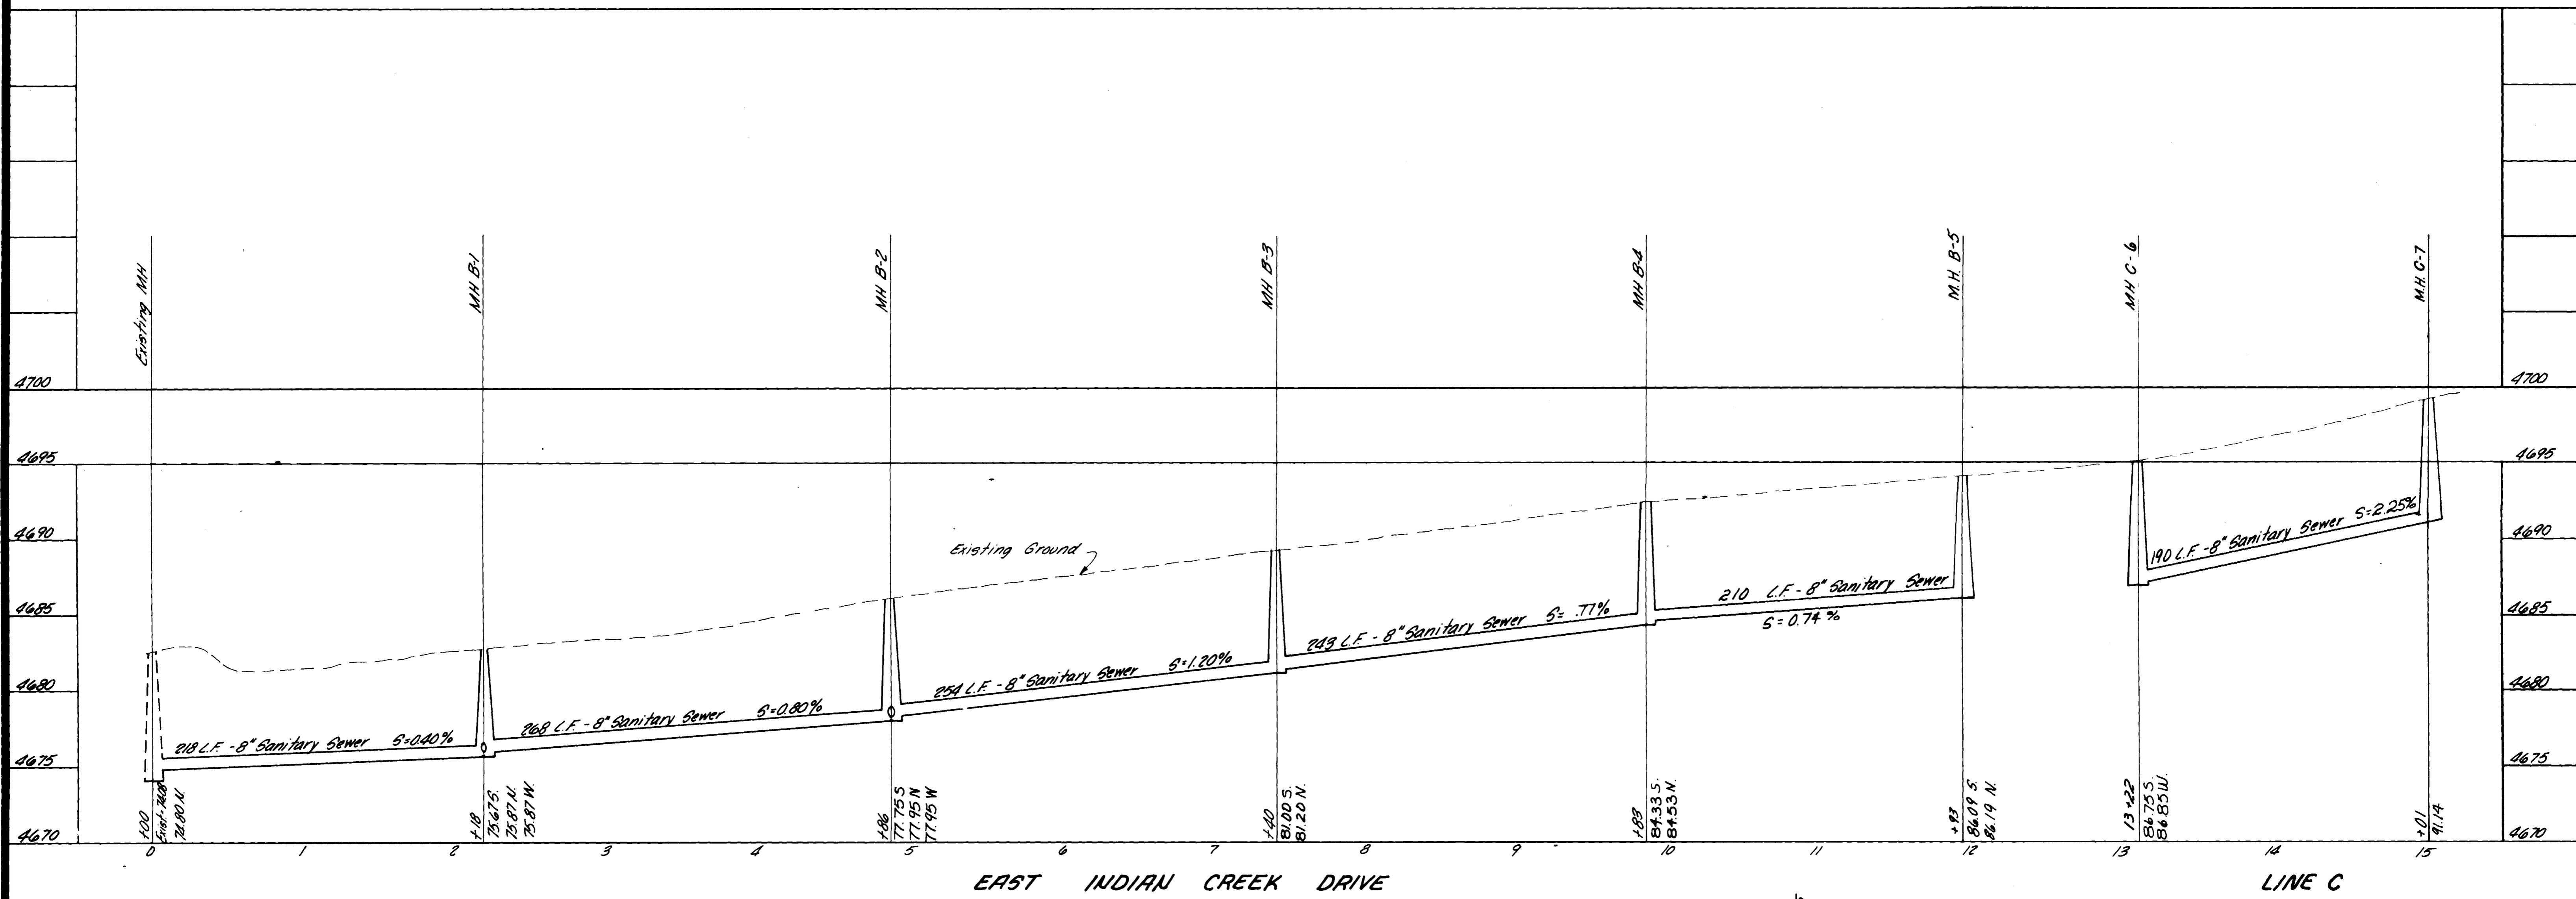

DATE: August 1977		DRAFTSMAN: P.J.S.	DEPT. HEAD:		NELSON - HALEY - PATTERSON AND QUIRK ENGINEERING CONSULTANTS GRAND JUNCTION COLORADO	INDIAN VILLAGE SUB. MESA COUNTY	SEWER PROFILES	SHEET 4 SHEETS 3
SCALE: Vertical: 1"=5' Horizontal: 1"=50'		PROJECT ENGR: E.J.S.	DATE SET:					
NO. BY DATE APPROVED		PROJECT MGR: K.M.W.						

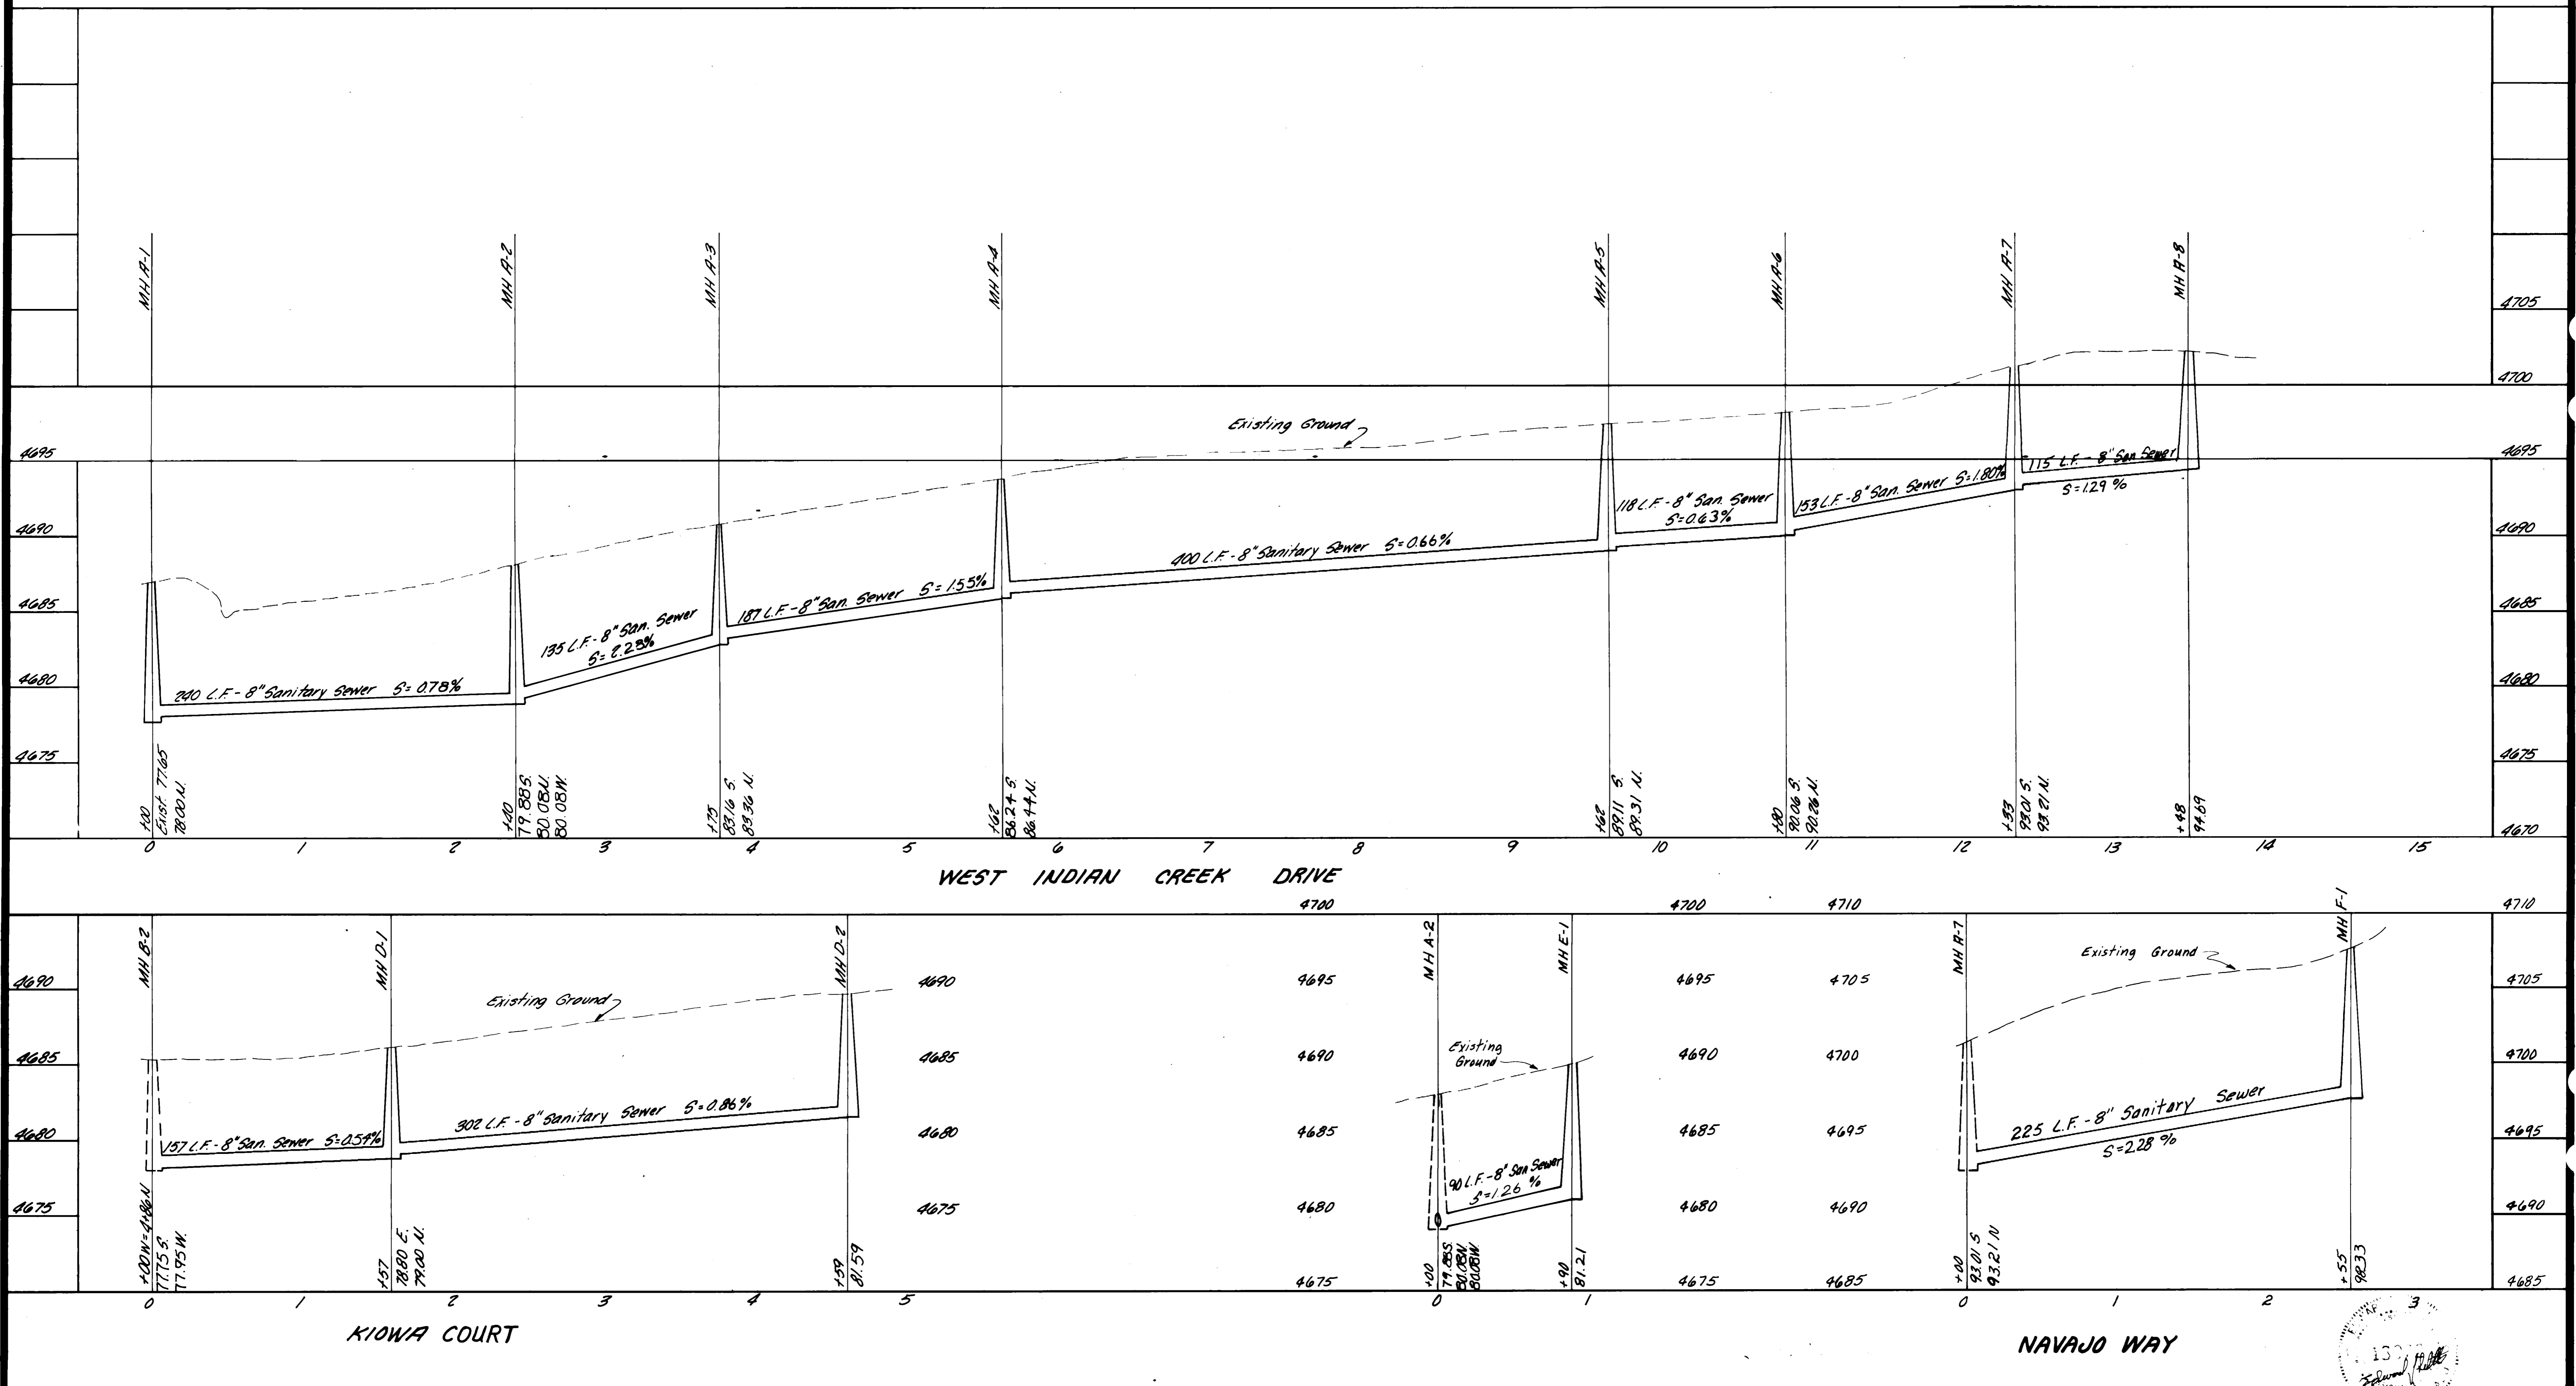

DATE August 1977	DRAWN BY P.J.S.	CHECKED BY E.J.S.	PROJECT MGR K.M.W.		NELSON - HALEY - PATTERSON AND QUIRK ENGINEERING CONSULTANTS GRAND JUNCTION COLORADO	INDIAN VILLAGE SUB. MESA COUNTY	SEWER PROFILES		SHEET 4
SCALE 1"=5' VERT. 1"=50' HORIZ.	NO.	BY	DATE						APPROVED