




SCALE 1"=50'

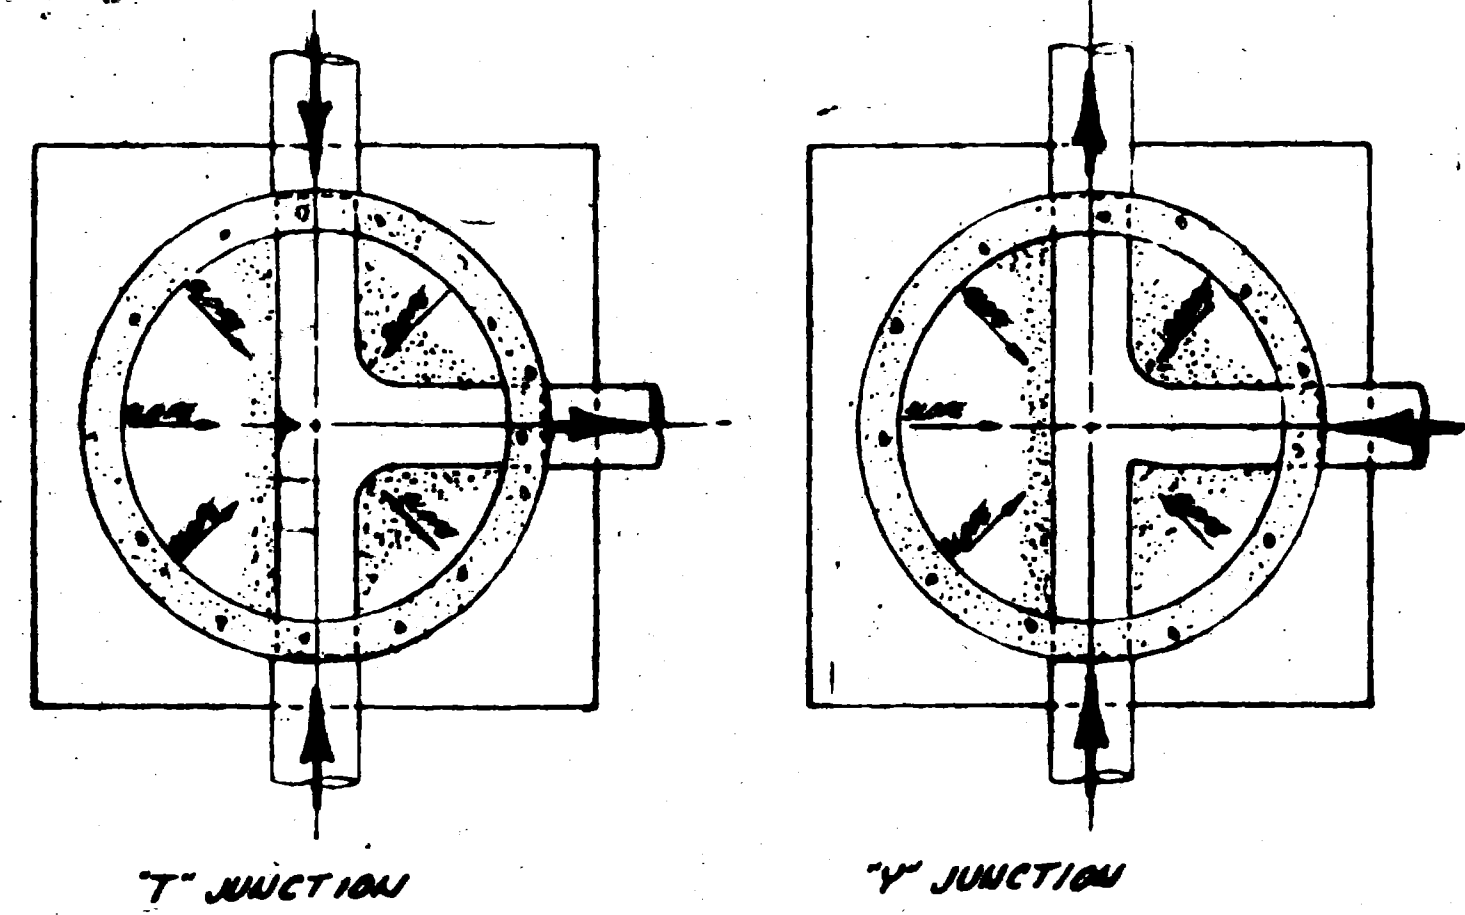

SECTION "A-A"

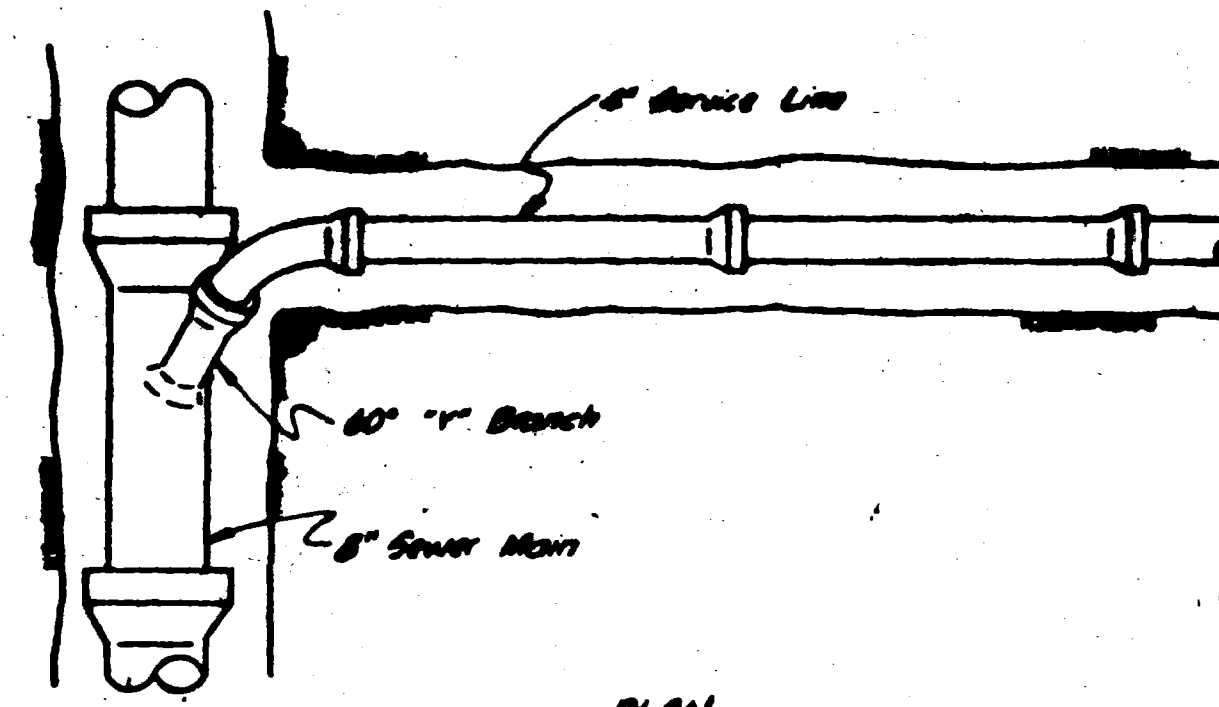


PLAN

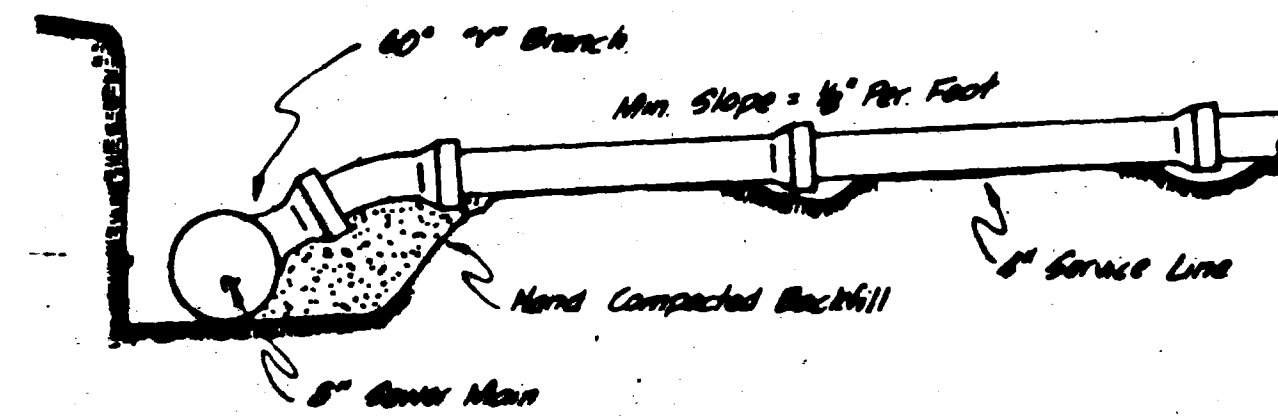


ELEVATION

STANDARD SERVICE CONNECTION  
1/8 Scale

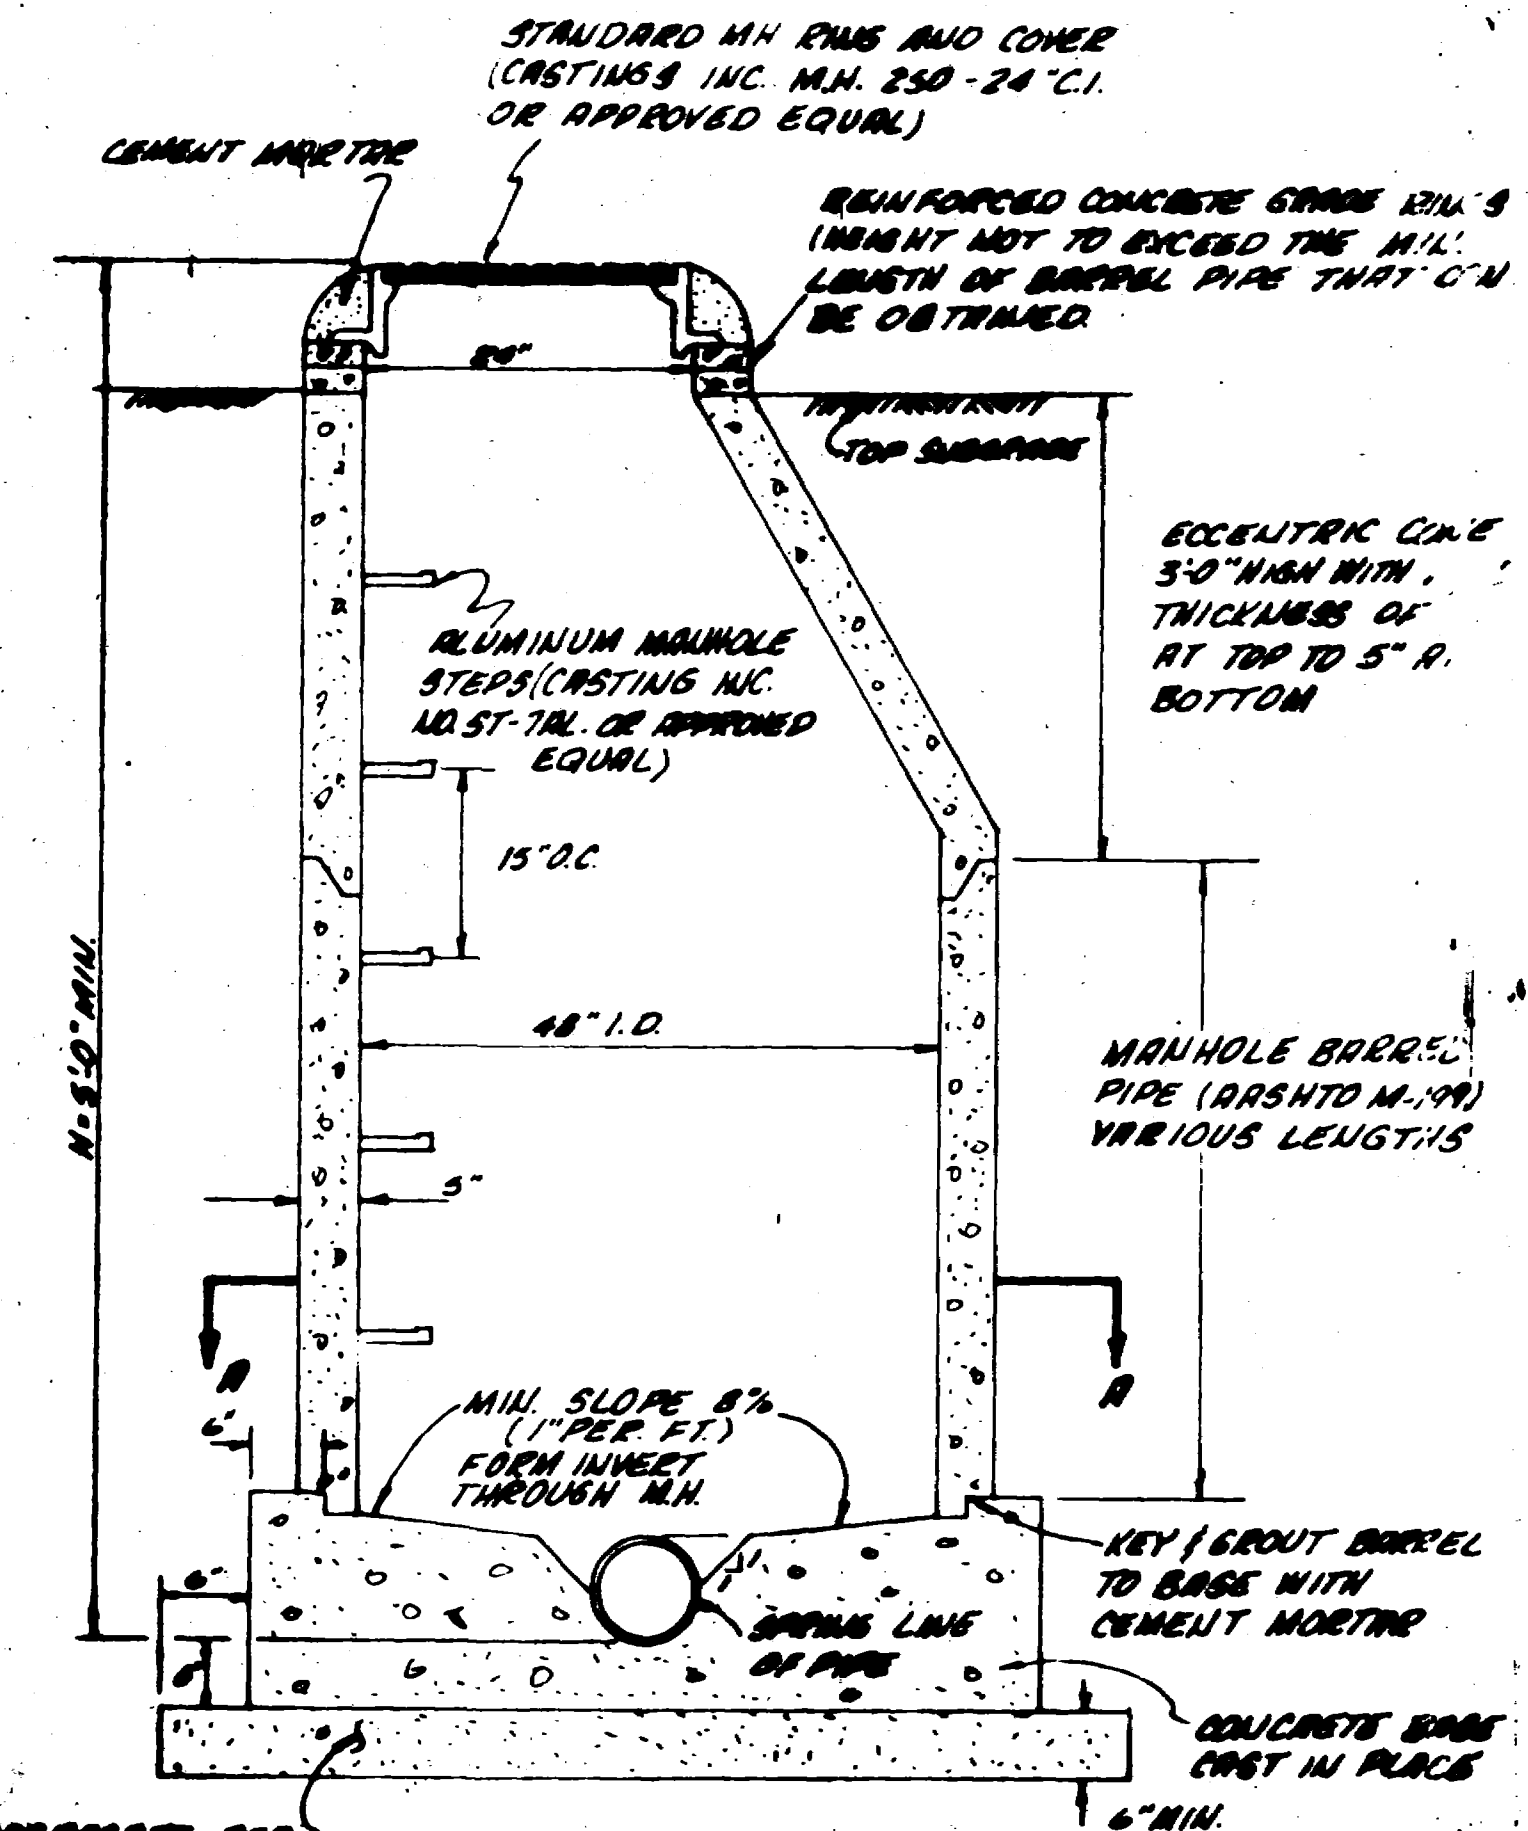

STANDARD MANHOLE

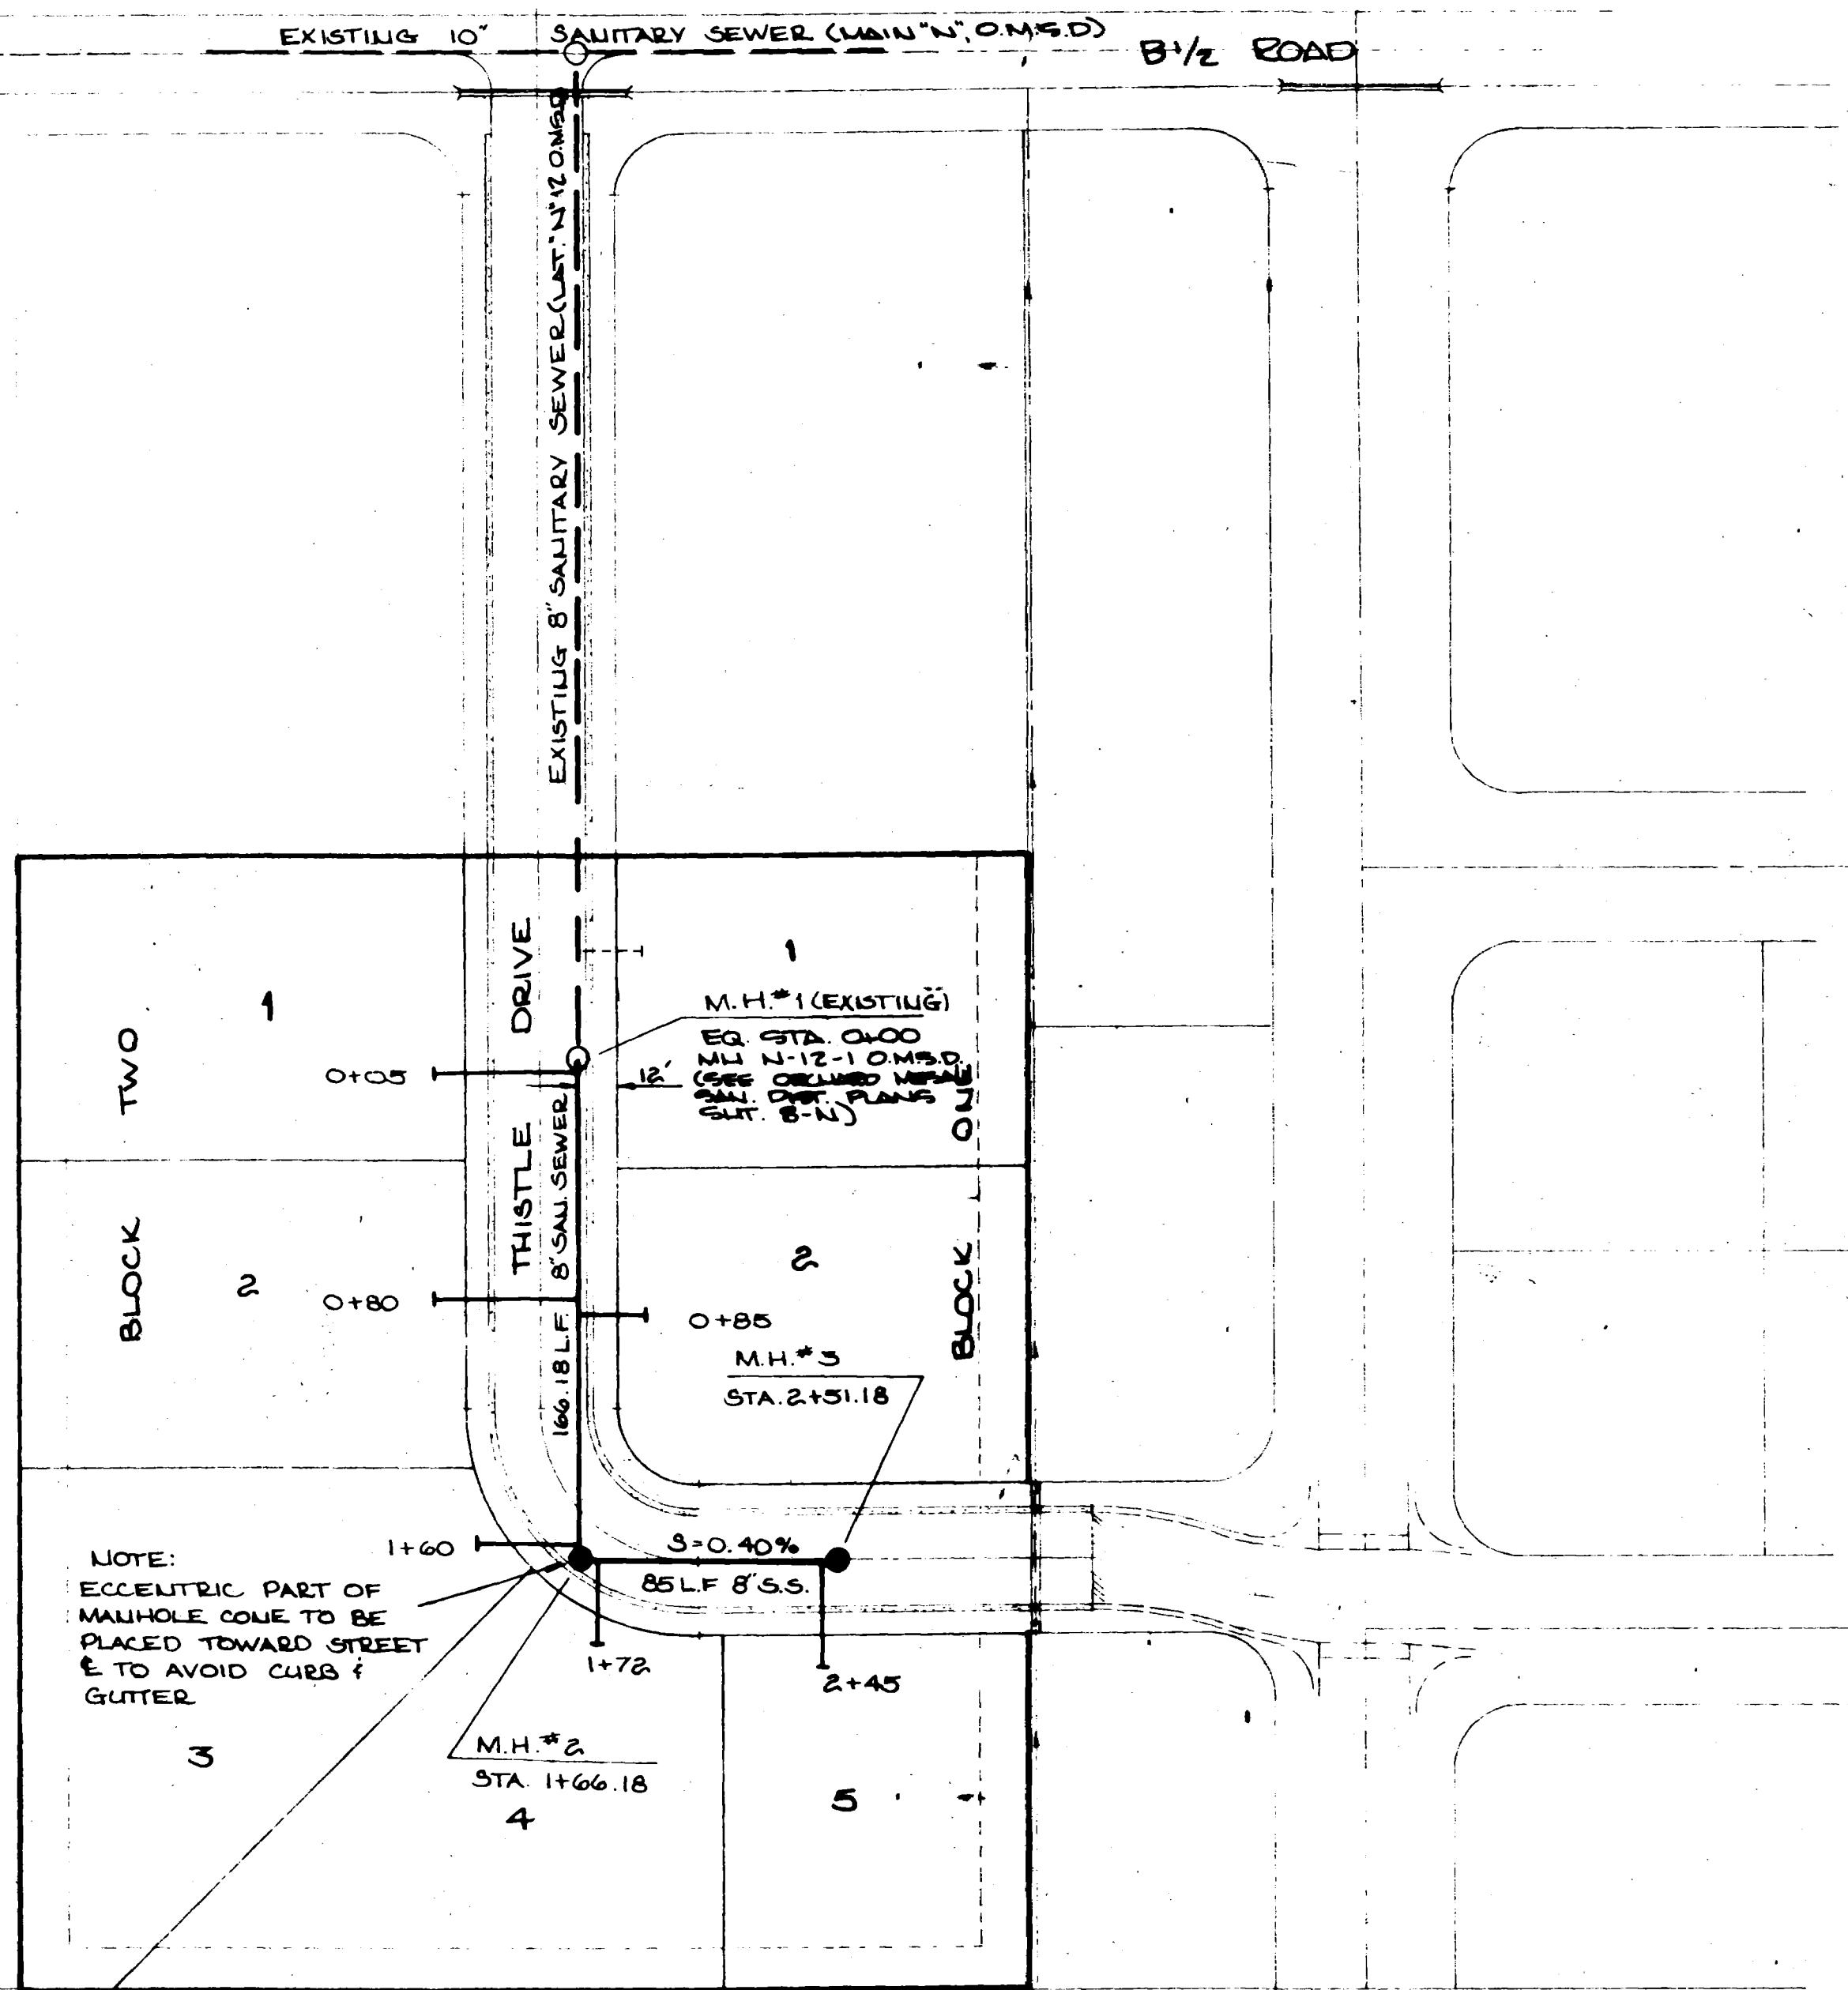


**GENERAL NOTES:**

1. TOP OF ECCENTRIC CONE TO BE SET AT TOP OF SUBGRADE (STREET CONTRACTOR TO SET RIMS TO FINISHED GRADE OF STREET)
2. ALL CONSTRUCTION TO BE DONE IN ACCORDANCE WITH ORCHARD MESA SANITATION DISTRICT SPECIFICATIONS.
3. SERVICE LINES TO BE EXTEND 10' INTO THE PROPERTY LINES.

**QUANTITIES:**

1. 250 LF. 8" SALUTARY SEWER
2. STANDARD MANHOLES
6. 4" SERVICE CONNECTIONS

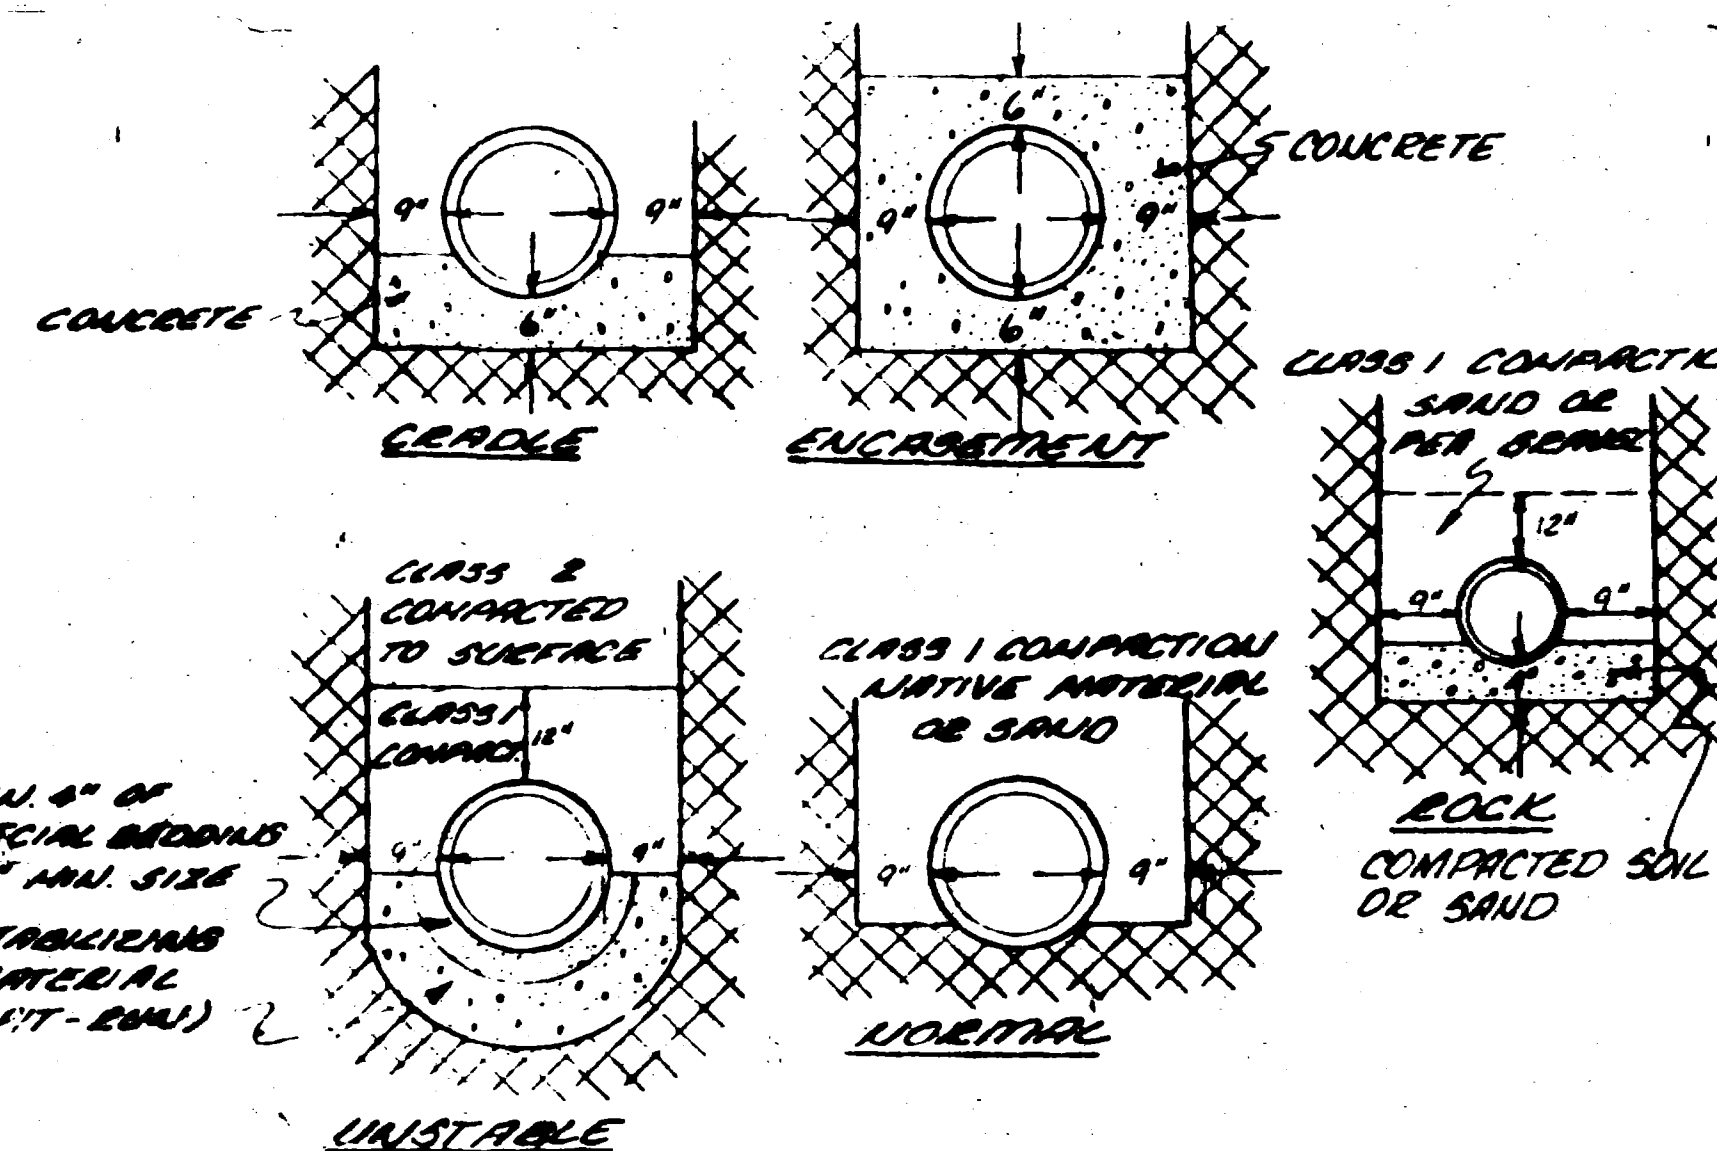

TYPICAL BEDDING DETAIL

N.B. MOUND DIG FOR BELL OR COUPLING

NOTE: This is to certify that the system infiltration does not exceed 100 gallons per inch diameter per mile of length per day.

AS BUILT DRAWING

|           |  |
|-----------|--|
| CHECKED   |  |
| DATE      |  |
| AUG. 1979 |  |
| SCALE     |  |
| 1" = 50'  |  |

|                 |    |
|-----------------|----|
| REVISIONS       | BY |
| INJECTS 2-19-80 | DM |
|                 |    |
|                 |    |

**PARAGON ENGINEERING, INC.**

P. O. Box 2872  
Grand Junction, Colorado 81501 (303) 243-8866

*Handwritten signature*

THISTLE DRIVE SUBDIVISION

SALUTARY SEWER AND DETAILS

|       |          |
|-------|----------|
| SHEET | 1        |
| OF    | 1 SHEETS |