

NOTE:

1. ALL EXISTING SEWER LINES AND MANHOLES ARE WITHIN THE SYSTEM OF VILLAGE NINE - PHASE II SHEET 6 OF 9.
2. THE SEWER LINE SHALL BE CONSTRUCTED ACCORDING TO THE SPECIFICATIONS AND STANDARD DETAILS OF THE ORCHARD MESA SANITATION DISTRICT.
3. TAPS TO LOTS 29-30 AND 31-32 WILL BE LAID IN THE SAME TRENCH.

APPROVAL: *Thomas Blaback* 11 Dec 2000
 UTILITY COORDINATING COMMITTEE DATE


Richard A. ...



SCALE: 1" = 20'

AS BUILT

 Atkins & Associates CONSULTING ENGINEERS	1 12/20/00 Add Fire Hydrant & 6" Line		1 1
	DATE 11/20 P/S	DR. 00-00	REVISION 1" = 20'
OXFORD AVENUE PHASE - 2 Block 6			

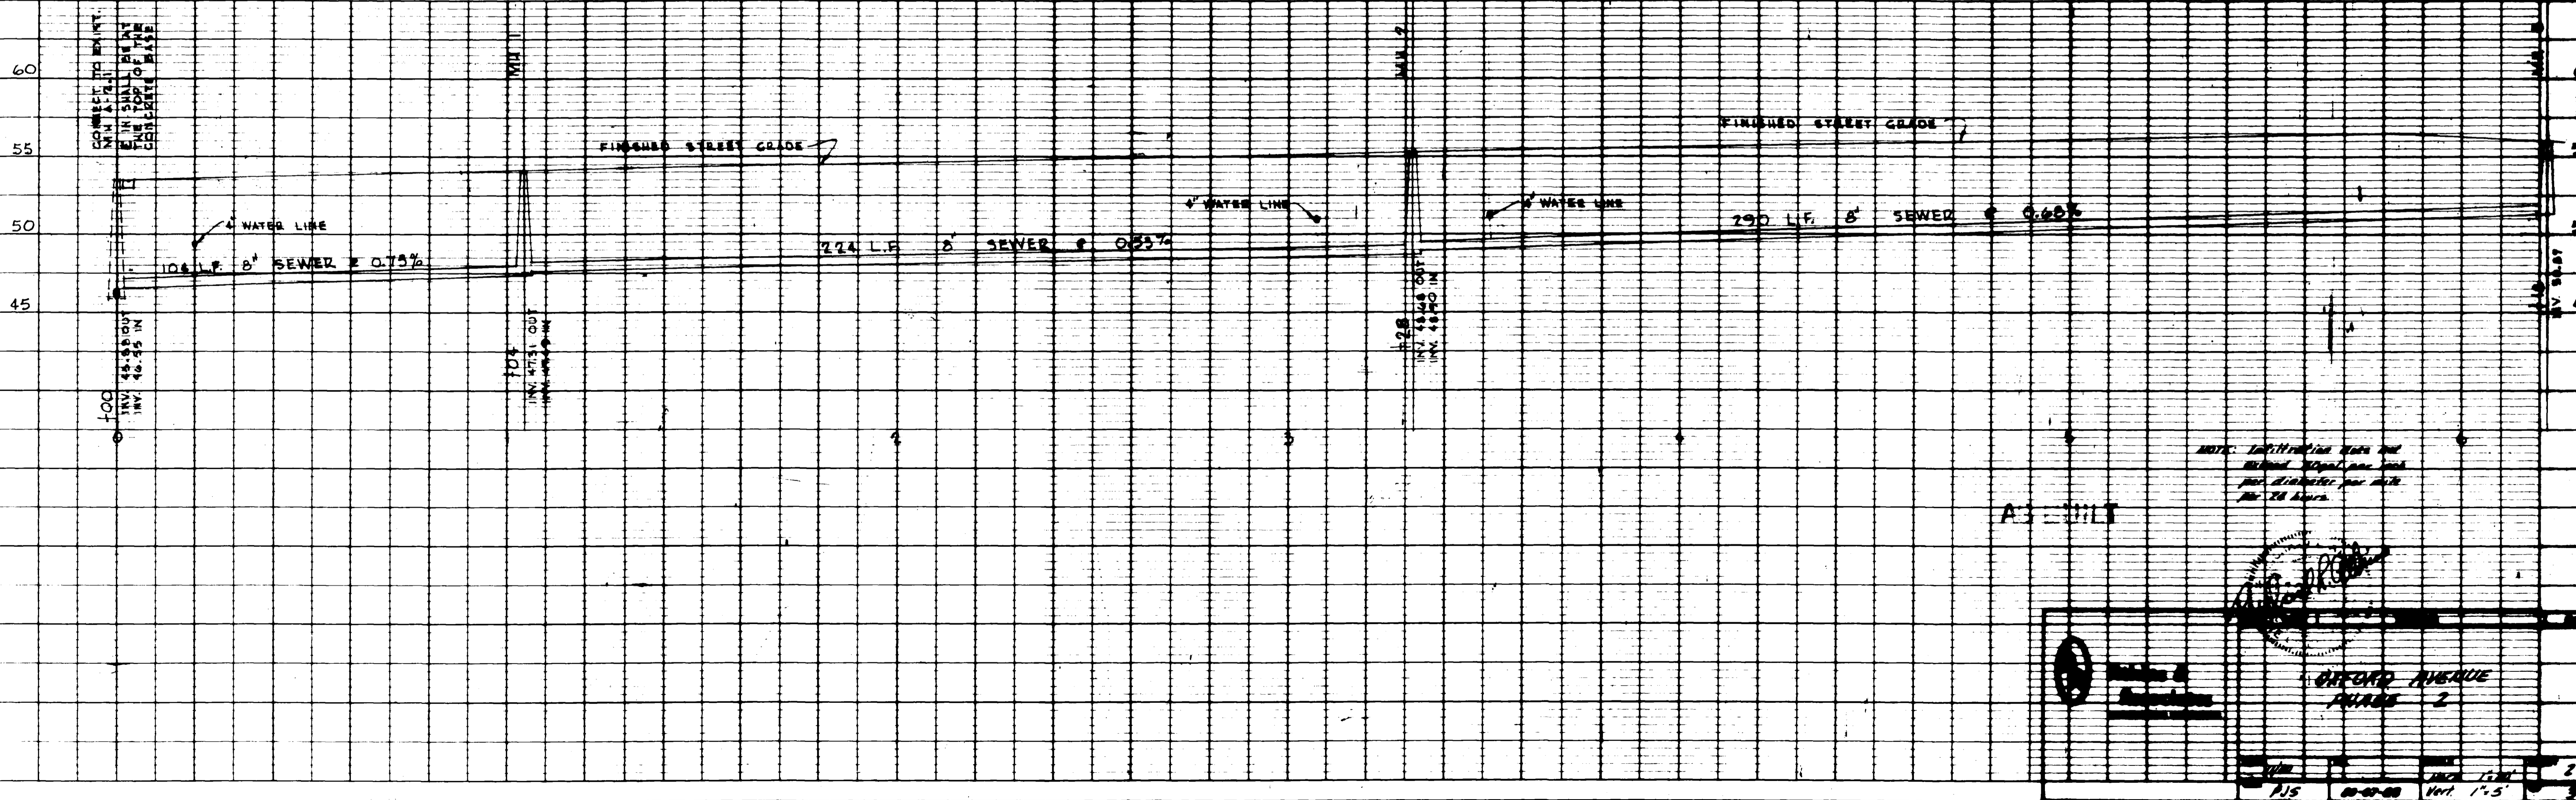

CONNECT TO EXIST.
 12 IN. 15 PSI
 12 IN. 15 PSI
FOO
 INV. 48.80 FT
 INV. 46.95 IN

MAN. 2


10" W/ST OUT
 INV. 48.80 FT
 INV. 46.95 IN

MAN. 2

12" W/ST OUT
 INV. 48.80 FT
 INV. 46.95 IN

NOTE: INSTALLATION WITH THE
 EXISTING WATER LINE
 FOR 24 HOURS

AS SHOWN


 OFFICE OF
 ENGINEERING
 AND SURVEYING
 STATE OF CALIFORNIA
 CIVIL ENGINEER
 No. 12345
 EXPIRES 12/31/2010

OXFORD AVENUE
 PHASE 2

DATE: 08-01-08
 DRAWN BY: PJS
 SCALE: 1"=5'
 SHEET: 2 OF 3