



REVISIONS	BY


**PARAGON ENGINEERING, INC.**  
P.O. Box 3872  
Grand Junction, Colorado 81502

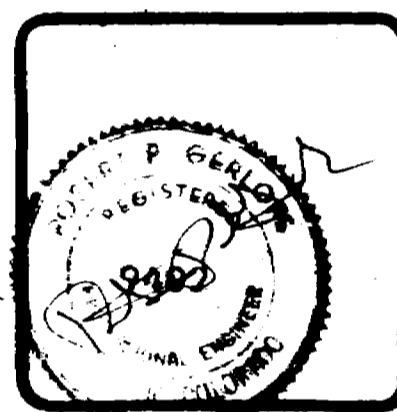


SANITARY SEWER & DOMESTIC WATER  
PLANS, PROFILES & DETAILS  
VALLEY WEST WATER & SANITATION DISTRICT  
VALLEY WEST FILING NO. 3  
MESEA COUNTY, COLORADO

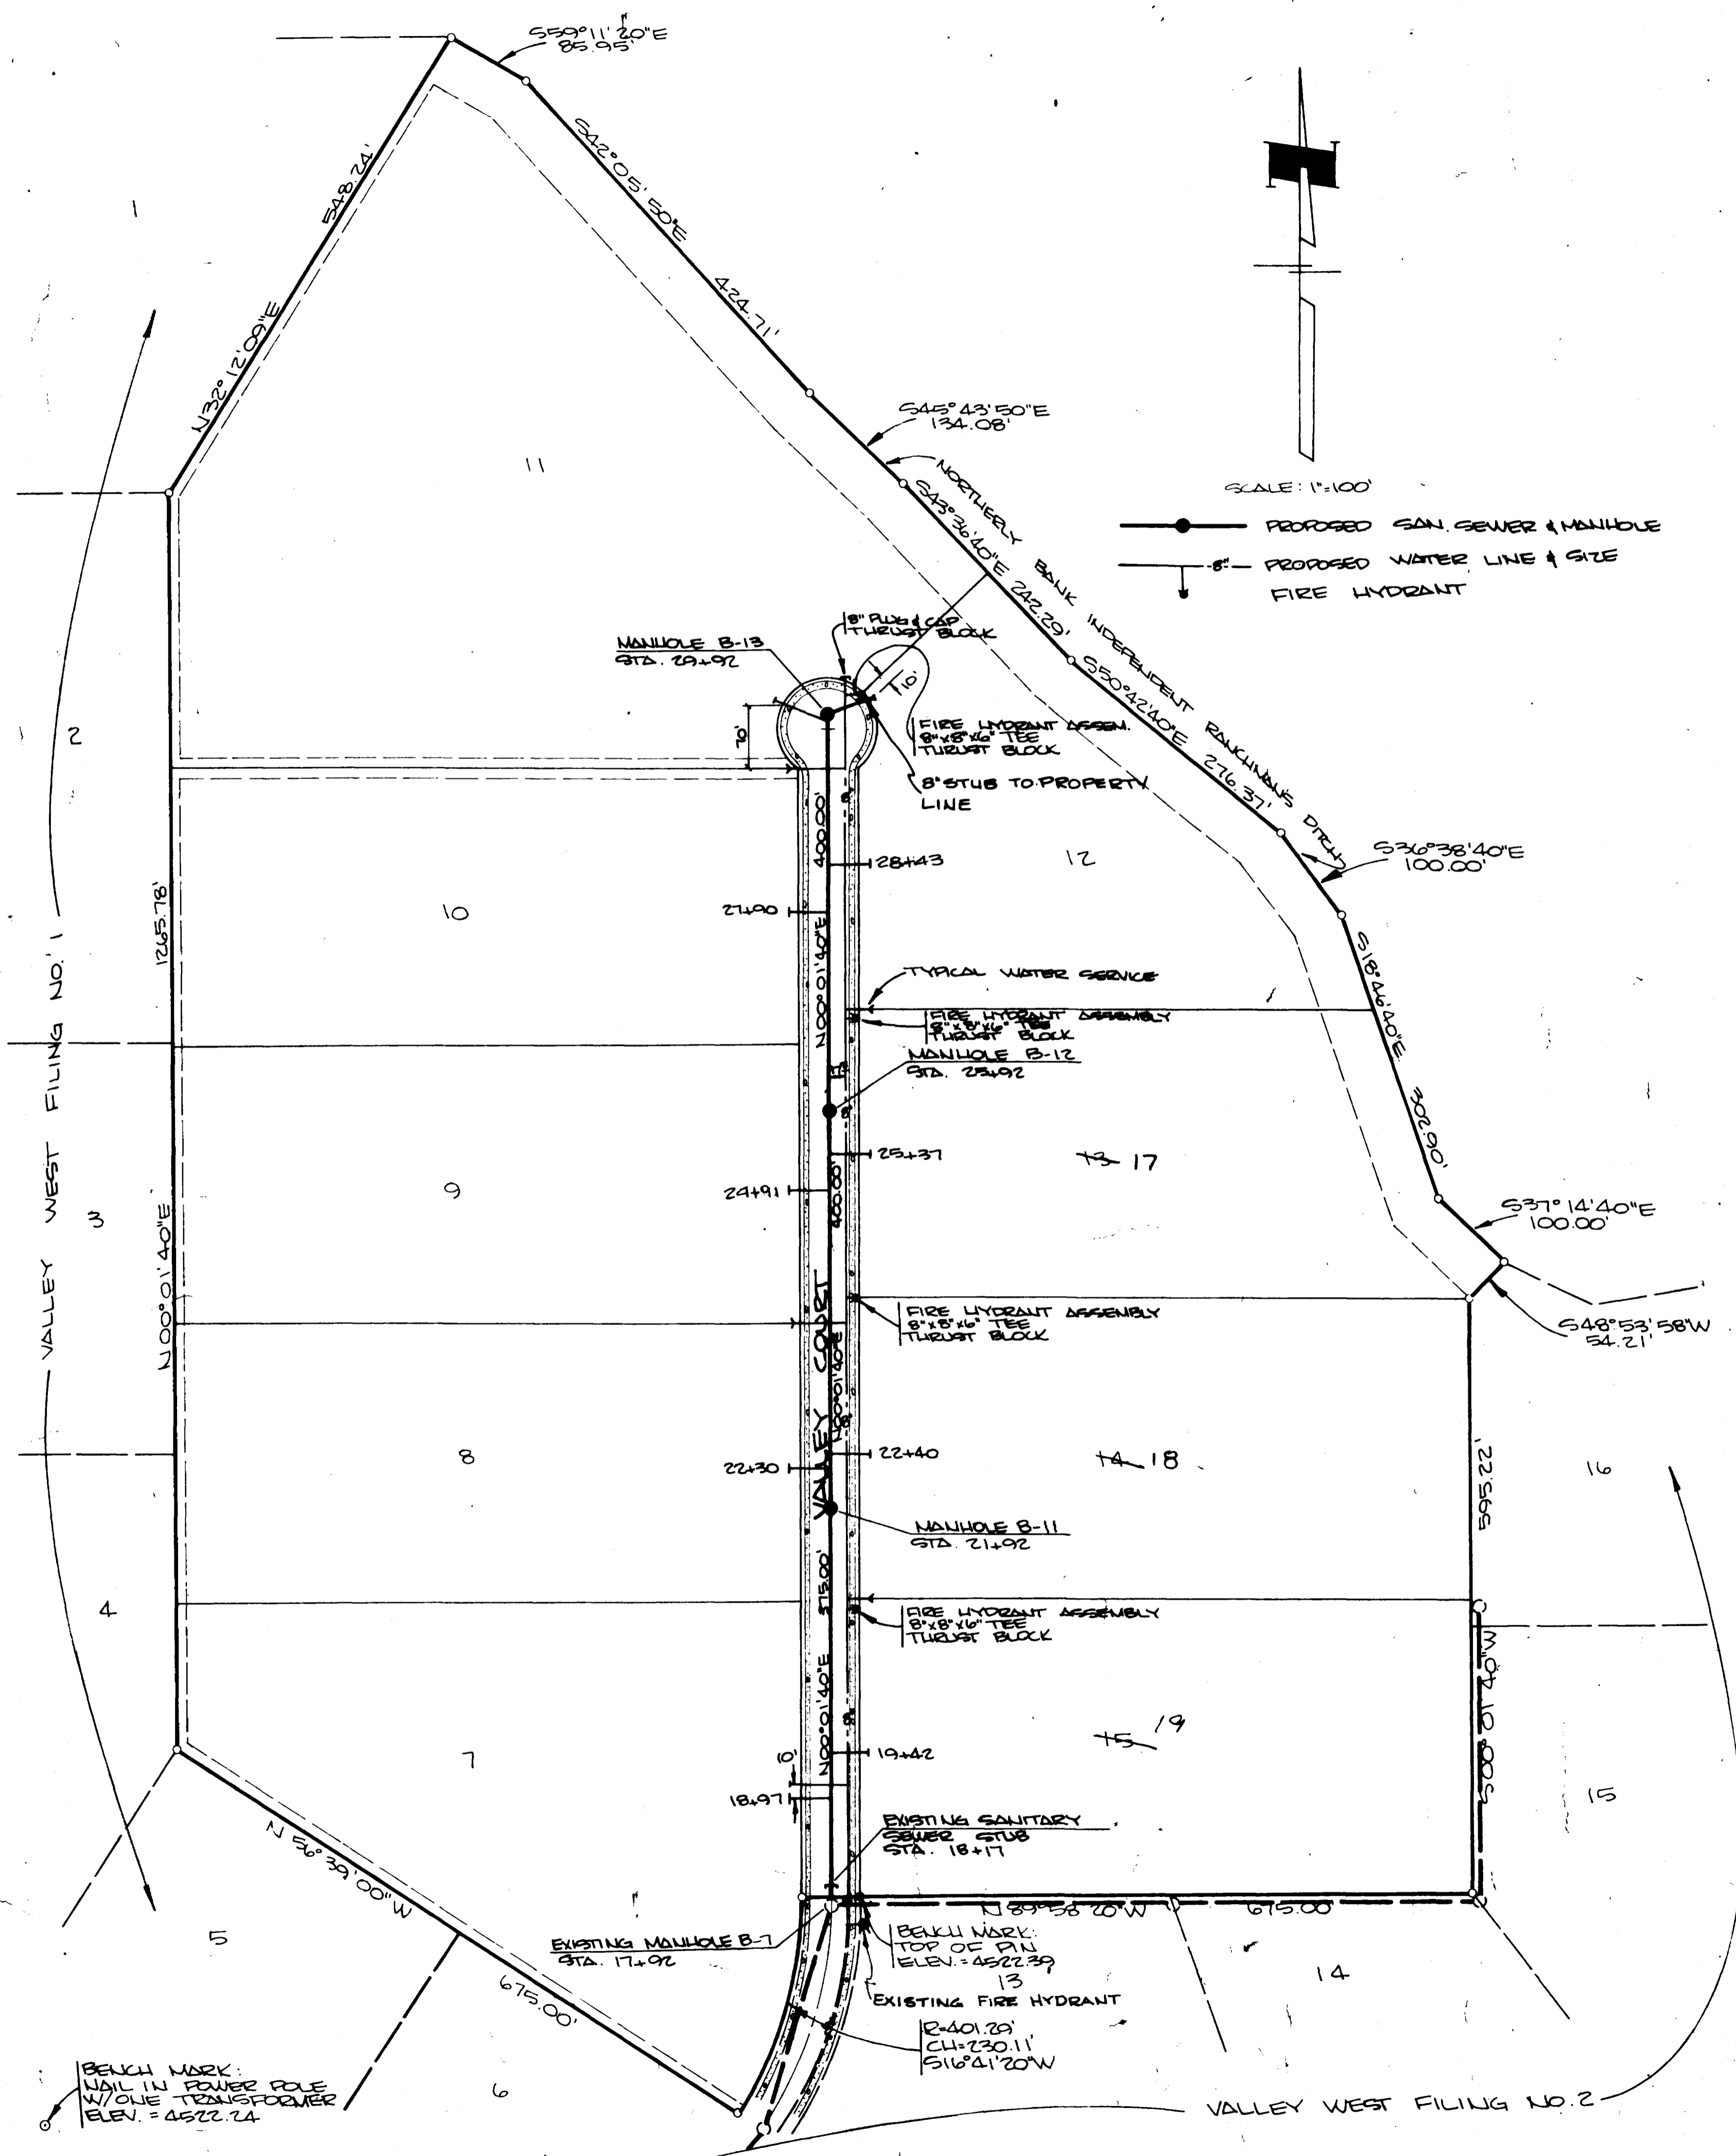


**AS BUILT DRAWINGS**

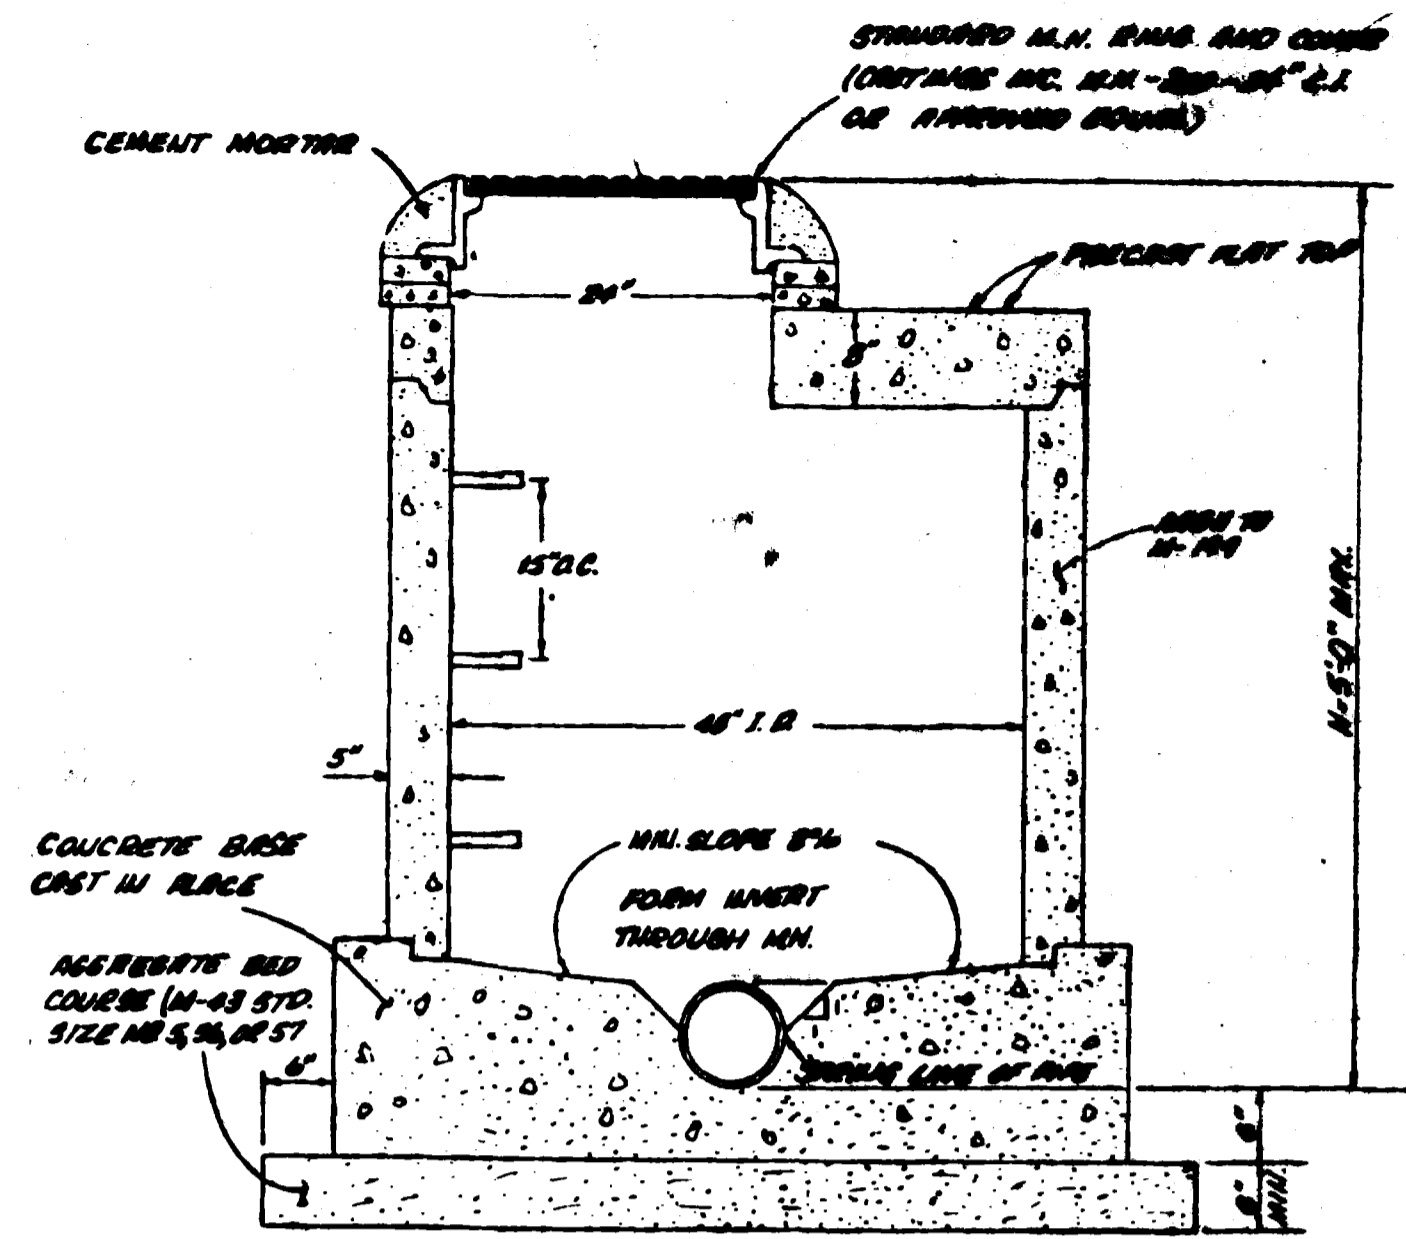

**STANDARD SHALLOW MANHOLE**

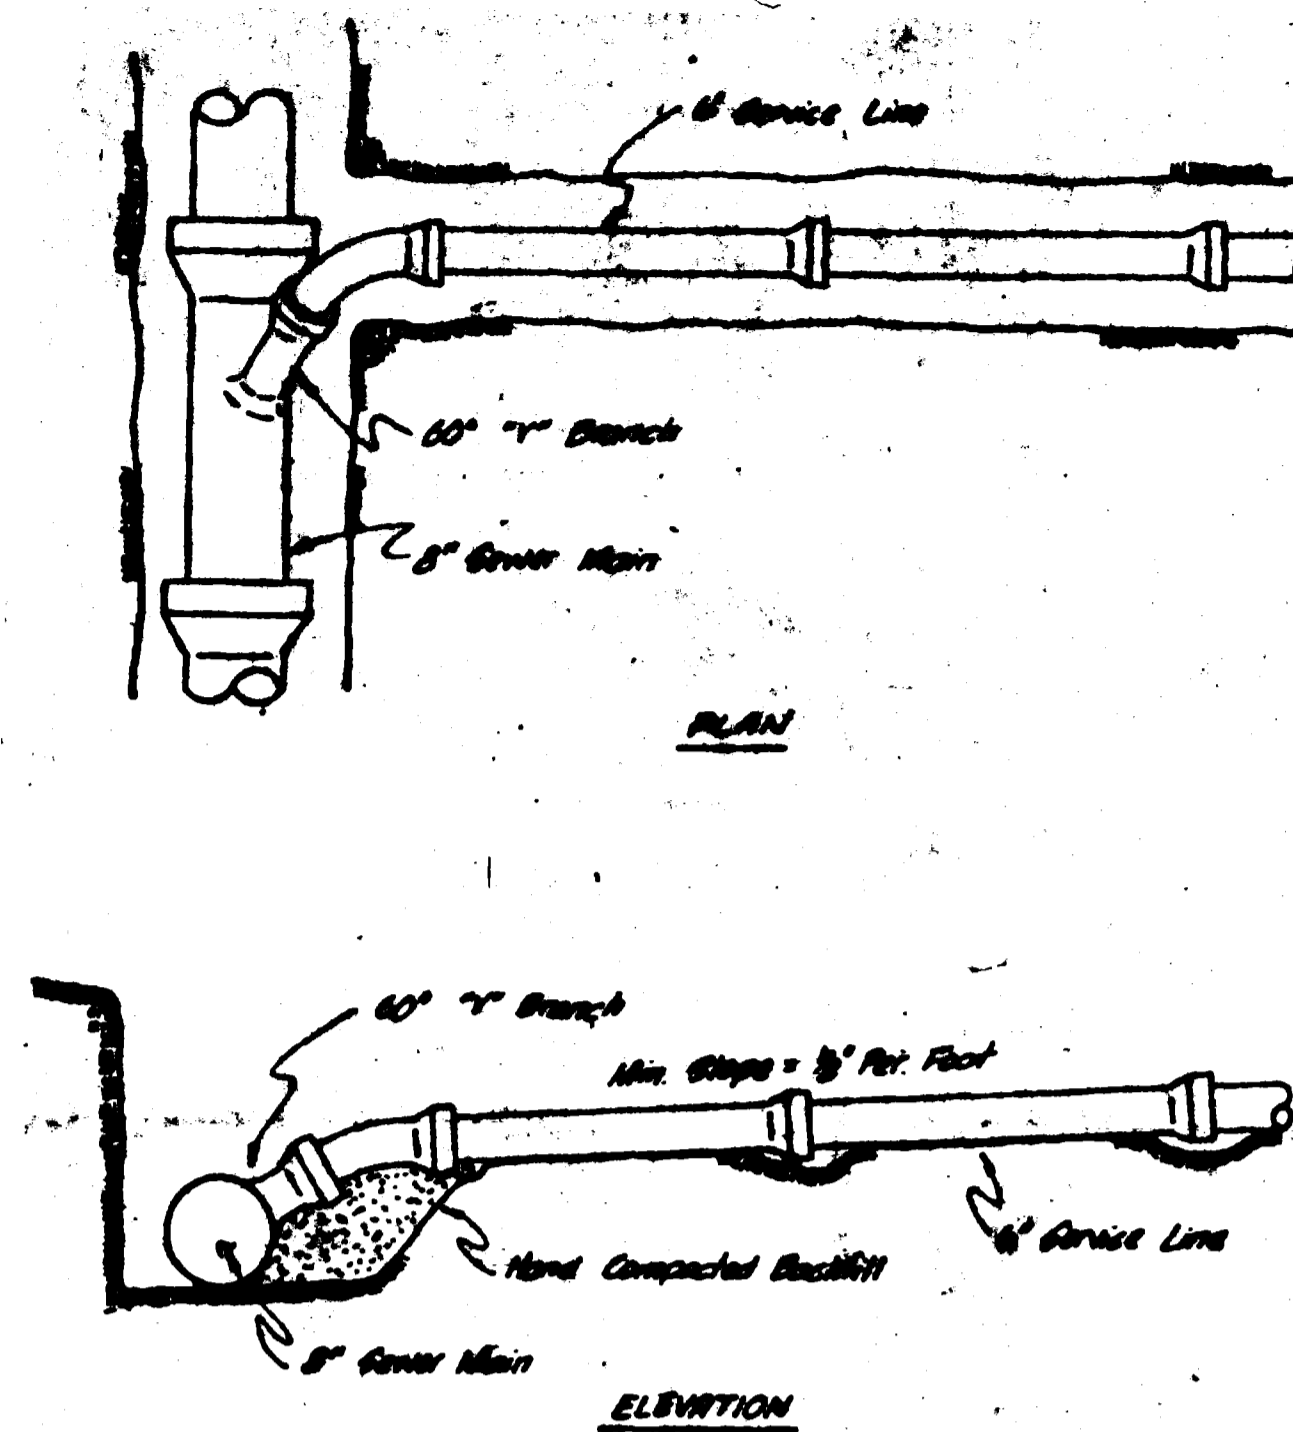

**STANDARD SERVICE CONNECTION**  
As Built

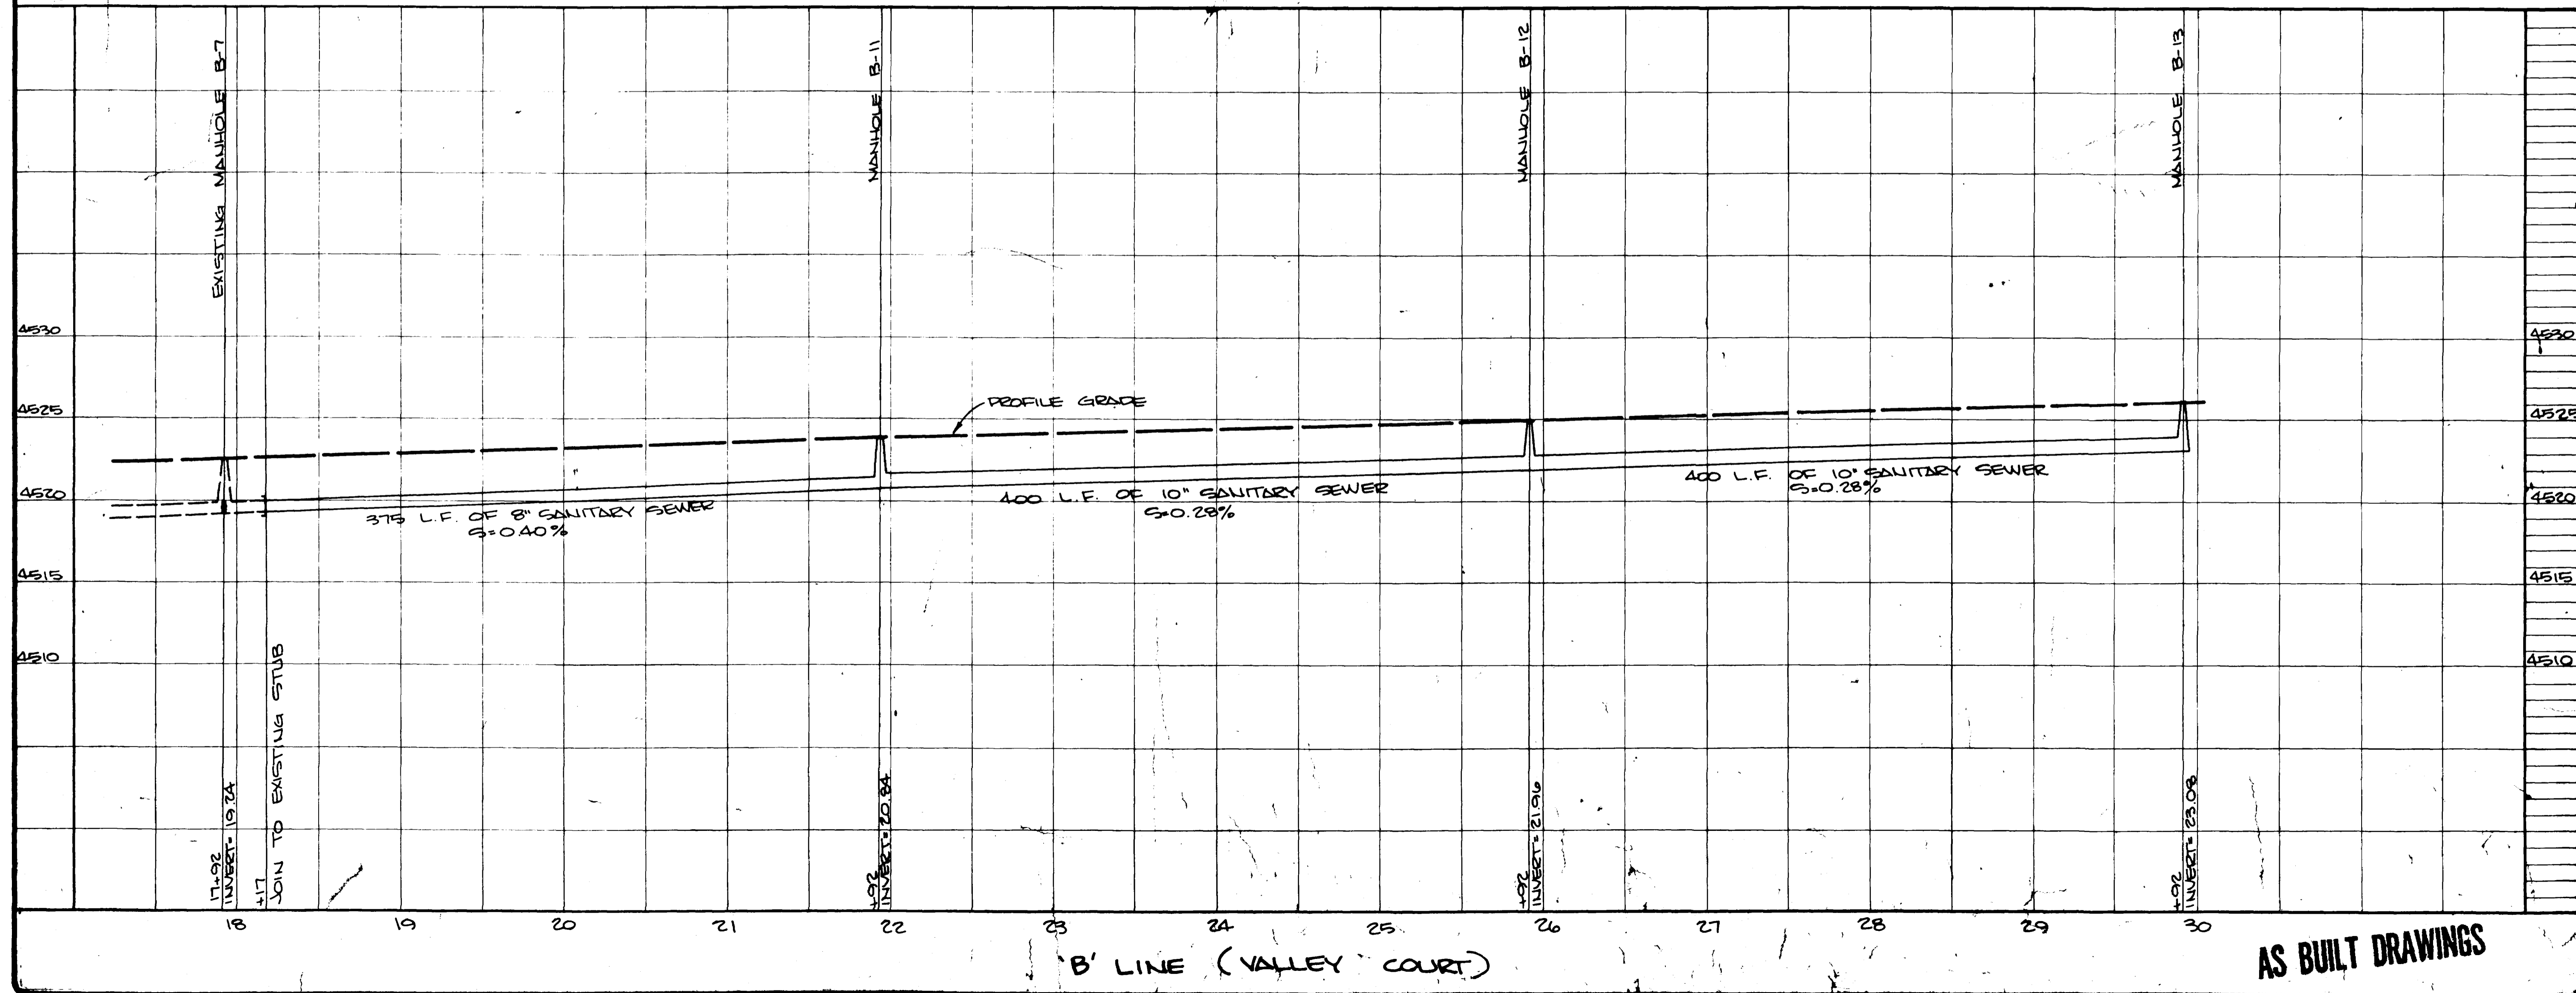


**AS BUILT DRAWINGS**

CHECKED
DATE
NOVEMBER, 1980
SCALE
HOR. SCALE - 1" = 30'
VERT. SCALE - 1" = 5'

REVISIONS	BY

**PARAGON ENGINEERING, INC.**  
1001 Box 2872  
DENVER, COLORADO 80202

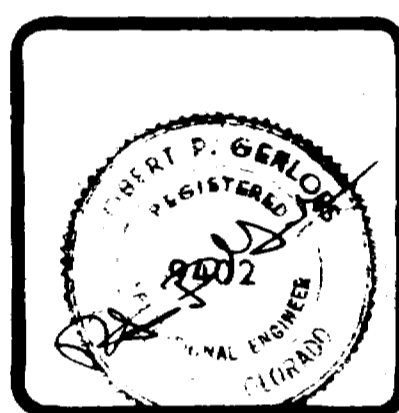

**SANITARY SEWER PROFILES & DETAILS**  
**VALLEY WEST WATER & SANITATION DISTRICT**  
**VALLEY WEST FILING No. 3**  
MEAD COUNTY, COLORADO

SHEET
2
OF 4 SHEETS