




REVISIONS	BY
6-25-80	

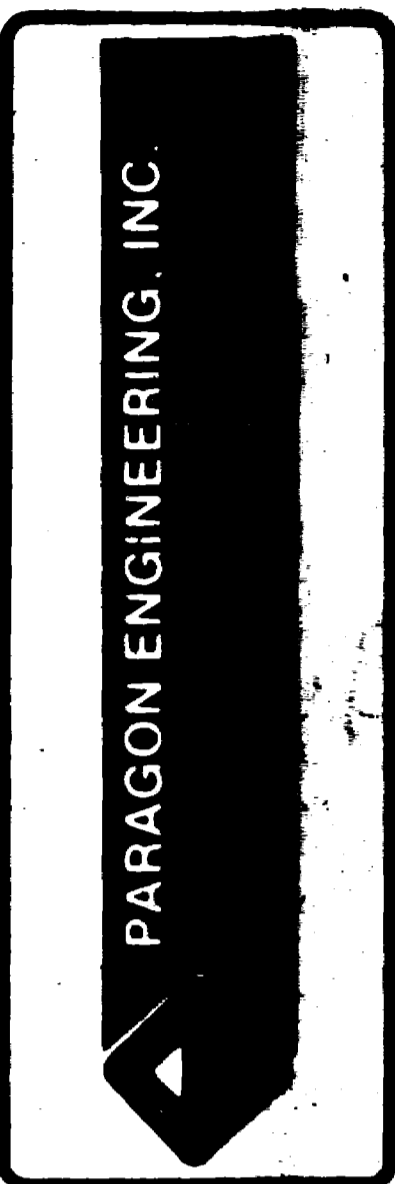

Parkwood Estates
Filing No. One
Mesa County, Colorado
Sanitary Sewer Plan

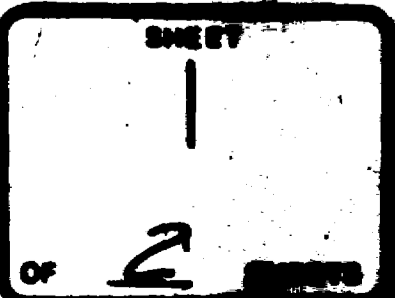

Parkwood Estates, Filing No. Two

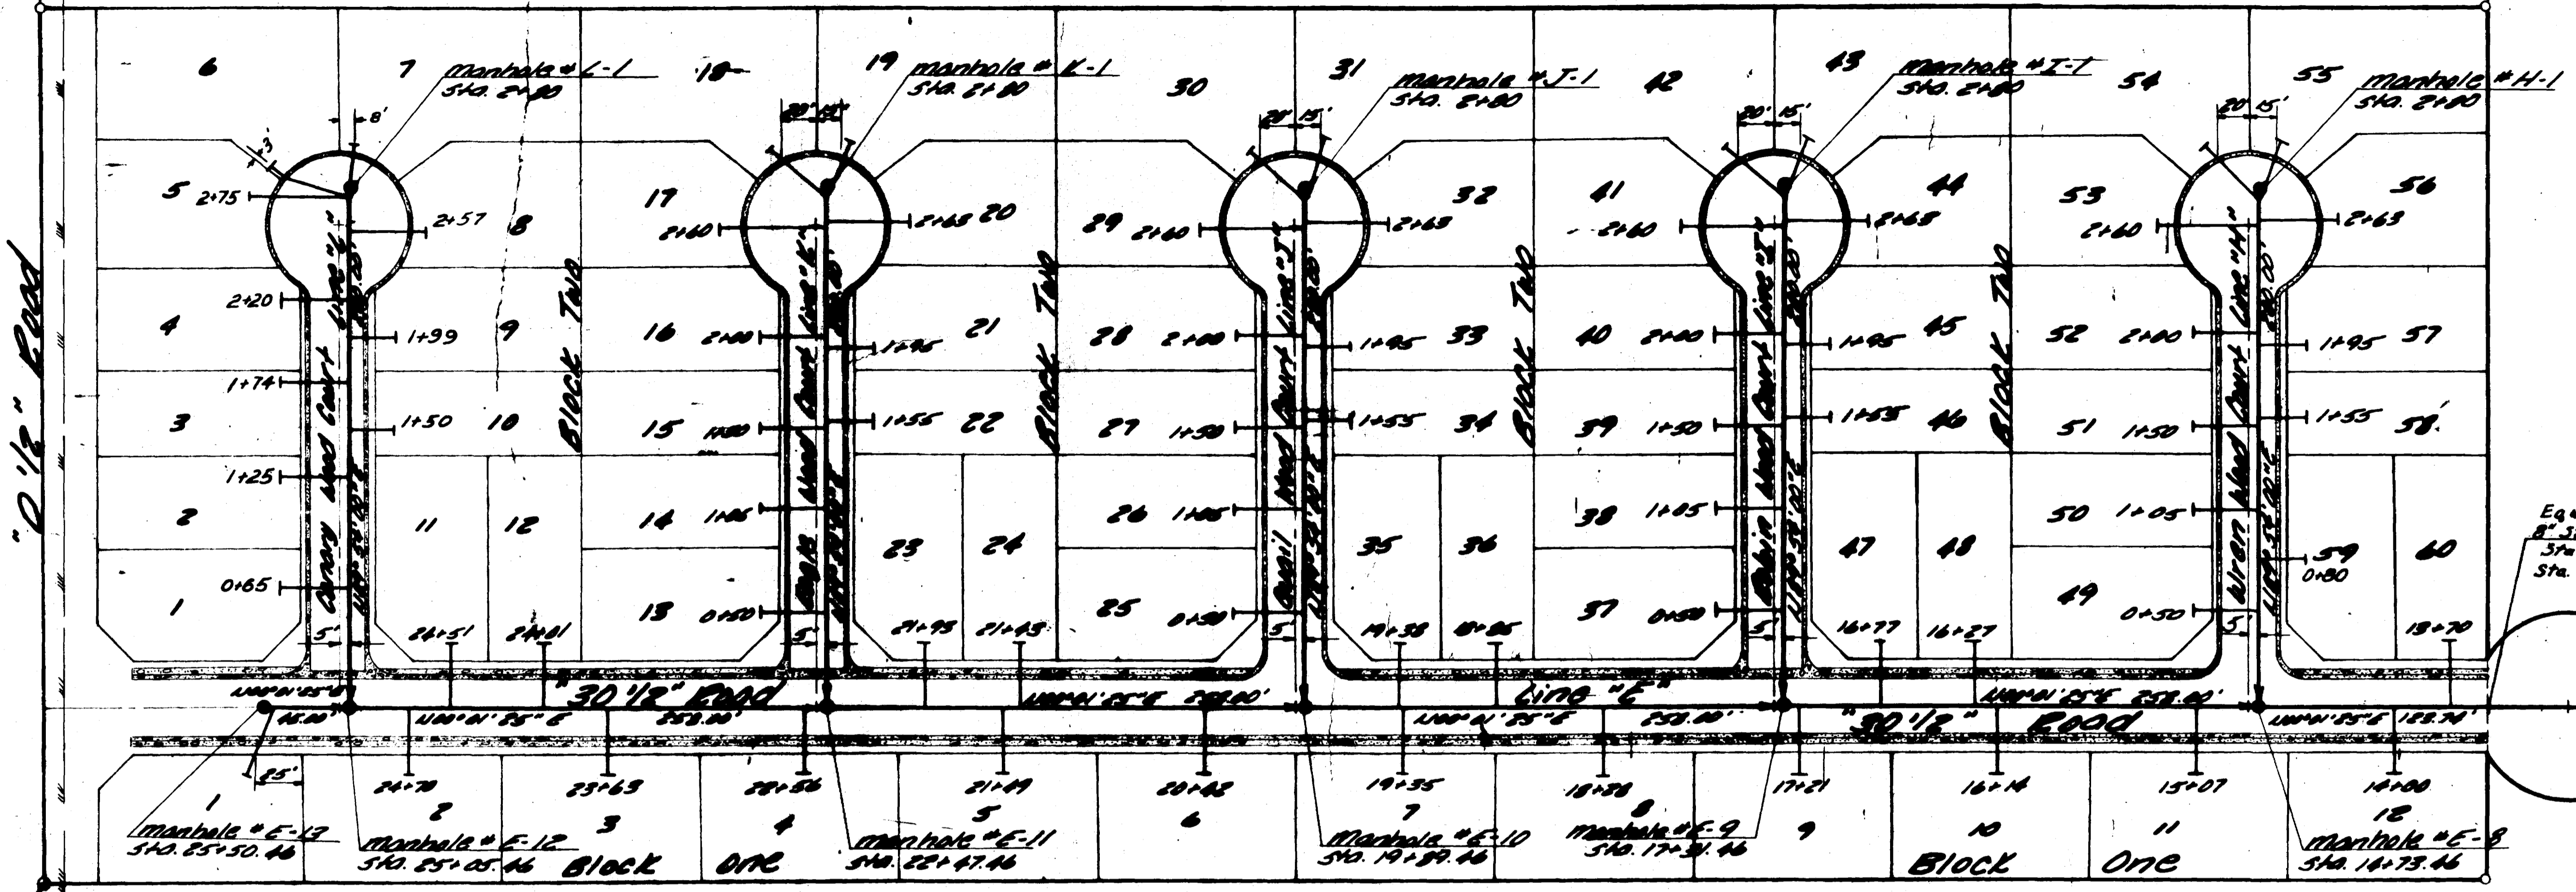


Equation Station
8" Station Filing #2
Sta. 13+49.72 Filing #1
Sta. 10+43.57 Filing #2

bench mark: CROSS CAP
ELEVATION = 4636.85

General Notes:

- 1) All construction to be done in accordance with the Central Grand Valley Sanitation District specifications.
- 2) Service connections are to extend 10ft. inside property line.
- 3) Sewer services shall be a minimum of 10 ft. from water services on the downhill side.
- 4) Top of eccentric cover to be set at top of subgrade. (Street contractor to set manhole rims to finish grade of street.)

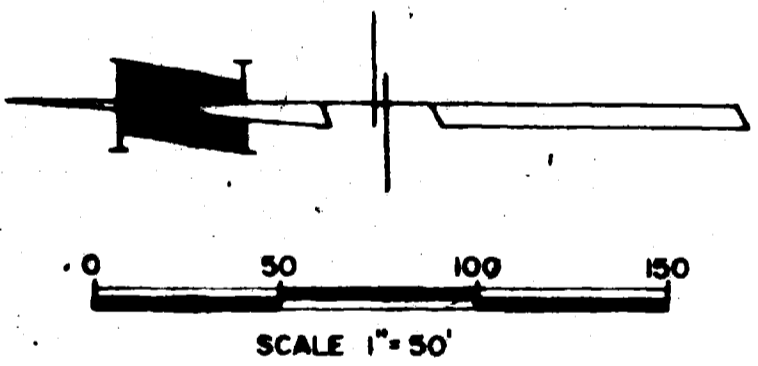


SEWER QUANTITIES:
2601 L.F. 8" sanitary sewer line
11 - standard manholes
72 - 4" standard service connections
2270 L.F. 4" service connection line
4871 L.F. OF TRENCH CONSTRUCTION

NOTE:
This is to certify that the system installation does not exceed 200 gallons per inch diameter per mile of length per day.

AS BUILT DRAWINGS

CHECKED
DATE
March 1980
1" = 5' SCALE
1" = 50' HORIZ
REVISIONS
6-24-80
BY
LR

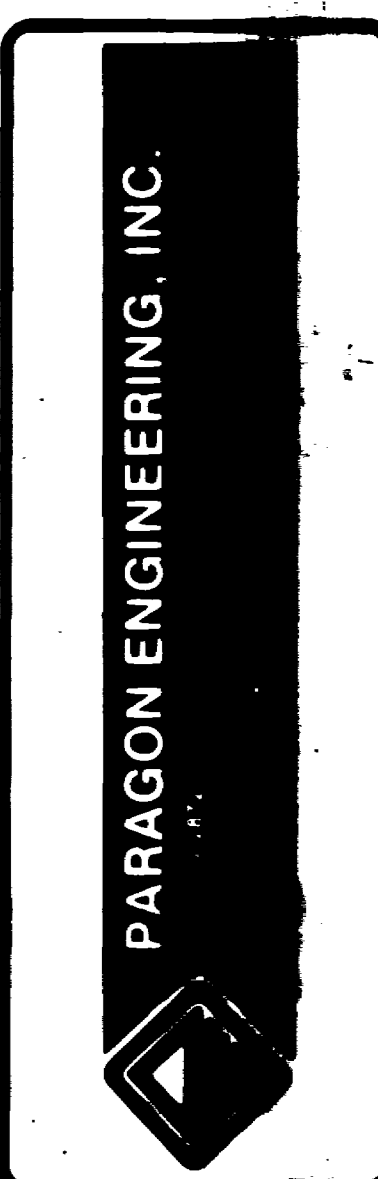

Parkwood Estates
 Filing No. 008
 Mesa County, Colorado
 Sanitary Sewer Profiles

SHEET
0
OF
2
SHEETS

