



NW CORNER, SW 1/4, 21.5, 18th Twp, R. 23E

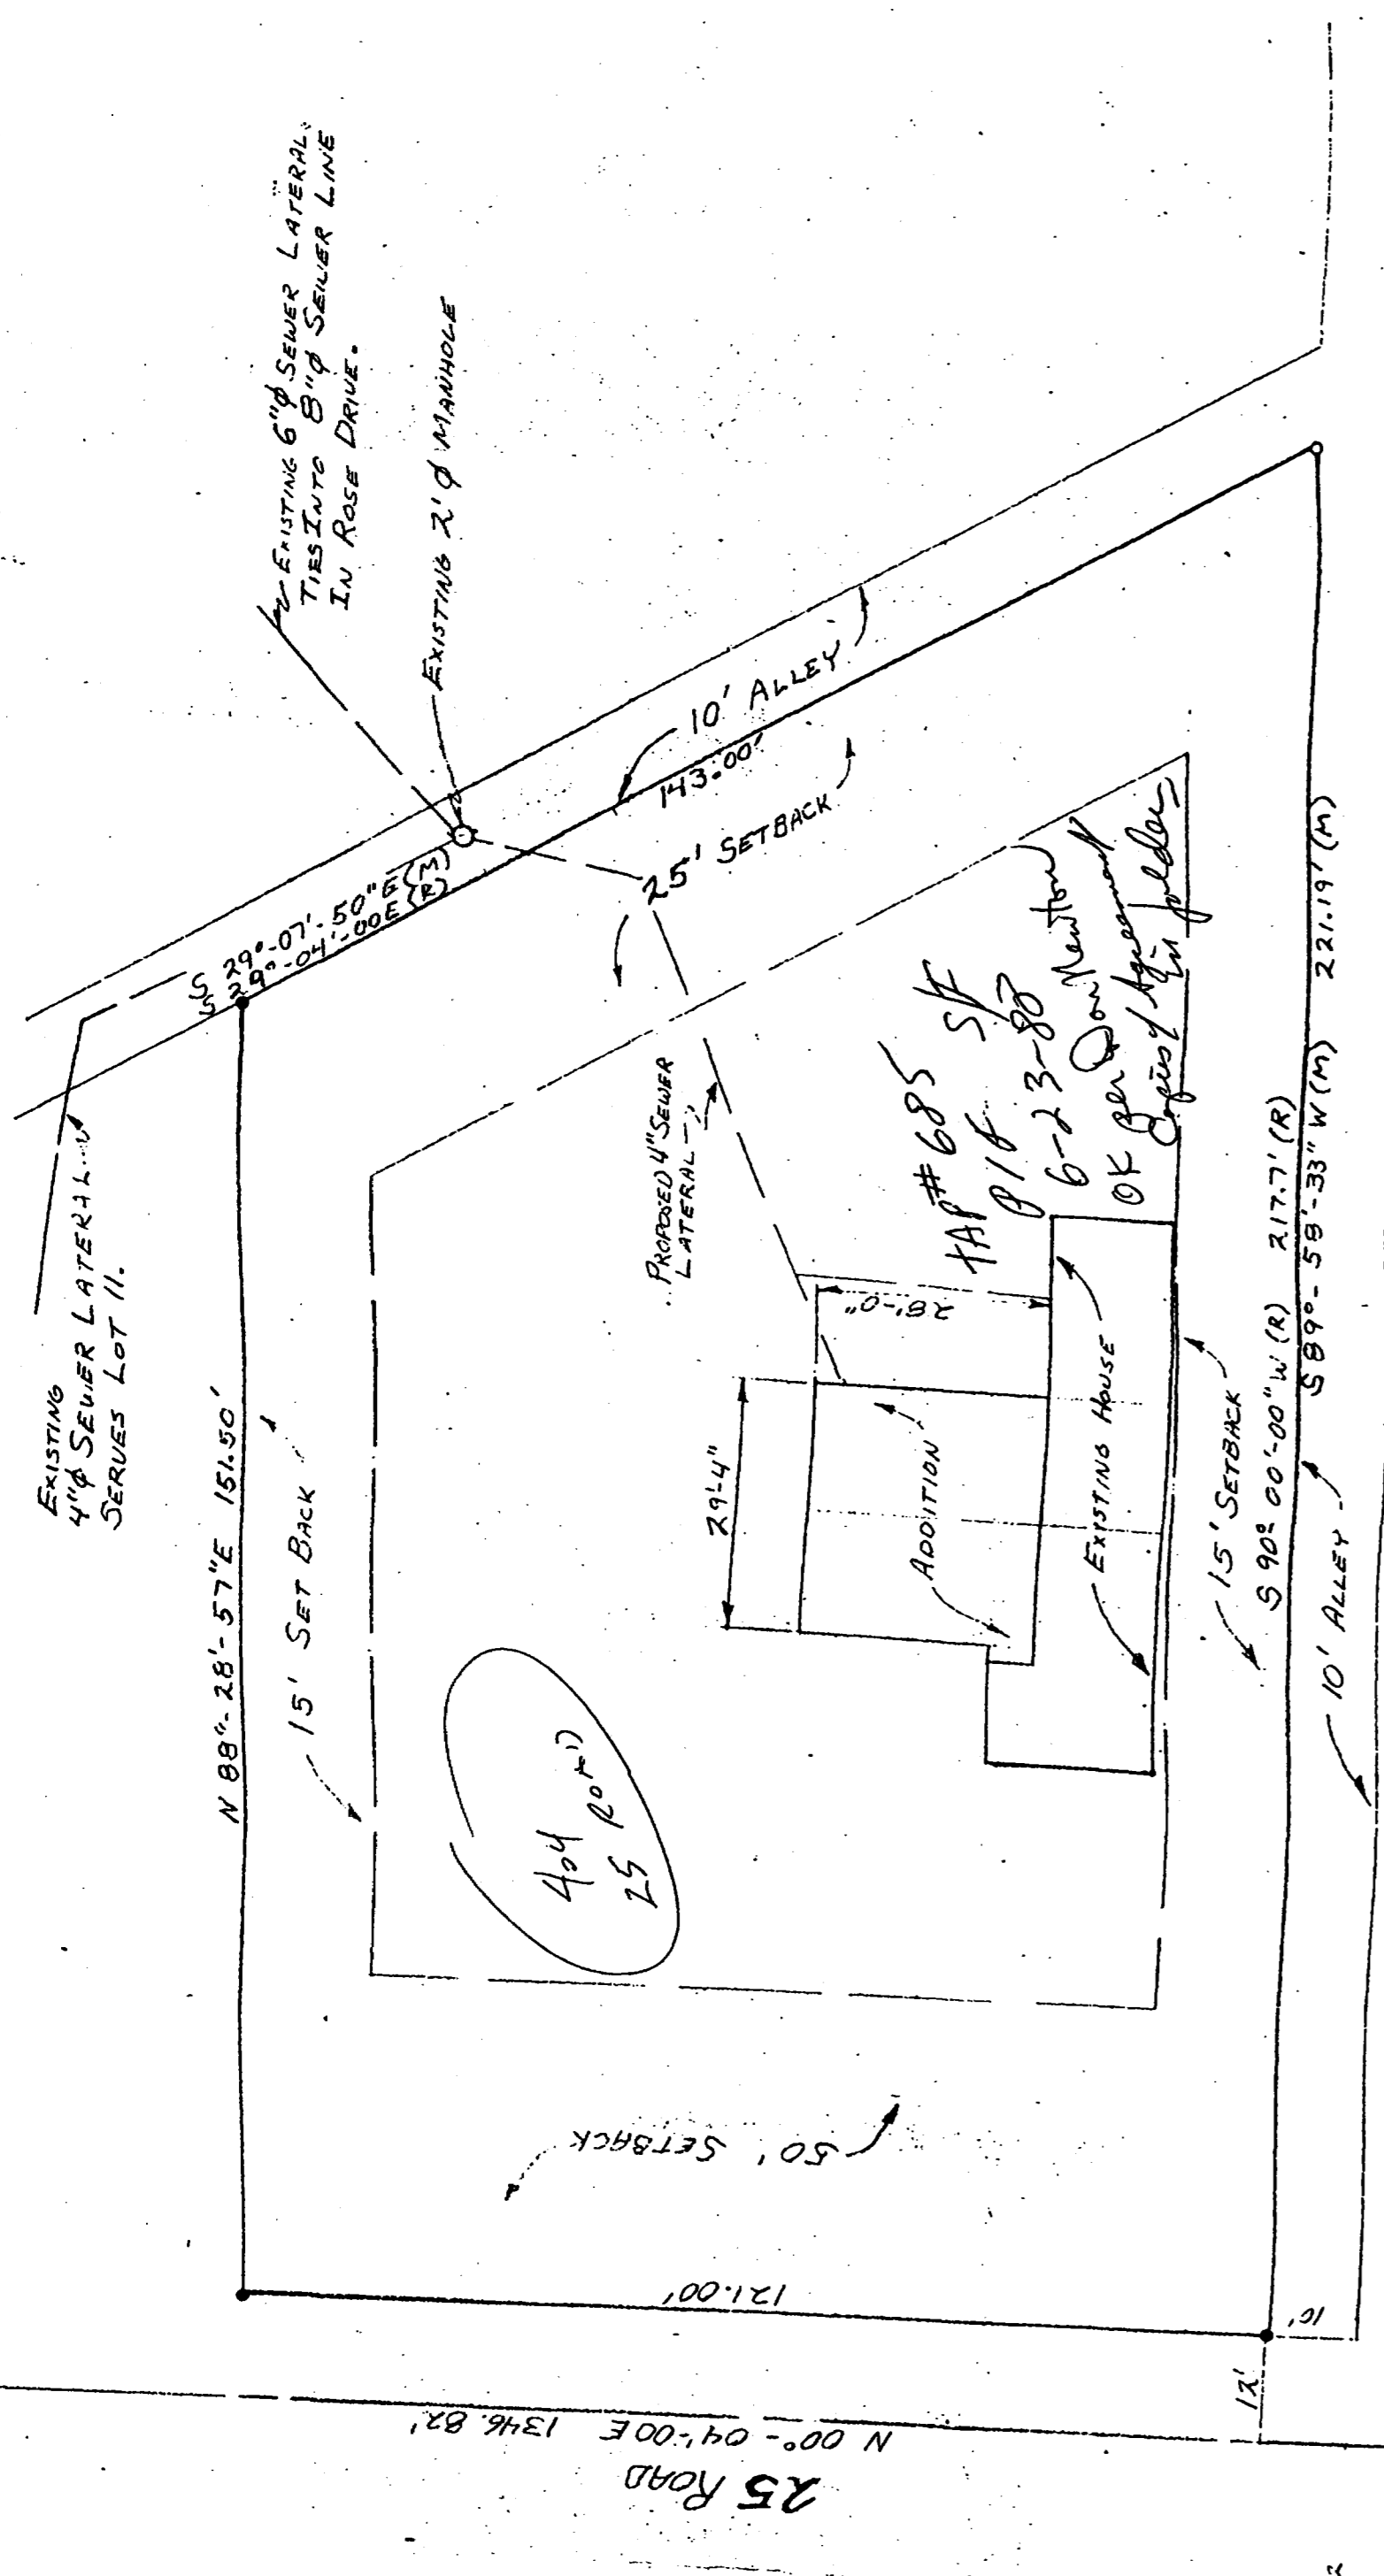


STANCES
BY
DATE
JUNE 9, 1962

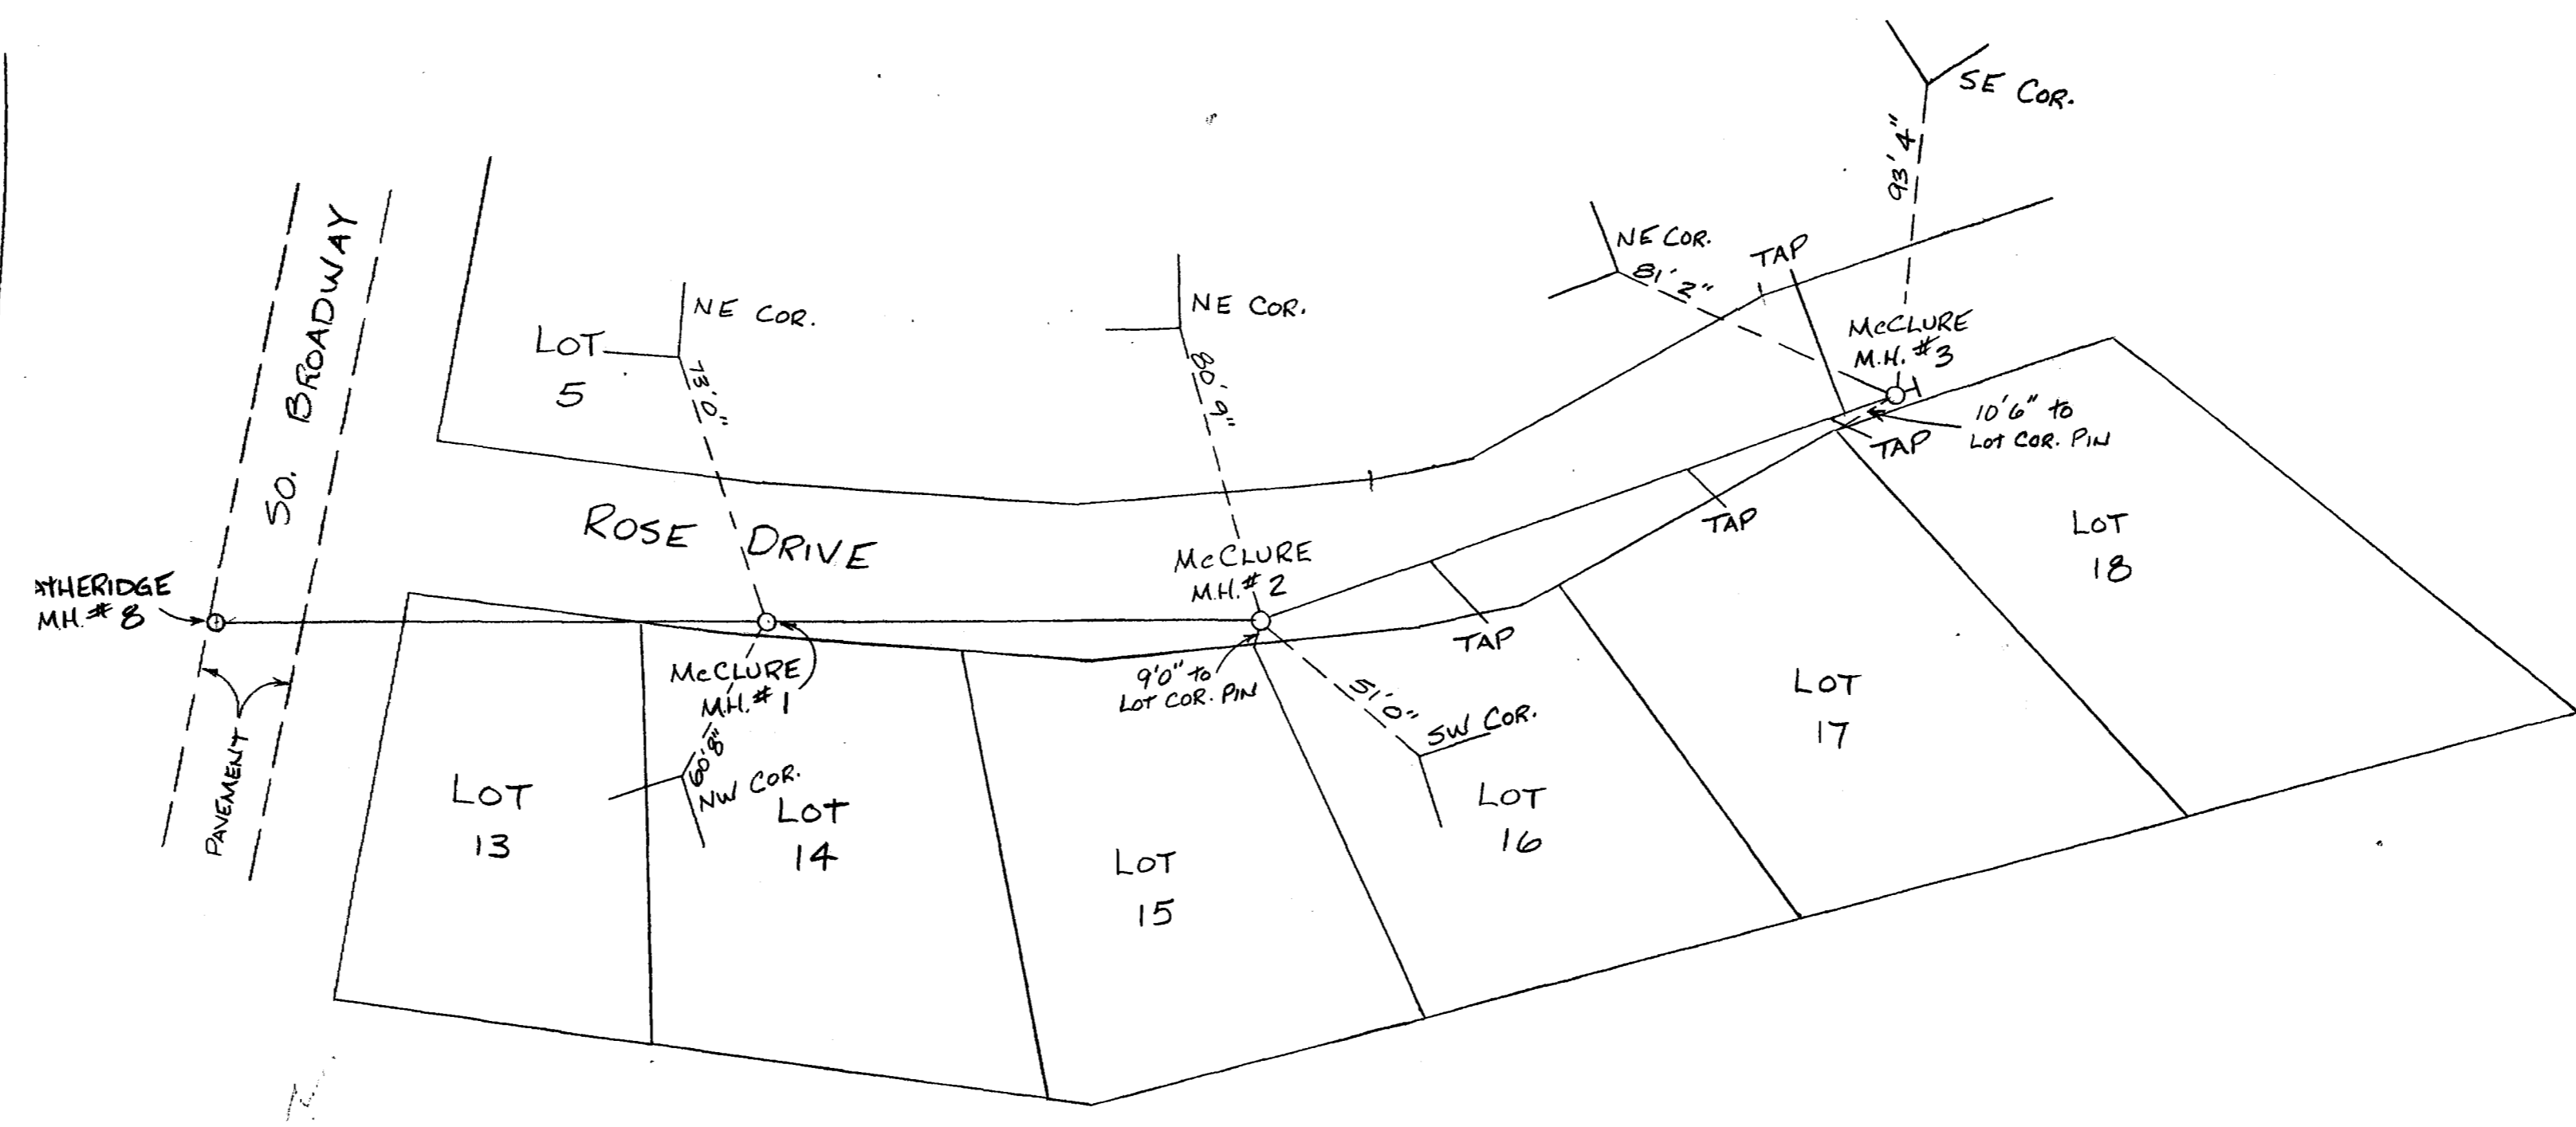

NOTE: THIS IS TO CERTIFY THAT THE SEWER INFILTRATION DOES NOT EXCEED 200 GALLONS PER INCH DIAMETER PER MILE OF LENGTH PER DAY.

SCALE: 1" = 50' HOR.
1" = 5' VERT.

McCLURE SEWER LINE PLAN & PROFILE

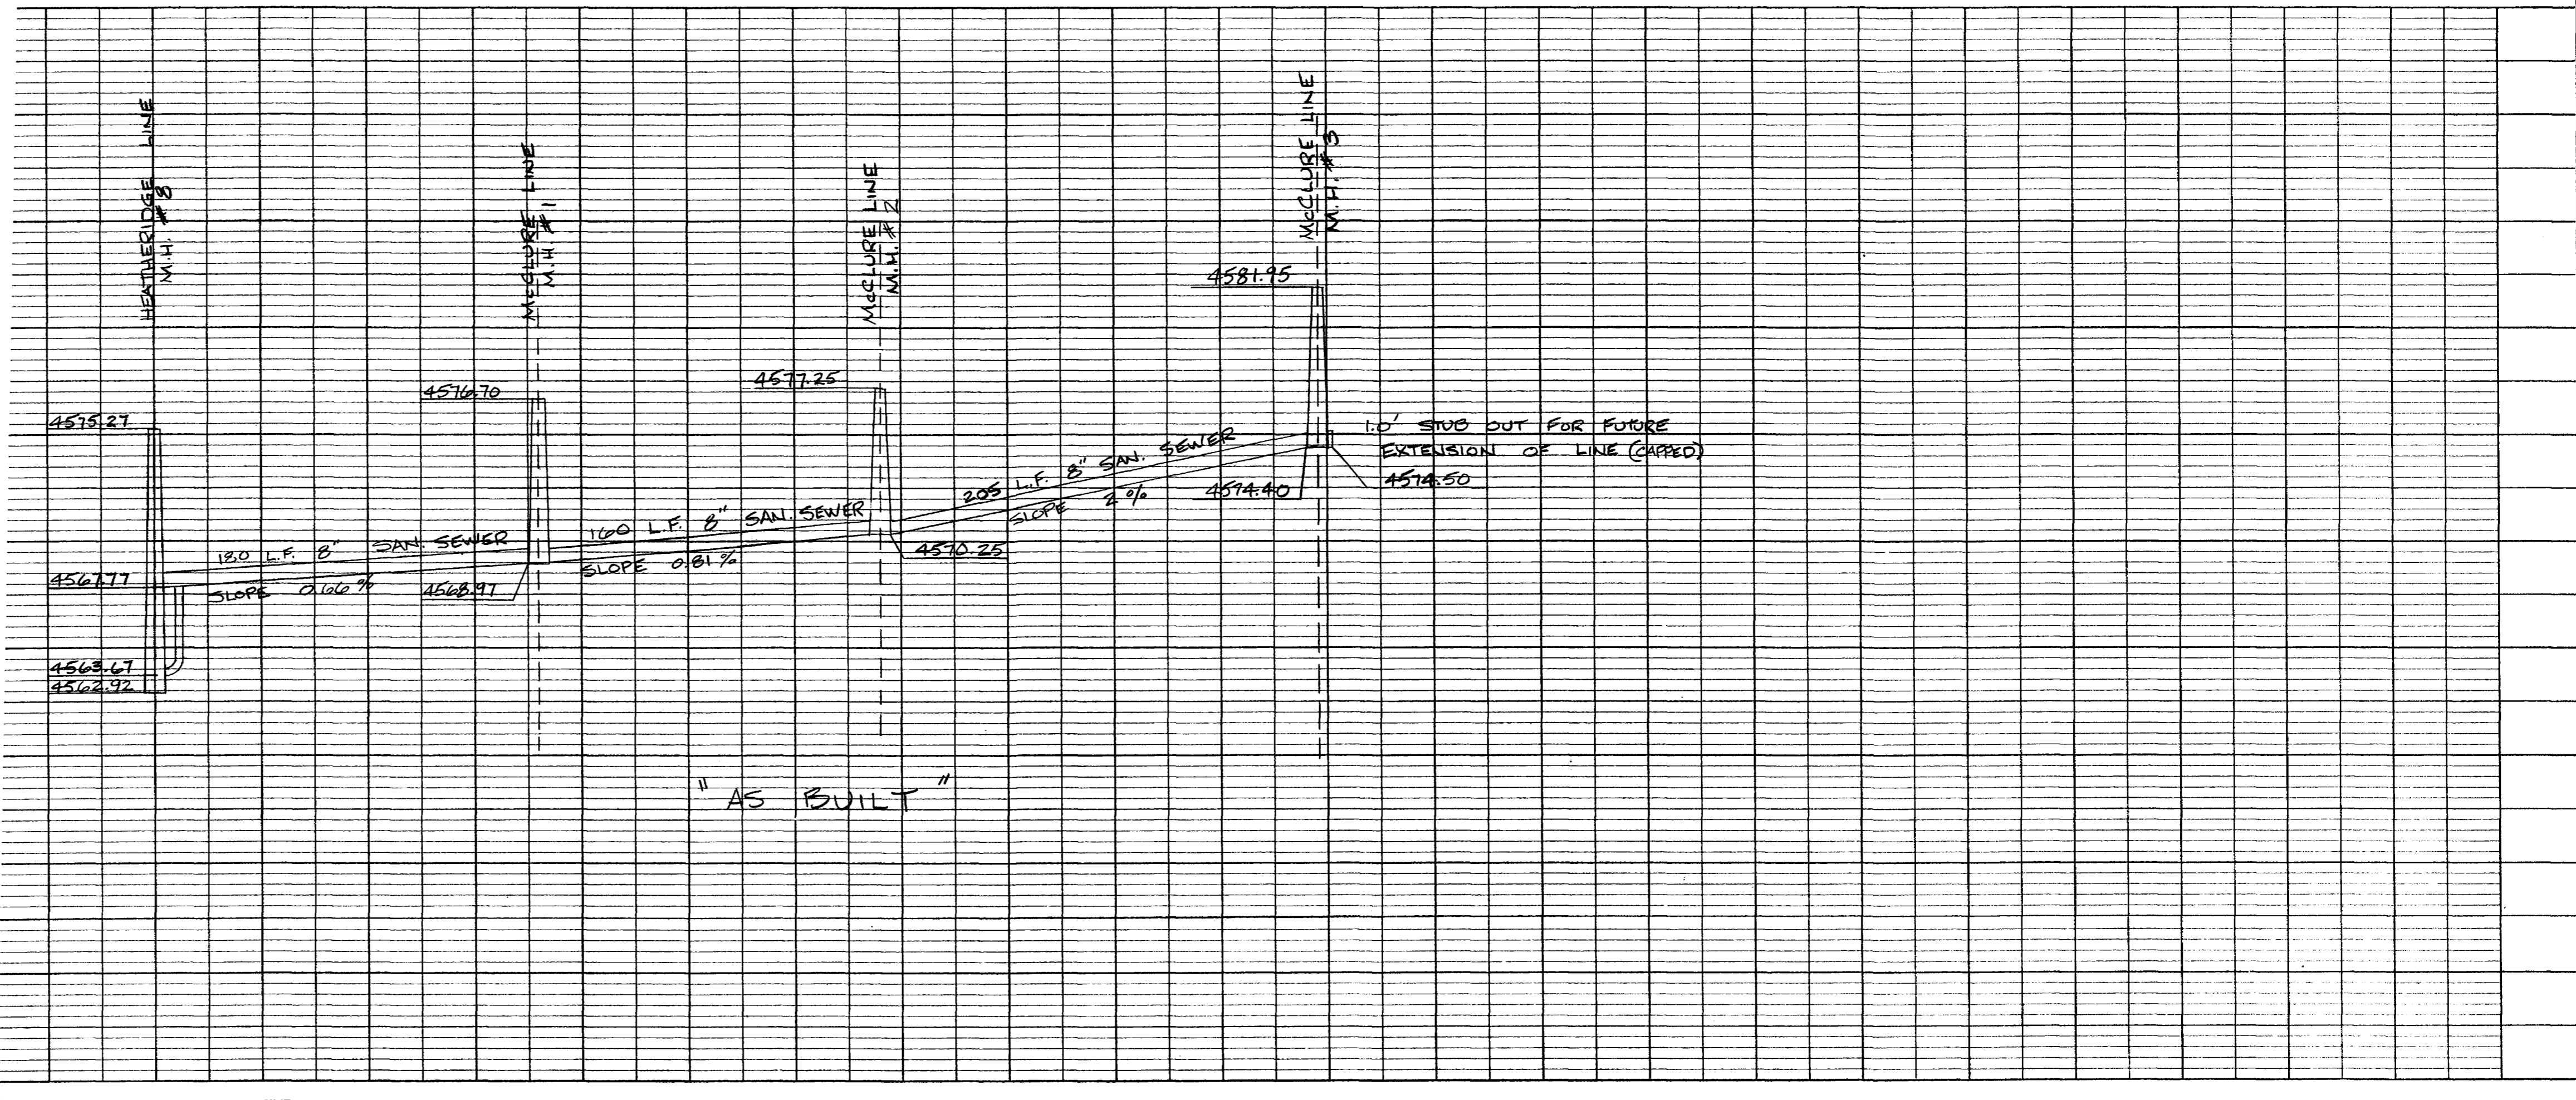

"AS BUILT"