


02-275 AB

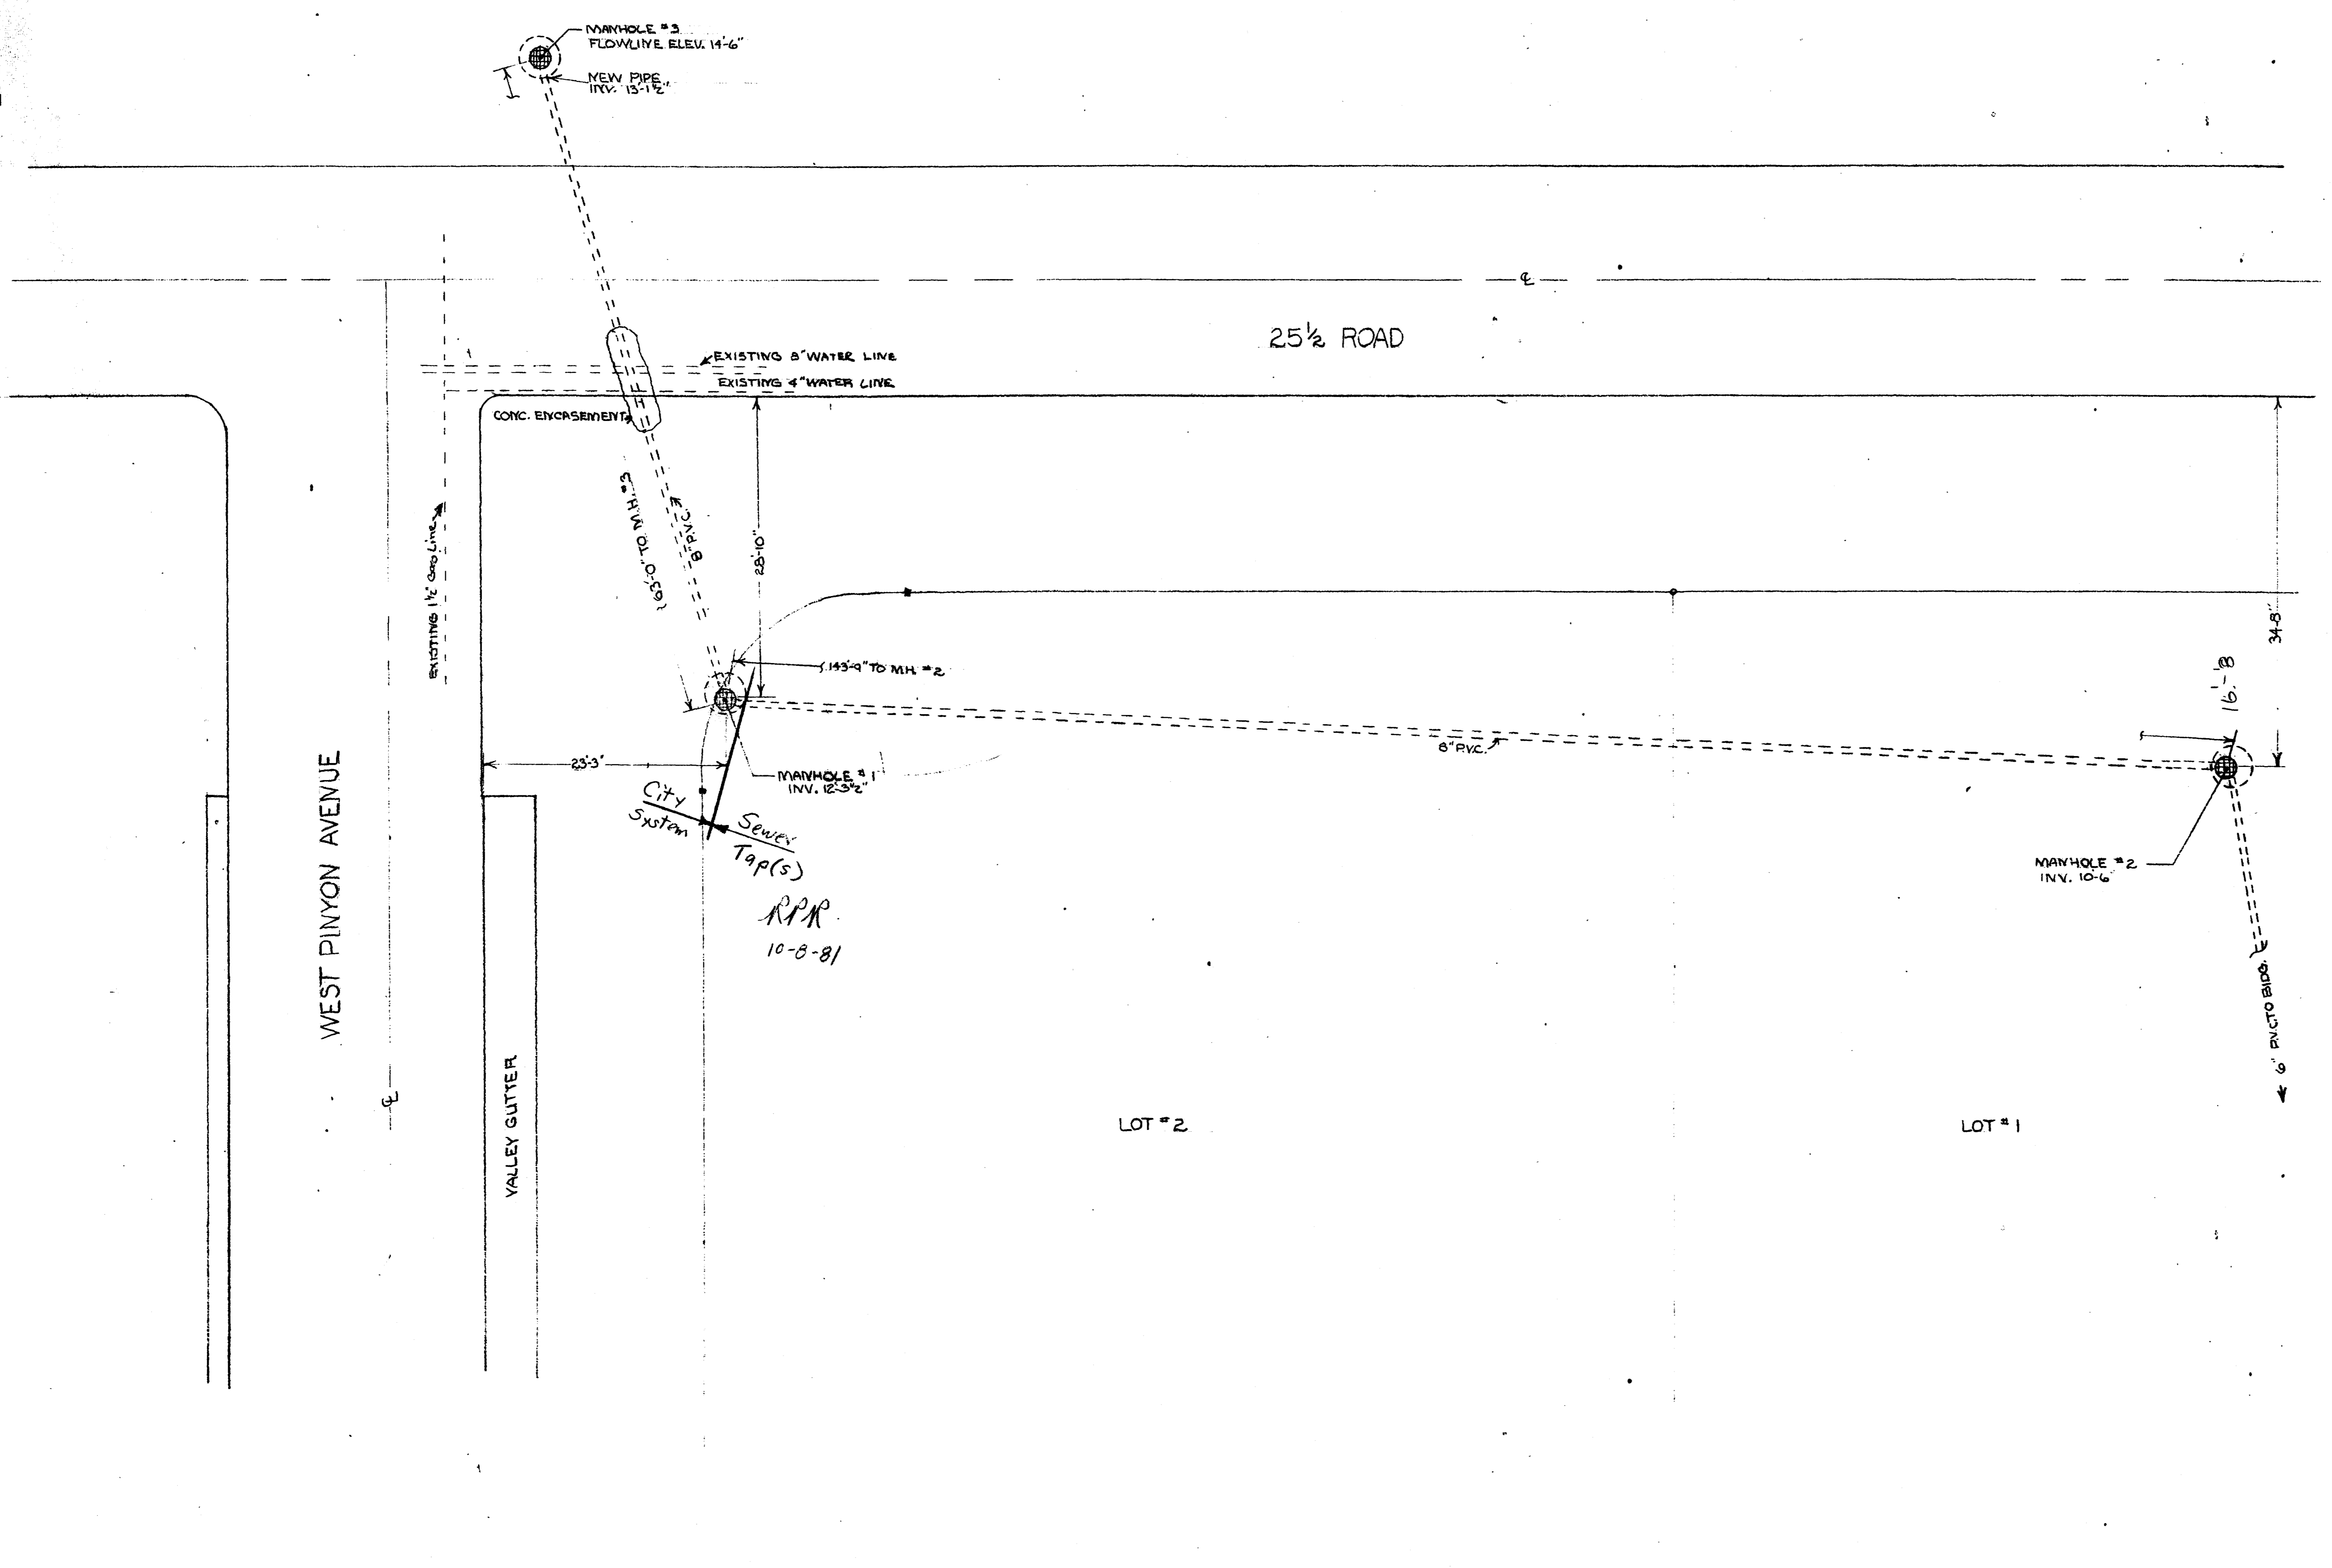

WEST PINYON AVENUE

25 1/2 ROAD

VALLEY GUTTER

LOT #2

LOT #1

MANHOLE #3
FLOWLINE ELEV. 14'-6"
NEW PIPE
INV. 13'-1 1/2"

EXISTING 8" WATER LINE
EXISTING 4" WATER LINE

CONC. ENCASEMENT

1.65'-0" TO M.H. #3
5.34'-8"

28'-10"

143'-9" TO M.H. #2

MANHOLE #1
INV. 12'-3 1/2"

CITY Sewer System
Tap(s)

RPR
10-8-81

8" PVC

MANHOLE #2
INV. 10'-6"

16'-8"

34'-8"

6" PVC TO BLDG.



PHIPP'S CONSTRUCTION			
SCALE 1/8"=1'	DRAWN BY MRS	REVISED	
AS-BUILT DRAWINGS			
DATE 10/7/81	APPROVED BY	DRAWING NUMBER A-1	