

CONTRACTOR TO VERIFY INVERT OF EXISTING SEWER LINE BEFORE LAYING NEW SEWER LINE

NOTES:

- THE LOCATION OF EXISTING UTILITIES IS APPROXIMATE ONLY FROM INFORMATION FURNISHED BY THE CITY AND UTILITIES COMPANIES. CONTRACTOR SHALL BE RESPONSIBLE FOR VERIFYING THEIR ACTUAL LOCATION, RESOLVING ANY CONFLICTS AND THEIR PROTECTION DURING CONSTRUCTION AT NO ADDITIONAL COST TO THE OWNER.
- CONTRACTOR SHALL KEEP ALL CONSTRUCTION AND EQUIPMENT WITHIN THE TEMPORARY CONSTRUCTION EASEMENT. TEMPORARY CONSTRUCTION EASEMENT EXISTS 25' TO THE WEST OF THE SANITARY SEWER ALIGNMENT AND 60' TO THE EAST OF THE ALIGNMENT UNLESS OTHERWISE SHOWN ON DRAWINGS.

NOTE: INFILTRATION DOES NOT EXCEED 200 GAL. / IN. DIA. / MILE OF LENGTH / DAY

A Professional Corporation

ARIX

Engineers Architects Planners

Greely, Colorado
Grand Junction, Colorado
Riverton, Wyoming

THIS DRAWING IS THE PROPERTY OF ARIX, AND IS NOT TO BE REPRODUCED, MODIFIED OR USED FOR ANY OTHER PROJECT OR EXTENSION OF THIS PROJECT EXCEPT BY AGREEMENT WITH SAID COMPANY.

GORDON W. BRUCE
REGISTERED PROFESSIONAL ENGINEER
NO. 8811
STATE OF COLORADO

SCALE 1" = 50' HORIZ.
1" = 5' VERT.

DRAWN ADC
CHECKED JEE
APPROVED GWB








DATE JUNE 1981
PROJECT NO 81109.01

AS-BUILT PLANS

THUNDER MOUNTAIN ELEMENTARY SCHOOL

MESA COUNTY VALLEY
SCHOOL DISTRICT NO. 51
GRAND JUNCTION COLORADO

SANITARY SEWER PLAN AND PROFILE C1

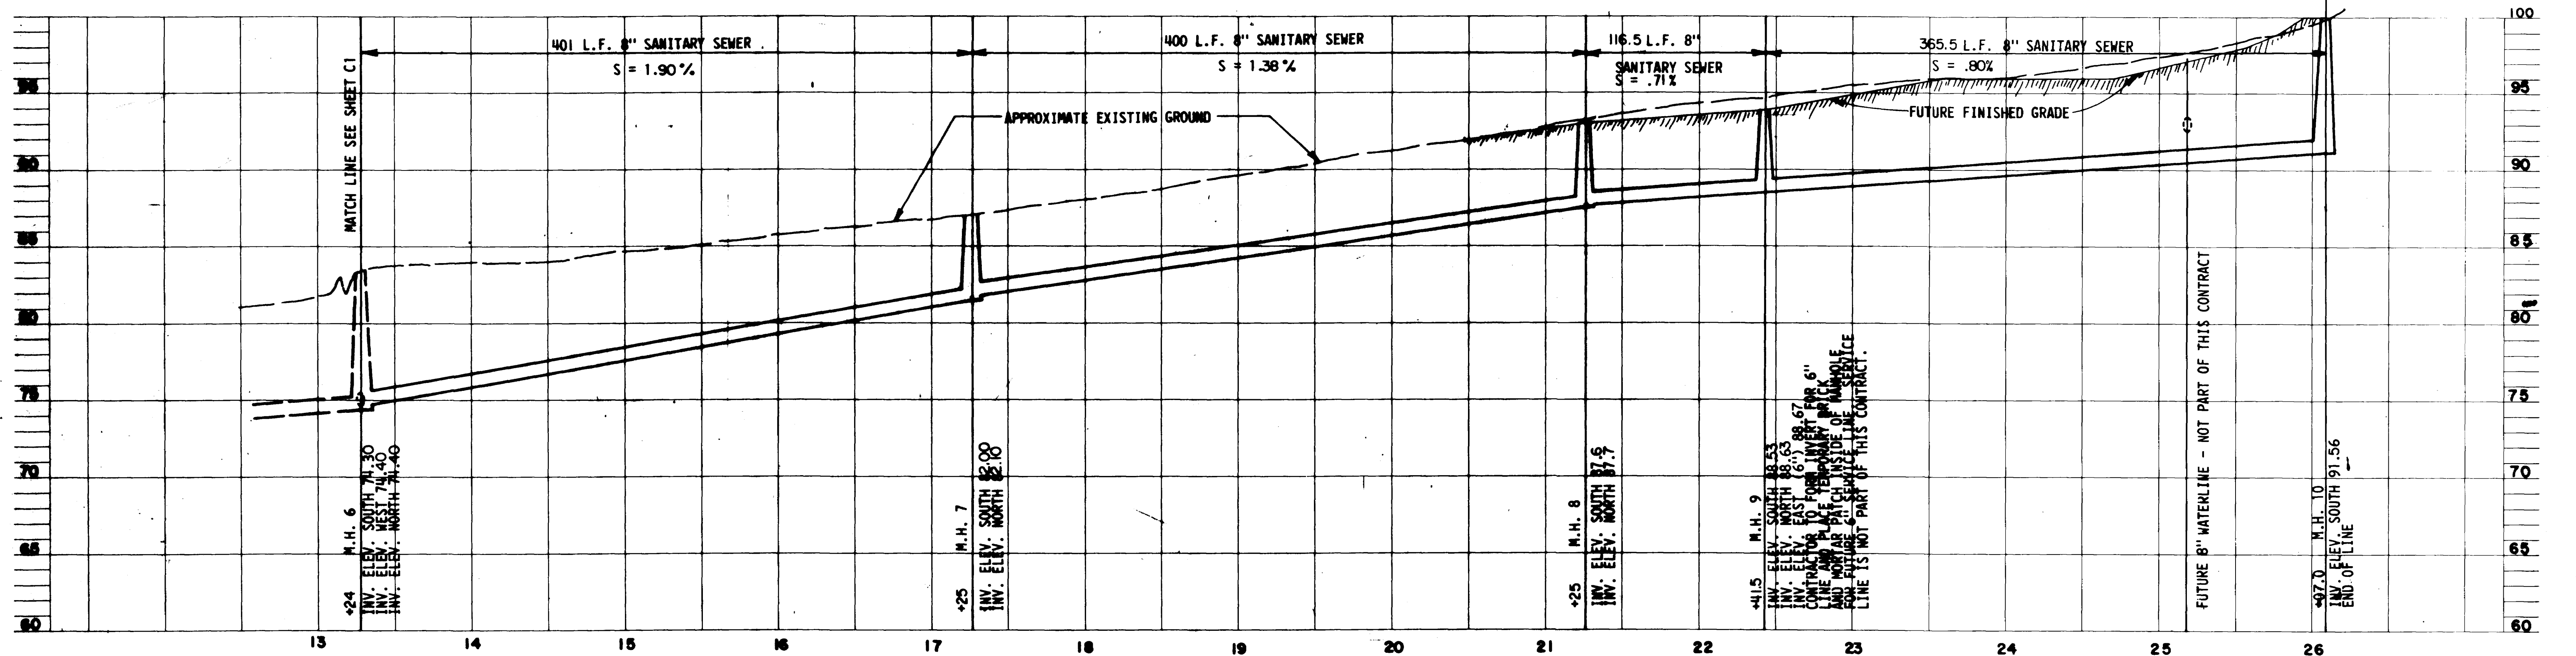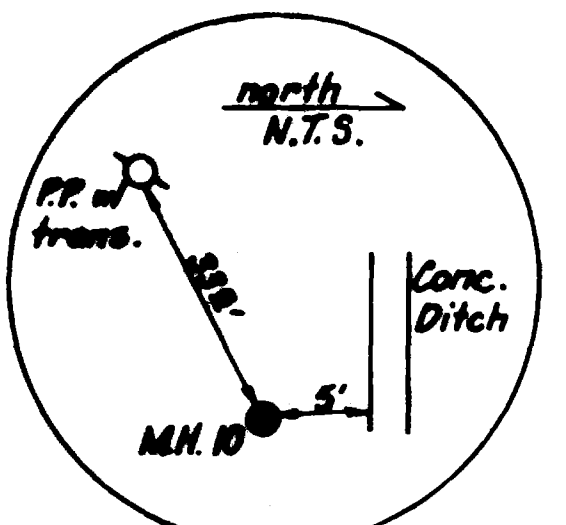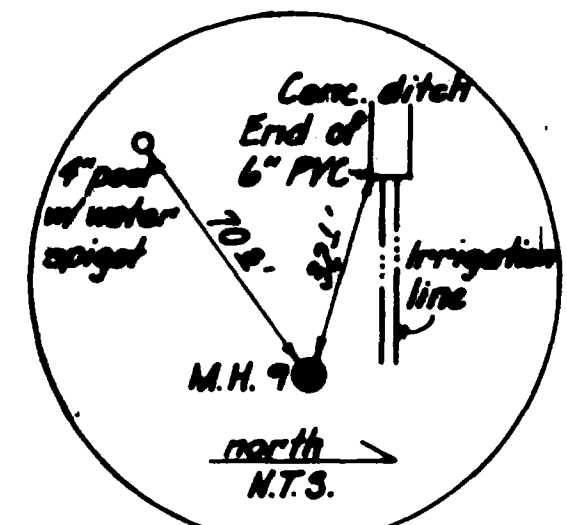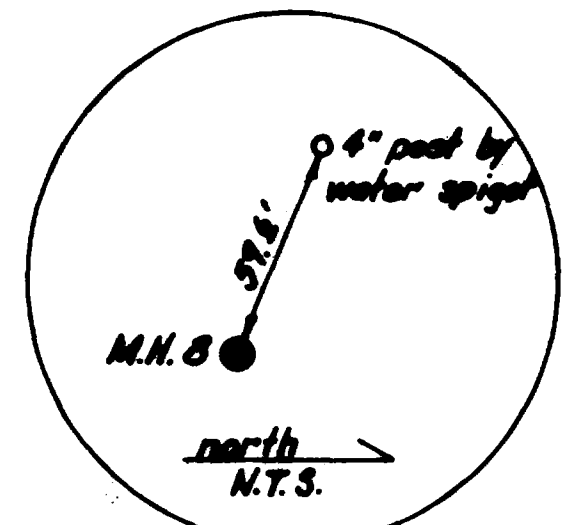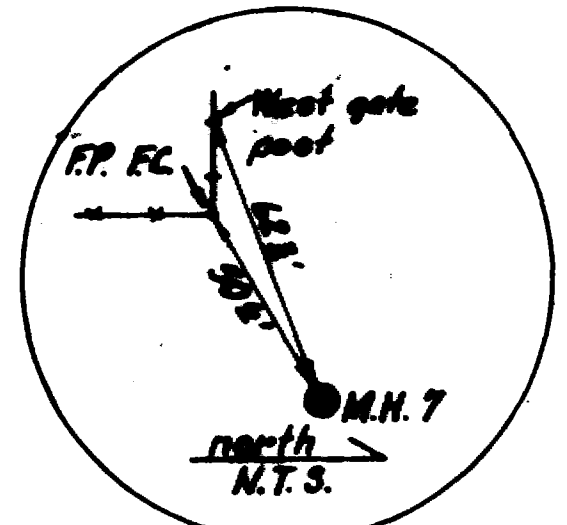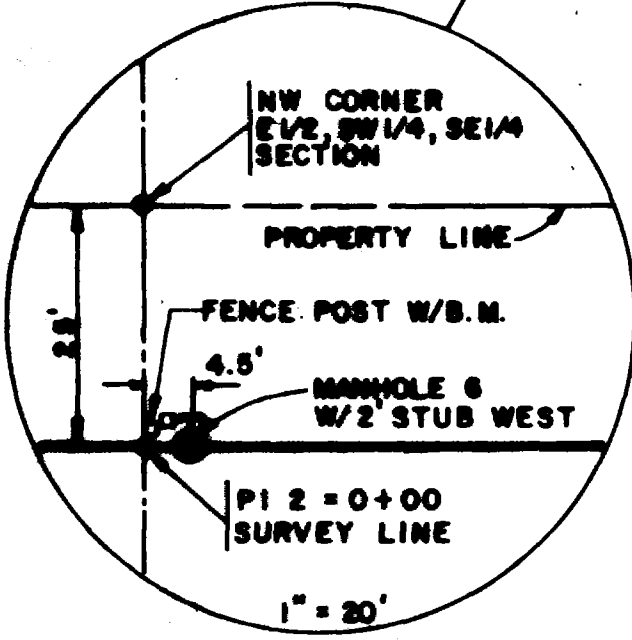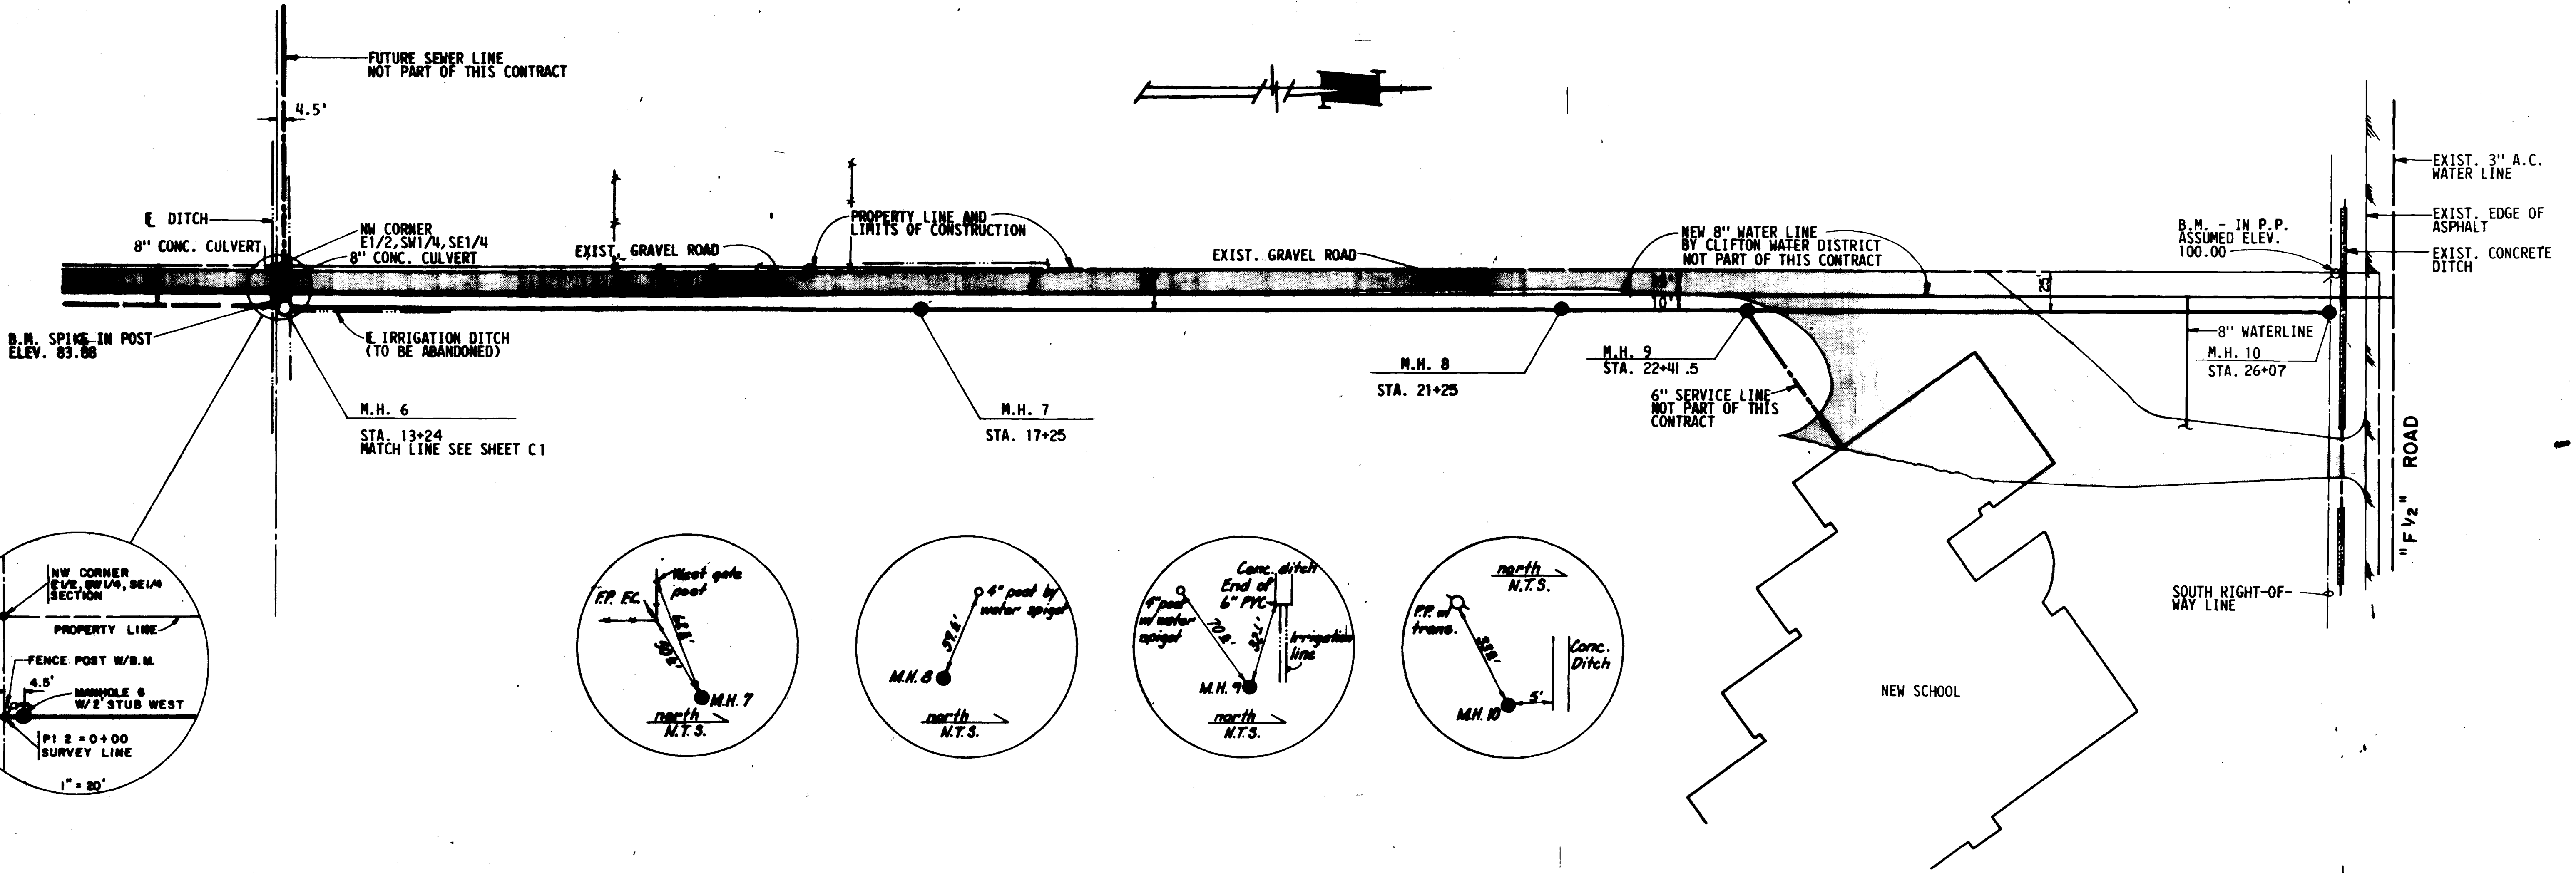

NOTE:
 1. CONTRACTOR TO SET TOP OF RIMS OF MANHOLES 8, 9, & 10 TO FUTURE GRADE SHOWN.

ARIX A Professional Corporation Engineers Architects Planners <small>Creating Colorado Grand Junction, Colorado Durango, Wyoming</small>	THIS DRAWING IS THE PROPERTY OF ARIX, AND IS NOT TO BE REPRODUCED, MODIFIED OR USED FOR ANY OTHER PROJECT OR EXTENSION OF THE PROJECT EXCEPT BY AGREEMENT WITH SAID COMPANY.		SCALE 1" = 50' HORIZ. 1" = 5' VERT.	AS-BUILT PLANS THUNDER MOUNTAIN ELEMENTARY SCHOOL MESA COUNTY VALLEY SCHOOL DISTRICT NO. 51 GRAND JUNCTION COLORADO SANITARY SEWER PLAN AND PROFILE
			DRAWN ADC CHECKED JEE APPROVED GMB	