


"AS BUILT, NOVEMBER 20, 1981"

CERTIFICATION

In accordance with the City of Grand Junction specifications and based on an actual field test of this project, I hereby certify that the infiltration rates as stated in the standard specification for the City of Grand Junction was not exceeded.

Date: \_\_\_\_\_


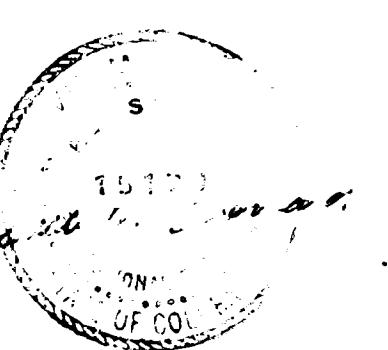


ARMSTRONG HIGHWAY AND UTILITY, INC.  
ENGINEERING & SURVEYING • CONSTRUCTION • TESTING  
861 ROAD AVENUE • GRAND JUNCTION, COLORADO 81501 (970) 245-0861

27" INTERCEPTOR SEWER

ST# F 152A01 52 802814

DESIGN COMPUTATIONS

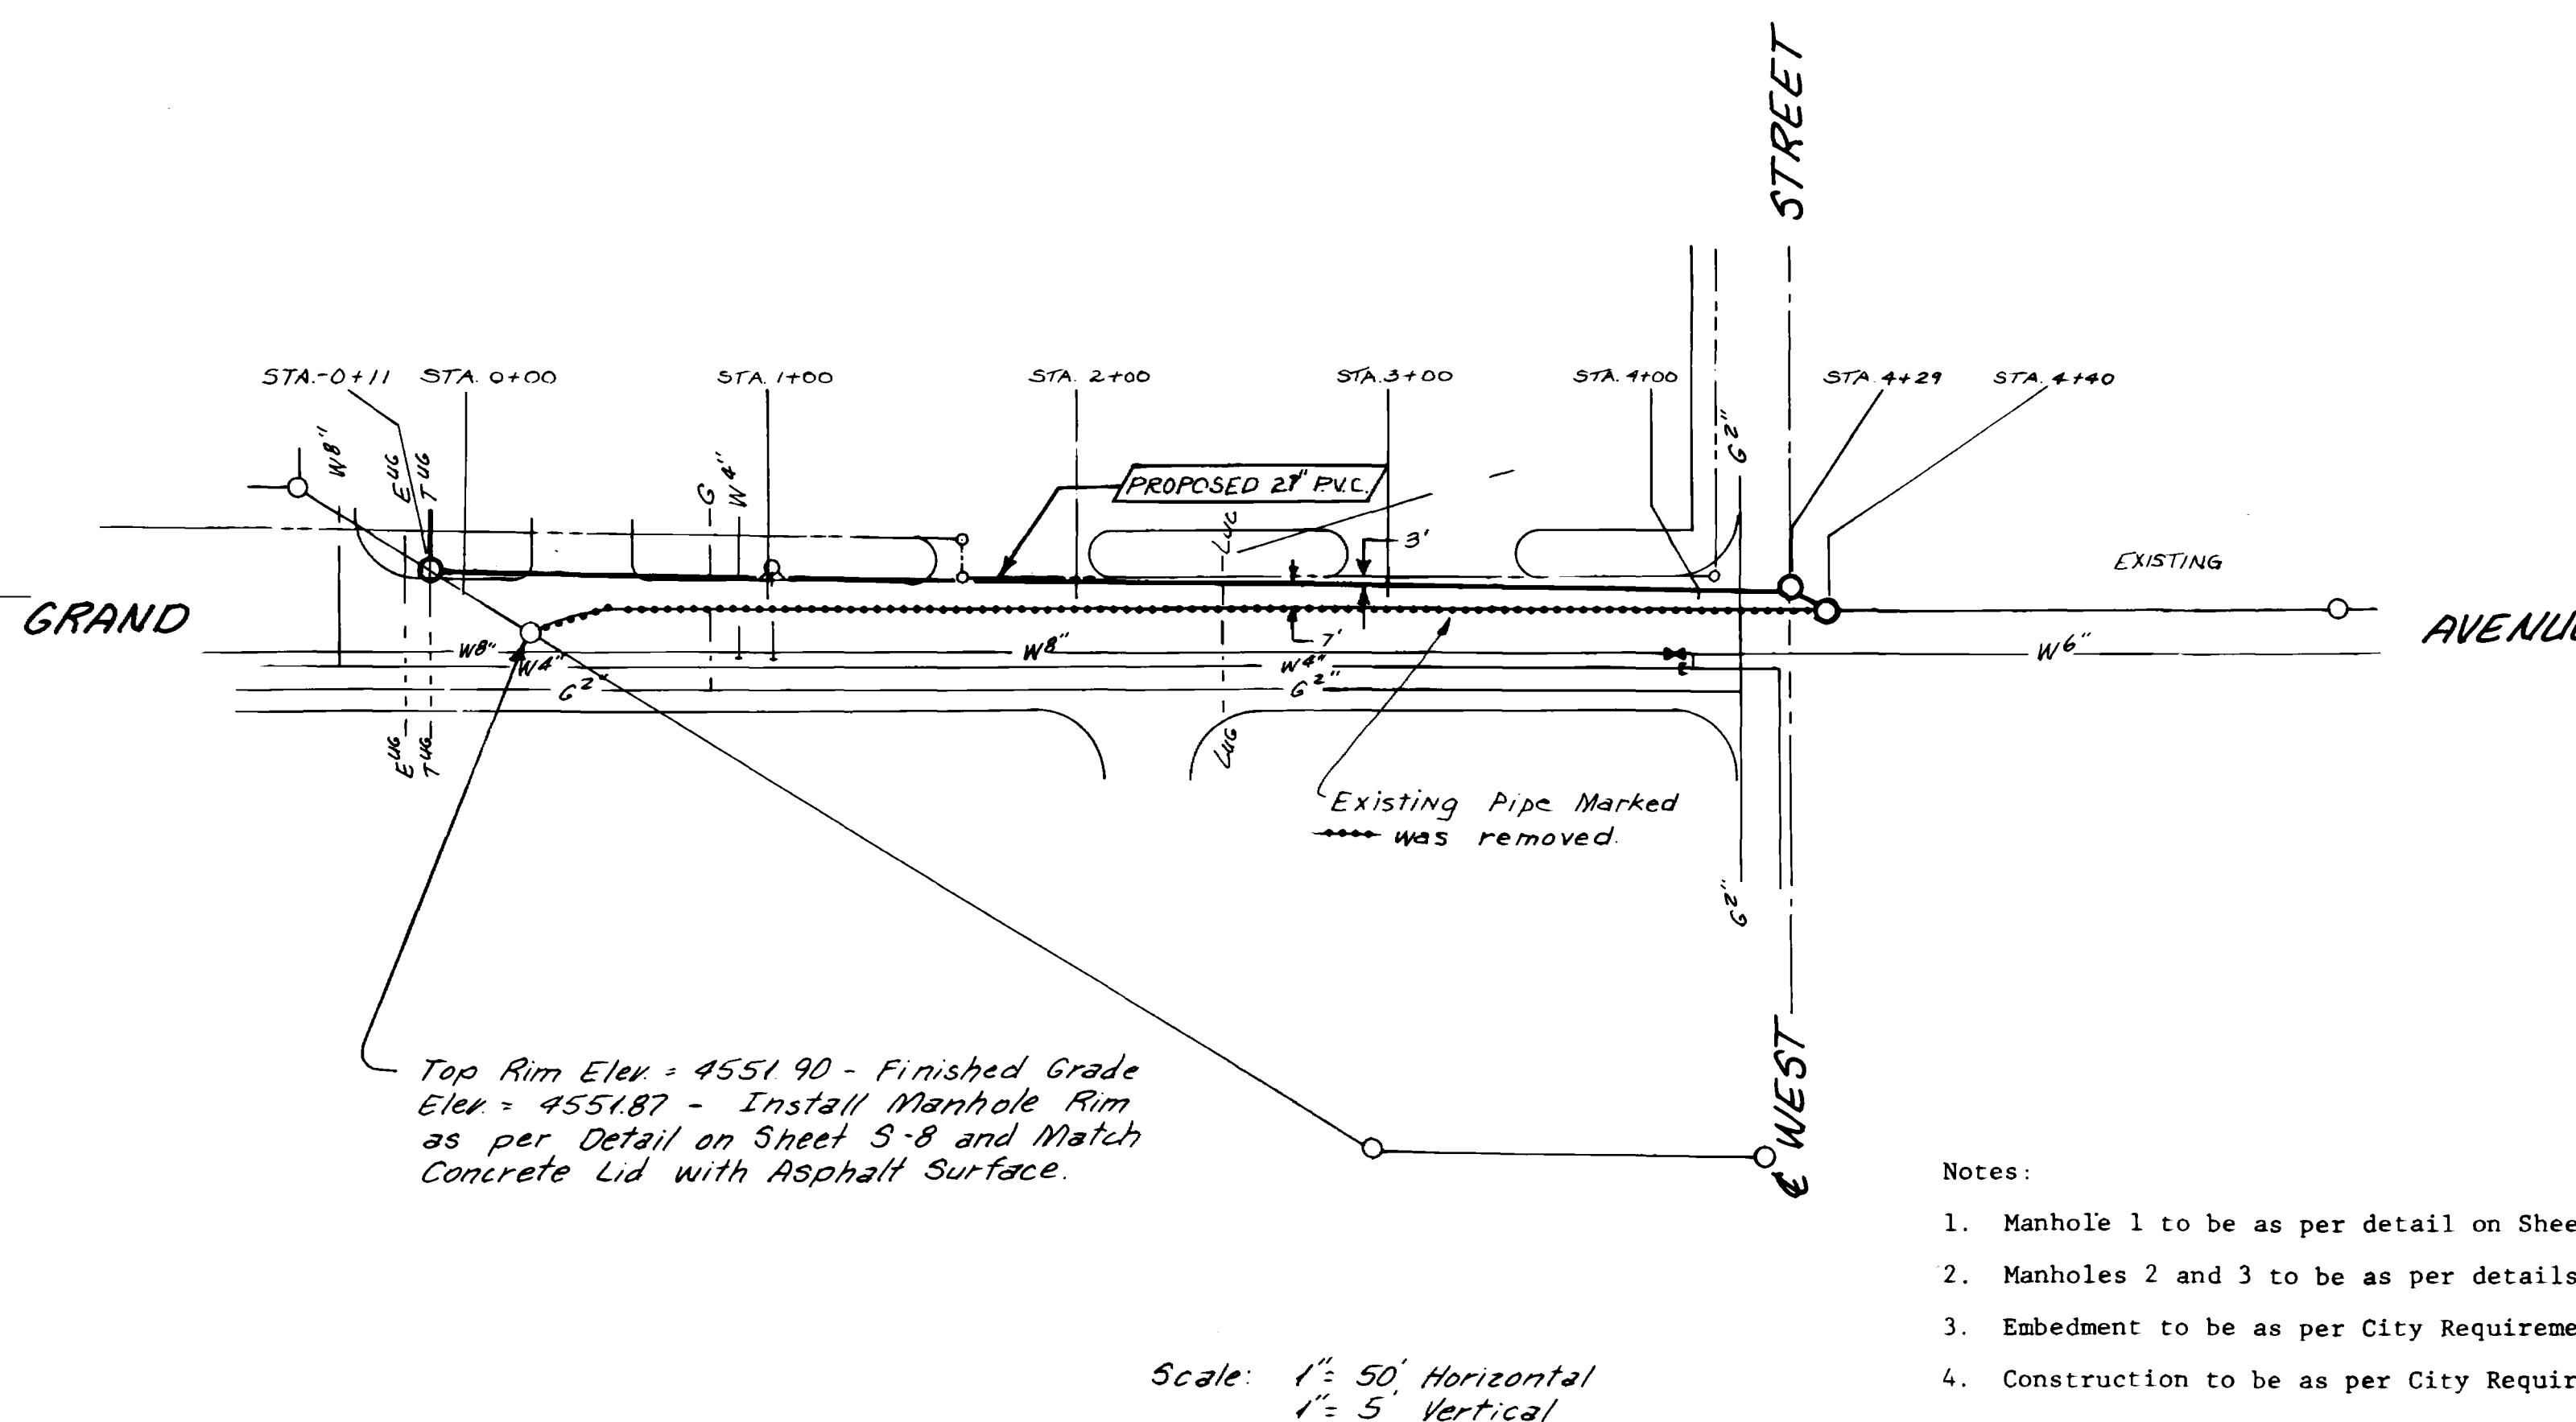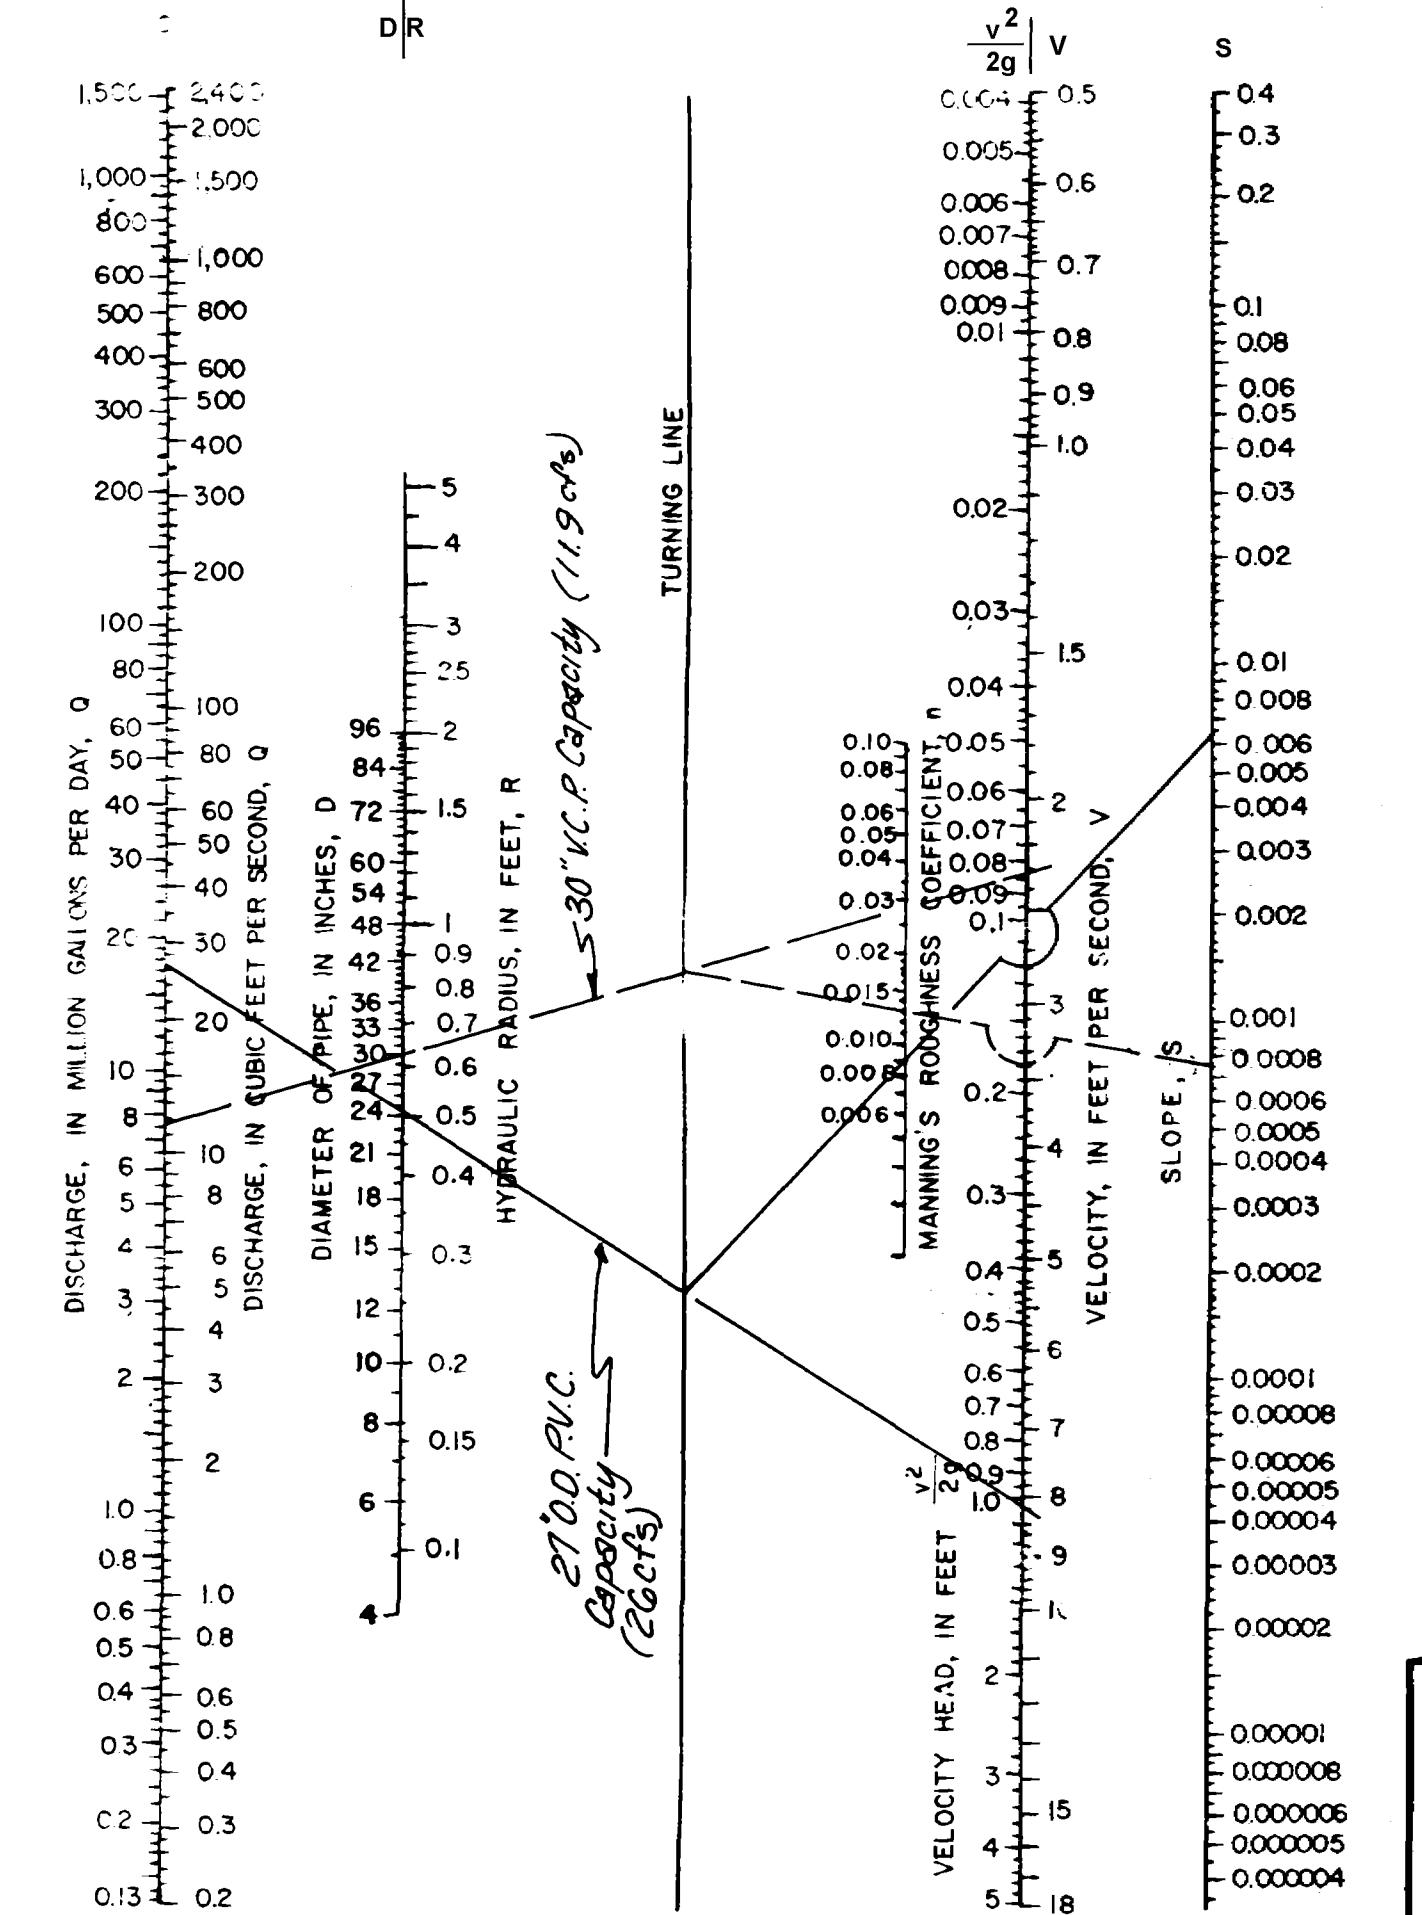

Notes:

1. Manhole 1 to be as per detail on Sheet S-9 of 52.
2. Manholes 2 and 3 to be as per details on Sheet S-8.
3. Embedment to be as per City Requirements.
4. Construction to be as per City Requirements.

