


General Notes:

1. This Subdivision Is Served By Central Grand Valley Sanitation District
2. This Is To Certify That The System Infiltration Does Not Exceed 200 Gallons Per Inch Diameter Per Mile Of Length Per Day. Field Verified 7/21/8

- O.M. - Top of MCBC  
Elev. = 4659.69

## Sunridge Subdivis

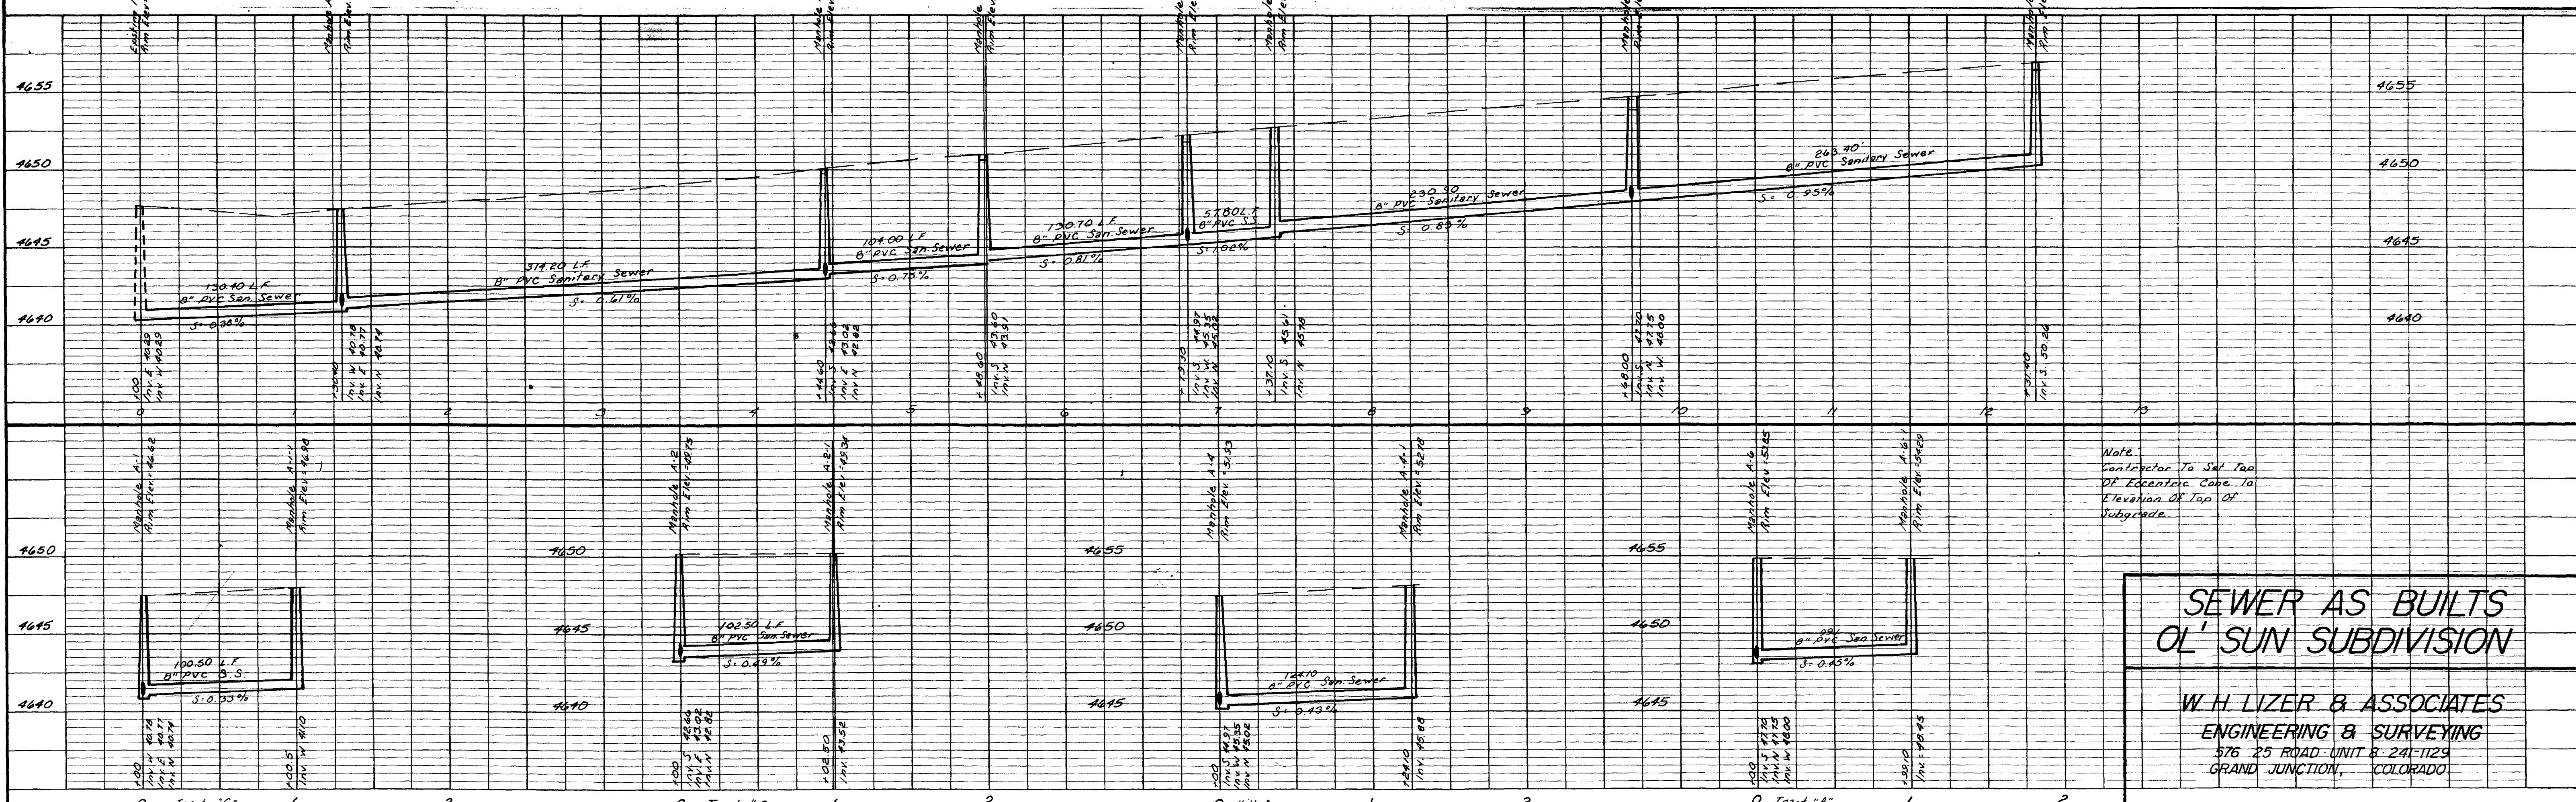

# SEWER AS BUILT OL' SUN SUBDIVISION

**W. H. LIZER & ASSOCIATES  
ENGINEERING & SURVEYING  
576 25 ROAD · UNIT 8 · 241-1129  
GRAND JUNCTION, COLORADO**