
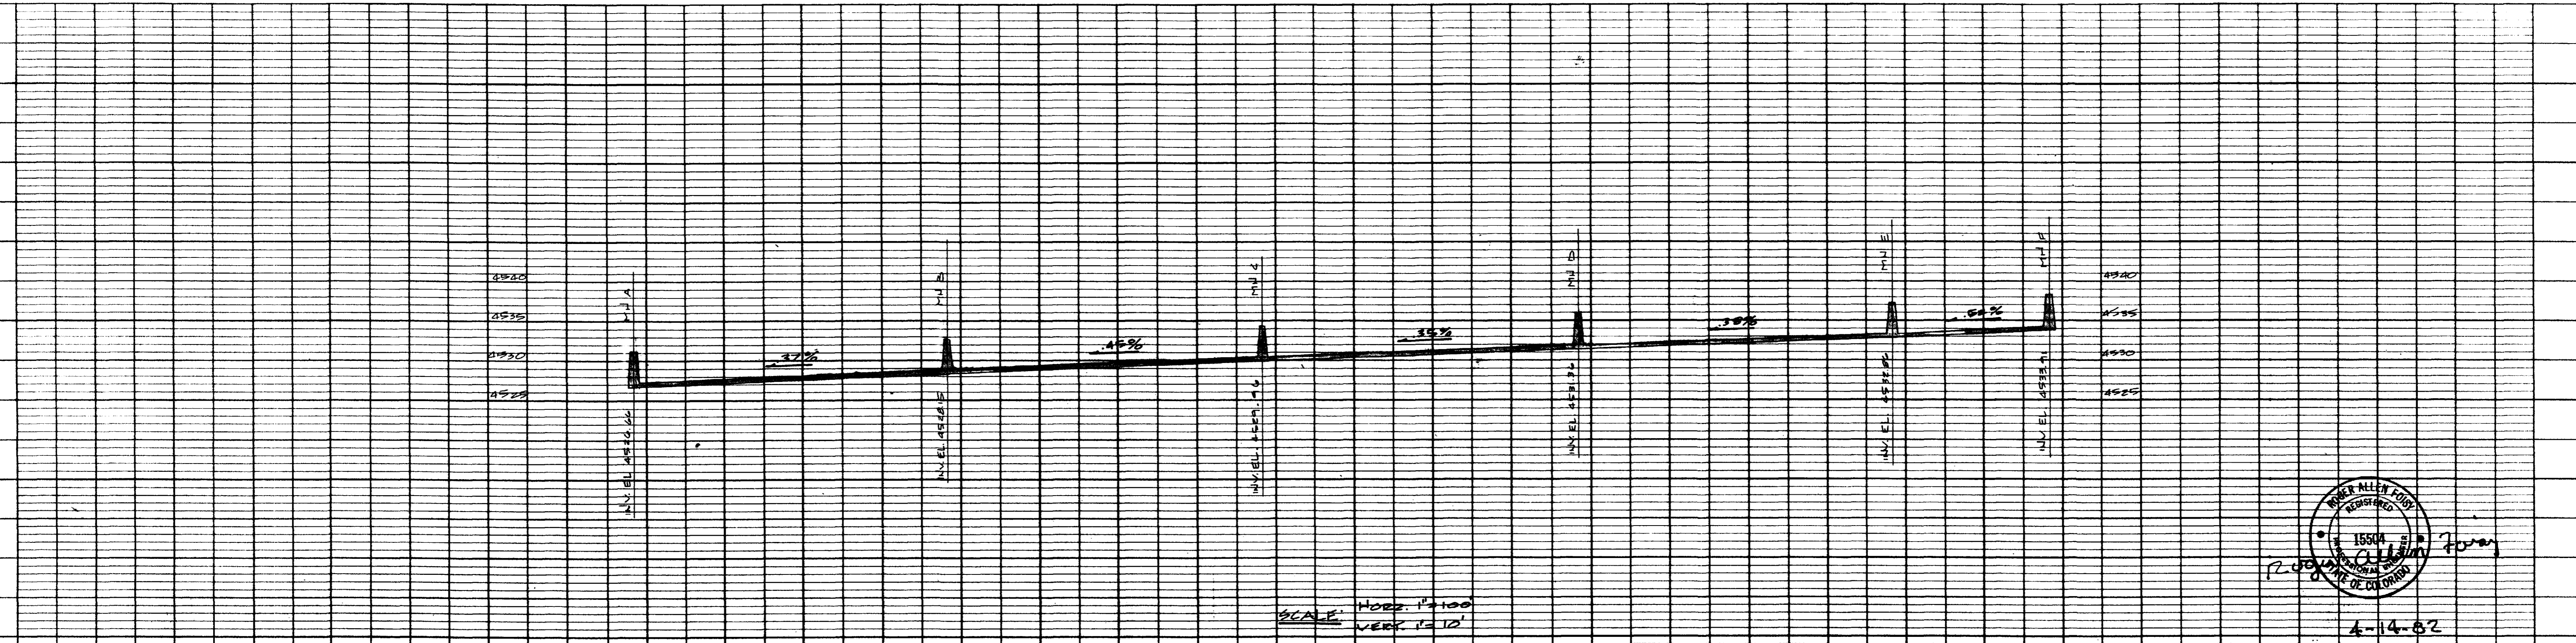


TIES TO GRAND JUNCTION WEST. (SEE SHEET # 02-359-14-AB)

NOTE: SANITARY SEWER DISTANCES GIVEN ARE CENTER TO CENTER DISTANCES BETWEEN MANHOLES

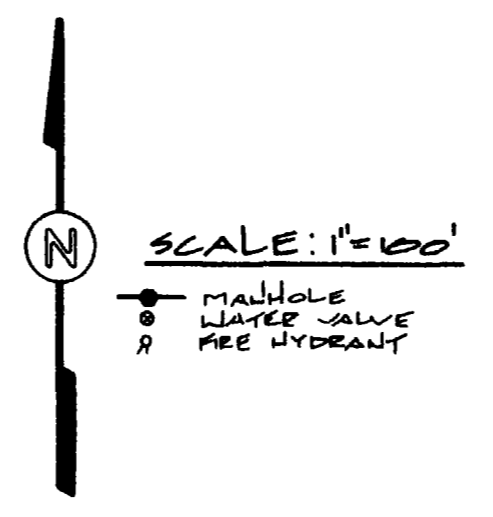

SCALE: HORIZ. 1"=100' VERT. 1"=10'

POWER ALLEN FORD REGISTERED PROFESSIONAL ENGINEER
 15504
 COLORADO
 4-14-02

DESIGNED BY:	DATE:	STATION TO STA.	23 RD. COMMERCIAL SUB'D WATER & SEWER "AS-BUILT" "DRY LINE"
DRAWN BY:	DATE:	SCALE	
COLORADO WEST ENGINEERING			CLIENT: CAVNESS INC.
CONSULTING CIVIL ENGINEERS 835 COLORADO AVE. GRAND JUNCTION, COLO. 81501 (303) 249-5112			JOB NO. 558.2 SHEET 1 of 1