

All construction shall be in accordance with City of Grand Junction Standard Sanitary Sewer Details Drawing SS-1 and shall conform to City of Grand Junction "Standard Specifications for Construction of Water Lines, Sanitary Sewers, Storm Drainage and Irrigation Systems", 1981, and City of Grand Junction General Contract Conditions for Public Works and Utilities Construction GC-37, GC-50 and GC-65.

All sanitary sewer mains will be constructed using 8" PVC pipe


All service wyes 4" except where noted.

This is to certify that the system infiltration does not exceed 200 gallon per inch diameter per mile of length per day.

This plan and drawing prepared under my direct supervision.

Howard A. Paul
 Howard A. Paul
 Registered Professional Engineer
 Colorado Reg. No. 18192

FILING No. 1
 TITLE:
 PEPPER TREE SANITARY SEWER
 AS BUILT DRAWING OF
 RECORD FOR PEPPER TREE FILING
 NO. 2, NO. 3 AND NO. 4

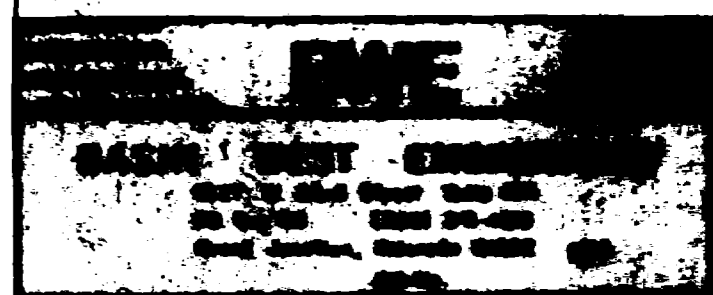

PROPOSED SANITARY
 EASEMENT - 20' WIDE



SCALE
 Horz. 1" = 40'
 Vert. 1" = 5'

