


CAPITAL IMPROVEMENTS
FOR THE
CENTRAL GRAND VALLEY SANITATION DISTRICT

30 1/4 ROAD INTERCEPTOR

DISTRICT BOARD MEMBERS

JOHN KRIZMAN PRESIDENT
CHARLES BATES
ROYAL COLLARD
LEONARD DARNELL
EMERY WHITE

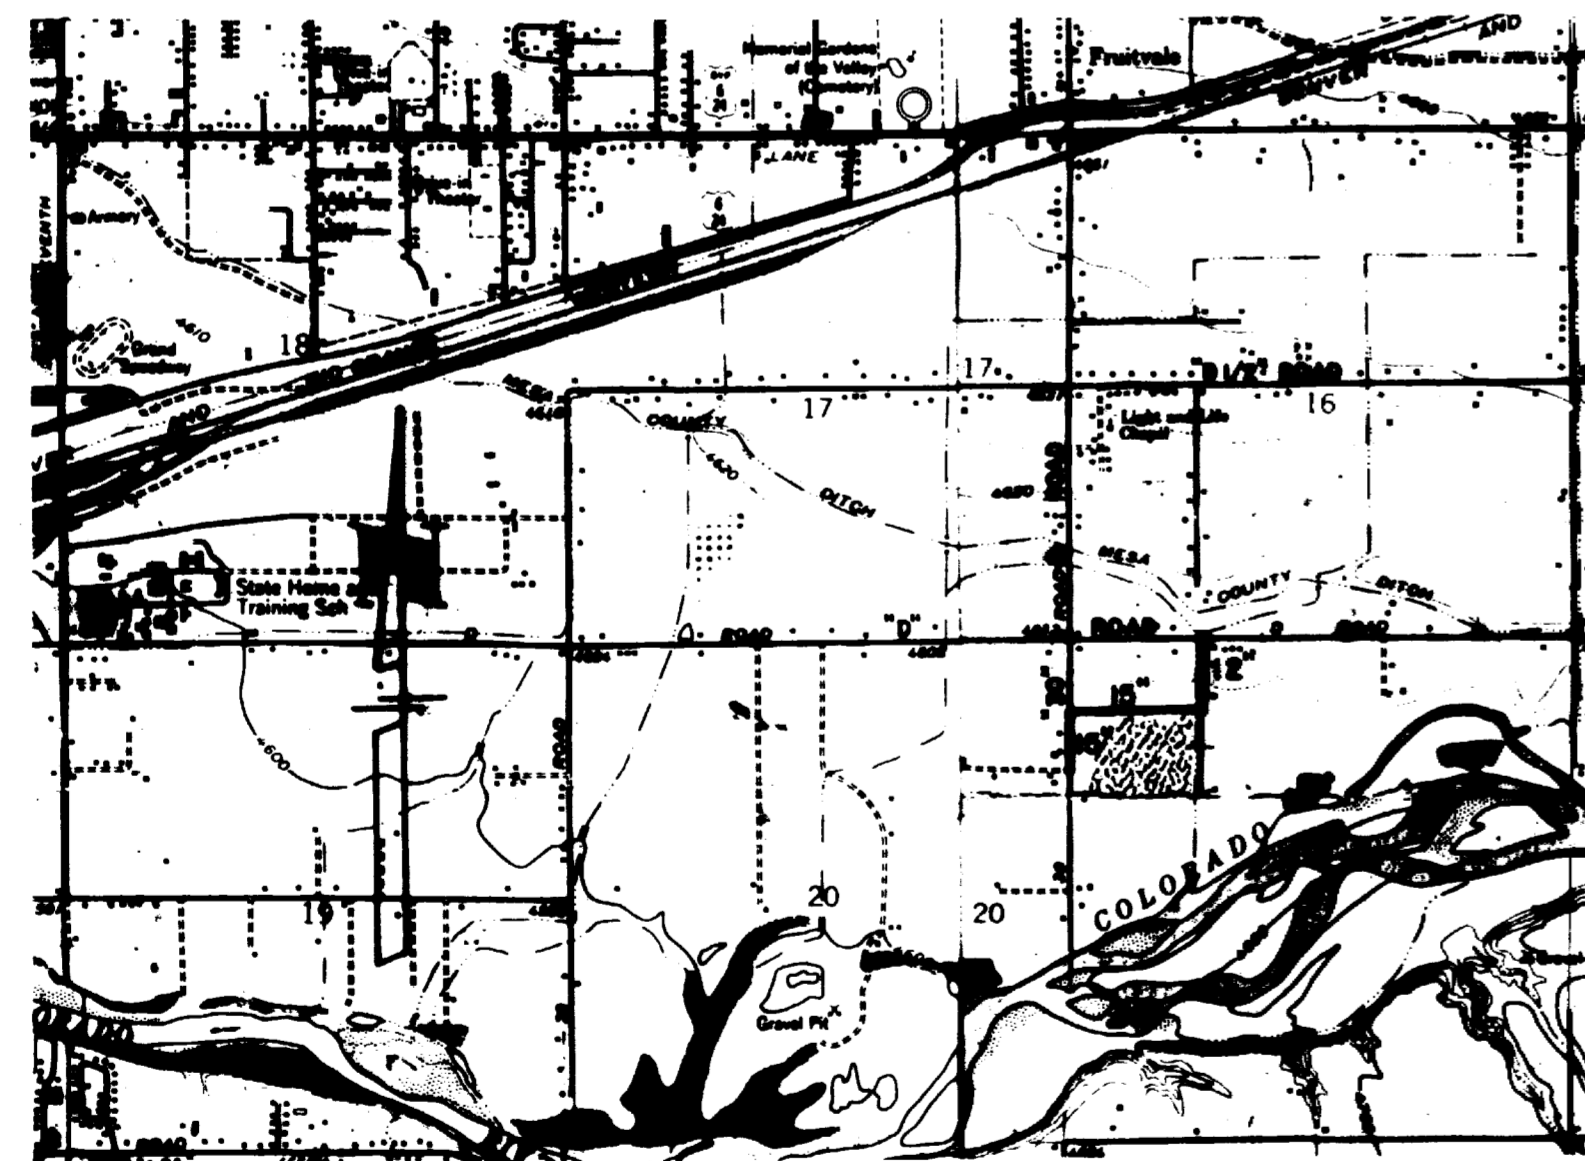

VICINITY MAP
SCALE: 1" = 2000'

SHEET INDEX

SHEET	DESCRIPTION
1	TITLE SHEET
2	"30" ROAD; FROM "C 3/4" TO "C 7/8"
3	"C 7/8" ROAD; FROM "30" ROAD TO "30 1/4"
4	"30 1/4" ROAD; FROM "C 7/8" ROAD TO "D"
5	DETAILS
6	STANDARD DETAILS

AS BUILT DRAWINGS

NOTE:
This is to certify that the system
infiltration does not exceed 200
gallons per inch diameter per mile
of length per day.



PARAGON ENGINEERING INC.

For other sheets please see

n:\files\02_sewer\sewer\sew_tif\single\02031302-06