



SECTION A-A
1" = 2'-0"


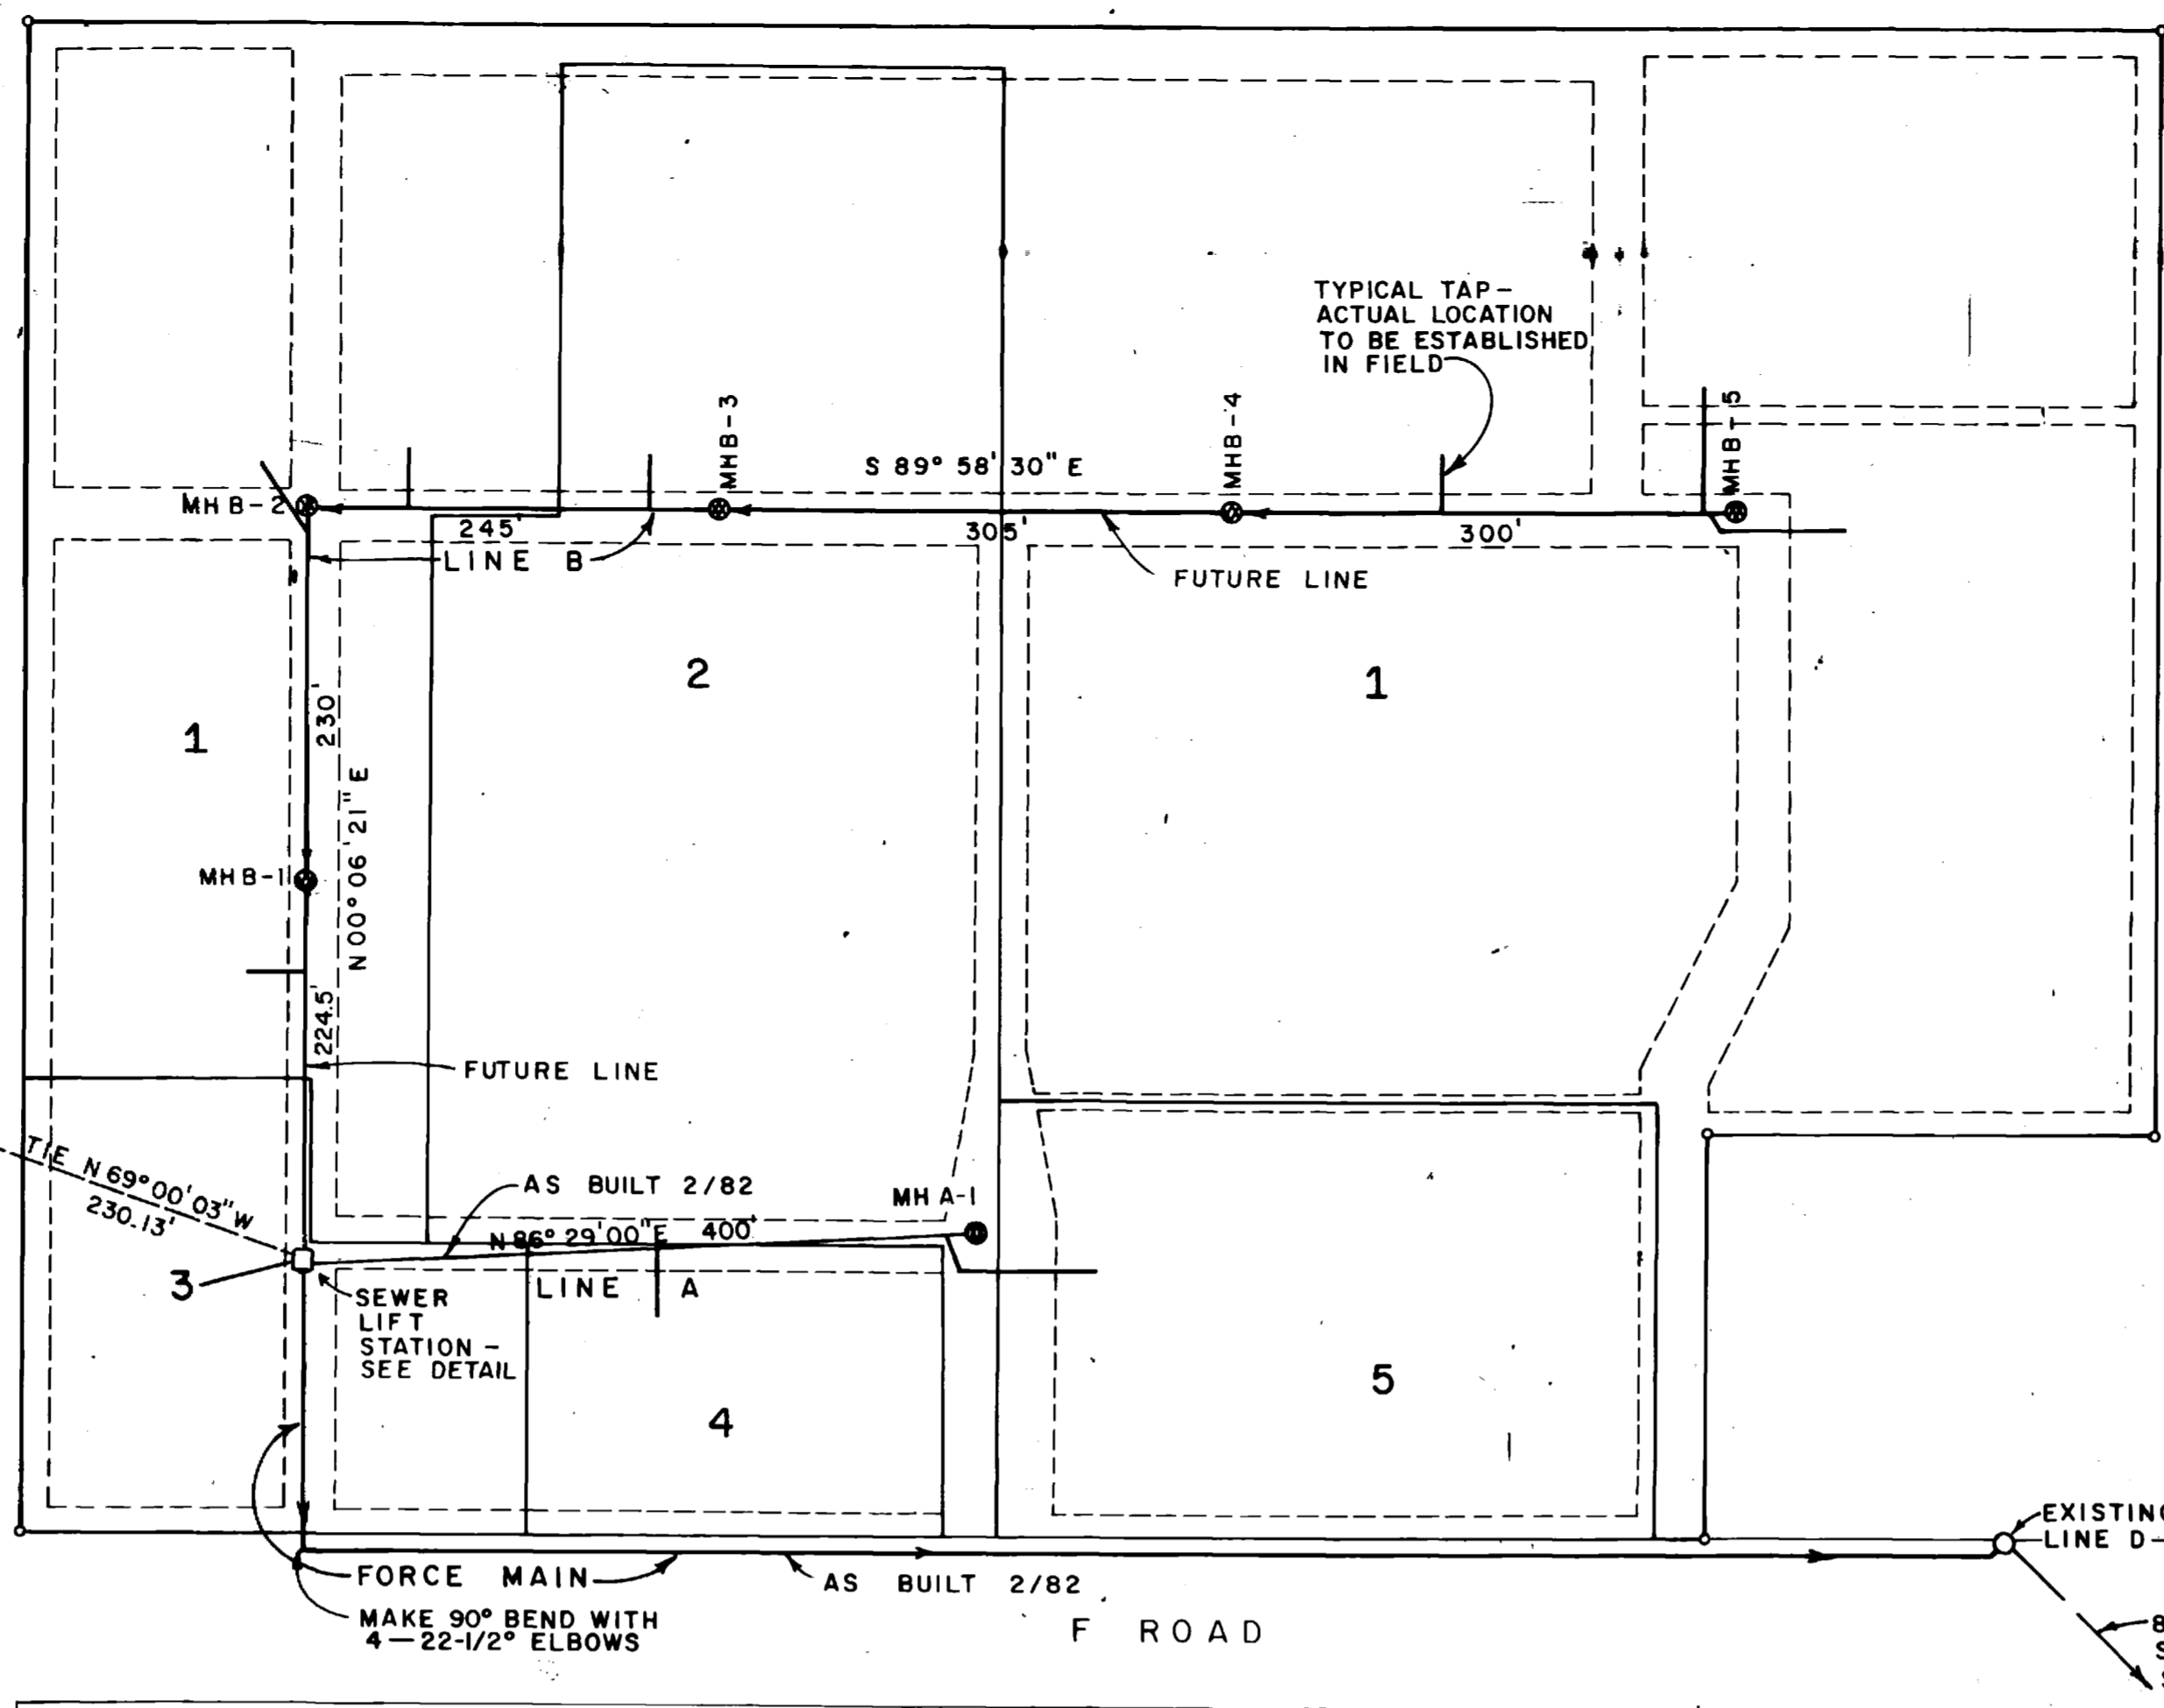


PLAN
1" = 100'

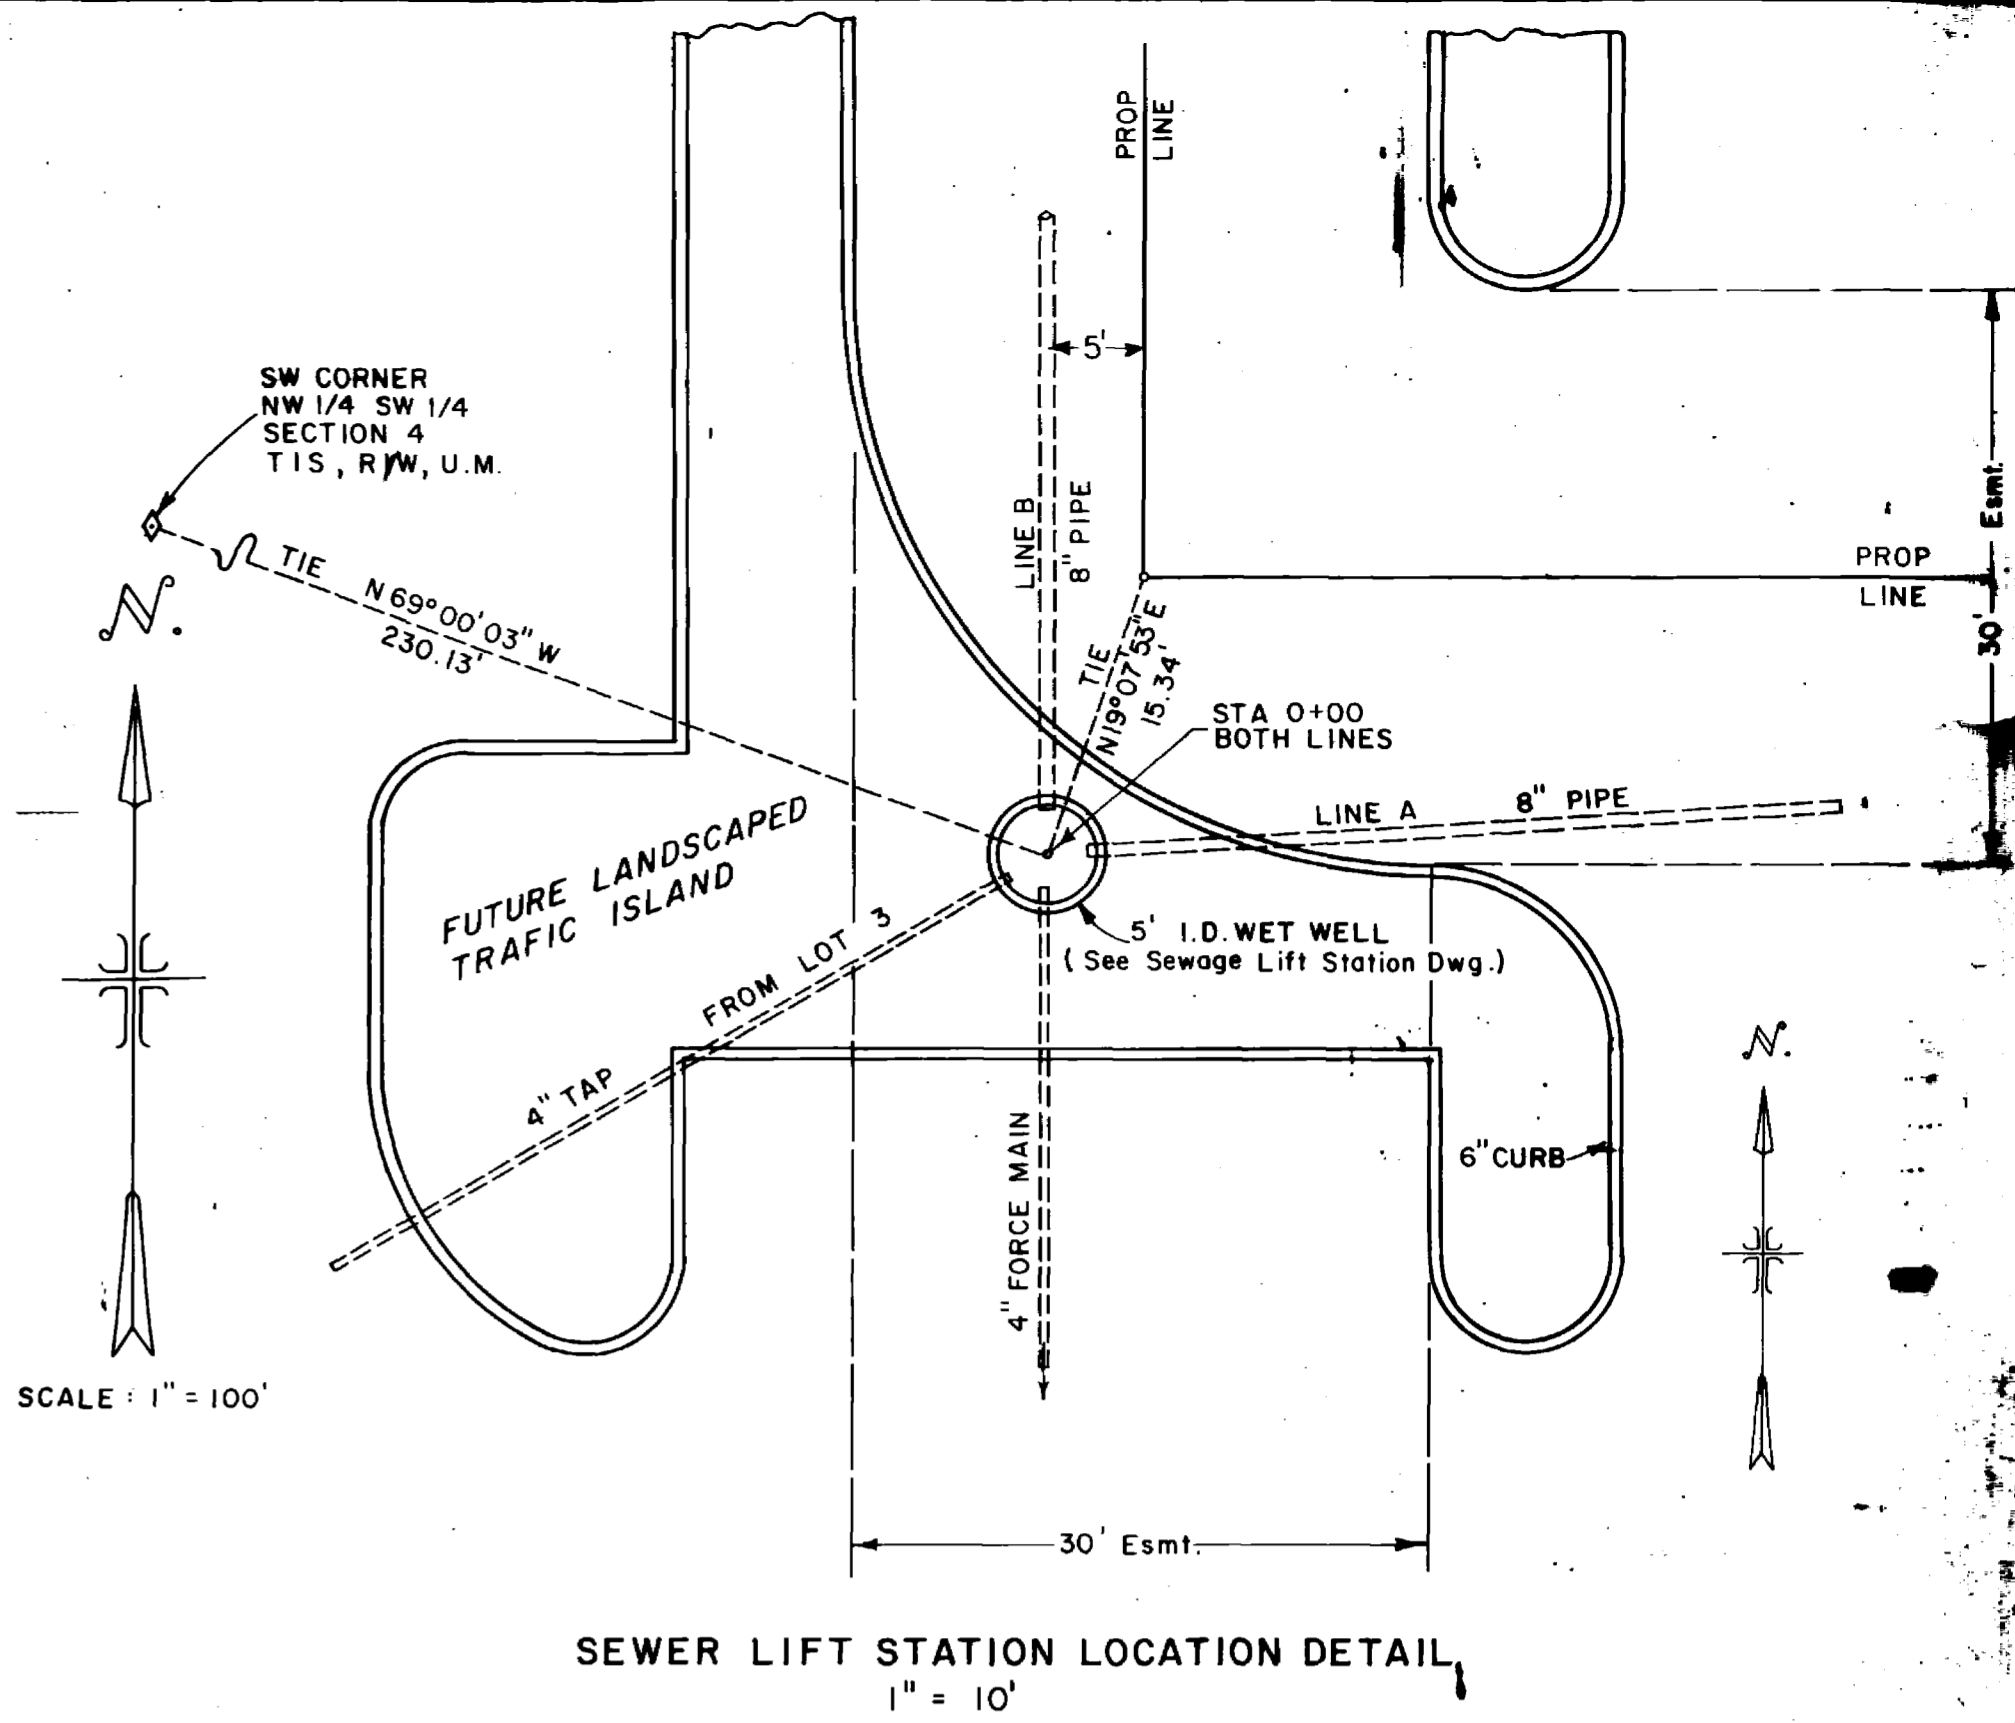

SEWER LIFT STATION LOCATION DETAIL
1" = 10'

AS BUILT 2/82
LINE A AND FORCE MAIN
INSTALLED BY SICKLE CONSTRUCTION
INFILTRATION DOES NOT EXCEED 200
GAL/IN. DIA./MILE/DAY

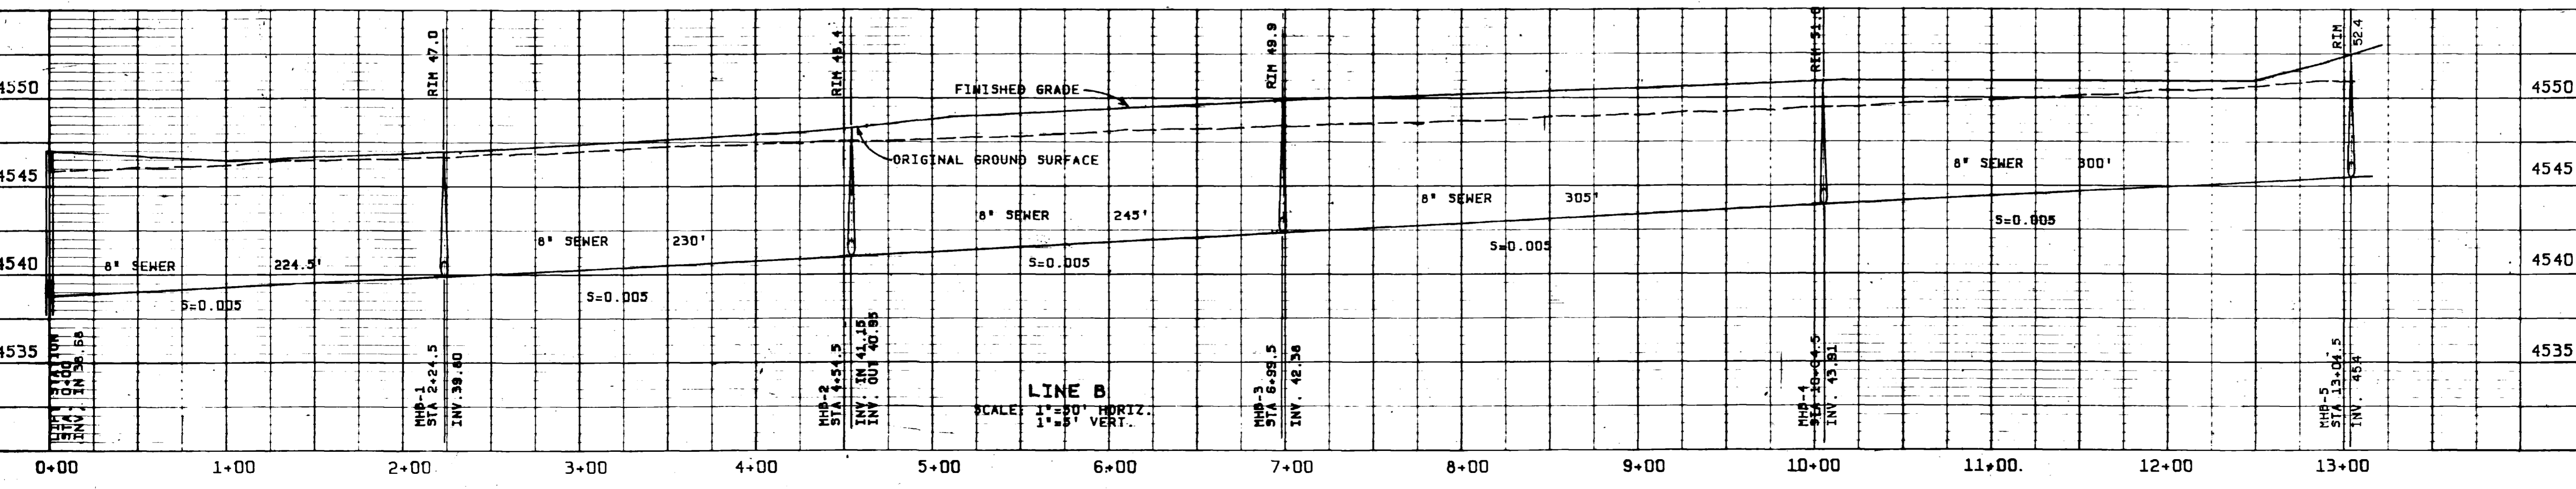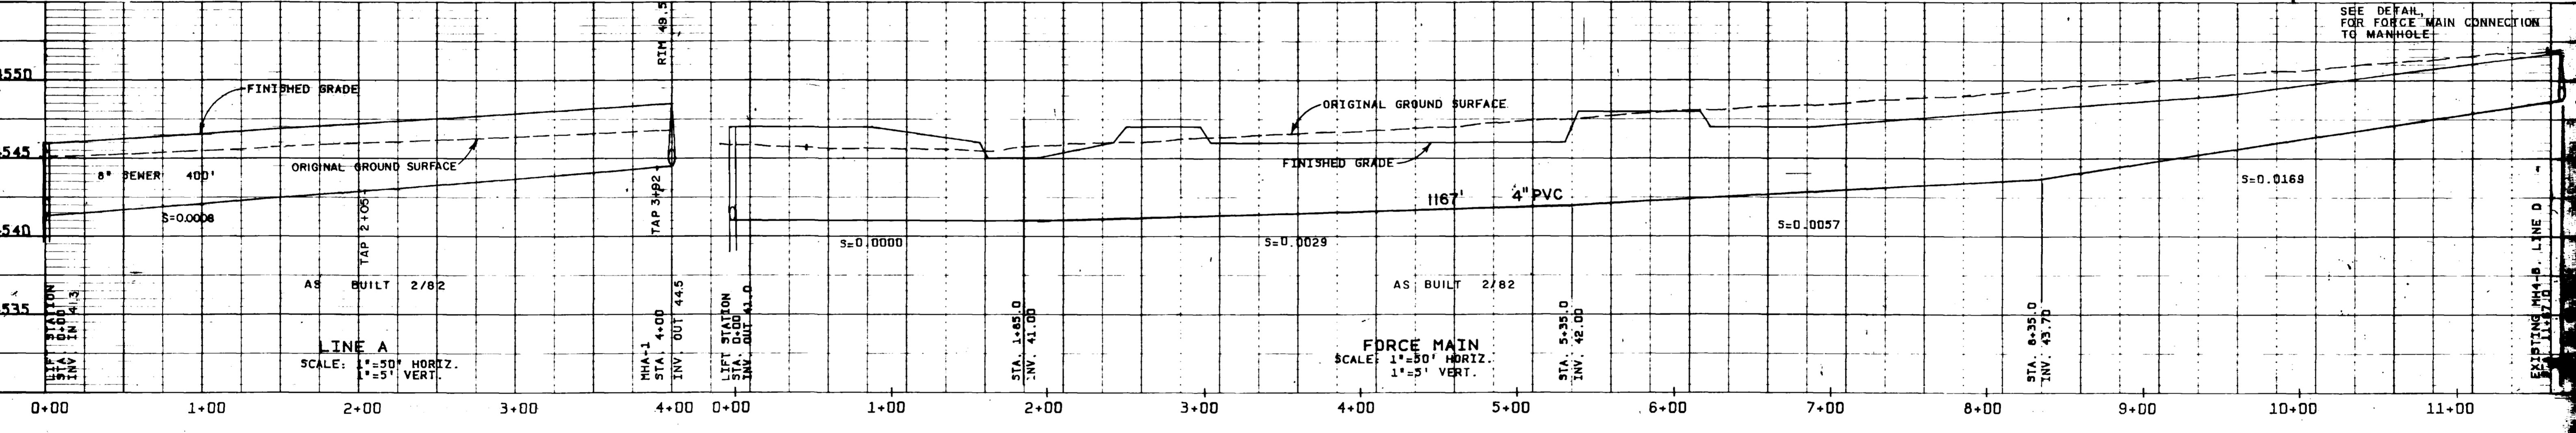

SEE DETAIL FOR FORCE MAIN CONNECTION TO MANHOLE

WESTERN ENGINEERS, INC.
MESA VILLAGE
SEWER PLAN & PROFILE

MESA COUNTY, COLORADO
ENGINEER A.S.C. DRAWN A.S.C. CHECKED
GRAND JUNCTION, CO. TEL. 436-921-1111

DATE: 16.18