


EXISTING MANHOLE NO 241  
CONSTRUCTED AS SHOWN  
BY WESTERN ENGINEER  
ON HORIZON DRIVE  
SHEET 1 OF 3  
DWS NO 1-78-16


WATER SERVICE  
Water Valve

TRANS at South side  
Power cable  
ASSUMED ELEVATION  
EL: 2100.00

TEL. CABLE

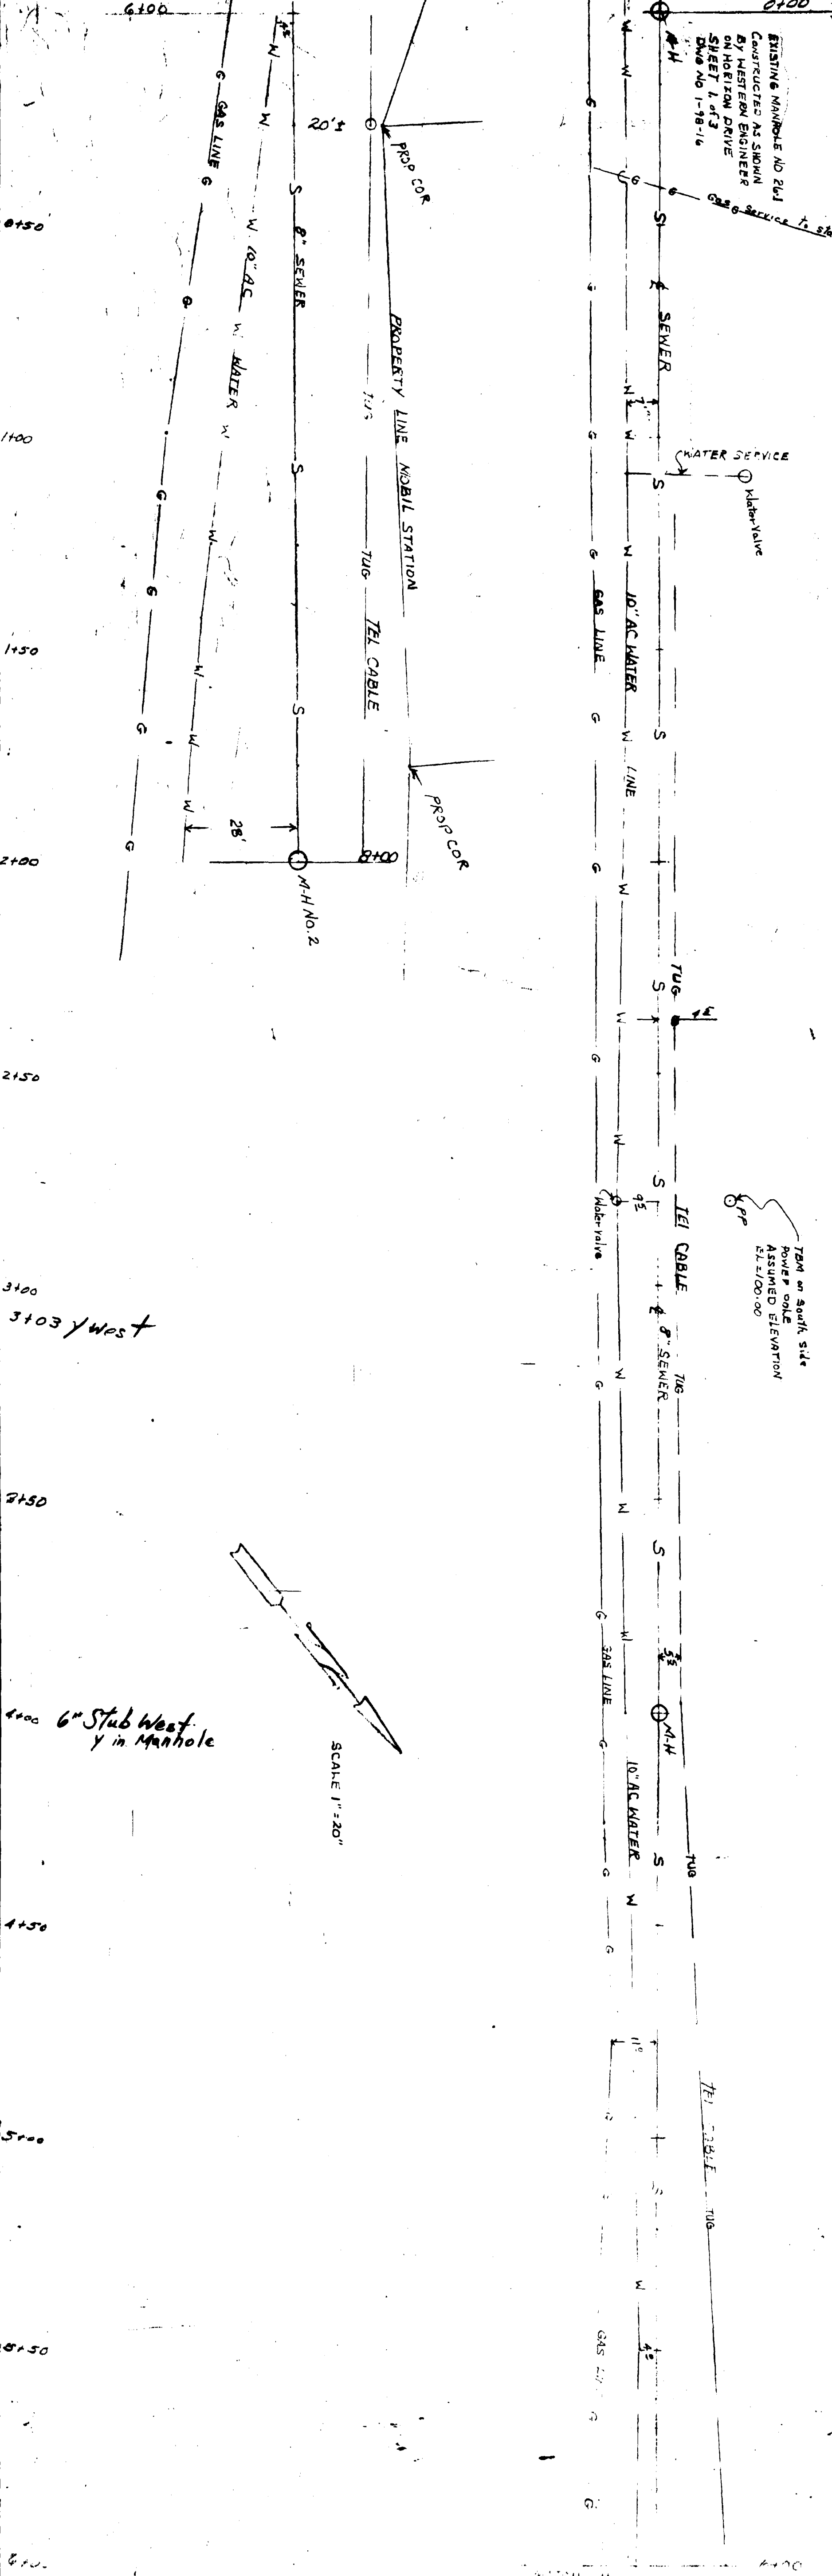


SCALE 1" = 20'

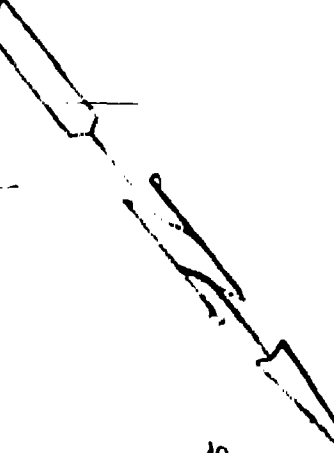

3100  
3103 West

4000 6" Stub West  
y in Manhole

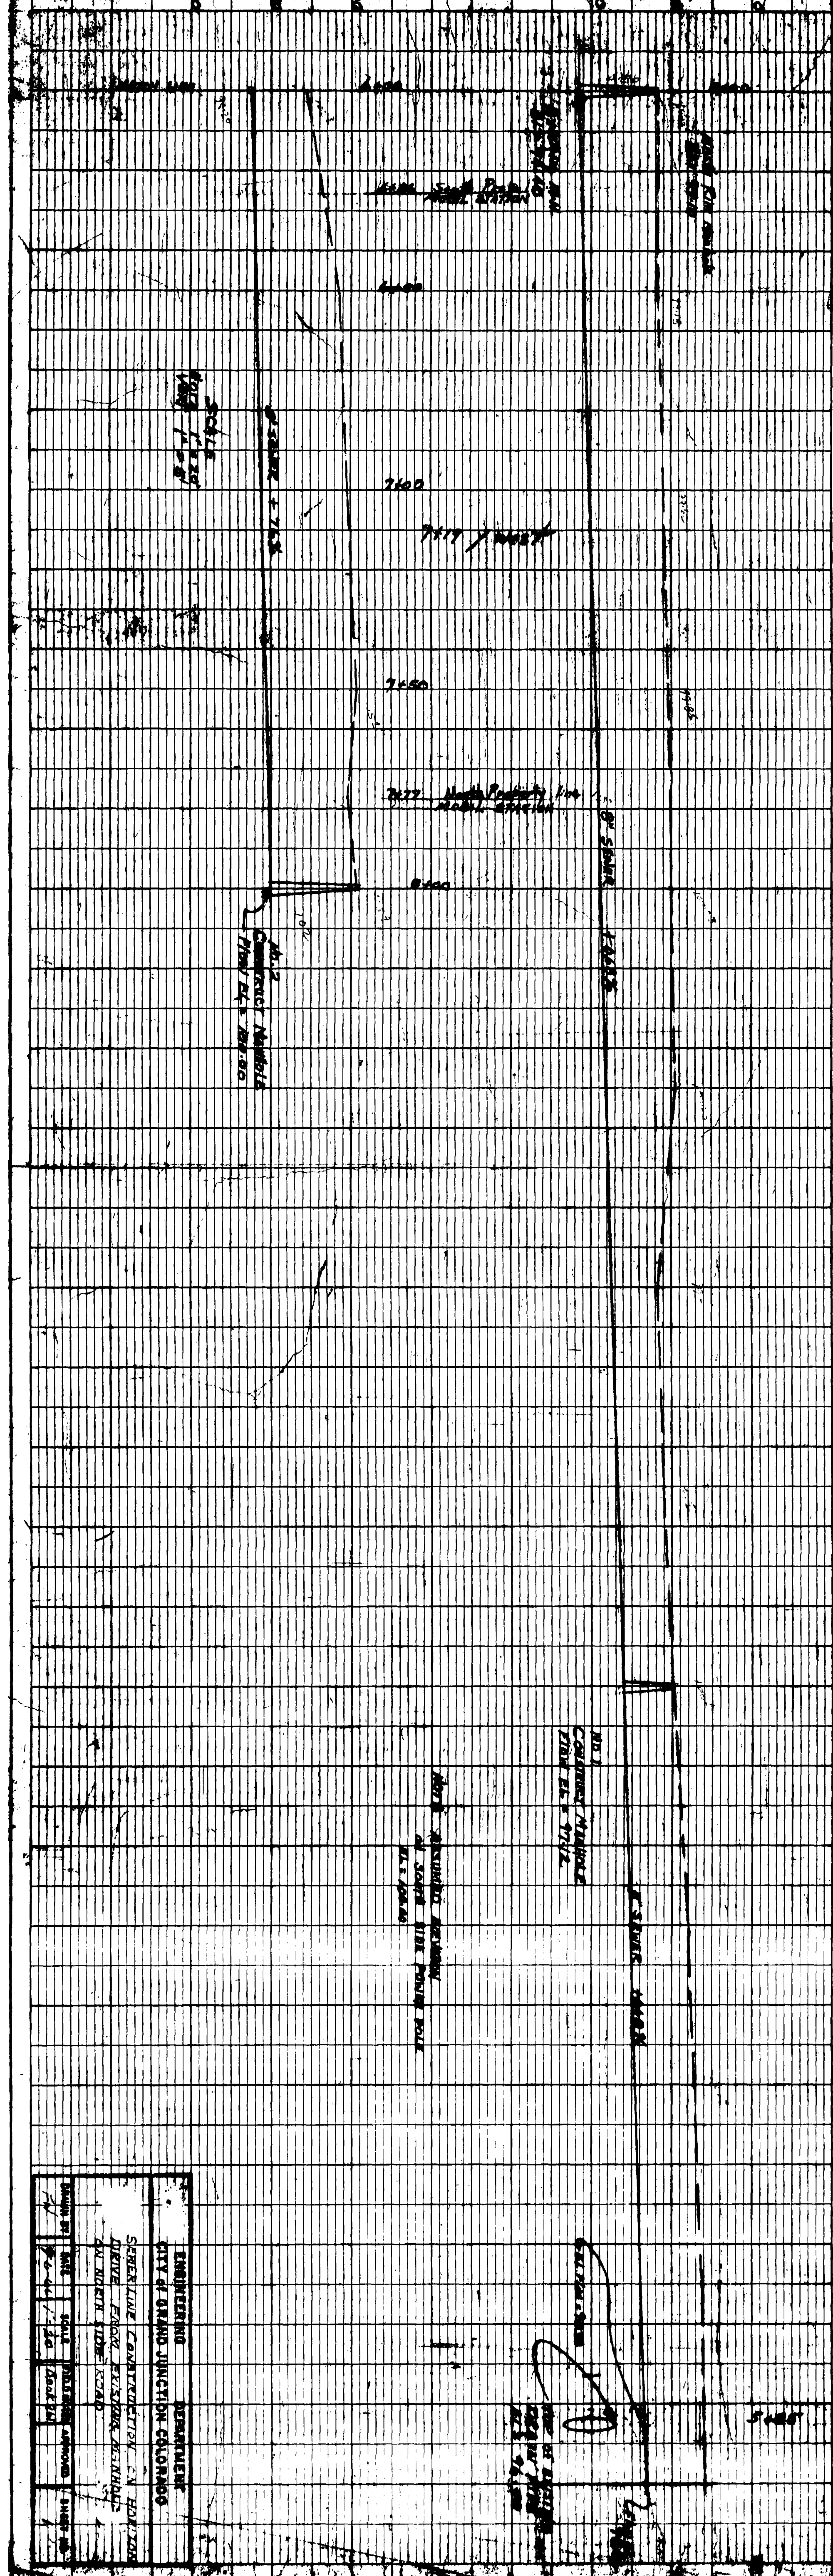

SEWER 15\"/>

2477 South Pacific, Inc  
MOBILE STATION

RD 1  
CONCRETE MANHOLE  
FROM EL. 4000

NOTE: ASSUMING EXISTENCE  
OF SOUTH SIDE POWER POLE  
AT EL. 2100.00

DATE OF REVIEW  
2/21/78  
2/21/78  
2/21/78

ENGINEER	DEPARTMENT
CITY OF GRAND JUNCTION COLORADO	
SEWER LINE CONSTRUCTION IN HORIZON	
DRIVE FROM WESTERN ENGINEERS	
AND NORTH SIDE ROAD	
DATE	SCALE
2/21/78	1" = 20'

