



COMBINED SEWER DISTRICT
No. 7

PROPOSED COMBINED SEWER
SEWER DIST #

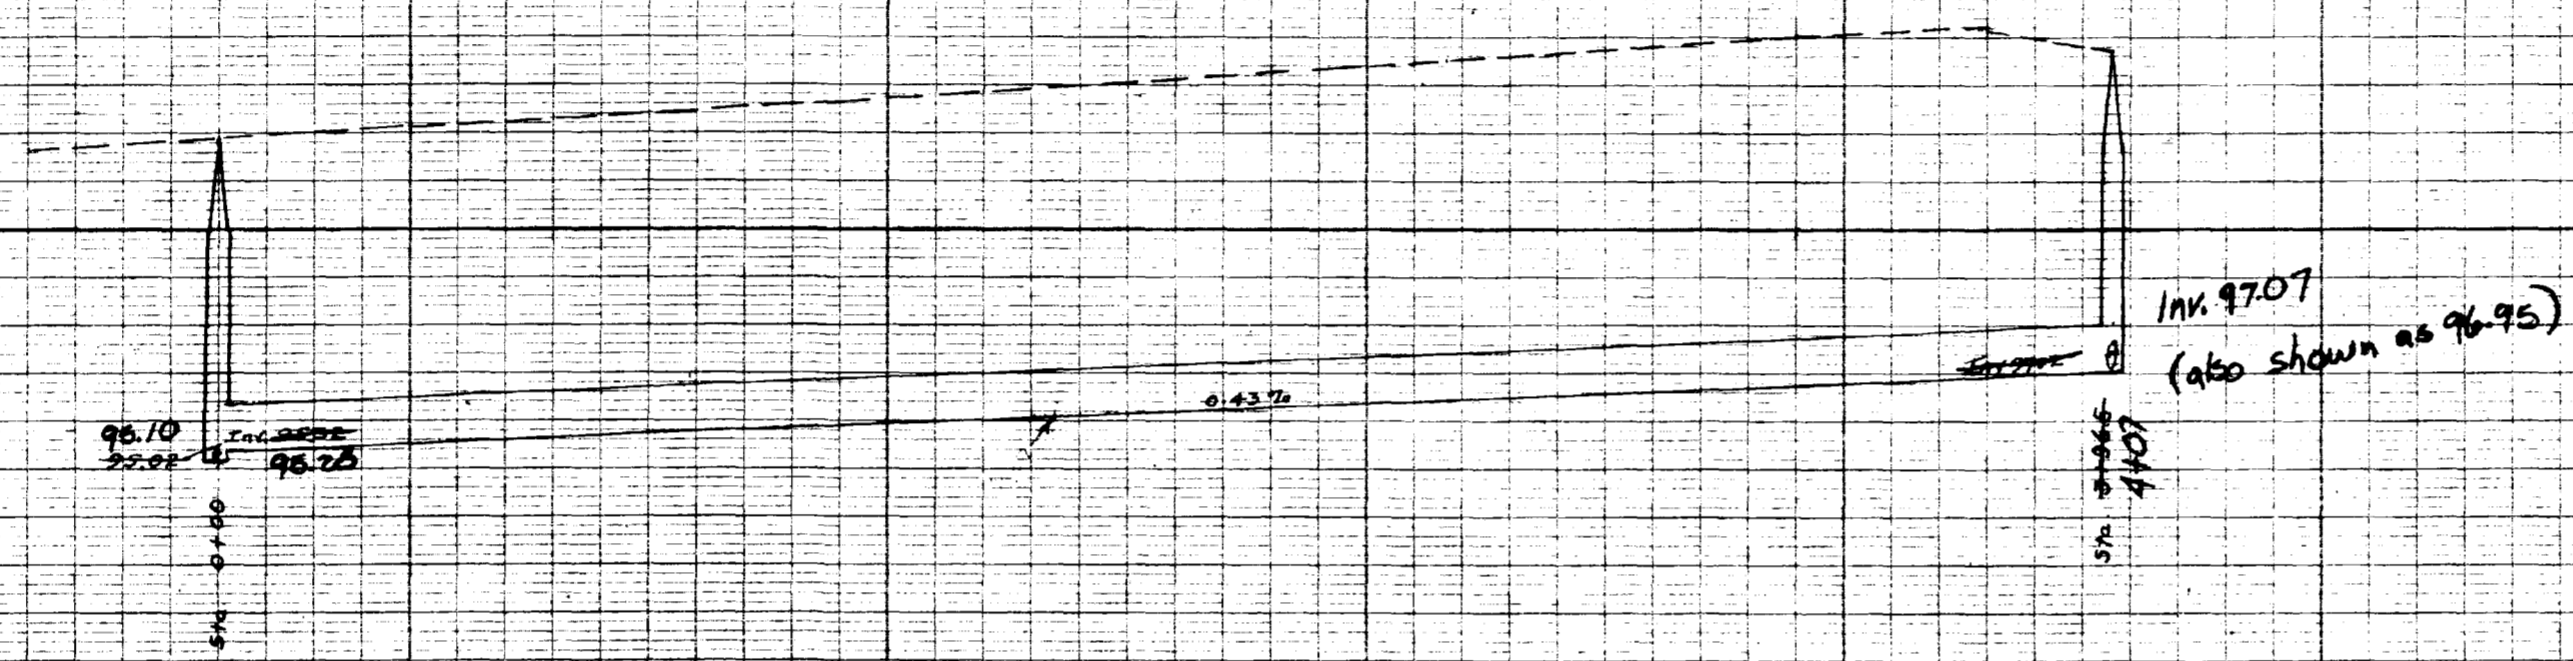

Book 99
Pg. 67

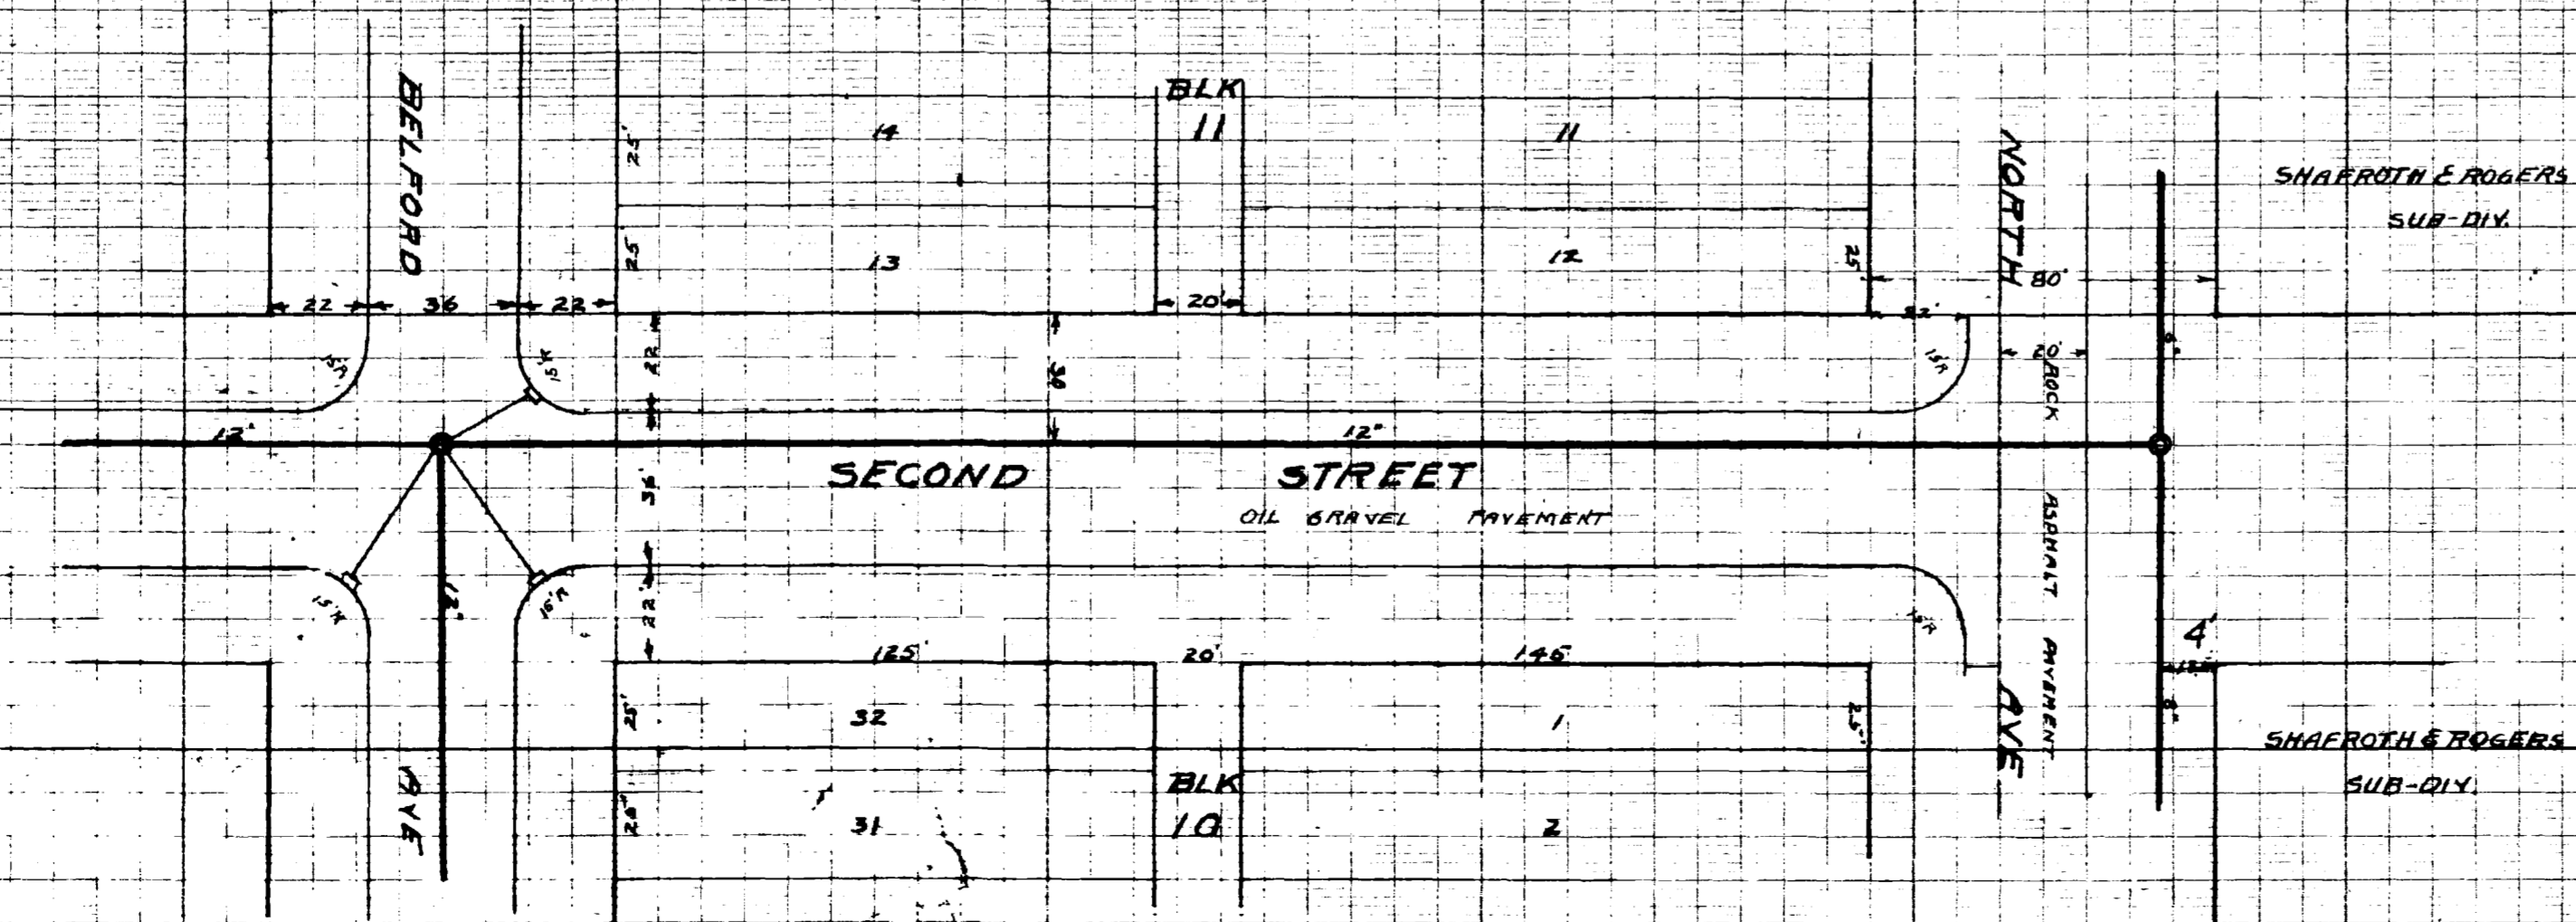

COMBINED
SEWER DIST.

Book 109
P-27

