
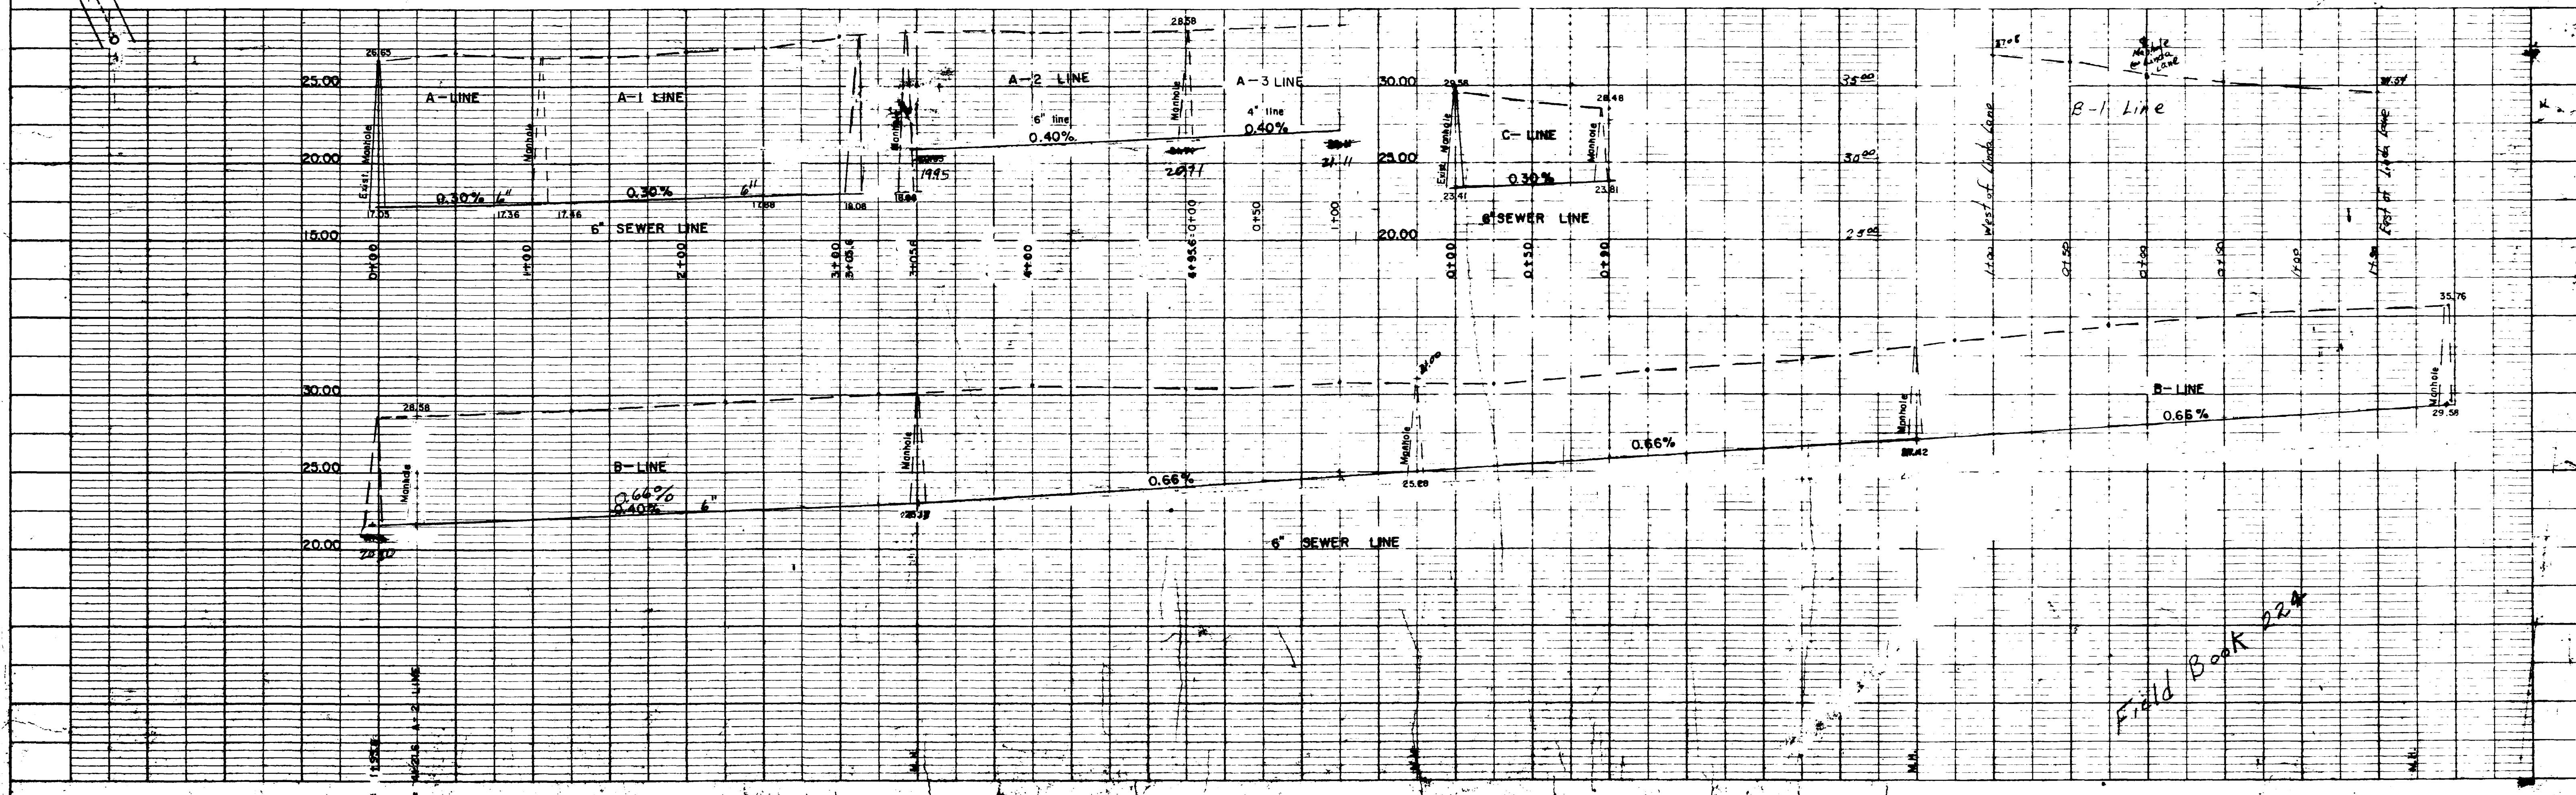


SEWER DISTRICT NO. 17
 GRAND JUNCTION COLORADO
 1957

SUMMATION OF QUANTITIES

Total Lin. Ft. of 6" Tile	1,872	○	EXISTING MANHOLES
Standard Manholes Required	7	●	MANHOLE REQUIRED
Total 6" Fittings Required	39	---	EXISTING SEWER
Total Lin. Ft. of Trenching	2,137	---	SEWER TO BE BUILT
Total Sq.ft. of District	441,254.00		
Total Lin. Ft. of 4" Tile	325		
Manholes to be Removed	1		

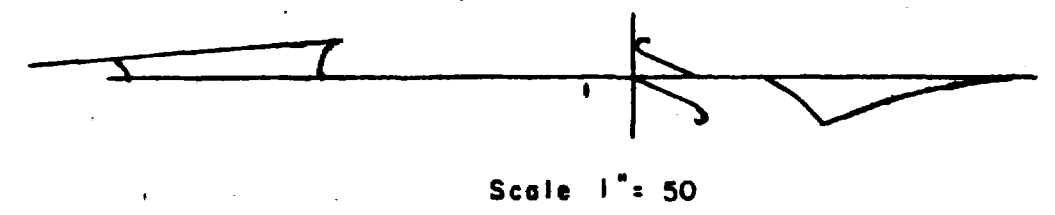

DATE 1 - PLAN, PROFILE & P. S. R. E. STANDARD
 THE PRECISION PAPER CO. CHICAGO

Field Book 224