
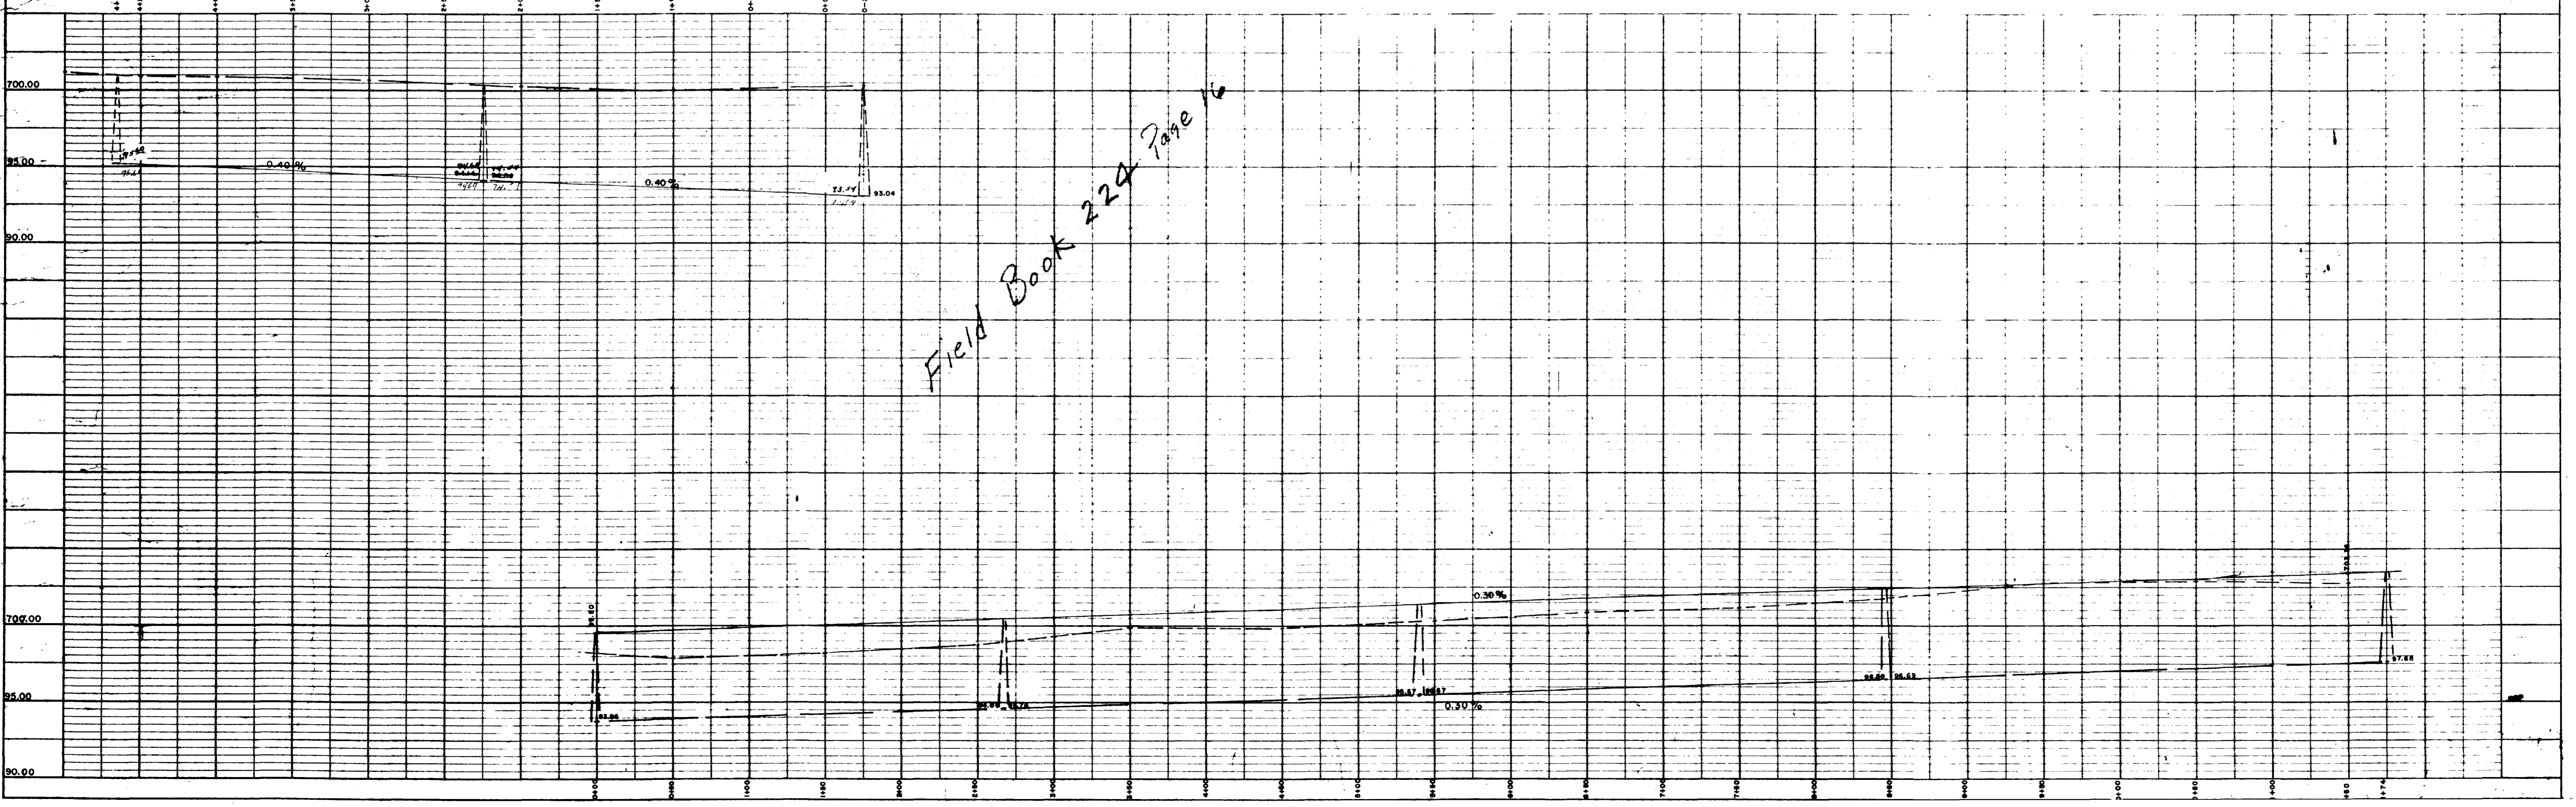



SUMMATION OF QUANTITIES

STANDARD MANHOLES REQUIRED	5
LINEAL FEET OF TRENCHING	1,666.0
TOTAL 6" Ys REQUIRED	25
TOTAL LINEAL FEET OF 6' TILE	1,616.0

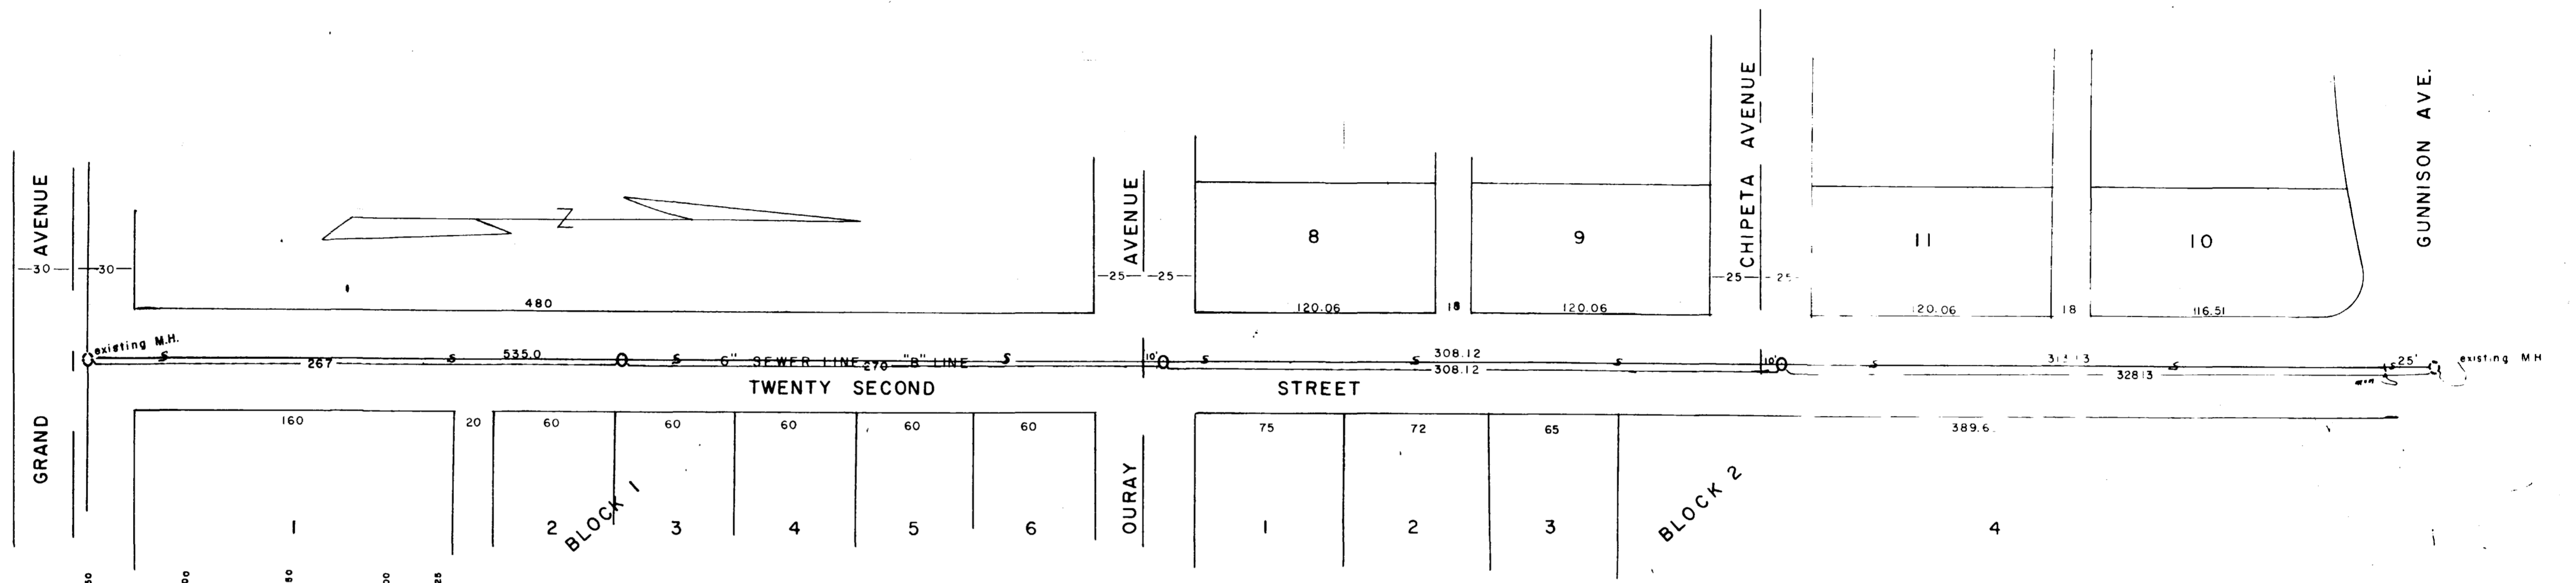

SEWER DIST. NO. 18

ASSESSMENT MAP

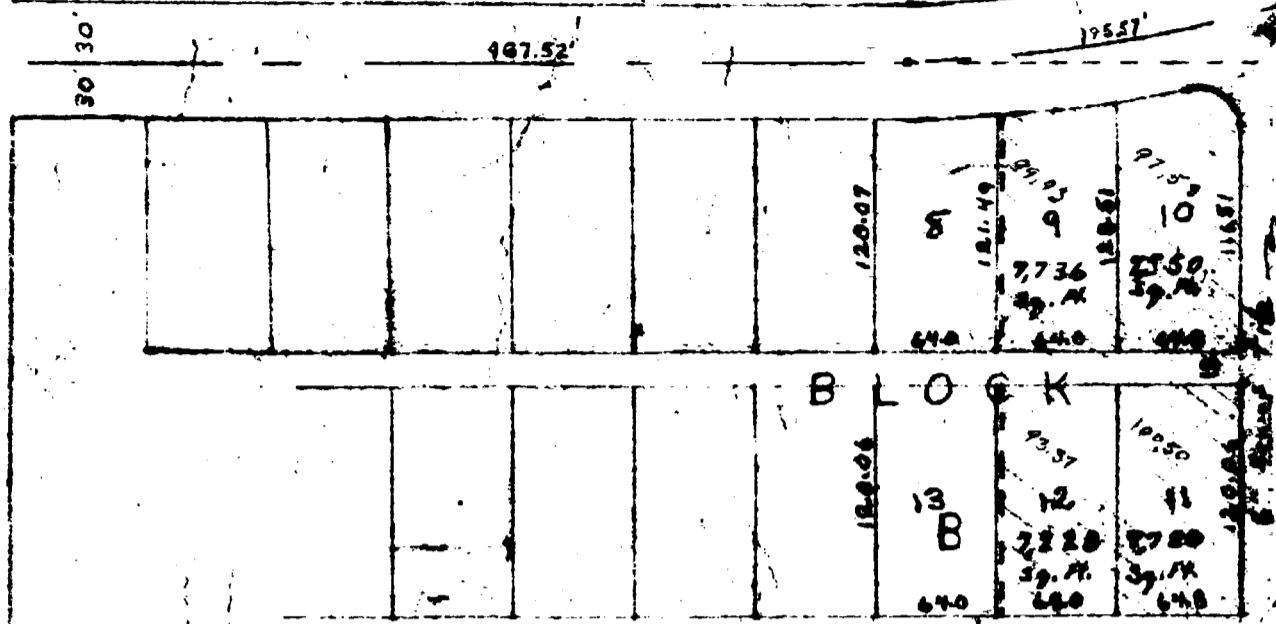

Sewer Dist #18


Total sq. ft. to be assessed

~~341,712~~ @ 0.02 sq. ft. = 6834.24

341,712 sq. ft. @ 0.02 sq. ft. = 6834.24

Total Lin. ft. of Sewer Pipe
1,668 Lin. ft.

Total Number of Manholes Needed 5

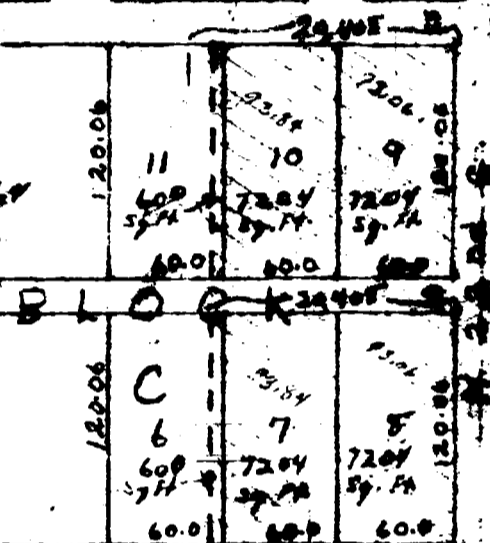

OURAY AVENUE

BLOCK A

BLOCK F

125.5
64.5
125.5
64.5
251.0
129.0

120.06
60.0
180.06

