

**WEST ORCHARD MESA
SANITARY SEWER
TRUNK LINE EXTENSION**




1978






**CITY OF GRAND JUNCTION
COLO.**

ENGINEERING DEPARTMENT
City of GRAND JUNCTION
*West Orchard Mesa
Sanitary Sewer
Trunk Line Extension*

Drawn by *Ray*
Date *6-27-78*
Field Book *296*
Scale *1"=25'*

APPROVED BY
Ernest A. White
CITY ENGINEER
APPROVED BY
R. C. Wickman
CITY ENGINEER

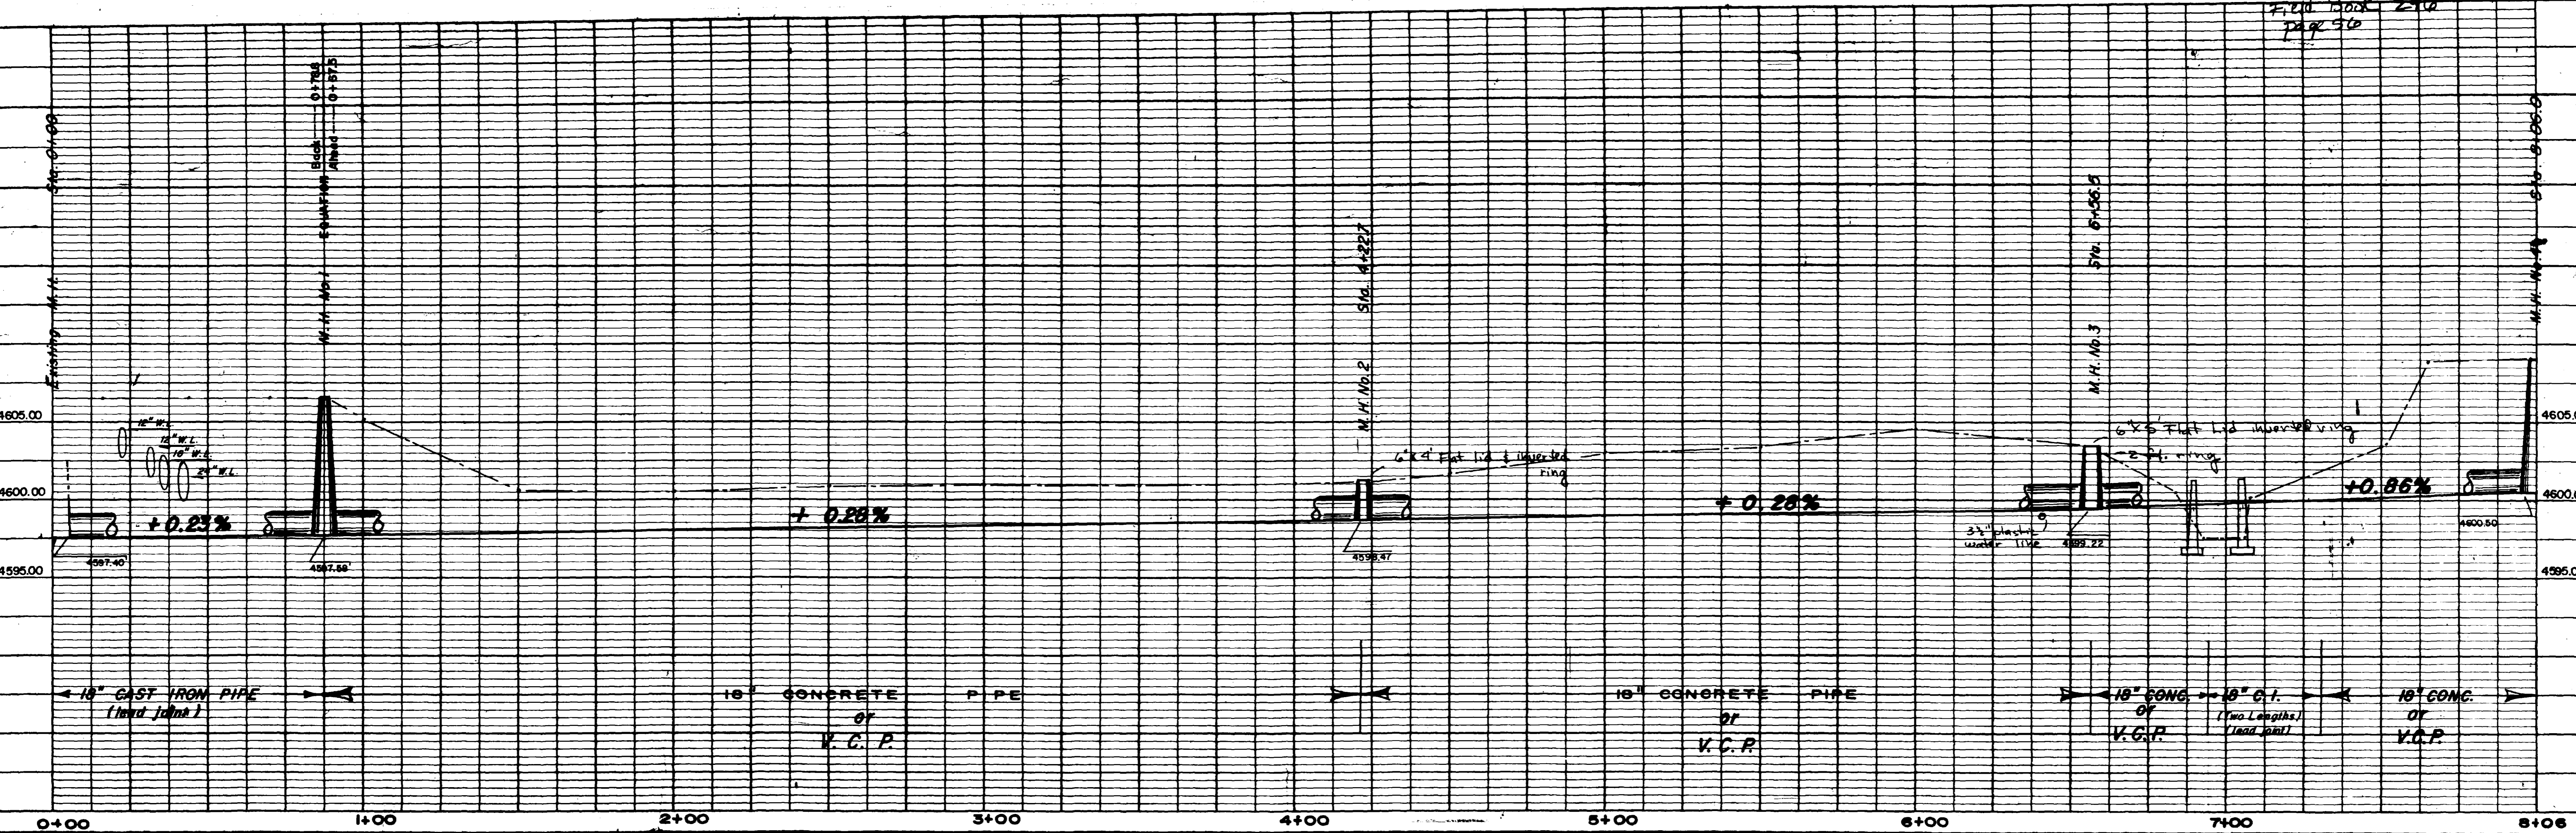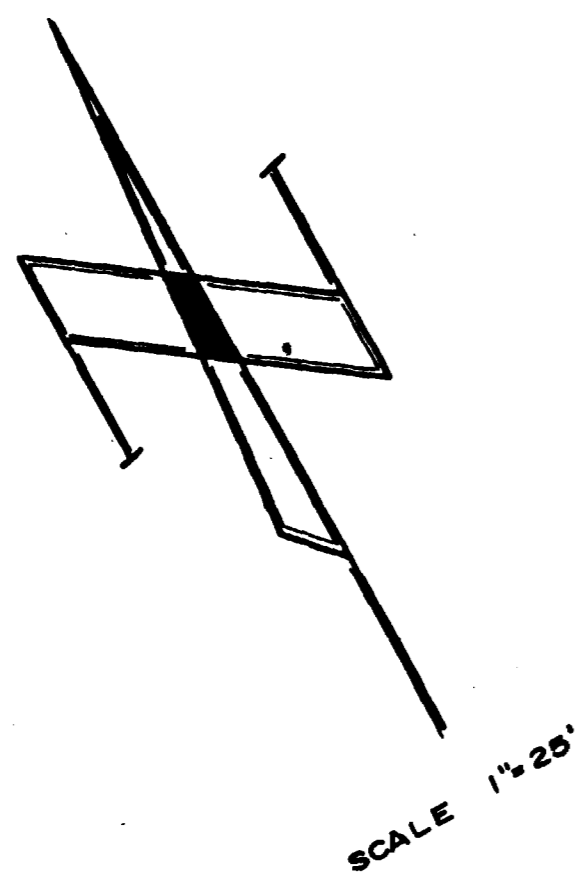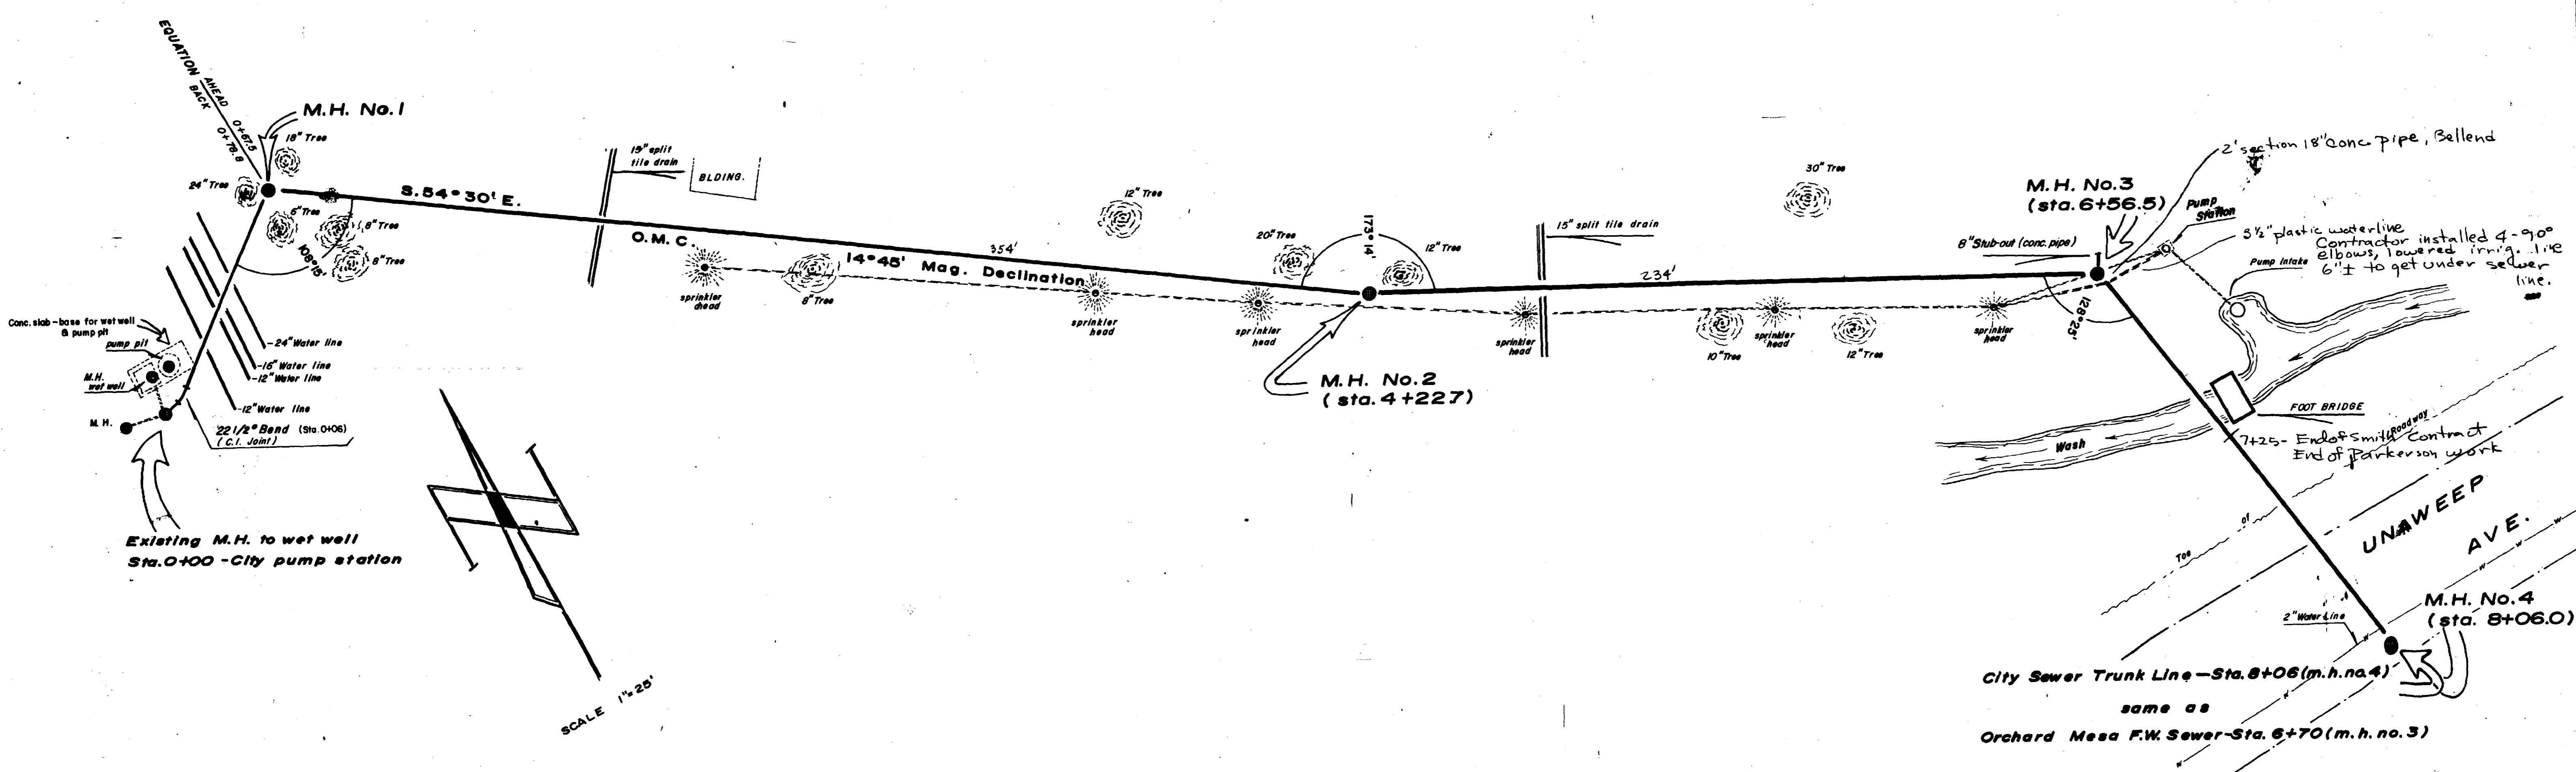

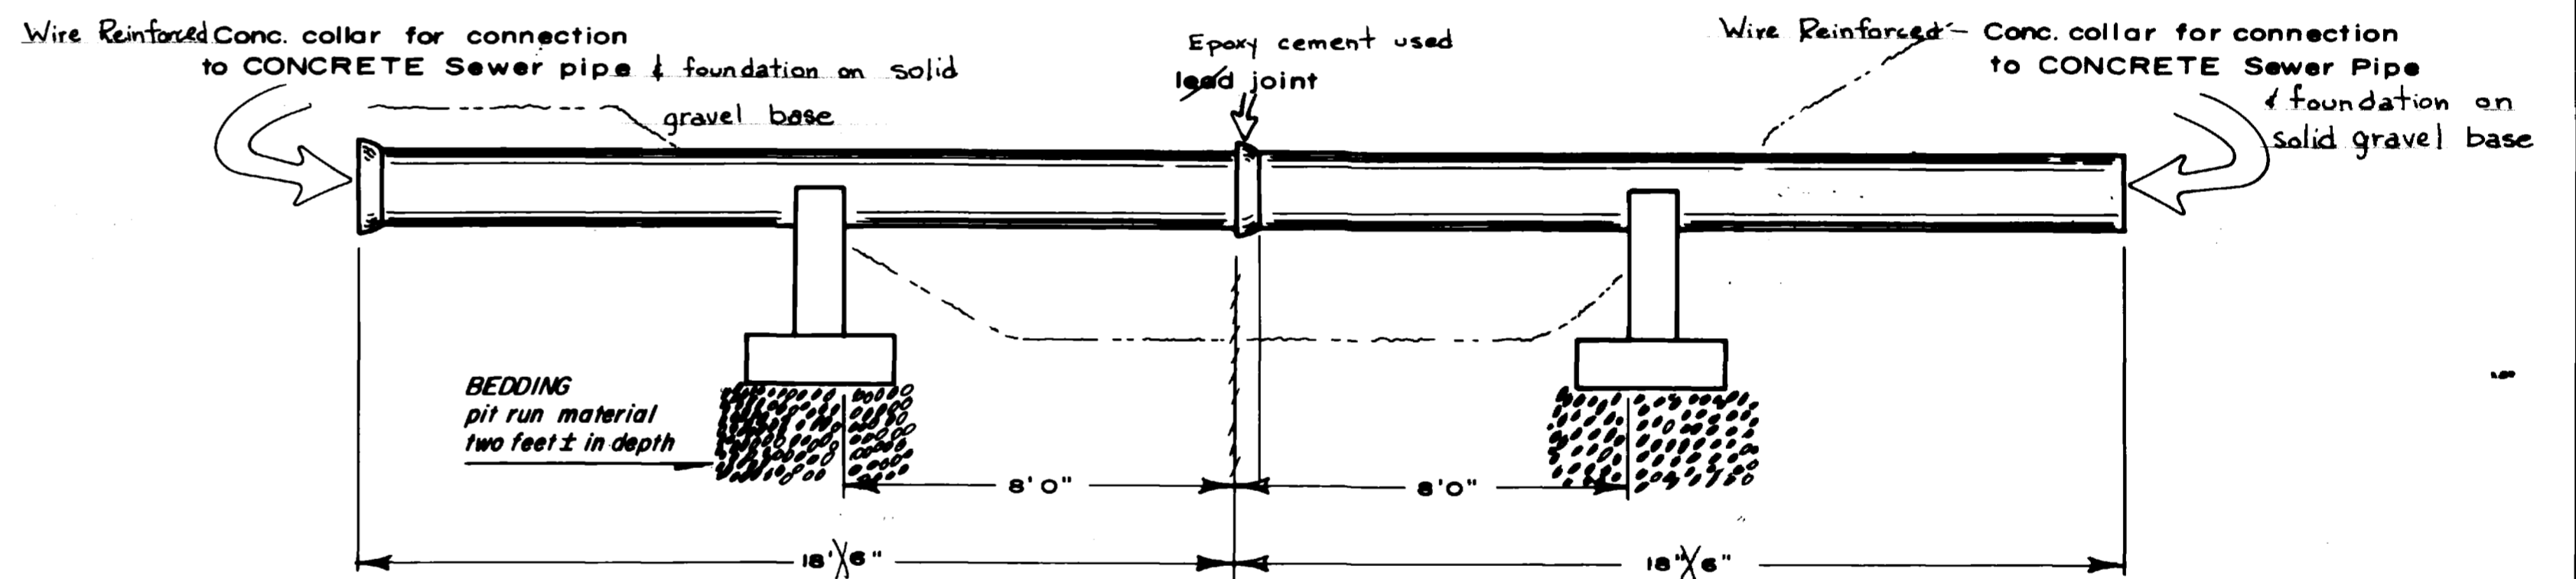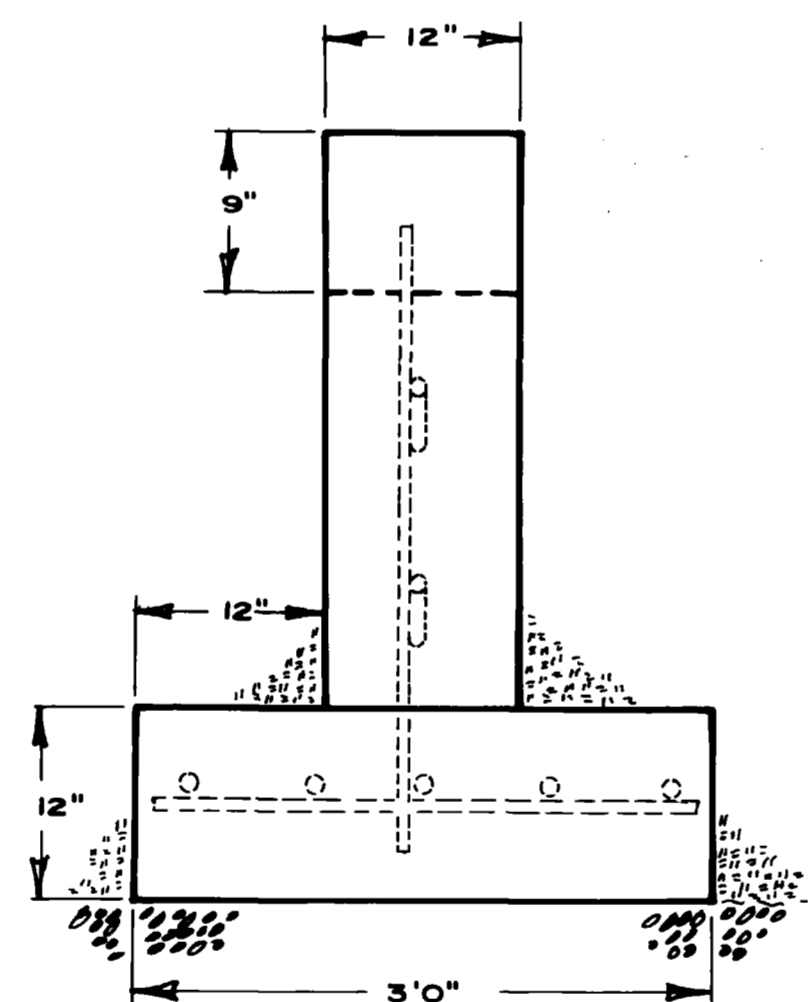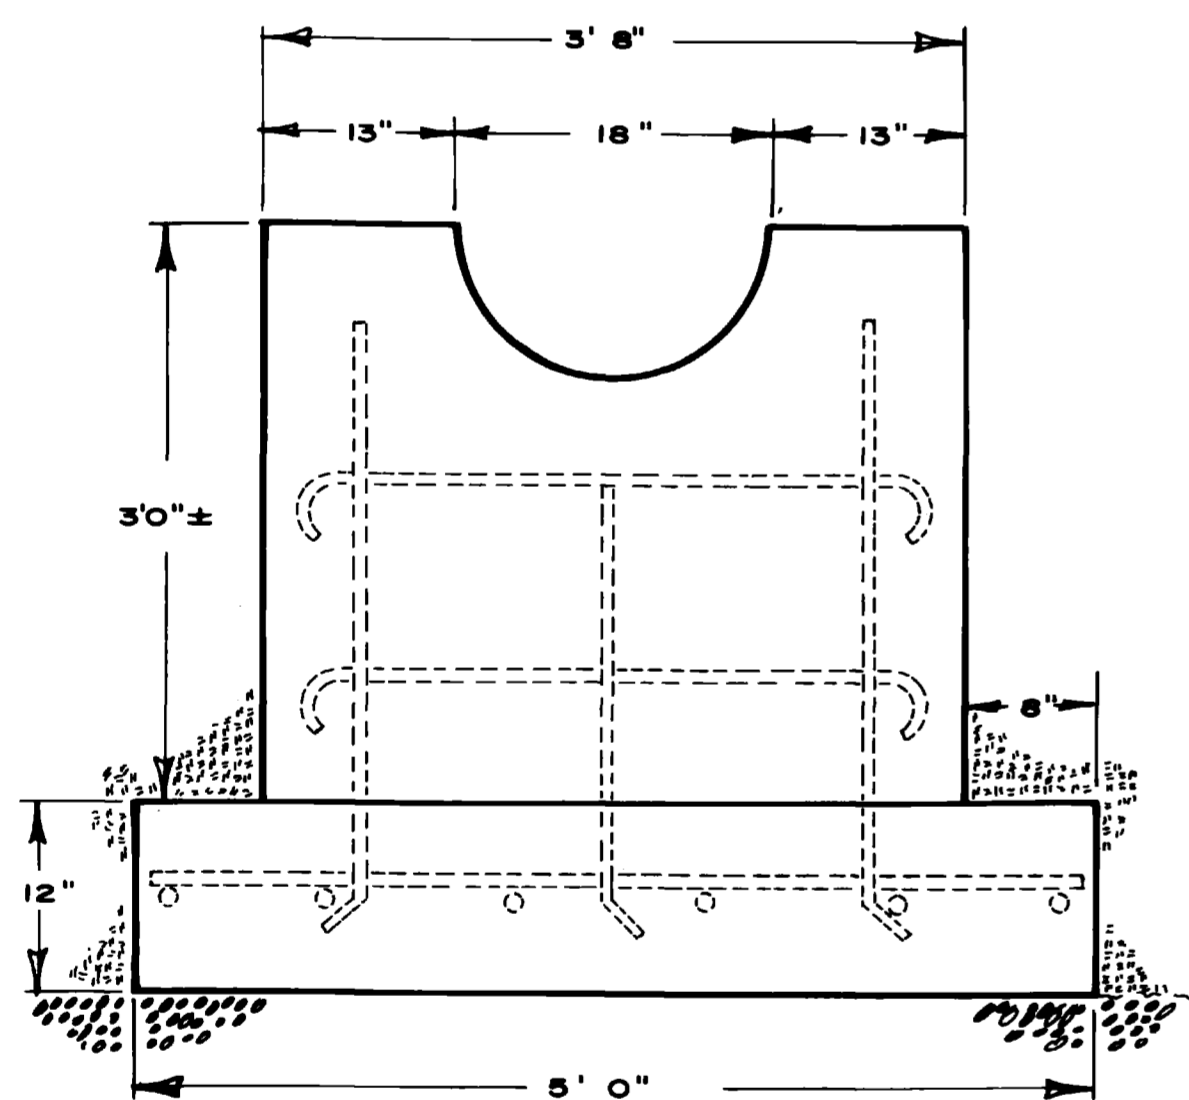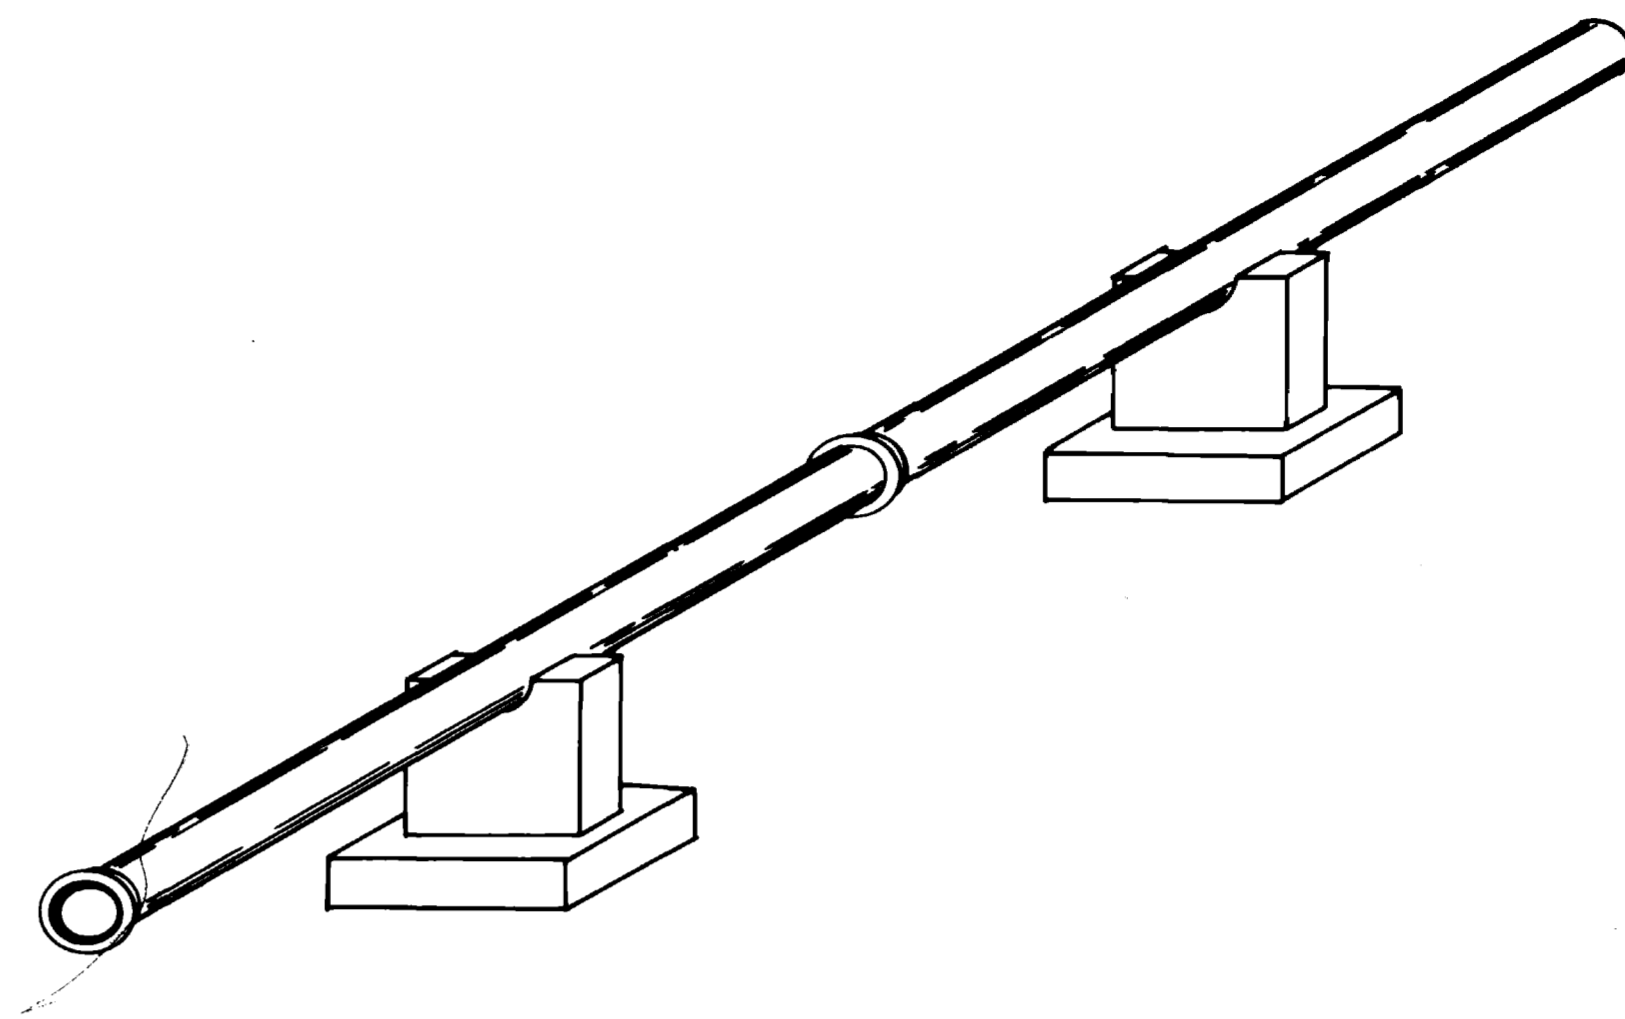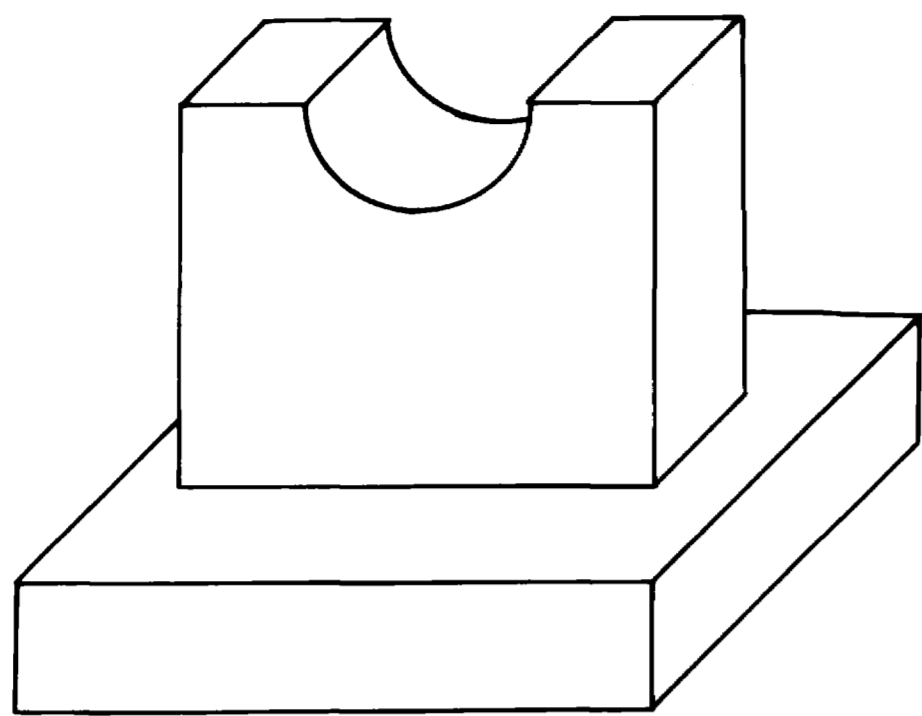

CROSSING

DETAIL

(Station 7 +14)