


- NOTES:
- All construction shall be in accordance with City of Grand Junction Standard Sanitary Sewer Details Drawing SS-1 and shall conform to City of Grand Junction, "Standard Specifications for Construction of Water Lines, Sanitary Sewers, Storm Drainage and Irrigation Systems", 1984, and City of Grand Junction, General Contract Conditions for Public Works and Utilities Construction 6C-97, 6C-50, and 6C-65.
 - The Contractor shall contact the City Public Works Superintendent (244-1567) prior to any cutting of pavement. All pavement and/or concrete disturbed in Fifteenth Street shall be replaced in kind to City Specifications.
 - The Contractor shall contact the City Utilities Superintendent (244-1568) prior to any disturbance of the existing sewer in Fifteenth Street. Existing flows in the Fifteenth Street sewer must be maintained at all times.
 - Utility locations as shown are approximate. The Contractor is responsible for determining exact locations during construction.
 - The Contractor shall be responsible for getting City Permits before beginning construction in the street right-of-way.

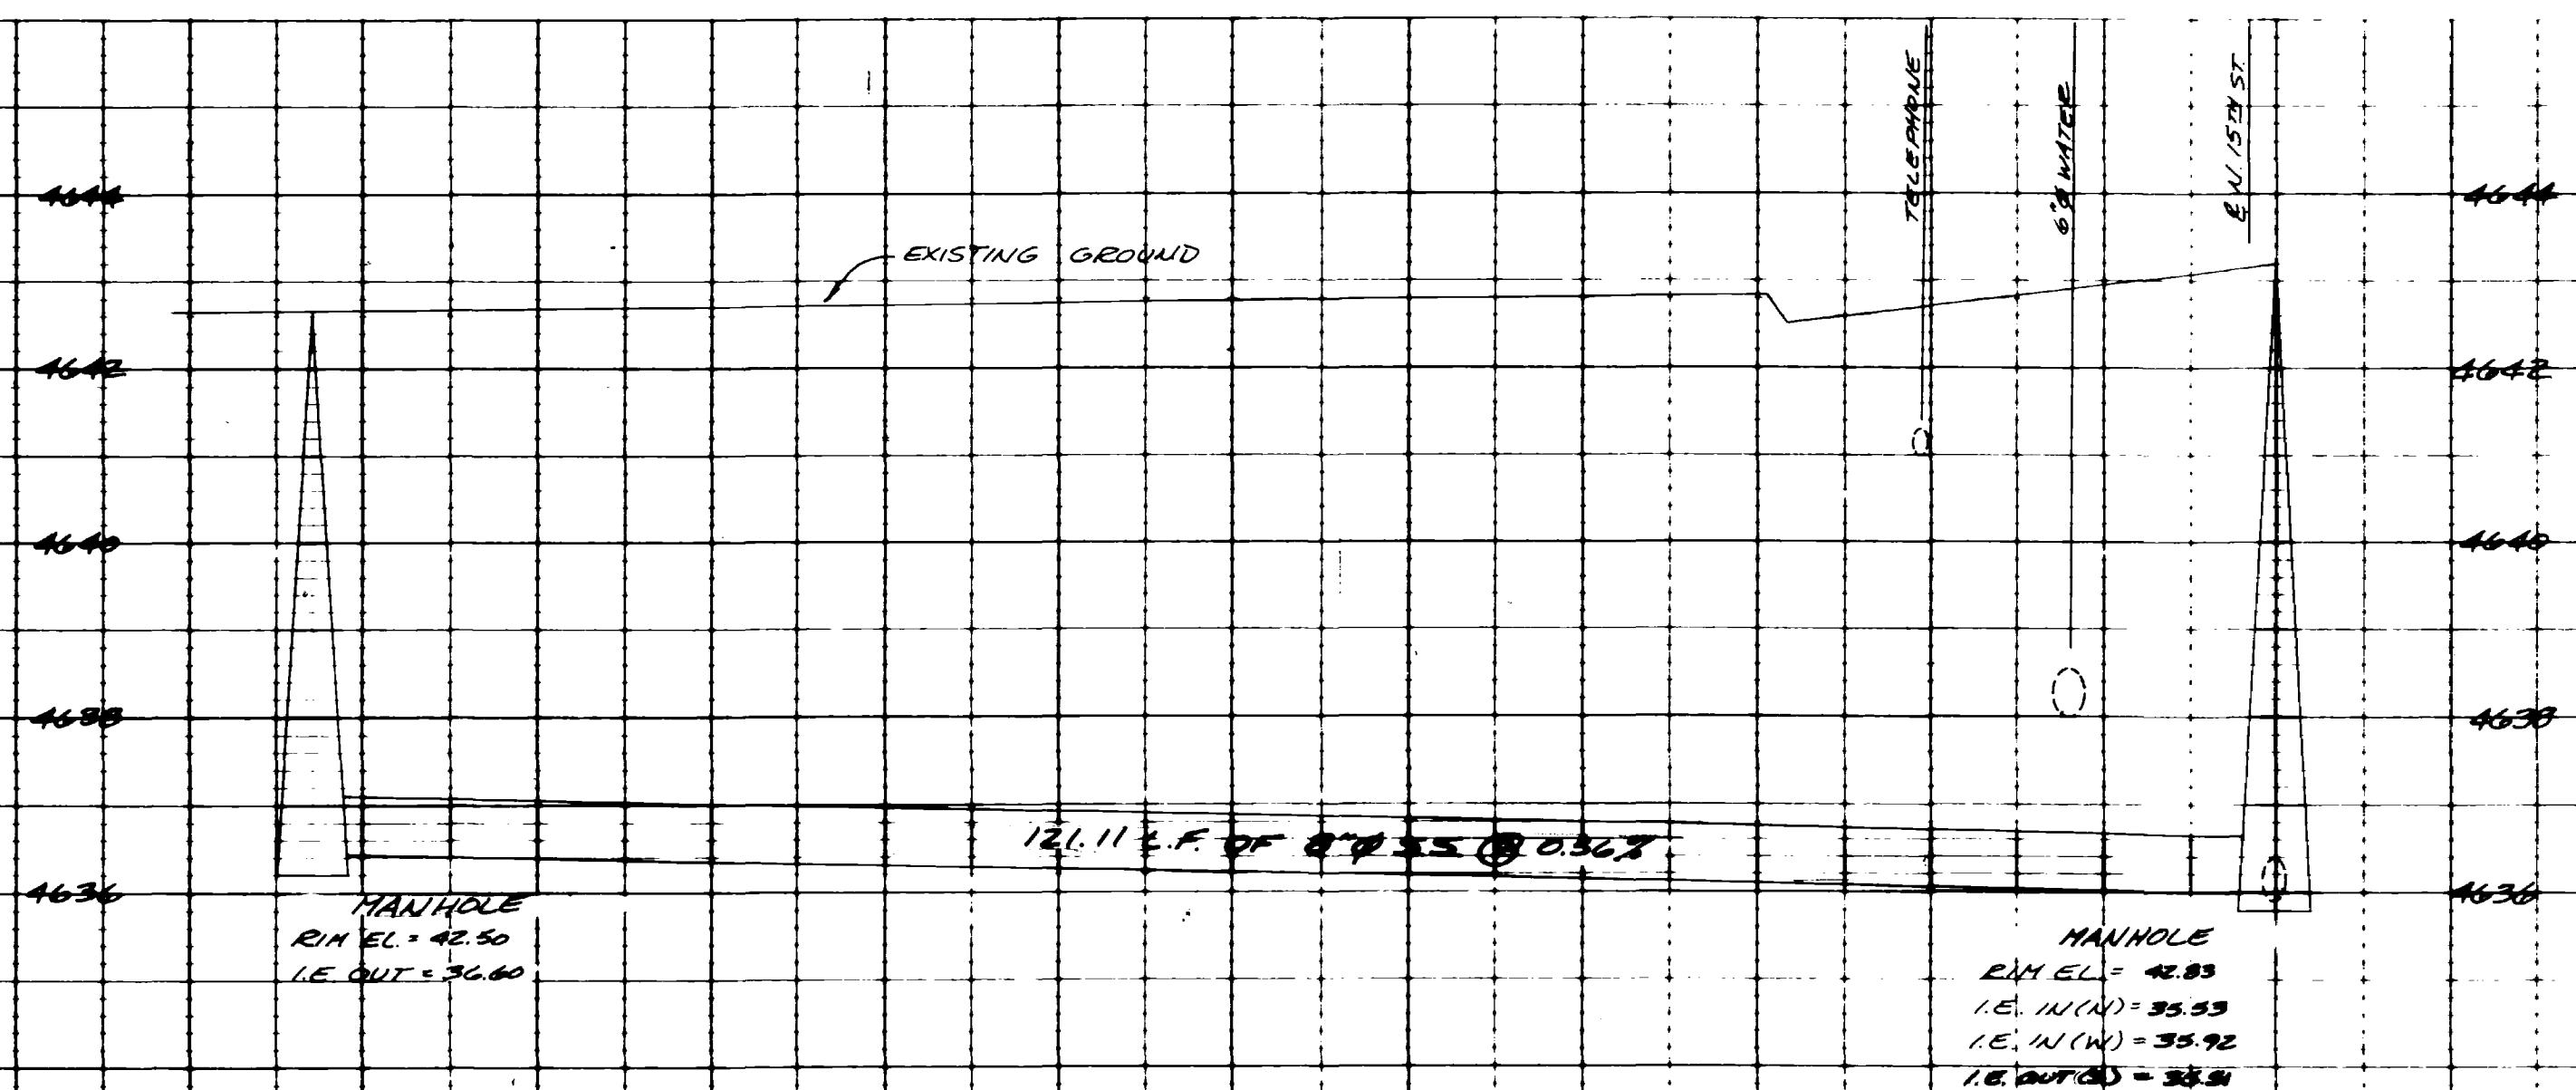

Ronald R. Rasmussen

<p>COLORADO WEST SURVEYING COMPANY COMPREHENSIVE LAND PLANNING COMPLETE SURVEYING SERVICE</p> <p>835 Colorado Avenue Grand Junction, Colorado 81501 303 245-2767</p>	NO. DATE		REVISION	BY
	<p>WALNUT GROVE</p> <p>AS-BUILT</p> <p>WALNUT AVENUE SANITARY SEWER LINE</p>			
	DES. RF	CK	82-1154	SHEET 1
DR. SR.	DATE 2/83		OF 1	