
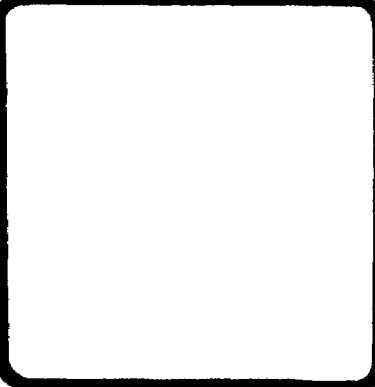


CHECKED	
DATE	OCT 6, 1981
SCALE	1" = 20'


REVISIONS	BY

PARAGON ENGINEERING, INC.
 P.O. Box 2872
 Grand Junction, Colorado 81501 (303) 243-8966





CASCADE VILLAGE FILING NO ONE
 THE FALLS FILING NO TWO
 SANITARY SEWER AS BUILTS

SHEET	1
OF SHEETS	1

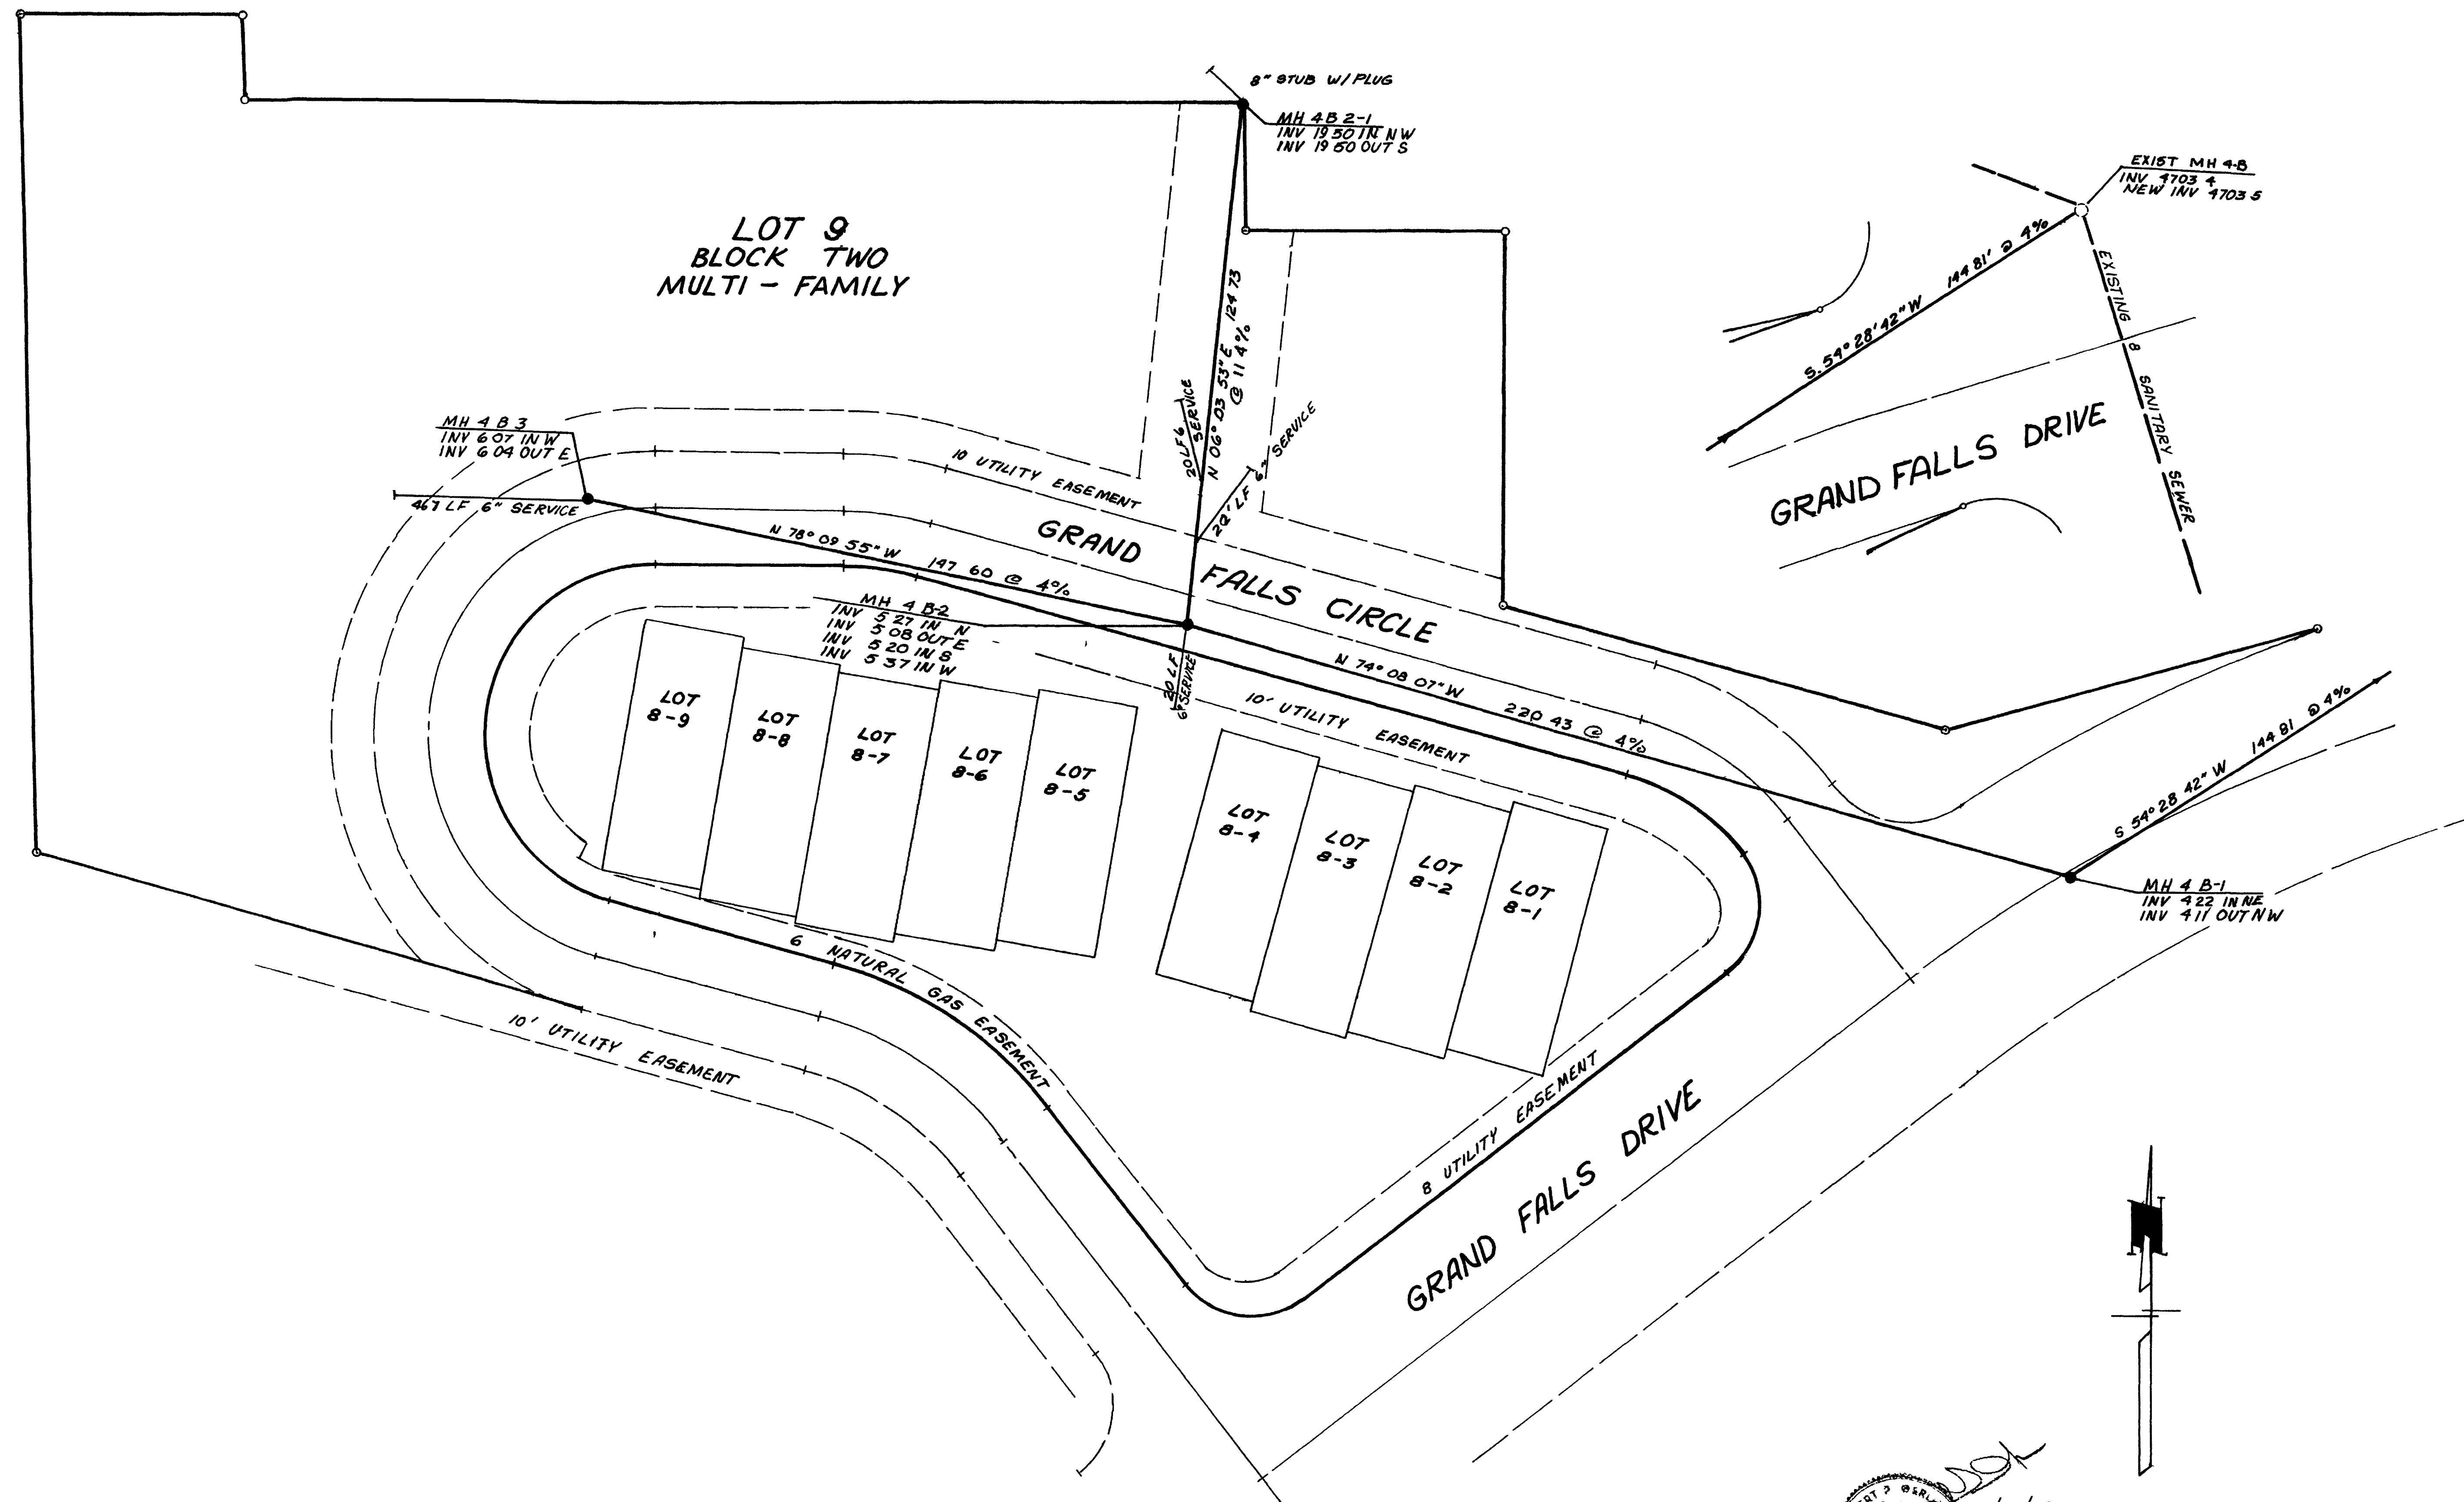


NOTE
 This is to certify that the system
 infiltration does not exceed 100
 gallons per inch diameter per mile
 of length per day

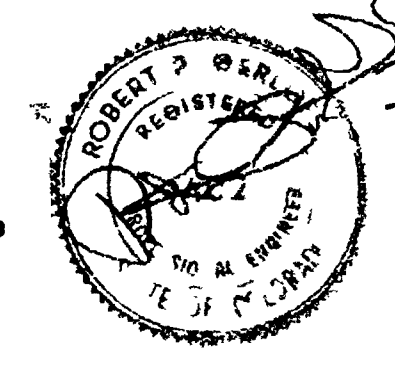

7/20/82

SCALE 1" = 20'

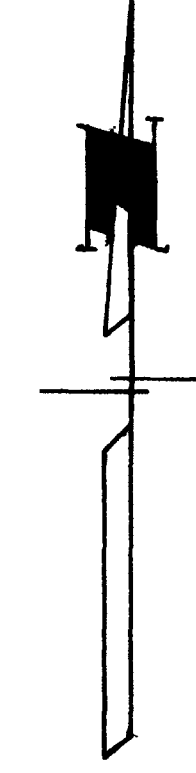

AS BUILT DRAWING